

Menu Save Reset Cancel Help

Record Detail (This section is required.)

Permit Type Building/Residential/Misc/Pool Spa Permit Number B24004019 Opened Date 10/21/2024
Description of Work SFD/ Install 16x38 Inground Fiberglass Pool DEPTH RANGE 3'6 TO 5'9 w/Auto cover and Paver deck, FENCE TO CODE

[check spelling](#)

Address (This section is required.)

Search Reset Clear Get Parcel & Owner

Street # 2800 Street Name BELLE HOLLOW Street Type CT
Unit Type --Select-- Unit # X Coordinate -77.01127 Y Coordinate 39.30481
City GLENWOOD State MD Zip Code 21738 Primary Yes

Parcel (This section is required.)

Search Reset Clear Get Address & Owner

GIS ID 905561 Parcel 123 Parcel Area 1.36 Land Value 233600 Improved Value 707800 Exemption Value 474200 Plan Area RURAL
Legal Description LOT 26 1.366 A []2800 BELLE HOLLOW CT []GWYNDYL OAK ESTATES

[check spelling](#)

Block 26 Lot 26 Census Tract 605601 Council Dist 5 Inspection Dist Supervisor Dist Map # DAP Zone
Plan Area State Tax Id 1404356225 Subdivision Name GWYNDYL OAK ESTATES
Section Area Tax Map 14
Grid 14-11 Zoning District RC-DEO ADC Map 4812-J2
SDP No. Final Plan No. WP File No.
Record Plat No. 11552 WS Contract No. FDP No. Primary Yes
Owner Occupied Year Built 1996 Historic District Yes No
Historic District Registry No. Stat Area 4-06 Flood Plain Yes No
Building No

Owner (This section is required.)

Search Reset Clear

Name WEBB
Address Line 1 2800 BELLE HOLLOW CT
Address Line 2
Address Line 3
Mail City GLENWOOD
Mail State MD
Mail Zip Code 21738

Phone
571-406-4193
Primary
Yes
E-mail
mattmoving536@gmail.com
Cell Number Fax Number

Professionals (This section is not required.)

License # Business Name
08010079053 A & K CONSTRUCTION INC T/A
License Type First Name Middle Name Last Name
MHIC Ind MICHAEL S NAILL
Primary Address Line 1
Yes 9134 D WALNUT STREET
Address Line 2

City State ZIP Code
LIBERTYTOWN MD 21762-0279
Phone 1 Phone 2 Fax
3013042221 3018984120
E-mail
MIKE@LAURELPOOLS.COM

Applicant (This section is not required.)

Search As Owner As Lic. Prof As Contact

Type First Name MI Last Name
Applicant MICHAEL S NAILL
Relationship Full Name
Applicant MICHAEL S NAILL
Primary Organization Name
Yes A & K CONSTRUCTION INC T/A
Street Address
9134 D WALNUT STREET
Address Line 2

City State Zip Code
LIBERTYTOWN MD 21762-0279
Phone Cell Fax
3013042221 3018984120
E-mail
MIKE@LAURELPOOLS.COM

Addtl Info


Est Construction Cost Housing Units Number of Buildings Public Owned
107000 0 0 No
Construction Type
--Select--

POOL INFORMATION

MISCELLANEOUS POOL INFORMATION

Capital Project-No Fee Capital Project Number Fee Exempt Water Supply Sewage Disposal
☐ Yes ☒ No (Text) ☐ Yes ☒ No Private Private
Existing Use Type of Pool or Spa Pool Safety Device Electrical Permit Number Expiration Date
Other - See Description of Work In Ground Pool Fence (Text) 4/26/2025

Submit Cancel

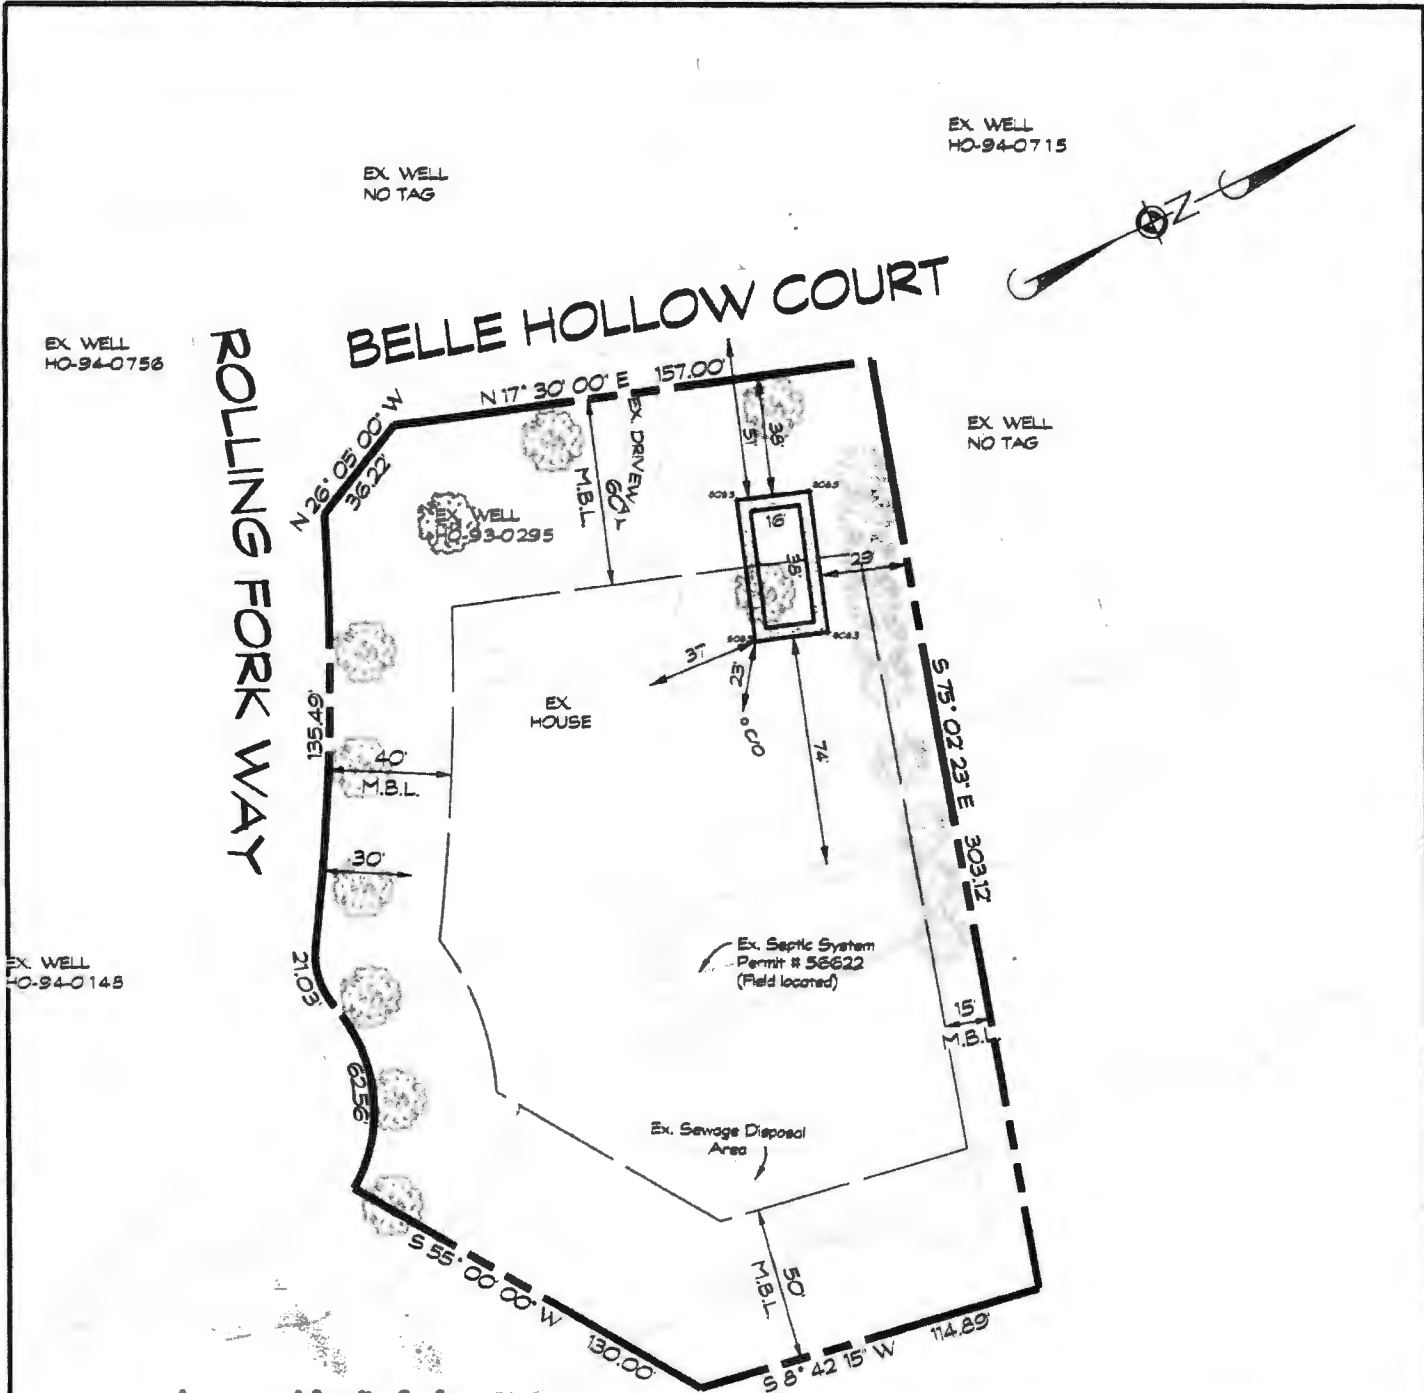

Approved Septic System Plan
 Howard County Health Department
DBernard 10-29-24/
 Signature Date
 PB 2400 4014

**PLOT PLAN - LOT 26
 GWYNDYL OAK ESTATES**

2800 BELLE HOLLOW CT. • GLENWOOD, MD 21738
 PLAT NO: 11552
 L. 21195, F. 050
 TAX MAP: 14 • GRID: 11 • PARCEL 123
 4TH ELECTION DISTRICT • HOWARD COUNTY, MD

CARROLL LAND SERVICES INC.

DATE

DATE	REVISIONS	



439 East Main Street Westminister, MD 21157-5539
 (410) 848-1790 FAX (410) 848-1791

DRAWN BY:	MS
DESIGN BY:	MS
REVIEW BY:	
DATE:	AUGUST, 2024
SCALE:	1" = 80'
JOB NO:	2023008
SHEET:	1 OF 1