

Menu Save Reset Cancel Help

Approved
HPE 10/23/24

Record Detail (This section is required.)

Permit Type Building/Residential/Misc/Pool Spa Permit Number B24003798 Opened Date 10/04/2024
Description of Work SFD/ INSTALL 7X6 HOT TUB ON PAVER PATIO WITH COVER**SUBJECT TO FIELD INSPECTION**

[check spelling](#)

Address (This section is required.)

Search Reset Clear Get Parcel & Owner
Street # 4669 Street Name ILCHESTER Street Type RD
Unit Type --Select-- Unit # --Select-- X Coordinate -76.7635 Y Coordinate 39.24172
City ELLICOTT CITY State MD Zip Code 21043 Primary Yes

Parcel (This section is required.)

Search Reset Clear Get Address & Owner
GIS ID 886041 Parcel 615 Parcel Area 7.6 Land Value 0 Improved Value 667700 Exemption Value 0 Plan Area ELKRID
Legal Description 7.600 A [J]4669 ILCHESTER RD [J]ILCHESTER

[check spelling](#)

Block Lot Census Tract 601101 Council Dist 1 Inspection Dist 6 Supervisor Dist Map # DAP Zone
Plan Area State Tax Id 1401175297 Subdivision Name
Section Area Tax Map 31
Grid Zoning District R-ED ADC Map 4936-H2
SDP No. Final Plan No. WP File No.
Record Plat No. WS Contract No. FDP No. Primary Yes
Owner Occupied Year Built 1989 Historic District Yes No
Historic District Registry No. Stat Area 1-01 Flood Plain Yes No
Building No

Owner (This section is required.)

Search Reset Clear
Name LUCAS
Address Line 1 4669 Ilchester Rd
Address Line 2
Address Line 3
Mail City Ellicott City
Mail State MD
Mail Zip Code 21043

Phone
410-788-5857
Primary
Yes
E-mail
bowerbox@gmail.com
Cell Number
4109057519
Fax Number

Professionals (This section is not required.)

License #
0
License Type
Home Owner
Primary
Yes
Business Name
First Name
VALERIE
Middle Name
Last Name
LUCAS
Address Line 1
4669 ILCHESTER RD
Address Line 2
City
ELLICOTT CITY
State
MD
ZIP Code
21043
Phone 1
410-788-5857
Phone 2
Fax
E-mail
BOWERBOX@GMAIL.COM

Applicant (This section is not required.)

Search As Owner As Lic. Prof As Contact

Type
Applicant
Relationship
Applicant
Primary
Yes
First Name
Valerie
MI
Anne
Last Name
Lucas
Full Name
Valerie Anne Lucas
Organization Name
Street Address
4669 Ilchester Rd
Address Line 2
City
Ellicott City
State
MD
Zip Code
21043
Phone
410-788-5857
Cell
410-905-7519
Fax
E-mail
bowerbox@gmail.com

Addtl Info


Est Construction Cost
12000
Construction Type
--Select--
Housing Units
0
Number of Buildings
0
Public Owned
No

POOL INFORMATION

MISCELLANEOUS POOL INFORMATION

Capital Project-No Fee
☐ Yes ☒ No
Capital Project Number
(Text)
Fee Exempt
☐ Yes ☒ No
Water Supply
Private
Sewage Disposal
Private
Existing Use
SFD
Type of Pool or Spa
Hot Tub
Pool Safety Device
Automatic Pool Cover
Electrical Permit Number
E24005435
Expiration Date
(Text) 4/21/2025

Submit Cancel

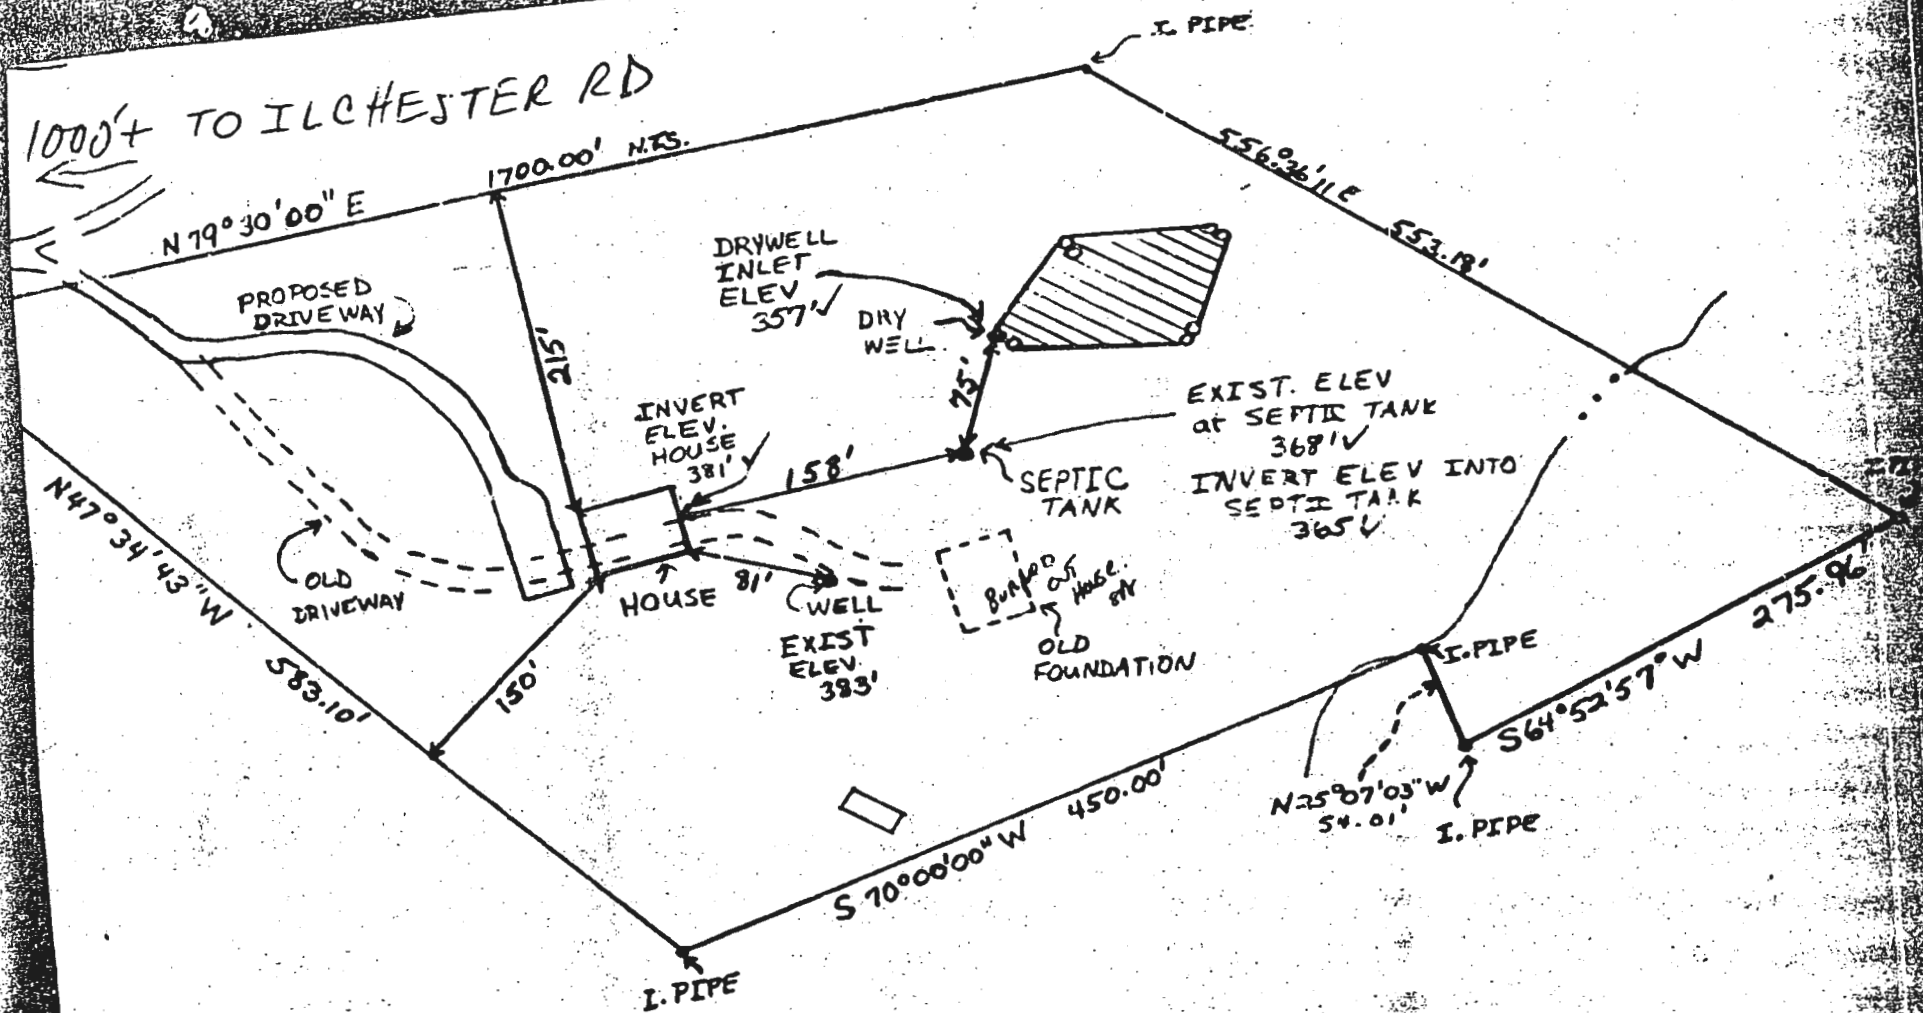

NOTES:

1. SCALE: 1 INCH = 100 FEET
2. EXISTING WELL - SEE ATTACHED REPORT
3. EXISTING APPROVED SEPTIC & DRYWELL - SEE ATTACHED REPORT

