

Menu Save Reset Cancel Help

Record Detail * (This section is required.)

Case

EH-PLANS-24-0

Type

EnvHealth/Environmental Health/Plan Check/Application

Status

In Review

Opened Date

08/30/2024

Single Entry Edit-View Record Form

Application Name

B24003244

Description

SFD/Install approx. 216 LF. of 7' tall vinyl privacy fence transitioning to approx. 32 LF of 6' vinyl privacy - no gate

Total Invoiced

0.00

Total Paid

0.00

Balance

0.00

Assigned to Department Current Department

Well and Septic Progr: v

Assigned to Staff Current User

Zack Silvast v

Address * (This section is required.)

New	Search	Delete	Set Primary											
☐ Primary	<u>Street # (start)</u>	<u>Direction</u>	<u>Street Name</u>	<u>Street Type</u>	<u>City</u>	<u>State</u>	<u>Zip Code</u>	<u>Address Status</u>	<u>Street Suffix (Direction)</u>	<u>Unit Type</u>	<u>U</u>			
☐	17512		Timber...	WAY	Wood...	MD	21797							

Parcel (This section is not required.)

Search	Delete	Get Address & Owner		Set Primary										
☐ Primary		<u>Parcel #</u>	<u>Book</u>	<u>Page</u>	<u>Parcel</u>	<u>Parcel Area</u>	<u>Land Value</u>	<u>Improved Value</u>	<u>Exemption Value</u>	<u>Legal Description</u>	<u>Tract</u>			
0 record(s) found.														

Owner (This section is not required.)

Search	Delete	Set Primary												
☐ Primary		<u>Name</u>	<u>Mail Address Line1</u>	<u>Mail Address Line2</u>	<u>Mail Address Line3</u>	<u>Mail City</u>	<u>Mail State</u>	<u>Mail Zip Code</u>	<u>Phone</u>	<u>Country/Regio</u>				
☐		John Nagengast	17512 Timberleigh Way			Woodbine	MD	21797	443-472-2690	US				

Applicant * (This section is required.)

Search As Owner As Lic. Prof As Contact

Single Entry Applicant Form

Type *

Applicant v

Primary

Yes v

First Name *

Julie

Middle Name

Last Name *

Barth

Home Phone ((XXX)XXX-XXXX)

Approved RMC
9/13/2024

Online BP.
gjb 9/13/24

Organization Name *
Chedapeake Permits
Mobile Phone * (XXX XXX-XXXX)
(443) 623-1994
E-mail
mandm0003@hotmail.com
Business Phone ((XXX)XXX-XXXX)

Preferred Channel
--Select--

Applicant Address

New Look Up Deactivate Remove

☐ Contact Address ID	Address Type	Address Line 1	City	State	Zip	Primary	Recipient	Status
0 record(s) found.								

Custom Fields

DATE TRACKING

Received Date
8/30/2024

Due Date
9/16/2024

Dates to Complete
14
(Number)

Received by Food

Food Review Type
--Select--

Equipment Specification Sheets Submitted

Equipment Specification Sheet

Received by Community Hygiene

Received by Well and Septic
8/30/2024

FACILITY INFORMATION

Name of Business (dba) *

na (Text)

Associated Building Permit Number

(Text)

Owner Switch Date

Does the project include an Aquatic Facility such as a Public Pool? If Yes, forward to CH Program.

☐ Yes ☐ No

Does the project include Private Septic? If Yes, forward to WS Program.

☐ Yes ☐ No

Is this a Prototype Food Service Facility? If Yes, refer to State.

☐ Yes ☐ No

Facility Fax

0 (Text)

Days of Operation

0 (Text)

Does this project have a Building Permit?

☐ Yes ☐ No

Building Permit Issued Date

☐ Non-Profit

Does the project include Private Well? If Yes, forward to WS Program.

☐ Yes ☐ No

Does the project include Food Services? If Yes, forward to FP Program.

☐ Yes ☐ No

Facility Phone

0 (Text)

Facility Email

0 (Text)

PROPERTY INFORMATION

Water Source

Public

Design Wastewater Flow

0 (Number)

Sewage Disposal

Public

Permit Type

--Select--

PLAT STATS

Total Number of buildable lots to be recorded

0 (Number)

Total number of bulk parcels to be recorded

0 (Number)

New buildable lots created

0 (Number)

PLAT Type

--Select--

Total number of open space lots to be recorded

0 (Number)

Total number of lots / parcels to be recorded

0 (Number)

Date PLAT signed by Health Officer

DEVELOPMENT PLANS

Property Type Residential	Plan Version Initial
Signature Required ☐ Yes ☒ No	Engineer 0 (Text)
Number of paper copies 0 (Number)	Number of mylar copes 0 (Number)
Number of buildable lots created 0 (Number)	Number of non-buildable lots created 0 (Number)
Total Number of Lots 0 (Number)	Associated Plans 0

WELL AND SEPTIC INTERNAL

State Review Required ☐ Yes ☐ No	Coordinate State Review ☐ Yes ☐ No
Proposed Septic System Type --Select--	

FOOD ESTABLISHMENT FACILITY

Priority Assessment --Select--	Licensed Type --Select--
License Category --Select--	

FOOD ESTABLISHMENT INFORMATION

Hours of Operation (Text)	☐ Operating Seasonally Only
If Operating Seasonally. What is the start month? (Text)	Are pets allowed in a outdoor seating area? ☐ Yes ☐ No
Full Bar? ☐ Yes ☐ No	

RESTAURANT AND FOOD SERVICE

Food Service Facility Secondary Category --Select--	Total Seating Capacity (Number)
Number of Restrooms (Number)	Interior Restaurant Seating Capacity (Number)
Bar Seating Capacity (Text)	Outdoor Seating Capacity (Text)
Does the restaurant have outdoor seating ☐ Yes ☐ No	

EQUIPMENT


Evaluated non NSF, ANSI, CF or other standards ☐ Yes ☐ No	Description of Refrigeration Units
Number of Walk-In Refrigerator Units (Number)	Description of Walk-In Freezer Units (Text)
Is there a bulk ice machine available ☐ Yes ☐ No	Space Limitation
Number of Hand Sinks Available (Number)	Hood System (Text)
Ventless Equipment (Text)	

PLUMBING

Size and installation of the water heater? (Text)	Is there a grease interceptor or grease trap? --Select--
---	--

REFUSE AND RECYCLABLES

Dumpsters Located on a impervious surface? --Select--	Will there be a grease receptacle? --Select--
---	---

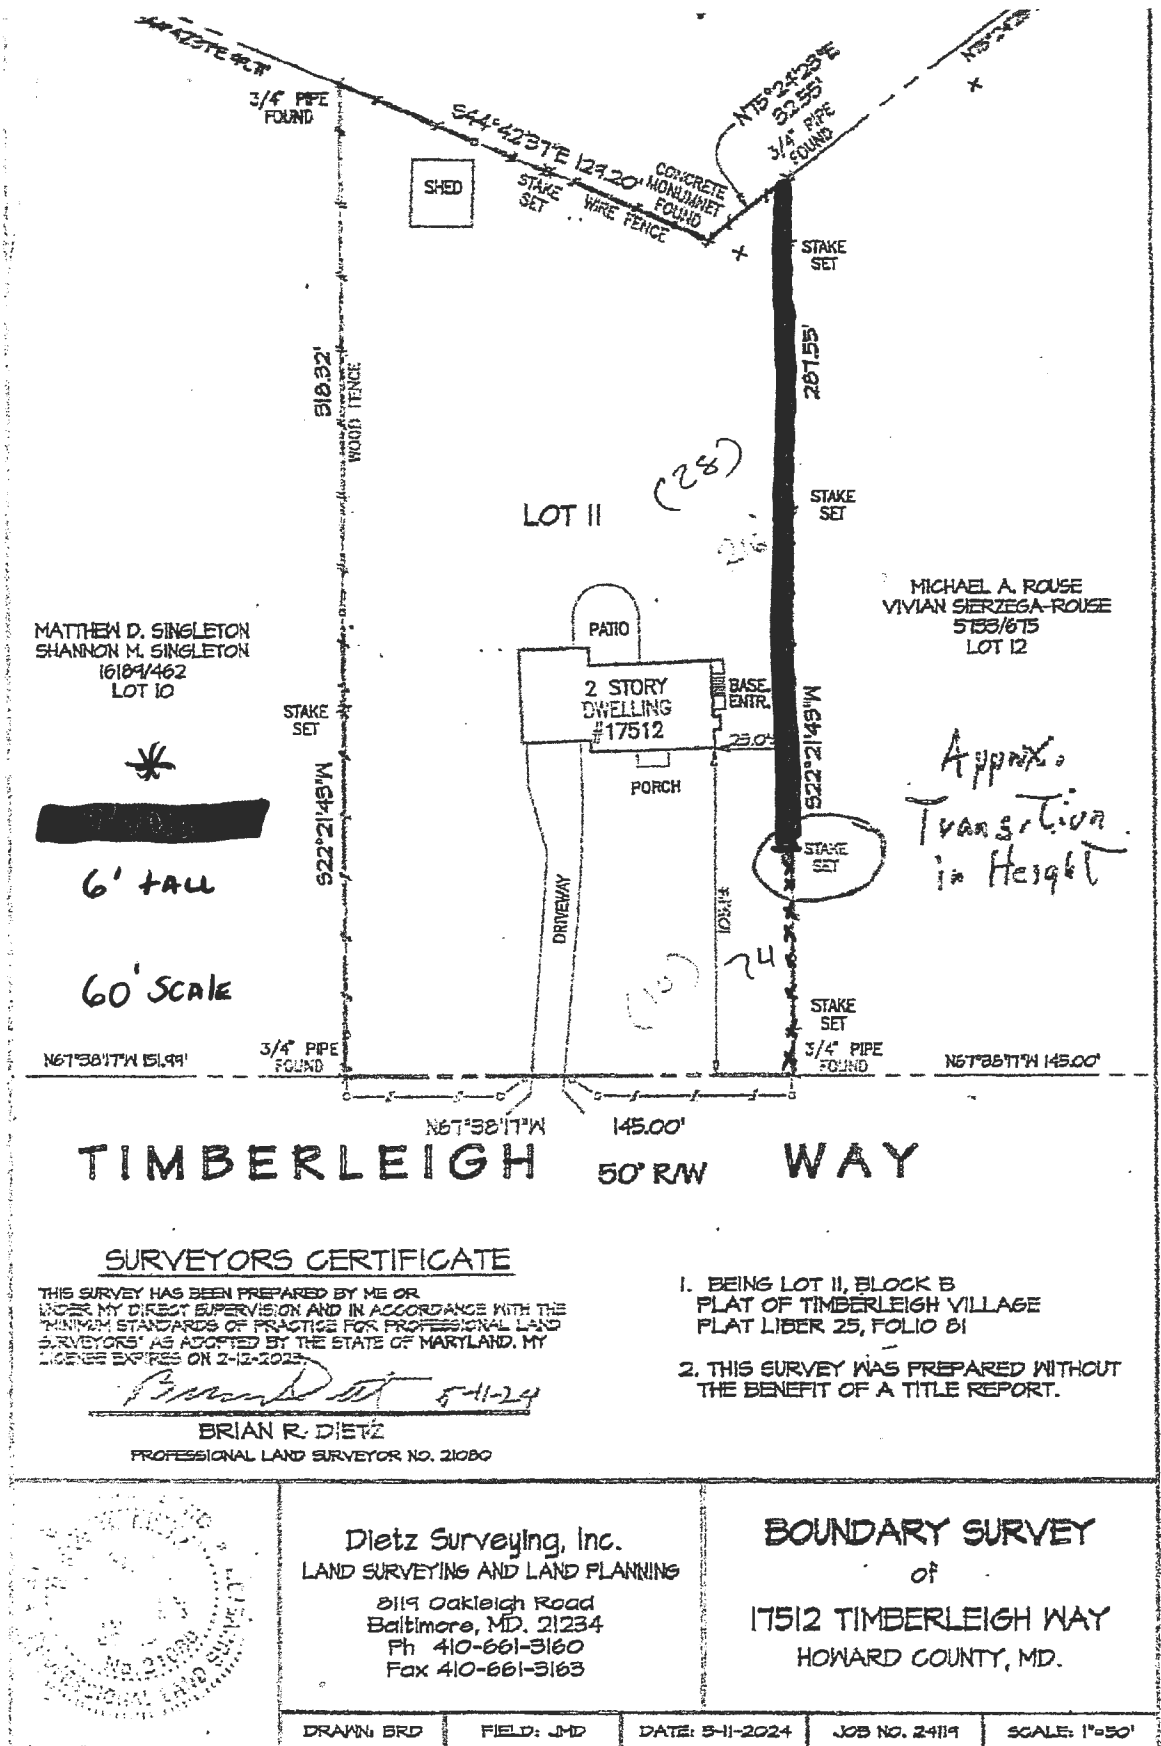

J. Nagengast Plat