

Menu Save Reset Cancel Help

Record Detail * (This section is required.)

Case

EH-PLANS-24-0

Type

Env/Health/Environmental Health/Plan Check/Application

Status

In Review

Opened Date

08/19/2024

Single Entry Edit-View Record Form

Application Name

B24003032

Description

SFD/ Install 18' X 36' in-ground concrete pool with 3' concrete patio, Pool depths 3'6" to 5'0" WITH Fence to code**SUBJECT TO FIELD INSPECTION**

Total Invoiced

0.00

Total Paid

0.00

Balance

0.00

Assigned to Department Current Department

Well and Septic Progr ▼

Assigned to Staff Current User

Zack Silvast ▼

Address * (This section is required.)

New Search Delete Set Primary

☐ Primary	<u>Street # (start)</u>	<u>Direction</u>	<u>Street Name</u>	<u>Street Type</u>	<u>City</u>	<u>State</u>	<u>Zip Code</u>	<u>Address Status</u>	<u>Street Suffix (Direction)</u>	<u>Unit Type</u>	<u>U</u>
☐ ●	6579		Prestwick	DR	High...	MD	20777				

Parcel (This section is not required.)

Search Delete Get Address & Owner Set Primary

☐ Primary	Parcel #	Book	Page	Parcel	Parcel Area	Land Value	Improved Value	Exemption Value	Legal Description	Tract
0 record(s) found.										

Owner (This section is not required.)

Search Delete Set Primary

☐ Primary	<u>Name</u>	<u>Mail Address Line1</u>	<u>Mail Address Line2</u>	<u>Mail Address Line3</u>	<u>Mail City</u>	<u>Mail State</u>	<u>Mail Zip Code</u>	<u>Phone</u>	<u>Country/Region</u>
☐ ●	Michael Seablom	6579 Prestwick Drive			Highland	MD	20777	202-381-6820	US

Applicant * (This section is required.)

Search As Owner As Lic. Prof As Contact

Single Entry Applicant Form

Type *

Applicant ▼

Primary

Yes ▼

First Name *

Mark

Middle Name

Last Name *

Shaffery

Home Phone (xxx)xxx-xxxx

Approved R/E
8/30/2024Online BP.
y8 8/22/24

Organization Name
Heritage Elite LLC
Mol... Phone ((XXX)XXX-XXXX)
(410) 808-2505
E-mail
Mark@elitepools.com
Business Phone ((XXX XXX-XXXX)

Preferred Channel
--Select--

Applicant Address

New Look Up Deactivate Remove

☐ Contact Address ID	Address Type	Address Line 1	City	State	Zip	Primary	Recipient	Status
0 record(s) found.								

Custom Fields

DATE TRACKING

Received Date

8/16/2024

Due Date

8/30/2024

Dates to Complete

14
(Number)

Received by Food

Food Review Type

--Select--

Equipment Specification Sheets Submitted

Equipment Specification Sheet

Received by Community Hygiene

Received by Well and Septic
8/16/2024

FACILITY INFORMATION

Name of Business (dba)
NA (Text)
Associated Building Permit Number
(Text)
Owner Switch Date

Does this project have a Building Permit?
☐ Yes ☐ No
Building Permit Issued Date

Does the project include an Aquatic Facility such as a Public Pool? If Yes, forward to CH Program.
☐ Yes ☐ No
Does the project include Private Septic? If Yes, forward to WS Program.
☐ Yes ☐ No
Is this a Prototype Food Service Facility? If Yes, refer to State.
☐ Yes ☐ No
Facility Fax
0 (Text)
Days of Operation
0 (Text)

☐ Non-Profit
Does the project include Private Well? If Yes, forward to WS Program.
☐ Yes ☐ No
Does the project include Food Services? If Yes, forward to FP Program.
☐ Yes ☐ No
Facility Phone
0 (Text)
Facility Email
0 (Text)

PROPERTY INFORMATION

Water Source
Private
Design Wastewater Flow
0 (Number)
Sewage Disposal
Private
Permit Type
--Select--

PLAT STATS

Total Number of buildable lots to be recorded

0 (Number)

Total number of open space lots to be recorded

0 (Number)

Total number of bulk parcels to be recorded

0 (Number)

Total number of lots / parcels to be recorded

0 (Number)

New buildable lots created

0 (Number)

Date PLAT signed by Health Officer

PLAT Type

--Select--

DEVELOPMENT PLANS

Property Type

Residential

Signature Required

☐ Yes ☒ No

Number of paper copies

0

(Number)

Number of buildable lots created

0

(Number)

Total Number of Lots

0

(Number)

Plan Version

Initial

Engineer

0

(Text)

Number of mylar copies

0

(Number)

Number of non-buildable lots created

0

(Number)

Associated Plans

WELL AND SEPTIC INTERNAL

State Review Required

☐ Yes ☐ No

Coordinate State Review

☐ Yes ☐ No

Proposed Septic System Type

--Select--

FOOD ESTABLISHMENT FACILITY

Priority Assessment

--Select--

Licensed Type

--Select--

License Category

--Select--

FOOD ESTABLISHMENT INFORMATION

Hours of Operation

(Text)

☐ Operating Seasonally Only

If Operating Seasonally. What is the start month?

(Text)

Are pets allowed in a outdoor seating area?

☐ Yes ☐ No

Full Bar?

☐ Yes ☐ No

RESTAURANT AND FOOD SERVICE

Food Service Facility Secondary Category

--Select--

Total Seating Capacity

(Number)

Number of Restrooms

Interior Restaurant Seating Capacity

(Number)

(Number)

Bar Seating Capacity

Outdoor Seating Capacity

(Text)

(Text)

Does the restaurant have outdoor seating

☐ Yes ☐ No

EQUIPMENT

Evaluated non NSF, ANSI, CF or other standards

☐ Yes ☐ No

Description of Refrigeration Units

Number of Walk-In Refrigerator Units

(Number)

Description of Walk-In Freezer Units

(Text)

Is there a bulk ice machine available

☐ Yes ☐ No

Space Limitation

Number of Hand Sinks Available

(Number)

Hood System

(Text)

Ventless Equipment

(Text)

PLUMBING

Size and installation of the water heater?

(Text)

Is there a grease interceptor or grease trap?

--Select--

REFUSE AND RECYCLABLES

Dumpsters Located on a impervious surface?


--Select--

Will there be a grease receptacle?

--Select--

Approved *R/E* B24003032

8/30/2024

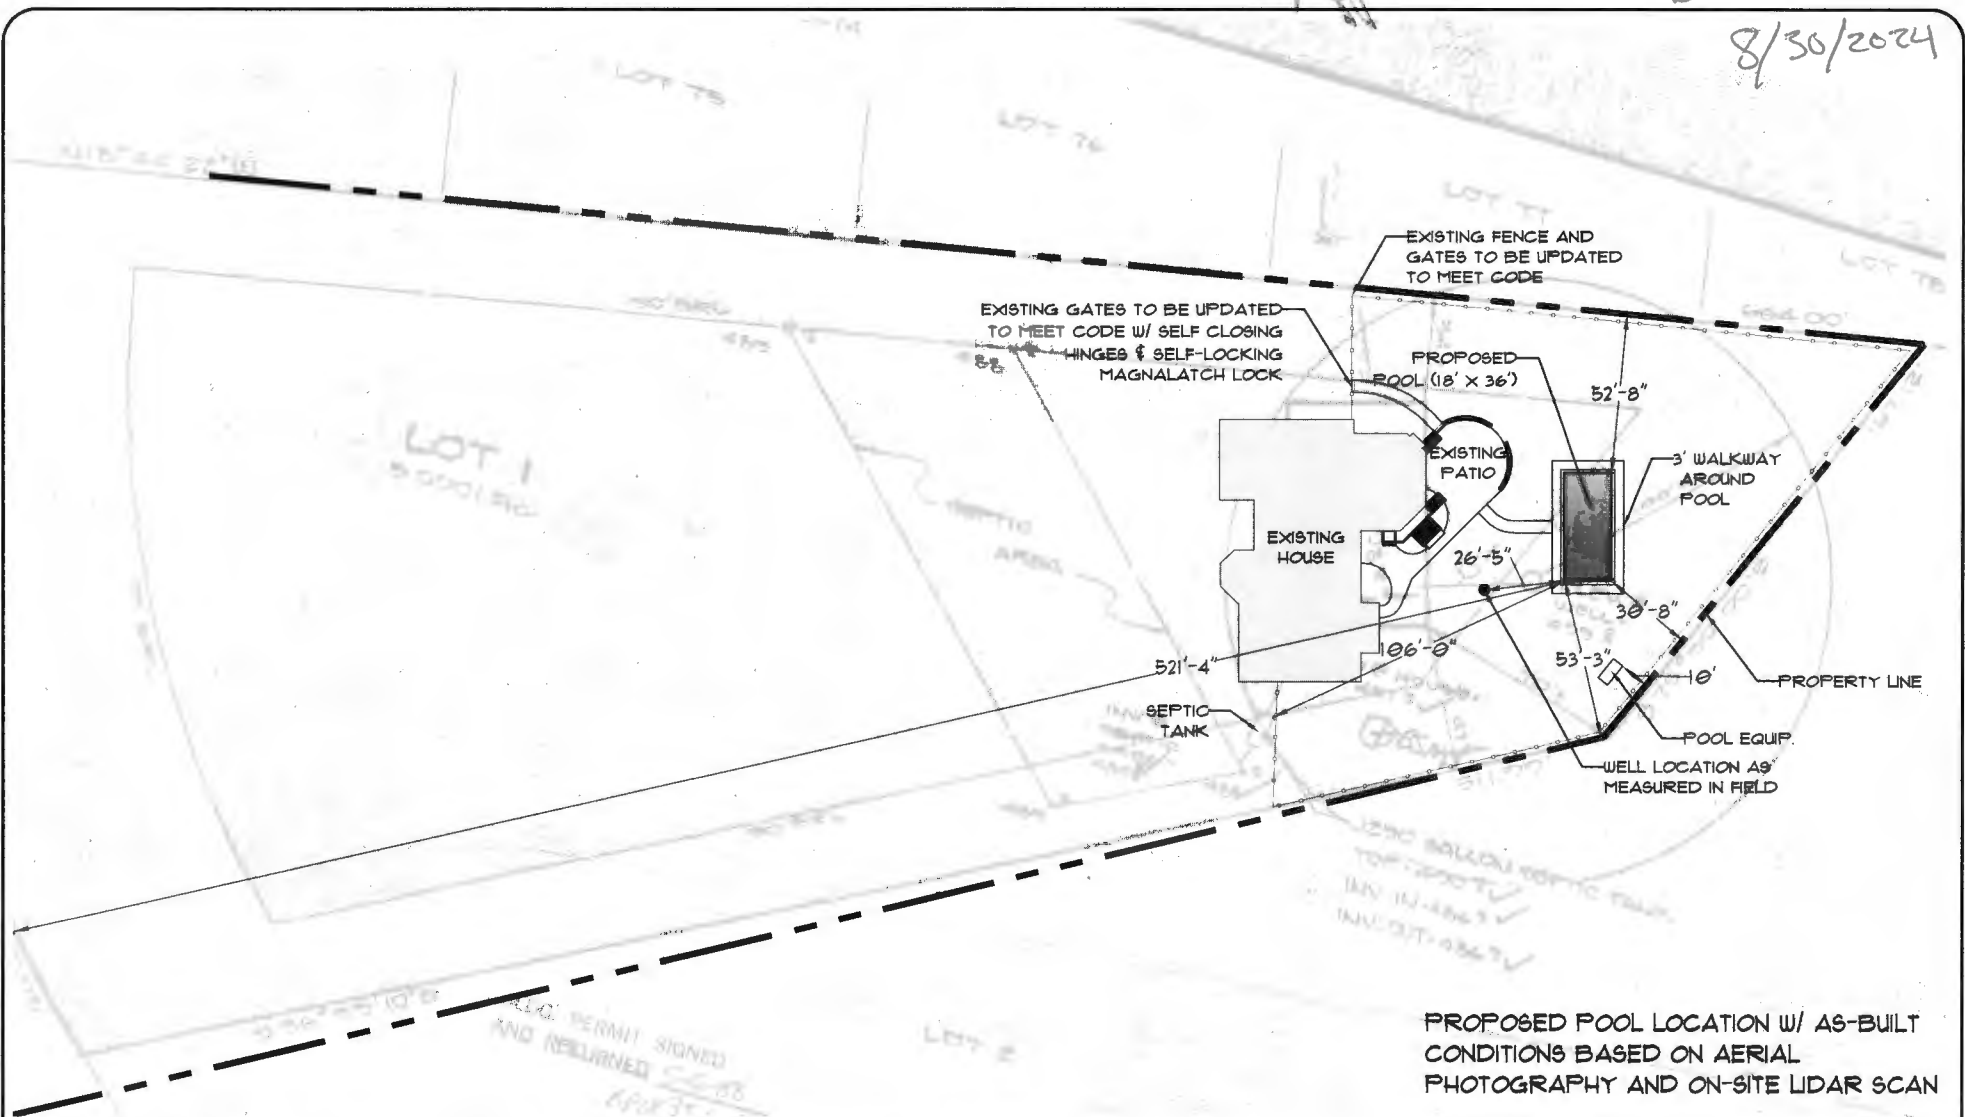

Elite Pools

400 EAST PRATT STREET, SUITE 500
BALTIMORE, MARYLAND 21202
410-454-7546 OFFICE
WWW.ELITEPOOLS.COM

SEABLOM RESIDENCE

6579 PRESWICK DRIVE
HIGHLAND, MD 20711

PERMIT PLAN

DATE: 10/27/2024
SCALE: 1"=40'

SHEET

L2

NO. REVISIONS DATE