

Menu Save Reset Cancel Help

Record Detail * (This section is required.)

Permit Type	Permit Number	Opened Date
Building/Residential/Misc/Pavilion	B24002736	07/23/2024
Description of Work		
SFD/install 12' x 18' open pavilion. Pavilion will be built off site and installed as one unit **SUBJECT TO FIELD INSPECTION**		

Approved
RIZ #34
8/1/2024

Online BP
assigned to RSF.

g8 7/30/24

[check spelling](#)

Address * (This section is required.)

Search	Reset	Clear	Get Parcel & Owner		
Street #	Street Name	Street Type			
13614	MITCHELLS	WAY		v	
Unit Type	Unit #	X Coordinate	Y Coordinate		
-Select-	v	-76.99251	39.30763		
City	State	Zip Code	Primary		
WEST FRIENDSHIP	MD	21794	Yes	v	

Parcel * (This section is required.)

Search	Reset	Clear	Get Address & Owner			
GIS ID *	Parcel	Parcel Area	Land Value	Improved Value	Exemption Value	Plan Area
927392	119	1.03	178800	867300	0	RURAL
Legal Description						
LOT 10 45,036 SQ' []13614 MITCHELLS WAY []CLOVERFIELD SEC II						

[check spelling](#)

Block	Lot	Census Tract	Council Dist	Inspection Dist	Supervisor Dist	Map #	DAP Zone
	10	603000	5				
Plan Area	State Tax Id		Subdivision Name				
	1403353486		Cloverfield				
Section	Area		Tax Map				
			15				
Grid	Zoning District		ADC Map				
15-7	RC-DEO		4813-B1				
SDP No.	Final Plan No.		WP File No.				
	F-07-091						
Record Plat No.	WS Contract No.		FDP No.		Primary	v	
20256-2025					Yes		
Owner Occupied	Year Built		Historic District				
☐ Yes ☐ No	2015		☐ Yes ☒ No				
Historic District Registry No.	Stat Area		Flood Plain				
	3-04		☐ Yes ☒ No				
Building No							

Owner * (This section is required.)

Search	Reset	Clear
--------	-------	-------

Name *

FARAS

Address Line 1

13614 MITCHELLS WAY

Address Line 2

Address Line 3

Mail City

WEST FIENDSHIP

Mail State

MD

Mail Zip Code

21794

Phone

443-604-4029

Primary

Yes

E-mail

jon@terranovadesignbuild.com

Cell Number

Fax Number

Professionals (This section is not required.)

License #

08010092718

License Type

MHIC Ind

Primary

Yes

Business Name

TERRA NOVA LANDSCAPING INC

First Name

GRANT

Middle Name

Last Name

REWEGA

Address Line 1

3309 DAMASCUS ROAD

Address Line 2

City

BROOKEVILLE

State

MD

ZIP Code

20833-0000

Phone 1

2408762837

Phone 2

Fax

E-mail

GRANT@TERRANOVADESIGNBUILD.COM

Applicant (This section is not required.)

Search

As Owner

As Lic. Prof

As Contact

Type

Applicant

Relationship

—Select—

Primary

Yes

First Name

jon

MI

m

Last Name

coakley

Full Name

jon m coakley

Organization Name

Terra Nova

Street Address

3177 elmmede rd

Address Line 2

City

ellicott city

State

MD

Zip Code

21042

Phone

4436044029

Cell

Fax

E-mail

joncoakley55@gmail.com

Addtl Info

Est Construction Cost

10000

Housing Units

0

Number of Buildings

0

Public Owned

No

Construction Type

—Select—

PAVILION

PAVILION INFORMATION

Capital Project-No Fee

YesNo

Capital Project Number

(Text)

Fee Exempt

YesNo

Roadside Tree Project Permit

YesNo

Roadside Tree Project Permit #

(Text)

Existing Use

SFD

Total Square Footage

▼

216

Water Supply

SQFT (Number) Private

Sewage Disposal

▼

Private

Expiration Date



▼

1/25/2025

Submit

Cancel

Approved RAC
324002736 8/1/2024

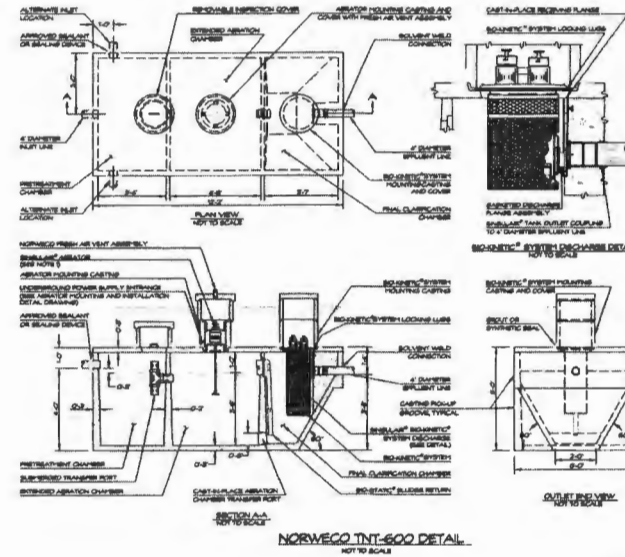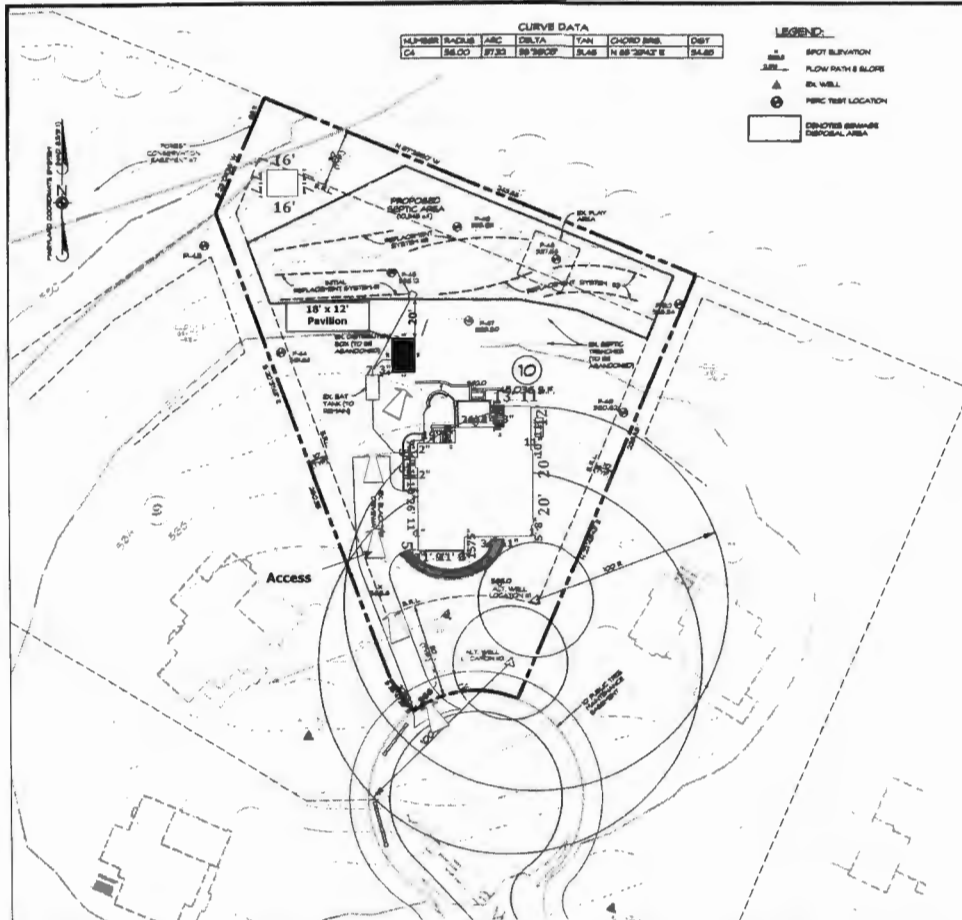

SEPTIC TANK NOTES

1. INSULATED AERATOR, AS TESTED AND ACCEPTED BY H&C, OPERATES 60 MINUTES ON / 60 MINUTES OFF.
2. RAIL THROUGH INSULATED PLANT FROM INLET INVERT TO OUTLET INVERT IS FOUR INCHES INLET INVERT IS TWELVE INCHES BELOW TANK TOP.
3. ON DEEPER INSTALLATIONS, PRECAST RISERS MUST BE USED TO BRIDGE ABISATOR HOUSING CASINGS AND BIO-GENETIC SYSTEM HOUSING CASINGS TO GRADE.
4. TANK REINFORCED PER A.C.I. STD. 308-OL.
5. REMOVABLE COVERS ON RISERS WAREH IN EXCESS OF SEVENTY-FIVE POUNDS EACH TO PREVENT UNAUTHORIZED ACCESS.
6. CONTACT THE LOCAL LICENSED INSULATED DISTRIBUTOR FOR ELECTRICAL REQUIREMENTS.

NOTE:
THE LOT BOUNDARY LINE MUST BE STAKED BY A LICENSED LAND SURVEYOR OR PROFESSIONAL ENGINEER WHEN INSTALLATION OF TRENCHES ARE PLANNED NEAR THE LOT'S BACK BOUNDARY.

GENERAL NOTES


1. THE STORM-WATER MANAGEMENT FOR THIS LOT IS PROVIDED OTHERWISE IN THE TWO HORIZONTAL EXTENDED DETENTION FACILITIES AND DRAINAGE SWALES FOR THE RECORDED PLAN NO. 30398.
2. THERE ARE NO STREAMS, PONDS, FLOODPLAINS, OR WETLANDS ON THIS LOT.
3. THERE ARE NO 30% OR GREATER SLOPES ON THIS LOT.
4. SEPTIC WELL LOCATION IS FIELD LOCATED.

SEPTIC SYSTEM TRENCH DESIGN:

HOUSE SQUARE FOOTAGE: 2817 S.F.
PROPOSED NUMBER OF BEDROOMS: 4
AVERAGE PERCOLATION TEST TIME: 4 MIN.
APPLICATION RATE: 1.3 GPD/SQ. FT.
DESIGN FLOW: 800 GAL/DAY + 4 BEDROOM = 180 GAL/DAY
800 GAL/DAY / 1.3 GAL/DAYING FT. = 600 SQ. FT.
350 L.P. x 30" = 125 L.P. OF TRENCH + 138 L.P.
USE 3 - 63 L.P. OF TRENCH FOR INITIAL SYSTEM
USE 5 - 80 L.P. OF TRENCH FOR REPLACEMENT SYSTEM #2
USE 2 - 63 L.P. OF TRENCH FOR REPLACEMENT SYSTEM #3


PURPOSE NOTE:
THIS PLAN IS TO REVISE THE LOCATION OF THE INITIAL SEPTIC SYSTEM FOR INSTALLATION OF A POOL.

TRENCH	EX. GROUND	INV. ELEV.	BOTTOM OF TRENCH
1	888.0	884.8	882.0
2	888.0	882.8	880.0

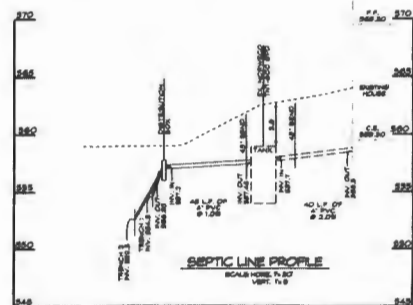

BAT SITE PLAN NOTES

1. ANY CHANGE TO THE LOCATIONS OR DEPTHS TO ANY COMPONENTS MUST BE APPROVED BY THE ENGINEER AND THE HOWARD COUNTY HEALTH DEPARTMENT PRIOR TO INSTALLATION. A REVISED SITE PLAN MAY BE REQUIRED.
2. THE MAXIMUM DEPTH OF THE BAT PER THE MANUFACTURER'S SPECIFICATION IS 4 FEET.
3. THE BAT SYSTEM SHALL BE MAINTAINED AND OPERATED FOR THE LIFE OF THE SYSTEM.
4. THE BAT SHALL BE OPERATED BY AND MAINTAINED BY A CERTIFIED SERVICE PROVIDER.
5. WITHIN ONE MONTH OF INSTALLATION, A PERSON INSTALLING THE BAT SYSTEM SHALL REPORT TO THE MARYLAND DEPARTMENT OF THE ENVIRONMENT (DCE) IN A MANNER ACCEPTABLE TO THEM, THE ADDRESS AND DATE OF COMPLETION OF THE BAT INSTALLATION AND THE TYPE OF BAT INSTALLED.
6. ELECTRICAL WORK FOR THE BAT INSTALLATION MUST BE PERFORMED BY A LICENSED ELECTRICIAN.
7. AN AGREEMENT AND EASEMENT MUST BE COMPLETED AND SIGNED BY ALL APPLICABLE PARTIES, AND RECORDED IN LAND RECORDS OR HOWARD COUNTY.
8. THE HEALTH DEPARTMENT REQUIRES DOCUMENTATION FOR THE START-UP CERTIFICATION FROM THE MANUFACTURER PRIOR TO FINAL APPROVAL OF THE INSTALLATION.
9. THE BLOWER MAY NOT BE LOCATED MORE THAN 100 FEET FROM THE TANK BASED ON MANUFACTURER'S SPECIFICATIONS.
10. IF A BUILDING PERMIT IS SUBMITTED ANY TIME IN THE FUTURE, A SEPTIC SYSTEM UPGRADE WILL BE REQUIRED TO FINISH THE AREA CURRENTLY IDENTIFIED AS THE BASEMENT. AT THAT TIME A SEPTIC SYSTEM UPGRADE WILL BE REQUIRED AS FINISHING THE BASEMENT COULD POSSIBLY CREATE A FIFTH BEDROOM PER HOWARD COUNTY CODE 3.80.1(B).

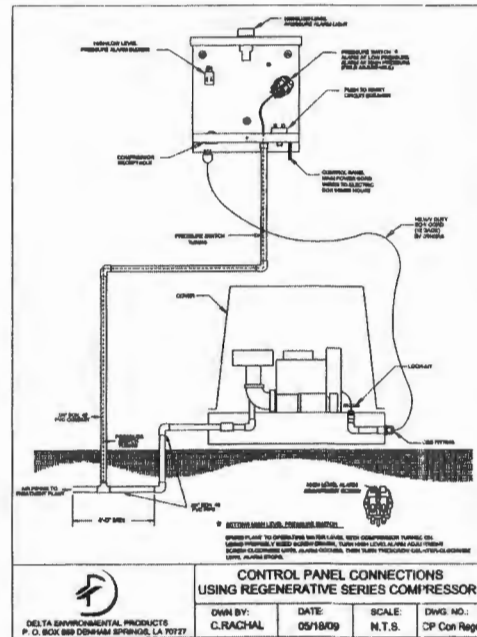

REVISED SITE PLAN FOR ON-SITE SEWAGE DISPOSAL SYSTEM

BRUCE HILL LLC
1834 HIGHLAND WAY
THE ACCORD NO. 183488
LOT 10


CLOVERFIELD - SECTION II

3RD ELECTION DISTRICT - HOWARD COUNTY, MD.
TAX MAP: 8 BLOCK 7 PARCELS 19

Handwritten signature: Bruce Hill LLC 10/19/19

438 East Main Street, Westminster, MD 21157-5939
(410) 846-1780 FAX (410) 846-1781

Date	Revision	Drawn By
3/23/18	REVISED A.T. WELL LOCATIONS AND BAT TANK	Designed By: LDA
10/11/18	REVISED SEPTIC AREA & SYSTEM FOR POOL	Reviewed By: LDA
		Date: 2-2-18
		Drawn: 7-1-20
		Job No.: 2018058
		Sheet: 108 OF 107

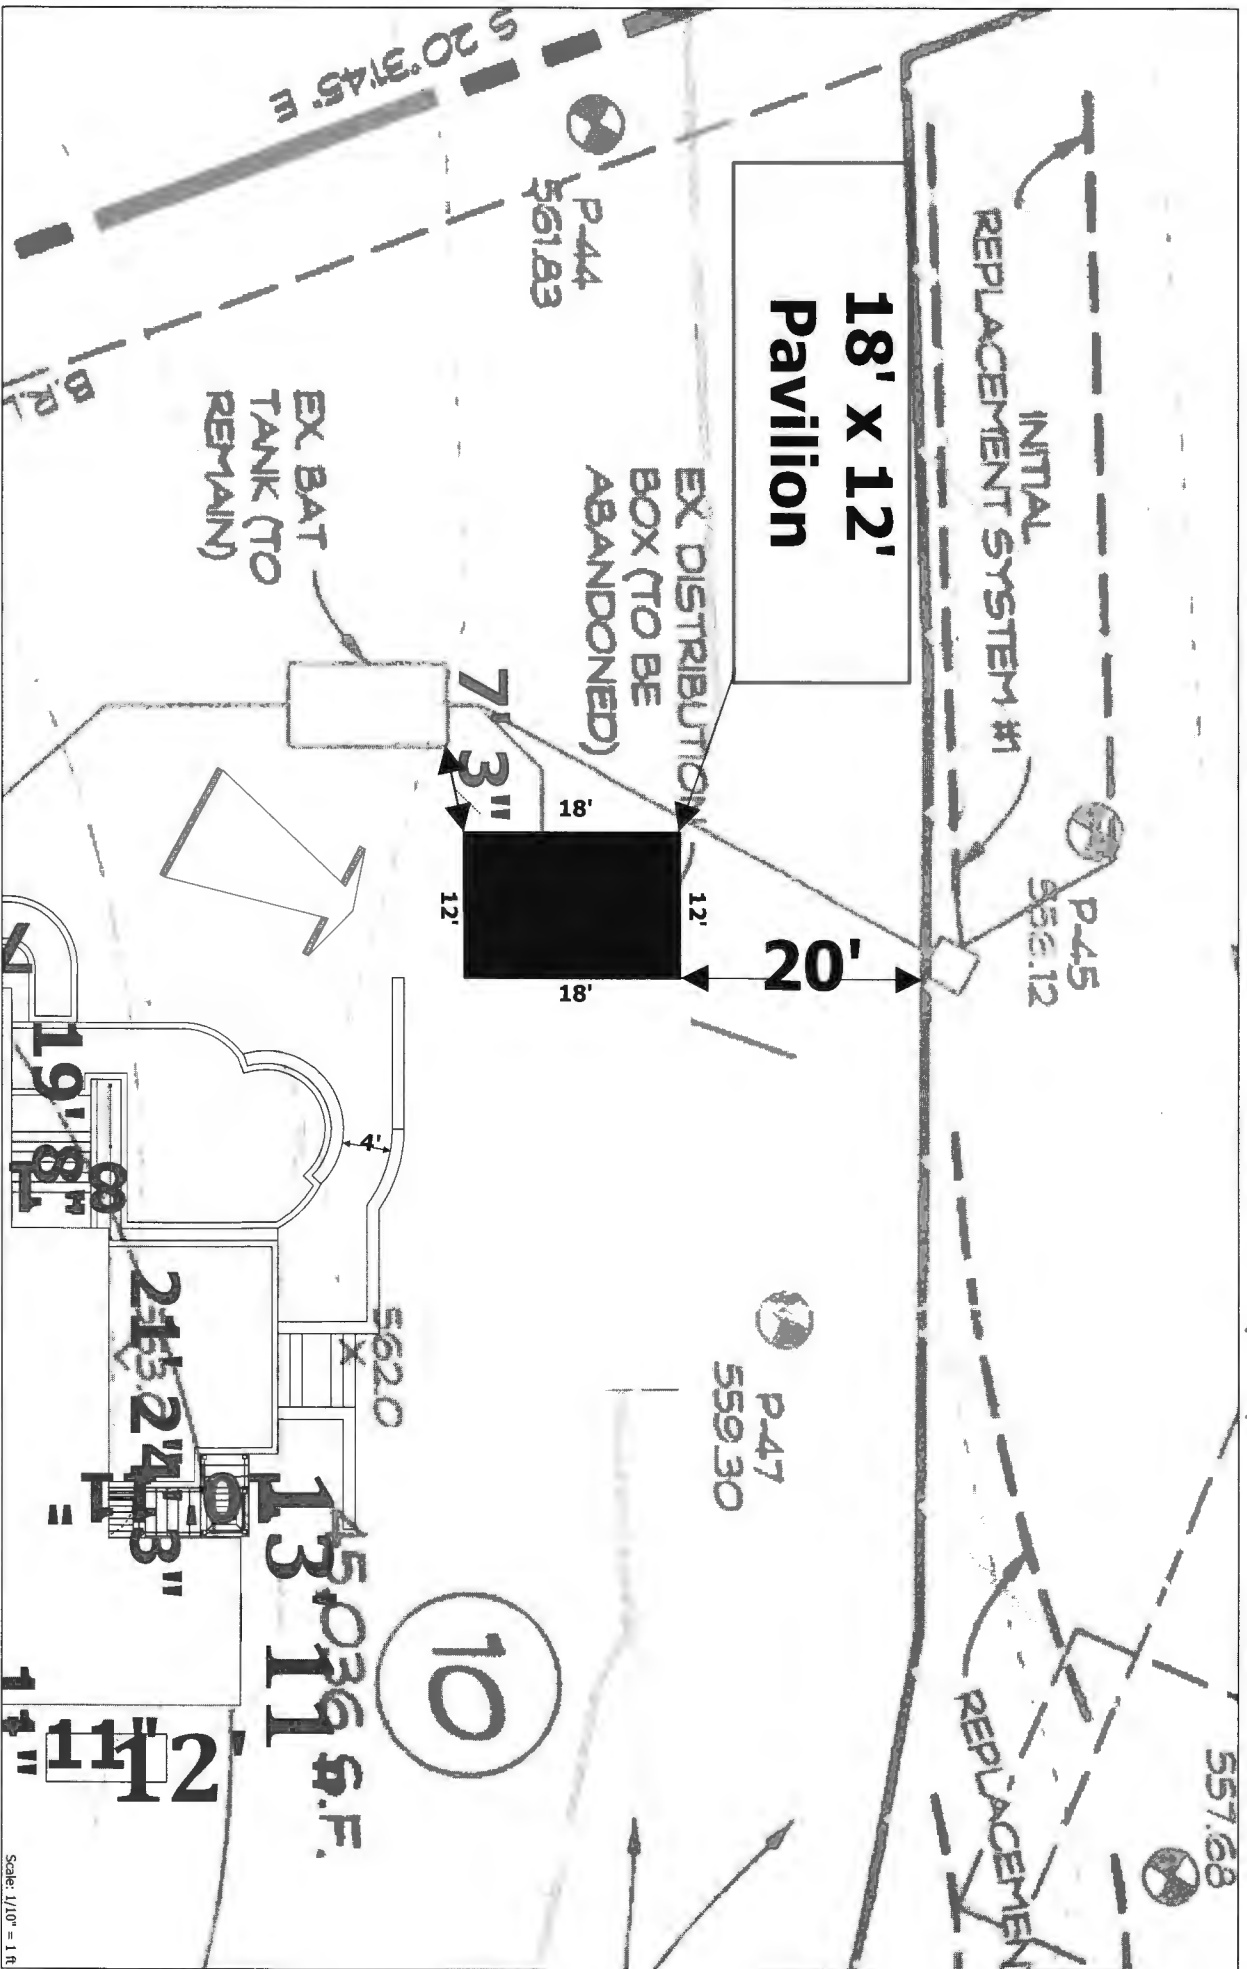

Approved
12/24/2020
4/1/2021


VINYL PAVILION - MANOR & HAMPTON STYLES

POST LOCATION PLAN

FOR FOUR POST UNITS


NOTES:

- ALL DIMENSIONS ARE TO THE CENTER OF THE FOOTINGS / POSTS AND ARE FOR ALL POST SIZES (STANDARD 6" SQUARE, 8" SQUARE AND 10" ROUND COLUMNS).
- STANDARD ROOF DESIGN WITH 12" OVERHANGS, ADD 32" TO DIMENSION SHOWN.

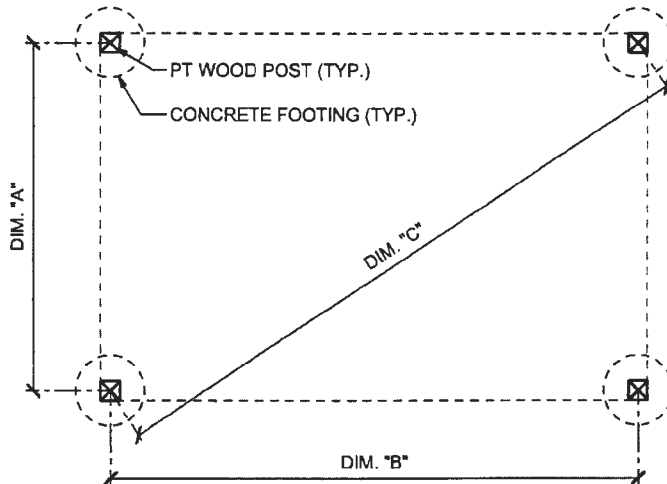


CONCRETE FOOTING REQUIREMENTS:

A MINIMUM OF 18" ROUND FOOTING IS REQUIRED AT EACH POST LOCATION, DUE TO LOCATION OF THE CONCRETE ANCHORS AND POST SIZE. DEPTH PER LOCAL CODE REQUIREMENT.

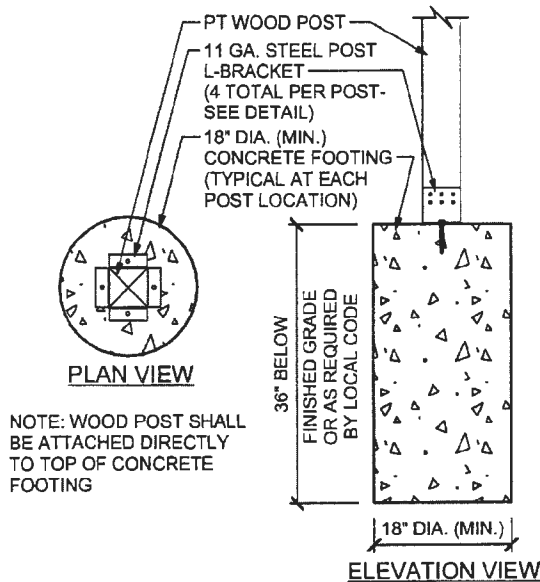

FOUNDATION DETAIL

PAVILION SIZE	DIM. "A"	DIM. "B"	DIM. "C"
8 x 10	6'-4 $\frac{7}{8}$ "	8'-7 $\frac{1}{4}$ "	10'-8 $\frac{3}{4}$ "
8 x 12	6'-4 $\frac{7}{8}$ "	10'-7 $\frac{1}{2}$ "	12'-4 $\frac{7}{8}$ "
8 x 14	6'-4 $\frac{7}{8}$ "	12'-7 $\frac{1}{2}$ "	14'-1 $\frac{7}{8}$ "
10 x 10	8'-7 $\frac{1}{4}$ "	8'-7 $\frac{1}{4}$ "	12'-2"
10 x 12	8'-7 $\frac{1}{4}$ "	10'-7 $\frac{1}{2}$ "	13'-8"
10 x 14	8'-7 $\frac{1}{4}$ "	12'-7 $\frac{1}{2}$ "	15'-3 $\frac{3}{8}$ "
10 x 16	8'-7 $\frac{1}{4}$ "	14'-4 $\frac{7}{8}$ "	16'-9 $\frac{3}{8}$ "
10 x 18	8'-7 $\frac{1}{4}$ "	16'-4 $\frac{7}{8}$ "	18'-6 $\frac{1}{4}$ "
12 x 12	10'-7 $\frac{1}{2}$ "	10'-7 $\frac{1}{2}$ "	15'-0 $\frac{1}{4}$ "
12 x 14	10'-7 $\frac{1}{2}$ "	12'-7 $\frac{1}{2}$ "	16'-6"
12 x 16	10'-7 $\frac{1}{2}$ "	14'-4 $\frac{7}{8}$ "	17'-10 $\frac{7}{8}$ "
12 x 18	10'-7 $\frac{1}{2}$ "	16'-4 $\frac{7}{8}$ "	19'-6 $\frac{1}{2}$ "
14 x 14	12'-7 $\frac{1}{2}$ "	12'-7 $\frac{1}{2}$ "	17'-10 $\frac{1}{4}$ "
14 x 16	12'-7 $\frac{1}{2}$ "	14'-4 $\frac{7}{8}$ "	19'-1 $\frac{7}{8}$ "
14 x 18	12'-7 $\frac{1}{2}$ "	16'-4 $\frac{7}{8}$ "	20'-8 $\frac{3}{8}$ "
16 x 16	14'-4 $\frac{7}{8}$ "	14'-4 $\frac{7}{8}$ "	20'-4 $\frac{1}{2}$ "
16 x 18	14'-4 $\frac{7}{8}$ "	16'-4 $\frac{7}{8}$ "	21'-10"
18 x 18	16'-4 $\frac{7}{8}$ "	16'-4 $\frac{7}{8}$ "	23'-2 $\frac{1}{2}$ "
20 x 20	18'-4 $\frac{7}{8}$ "	18'-4 $\frac{7}{8}$ "	26'-0 $\frac{3}{8}$ "

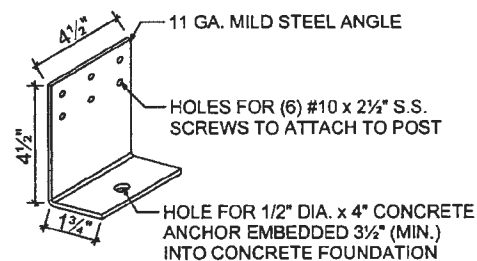

L-BRACKET DETAIL

HOMEOWNER / CONTRACTOR:

IT IS YOUR RESPONSIBILITY TO MAKE SURE THAT THE FOOTINGS ARE IN THE EXACT LOCATION AND AT THE CORRECT HEIGHT. DOUBLE CHECK ALL DIMENSIONS BEFORE AND AFTER THE CONCRETE IS POURED. IF THE BUILDER ARRIVES AT THE SITE AND THE FOOTINGS ARE NOT IN THE CORRECT LOCATIONS, THEY WILL NOT BE ABLE TO INSTALL YOUR STRUCTURE. ADDITIONAL CHARGES WILL APPLY TO COVER THE LABOR AND MILEAGE COSTS.

UPDATED 8/7/19

CREATIVE GAZEBOS