

6/11/64

PERMIT

approved
9/11/64
aw

P 08554

A 08048

SEWAGE DISPOSAL SYSTEM

MARYLAND STATE DEPARTMENT OF HEALTH

HOWARD COUNTY

ELLICOTT CITY

INDEXED

DISTRICT 1

DATE 6/5/64

Louis D. Hook & Sons IS PERMITTED TO INSTALL 2 ALTER

ADDRESS 6425 Baltimore National Pike, Catonsville 28 PHONE RI 7-7053

A SEWAGE DISPOSAL SYSTEM LOCATED AT

SUBDIVISION ROAD Ilchester Road LOT

PROPERTY OWNER Girls Scout Council of Central Maryland

ADDRESS 128 W. Franklin St., Baltimore 21201

SPECIFICATIONS

DRAIN FIELD DEPTH FEET, BOTTOM AREA SQ. FT.

SEEPAGE PITS ABSORBENT SIDE-WALL AREA SQ. FT.

SEPTIC TANK CAPACITY 750 GALLONS

FOR GARBAGE GRINDER, INCREASE DISPOSAL AREA 22% & TANK CAPACITY 50%.

OTHER Dry well - 12 ft. diameter and 8 ft. deep below inlet pipe.

Inlet pipe to be at least 4 ft. below grade.


Place dry well about 48 ft. from edge of concrete porch.

PLANS APPROVED BY D. W. Monaghan DATE 6/2/64

FILL SEPTIC TANK AND DISTRIBUTION BOX WITH WATER BEFORE CALLING FOR AN INSPECTION. COVER NO WORK UNTIL INSPECTED AND APPROVED.

NEITHER THE HOWARD COUNTY COMMISSIONERS NOR THE HEALTH DEPARTMENT IS RESPONSIBLE FOR THE SUCCESSFUL OPERATION OF ANY SYSTEM.

A 08048

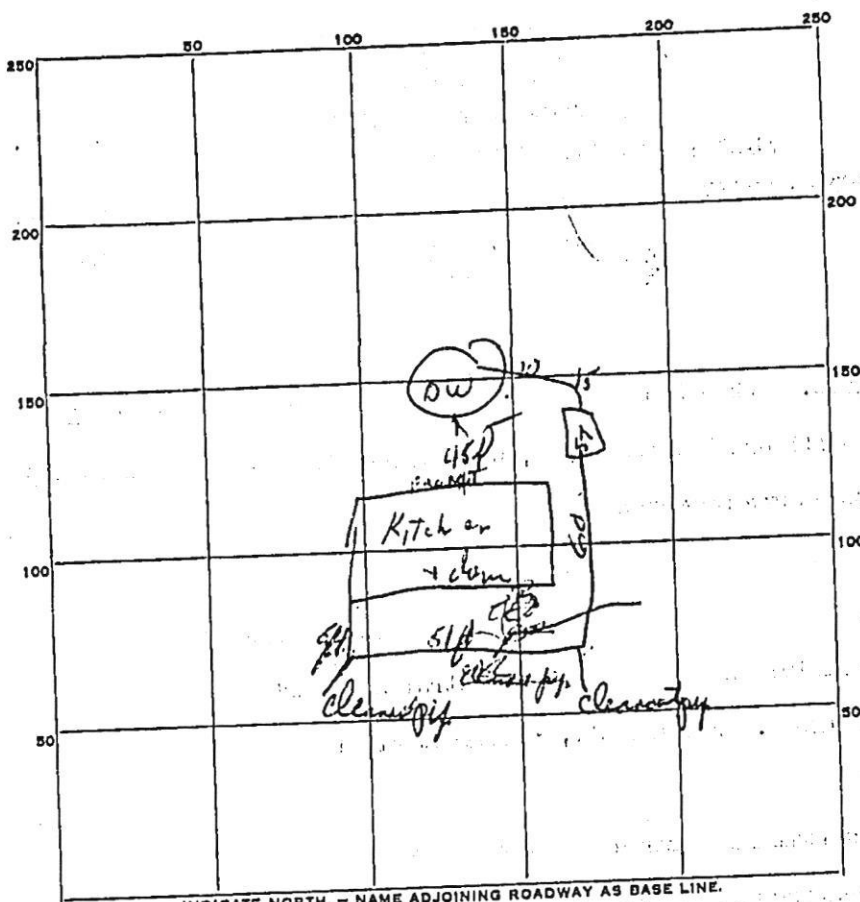

PERMIT CARD _____

SEPTIC TANK, LEVEL OK

CLEANOUTS 5/12

DISTRIBUTION BOX, LEVEL _____

TILE FIELD, DEPTH _____ FT. TRENCH WIDTH _____ FT.

GRAVEL DEPTH _____ IN. TOTAL LENGTH _____ FT.

NUMBER OF TRENCHES _____ TOTAL BOTTOM AREA _____

SEEPAGE PITS, INSIDE DIAMETER 12 FT. DEPTH BELOW INLET 8 1/2 FT.

ABSORBENT AREA 300 + SQ. FT.

REMARKS _____

DATE SYSTEM APPROVED 2/11/64

INSPECTOR Rev. M. M. M.

APPLICATION

SEWAGE DISPOSAL TESTING

MARYLAND STATE DEPARTMENT OF HEALTH

A 08048

P

HOWARD COUNTY

ELLICOTT CITY

DISTRICT 1

DATE 2/18/64

6/2/64. as agent for
Girl Scout Council I certify
that this proposed system
will be used only for
kitchen waste and that
there will be no toilet
or wash-shower facilities
added at any time.

James McManus

TO: THE COUNTY HEALTH OFFICER
ELLICOTT CITY, MARYLAND

I, HEREBY, APPLY FOR THE NECESSARY TESTS IN ORDER TO CONSTRUCT (OR RECONSTRUCT) A SEWAGE
DISPOSAL SYSTEM.

PROPERTY OWNER Girl Scout Council of Central Maryland

ADDRESS 128 W. Franklin St., Baltimore 21201 PHONE 685-1122

PROPERTY LOCATION:

SUBDIVISION _____ LOT NO. _____

ROAD AND DESCRIPTION Ilchester Road - approx. 1 mile from Montgomery Rd. on left.

OCCUPANT _____ PHONE _____

PERSON TO CONSTRUCT SYSTEM _____

ADDRESS _____ PHONE _____

SIZE OF LOT 23 acres TYPE BLDG. camp building

IF NOT SINGLE RESIDENCE DESCRIBE 36 persons using facilities NUMBER OF BEDROOMS _____

SIGNATURE OF APPLICANT *James McManus*

APPROVED BY *DW Monaghan* FOR *Dr. Will* DATE 6/2/64


REJECTED BY _____ FOR _____ DATE _____

HOLD PENDING FURTHER TESTS _____ DATE _____

REASONS FOR REJECTION OR HOLDING 5-2614 to install holes 1 & 2 for dry well at greater

depth 9 F.T. or holes 1 and 2 for hole at 9 or 10 ft. H.

THIS IS NOT A PERMIT

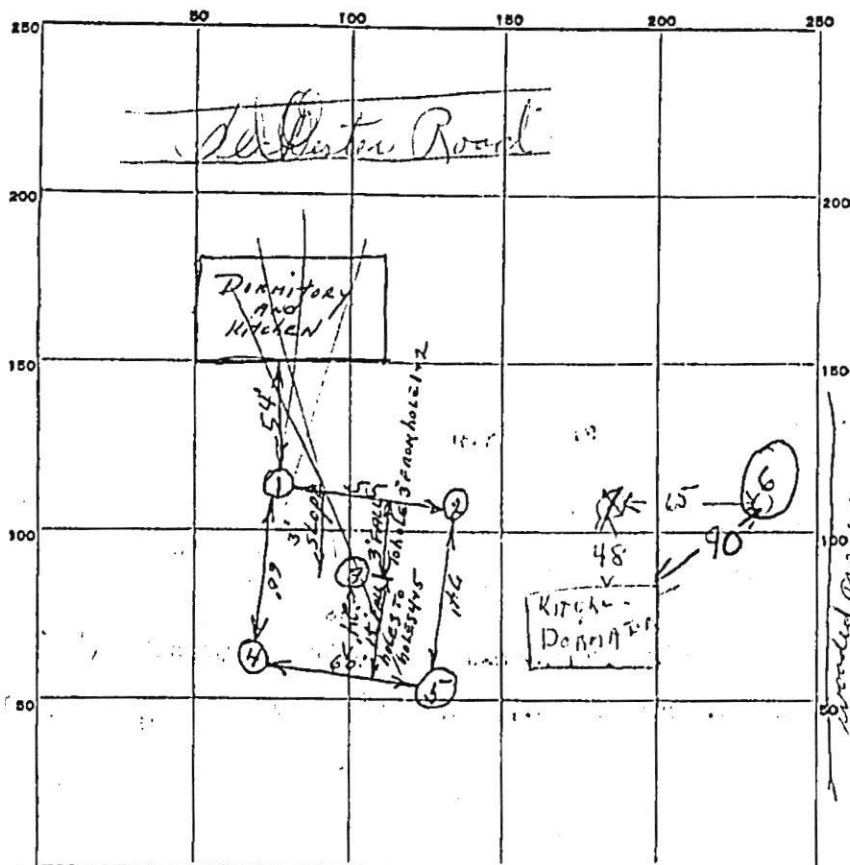

INDICATE NORTH. - NAME ADJOINING ROADWAY AS BASE LINE.

Dehster Rd

DATE	TEST NO.	DEPTH	PRE-WET		TEST - 1" DROP		TIME
			START	STOP	START	STOP	
5-26-64	1	6'	1:26	overtime			
	2		1:32	2:11	2:11	overtime	
	3	7 1/2	1:42	1:45	1:45	1:52	7 Min.
	4	5	1:53	1:56	1:56	2:00	4 Min.
	5	5 3/4	2:06	2:09	2:09	2:15	6 Min.
6/2/64	6	9 1/2	gravel - but - root				
	7	11 1/2	1:55	2:00	2:00	2:25	25 min.

SOIL AUGER FINDING.

TESTED BY

REMARKS

ALSO PRESENT

LOT NO.

Control No. 14814

WATER INSTALLATION RECORD

Application No. 1-91-1046

Acct. Control

Date Applied 5-21-91

Type of Installation:

Date Water Acct.

Future ☐ Capital Project ☐ Utilities ☐ Dev. Agreement ☐ ADO No. ☐

Applicant Girl Scouts Of America
Address 5042 Ilchester Road
Elkridge, Md. 21227

Size Tap

Size Meter

Phone No.

1" WMC

3/4" Meter

SKETCH

Date of Tap
Length of Connection

Diameter

Kind of Pipe

Size of Corp. Cock

Meter Size 3/4

Make Baldwin

Number 6955271

Date of Meter Setting 5-23-91

Meter Location Pit Inside

Location

Remote Right Side Bldg
Right side Kitchen

Reading:

Meter 000 Remote 000

Installed By B. Bogdan

BUREAU OF UTILITIES

SEWER INSTALLATION RECORD

Application No. 2-90-2330Date Applied 6-28-90Date Sewer Acct. S/Add Info.
W/Add Info.

(Circle One)

Acct. No. 31-40-7360

W&S Contract No.

Rebate Contract 208-W10-1214

Street

ILCHESTER Road

House No.

5042

Lot No.

Parcel 146

Block No.

Subdivision

Camp Ilchester

Type of Property

CAMPTown or Vicinity
(and Zip Code)ELK RIDGEApplicant
AddressGirl Scouts of Md.

Phone No.

Control No.

14501

Size S.H.C.

6

Acct. Control

Type of Installation:

Future ☐Capital Project ☐Utilities ☒Dev. Agreement ☐ADO No. ☐WITH 1446

Depth of Sewer

Lateral

Length of Conn. from DH MH

Plugged Sewer Information:

BUREAU OF UTILITIES

Control No. 14500

WATER INSTALLATION RECORD

Application No. 1-90-2310

Acct. Control

Date Applied 6-28-90

Type of Installation:

Date Water Acct.

Future ☐ Capital Project ☐ Utilities ☐ Dev. Agreement ☐ ADO No. ☐

Applicant

Size Tap

Size Meter

Address

Girl Scouts Of Maryland

703 W. 40th Street

Phone No.

Baltimore, Maryland 21211

1" Meter

Date of Tap

SKETCH

Length of Connection

Diameter

Kind of Pipe

Size of Corp. Cock

Meter Size

Make BADGER

Number 6586827

Date of Meter Setting 5-7-91

Meter Location ☐ Pit ☒ Inside

Location

W.B. ON FRONT

Reading:

Meter 0 Remote 0

Installed By TB

BUREAU OF UTILITIES

SEWER INSTALLATION RECORD

Application No. _____

Date Applied _____

Date Sewer Acct. _____

Acct. No. _____

S/Add Info,
W/Add Info.

(Circle One)

W&S Contract No. 208-W
Rebate Contract

Street

Ilchester Road

House No.

5042

Lot No.

Parcel 146

Block No.

Subdivision

Camp Ilchester

Type of Property

CAMP

ILCHESTER

Town or Vicinity
(and Zip Code)

ELK RIDGE

Applicant
Address

Girl Scouts of Maryland

Phone No.

Control No.

Size S.H.C.

Acct. Control

Type of Installation:

Future ☐Capital Project ☐Utilities ☐Dev. Agreement ☐ADO No. ☐

Depth of Sewer

Lateral

Length of Conn. from DH MH

Plugged Sewer Information:

BUREAU OF UTILITIES

Control No. 14500

WATER INSTALLATION RECORD

Application No. 1-90-2311

Acct. Control

Date Applied 6-28-90

Type of Installation:

Future ☐

Capital Project ☒

Utilities ☒

Dev. Agreement ☐

ADO No. #1446 ☒

Date Water Acct. _____

Applicant Address

Girl Scouts Of Maryland
730 W. 40th Street
Baltimore, Md. 21211

Size Tap

Size Meter

4" WHC

X2 1/2

Date of Tap

Length of Connection

Diameter

Kind of Pipe

Size of Corp. Cock

Meter Size

Make

Number

Date of Meter Setting


Meter Location

Location

Pit

Inside

SKETCH

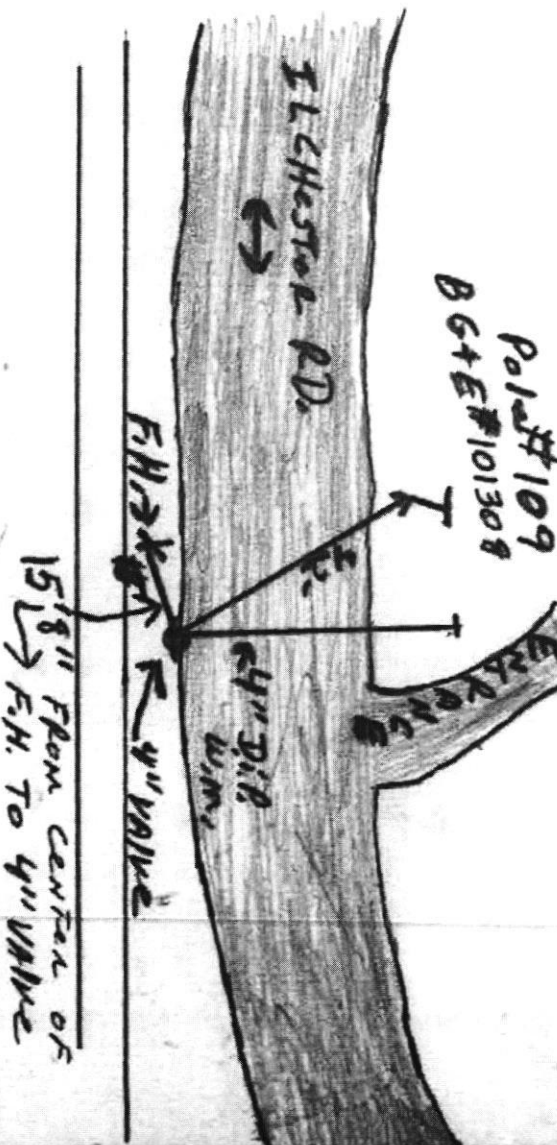

Reading:

Meter

Remote

Installed By

BUREAU OF UTILITIES

HOWARD COUNTY METROPOLITAN COMMISSION

Record Posted	W	S
H. C. Book		
208 W		
50' Sheet No.		

RECORD OF 31-40-7363 Date
 INSTALLATION OF SEWER CONNECTION Installed by
 Tap Insp. by Date

Street	House No.	Lot No.	Block No.	Subdivision	Permit No.
Ilchester Road	5042				
Type of Property	District		Town or Vicinity		
Girl Scout Camp			Ellicott City		
Applicant	Plumber		Application Filed for		

DATA CONCERNING INSTALLATION

First - Second	On	Double with Lot	DATE CONSTRUCTED
Single			Started: Completed:

Depth of sewer invert at property line Diameter and kind of pipe used
 Length of connection

EC 311-H

HOWARD COUNTY METROPOLITAN COMMISSION

33-1518

February 28, 1968

Inspector's Signature

[Signature]

Date *2/28/68*
Inspector's Initial *DB*

CONNECTION

Installed by

TEC


tion Filed For

meter & 1" tap

Plumbing Permit No.

13873

TRIANGULATION

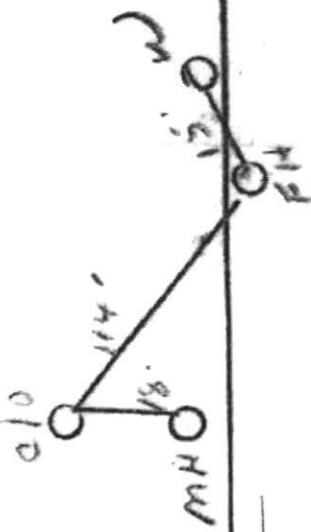

TRIANGULATION

W/S Permit No.

774791

Date

15-01-68

4707351

Date of Meter Setting

5-2-68

Brief description of Meter Location

6' Back of NW corner of Pole #101309

COMPLETION OF OFFICE RECORDS

Meter Card Record

5-3-68

Meter Sheet and Completion Record

Assessment Record

G&E Pole #101311

8" W

5' 13' 0"
G&E Pole #101309

(See Other Side for Sewer Connection Data)

ILLCHESTER RD.

SEWER INSTALLATION RECORD

Application No. _____

Date Applied _____

Date Sewer Acct. _____

Acct. No. 31-40-7361

S/Add Info.
W/Add Info.

(Circle One)

W&S Contract No. 208-JW
Rebate Contract

Street

Rlchester Road

House No.

5042

Lot No.

Parcel 146

Block No.

Subdivision

Camp Rlchester

Type of Property

CAMP

RlCHESTER

Town or Vicinity
(and Zip Code)

ELK RIDGE

Applicant
Address

Girl Scouts of Md.

Phone No.

Control No.

Size S.H.C.

Acct. Control

Type of Installation:

Future ☐Capital Project ☐Utilities ☐Dev. Agreement ☐ADO No. ☐

Depth of Sewer

Lateral

Length of Conn. from DH MH

Plugged Sewer Information:

BUREAU OF UTILITIES

Control No. 14500

WATER INSTALLATION RECORD

Application No. FP-90-072

Acct. Control

Date Applied 6-28-90

Type of Installation:

Date Water Acct.

Future ☐ Capital Project ☐ Utilities ☐ Dev. Agreement ☐ ADO No. #1446 ☒

Applicant Girl Scouts Of Maryland
Address 730 W. 40th Street
Baltimore, Maryland 21211

Size Tap

Size Meter

Phone No.

4" Detector Check

Date of Tap

SKETCH

Length of Connection

Diameter

Kind of Pipe

Size of Corp. Cock

Meter Size 5/8

Make BADGER

Number 68 40 112

Date of Meter Setting 5-7-91

Meter Location ☐ Pit ☒ Inside

Location

WB ON FRONT

Reading:

Meter ☐ Remote ☐

Installed By TB

BUREAU OF UTILITIES

SEWER INSTALLATION RECORD

Application No. _____

Date Applied _____

Date Sewer Acct. _____

S/Add. Info.
W/Add. Info.

(Circle One)

Acct. No. 31-10-7358

W&S Contract No. 208-M
Rebate Contract

Street

Richester Road

House No.

5042

Lot No.

Parcel 146

Block No.

Subdivision

Camp Richester

Type of Property

Town or Vicinity
(and Zip Code)Applicant
Address

Same As Above

Phone No.

Control No.

Size S.H.C.

Acct. Control

Type of Installation:

Future ☐Capital Project ☐Utilities ☐Dev. Agreement ☐ADO No. ☐

Depth of Sewer

Lateral

Length of Conn. from DH MH

Plugged Sewer Information:

BUREAU OF UTILITIES