


185
7410

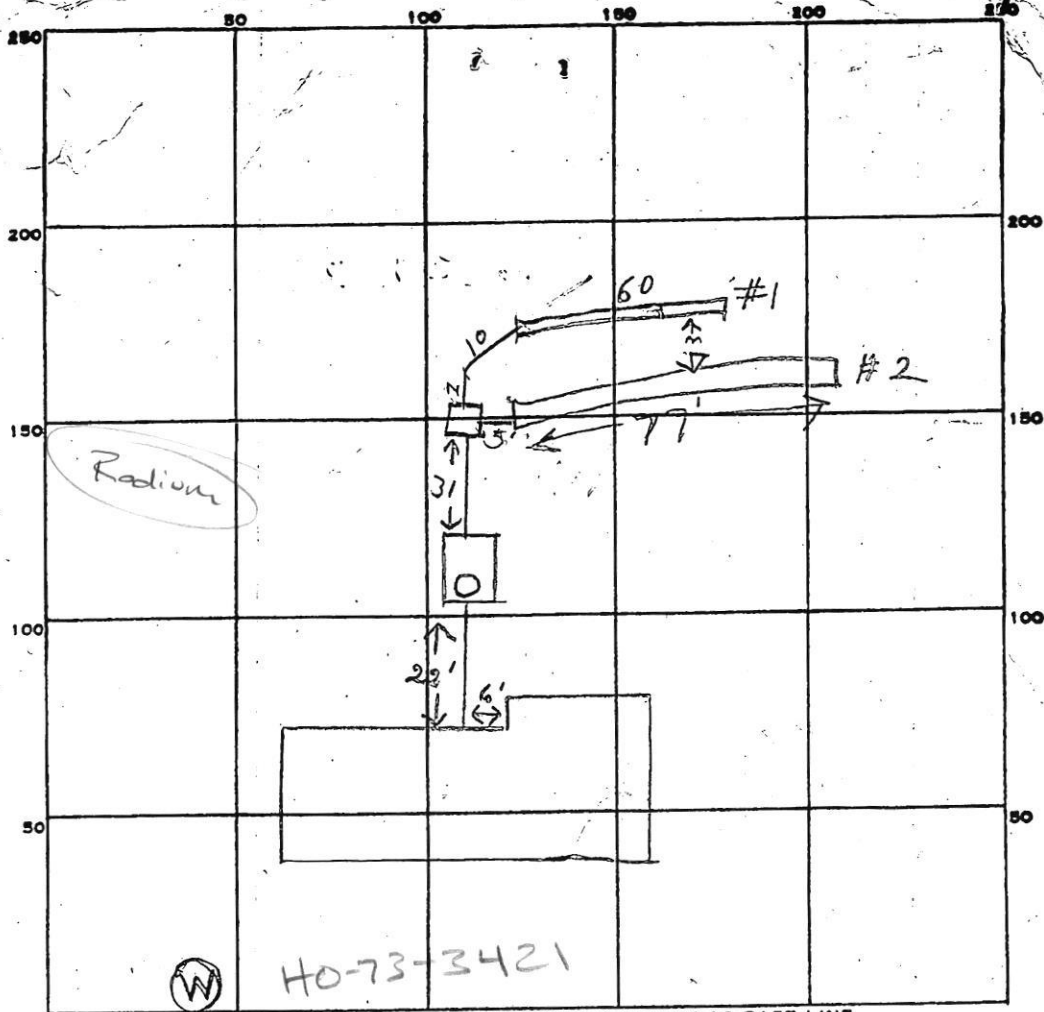

INDICATE NORTH. - NAME ADJOINING ROADWAY AS BASE LINE.

Fonside Rd.

PERMIT CARD

SEPTIC TANK, LEVEL

✓ 1500 gal

CLEANOUTS

ST

DISTRIBUTION BOX, LEVEL

✓

Mandible

TILE FIELD, DEPTH

#1 10 1/2 FT. #2

TRENCH WIDTH

2

FT. #2

360

GRAVEL DEPTH

6 1/2 IN. #1 #2

TOTAL LENGTH

60 77 FT. #1 #2

NUMBER OF TRENCHES

2

TOTAL BOTTOM AREA

#1	#2	TOTAL
360	402	762

SEEPAGE PITS, INSIDE DIAMETER

FT.

DEPTH BELOW INLET

FT.

ABSORBENT AREA

SQ. FT.

REMARKS

10/18/83 OK to cover work to date. R.H.

10/20/83 - OK TO ADD STONE TO DITCH #1 R.H.

10/20/83 PM - STONE ADDED TO DITCH #1 OK TO COVER R.H.

4 BR-740 SFT REQUIRED R.H.

10/21/83 OK to add stone in #2 trench R.H.

10/22/83 2:00 PM - STONE ADDED IN #2 TRENCH R.H.

DATE SYSTEM APPROVED

10/21/83

INSPECTOR

Raymond Hodger

HOUSE:
RST FLOOR 348.0
CEMENT 339.0
VERT 337.29

PTIC TANK:
LISTING GRADE 344.8
POSED GRADE 346.0
VERT IN 336.98
VERT OUT 336.73

STRICTION BOX:
LISTING GRADE 341.1
POSED GRADE 341.1
VERT 336.10

ENCHES:

WIDTH	LENGTH	STONE	INVERT	BOTTOM
2'	80'	5"	335.9	328.9 #1
2'	40'	5"	335.0	328.0 #2


PLOT PLAN
LOT 36 FARSIDE

3rd ELECTION DISTRICT
HOWARD COUNTY MARYLAND

SCALE 1"=50' DATE 1/21/83

I certify the above measurements and elevations to be true and actual for this property.

J. Carl Hudging
J. Carl Hudging

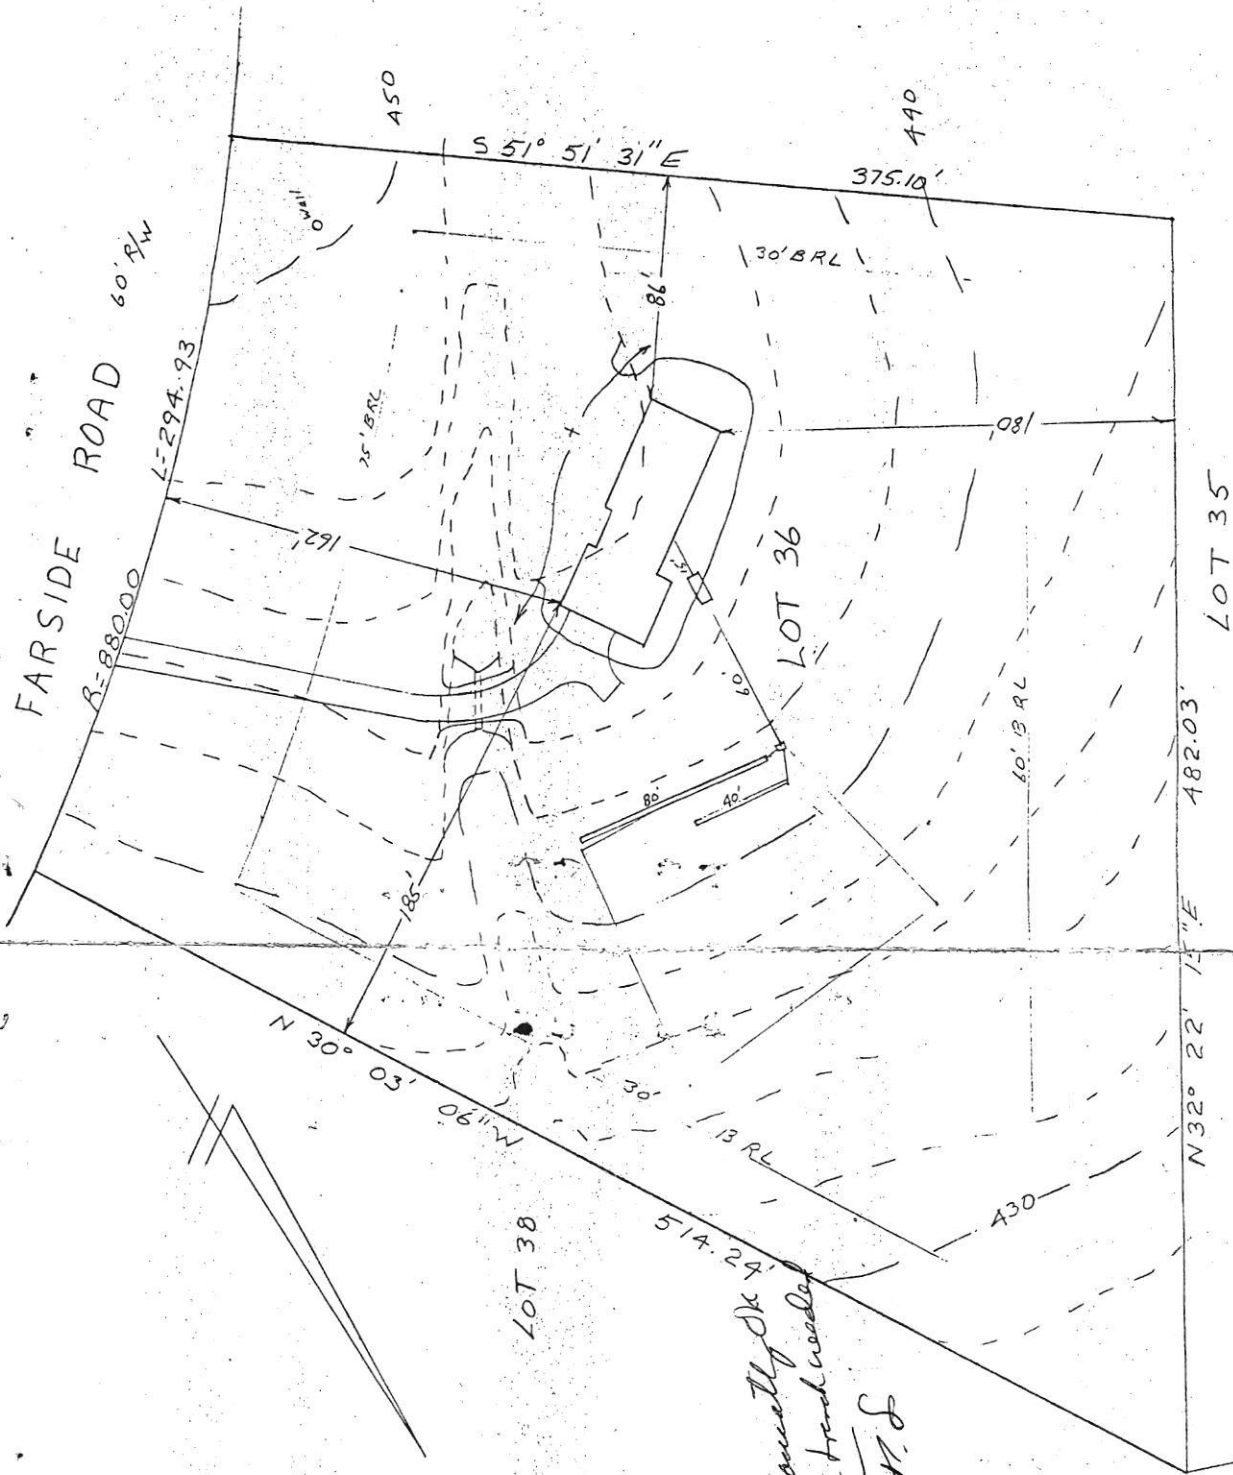

4/11/83
Sketch correctly OK
Met more hand wooded
J.F.S.