

Record Detail * (This section is required.)

Permit Type	Permit Number	Opened Date
Building/Residential/Misc/Pool Spa	B26002247	06/30/2026
Description of Work		
SFD/CONSTRUCT L SHAPED 32' X 34' INGROUND NON-DIVING CONCRETE POOL, EXISTING FENCE TO CODE**SUBJECT TO FIELD INSPECTION**		

[check spelling](#)

ON HOLD, needs perc testing.

gls 7/13/26

Address * (This section is required.)

Search	Reset	Clear	Get Parcel & Owner
Street #	Street Name	Street Type	
7535	BROWNS BRIDGE	RD	
Unit Type	Unit #	X Coordinate	Y Coordinate
--Select--		-76.94618	39.16084
City	State	Zip Code	Primary
HIGHLAND	MD	20777	Yes

PC waiver approved,
BP also approved.

gls 7/24/26

Parcel * (This section is required.)

Search	Reset	Clear	Get Address & Owner			
GIS ID *	Parcel	Parcel Area	Land Value	Improved Value	Exemption Value	Plan Area
846893	236	1	276200	634000	357800	RURAL
Legal Description						
LOT 2 []7535 BROWNS BRIDGE RD []HIGHLAND ACRES						

[check spelling](#)

Block	Lot	Census Tract	Council Dist	Inspection Dist	Supervisor Dist	Map #	DAP Zone
	2	605102	4				
Plan Area	State Tax Id	Subdivision Name					
	1405351014	HIGHLAND ACRES					
Section	Area	Tax Map					
		40					
Grid	Zoning District	ADC Map					
40-18	RR-DEO	5051-J5					
SDP No.	Final Plan No.	WP File No.					
Record Plat No.	WS Contract No.	FDP No.					
9 67							
Owner Occupied	Year Built	Historic District					
☐ Yes ☐ No	1964	☐ Yes ☒ No					
Historic District Registry No.	Stat Area	Flood Plain					
	5-15A	☐ Yes ☒ No					
Building No							

Owner * (This section is required.)

Search	Reset	Clear
Name *		
Michael		
Address Line 1		
7535 Browns Bridge Rd		
Address Line 2		
Address Line 3		
Mail City		
Highland		
Mail State		
MD		
Mail Zip Code		
20777		

Phone
804-516-8487
Primary
Yes
E-mail
mgrosder@gmail.com
Cell Number
Fax Number

Professionals (This section is not required.)

License # *
08050146833
Business Name
PATRIOT POOLS LLC
License Type *
MHIC Co
First Name
ANDREW
Middle Name
STEVEN
Last Name
GRILL
Primary
Yes
Address Line 1
753 ROLLING VIEW DRIVE
Address Line 2
City
ANNAPOLIS
State
MD
ZIP Code
21409-0000
Phone 1
4103202840
Phone 2
Fax
E-mail
PATRIOTPOOLSMD@GMAIL.COM

Applicant (This section is not required.)

Search As Owner As Lic. Prof As Contact

Type *
Applicant
Relationship
Applicant
Primary
Yes
First Name
Victor
MI
Last Name
Skinner
Full Name
Victor Skinner
Organization Name
Scorpion Designs
Street Address
7808 Beddington Ct
Address Line 2
City
Clinton
State
MD
Zip Code
20735
Phone
240-804-7350
Cell
Fax
E-mail *
designingscorpion@gmail.com

Addtl Info


Est Construction Cost *
45000
Housing Units *
0
Number of Buildings *
0
Public Owned
No
Construction Type
649 - All Other Buildings and Structures

POOL INFORMATION

MISCELLANEOUS POOL INFORMATION

Capital Project-No Fee *
☐ Yes ☒ No
Capital Project Number
(Text)
Fee Exempt *
☐ Yes ☒ No
Water Supply *
Private
Sewage Disposal *
Private
Existing Use *
SFD
Type of Pool or Spa *
In Ground Pool
Pool Safety Device *
Fence
Electrical Permit Number
Expiration Date
(Text) 1/10/2027

Submit Cancel

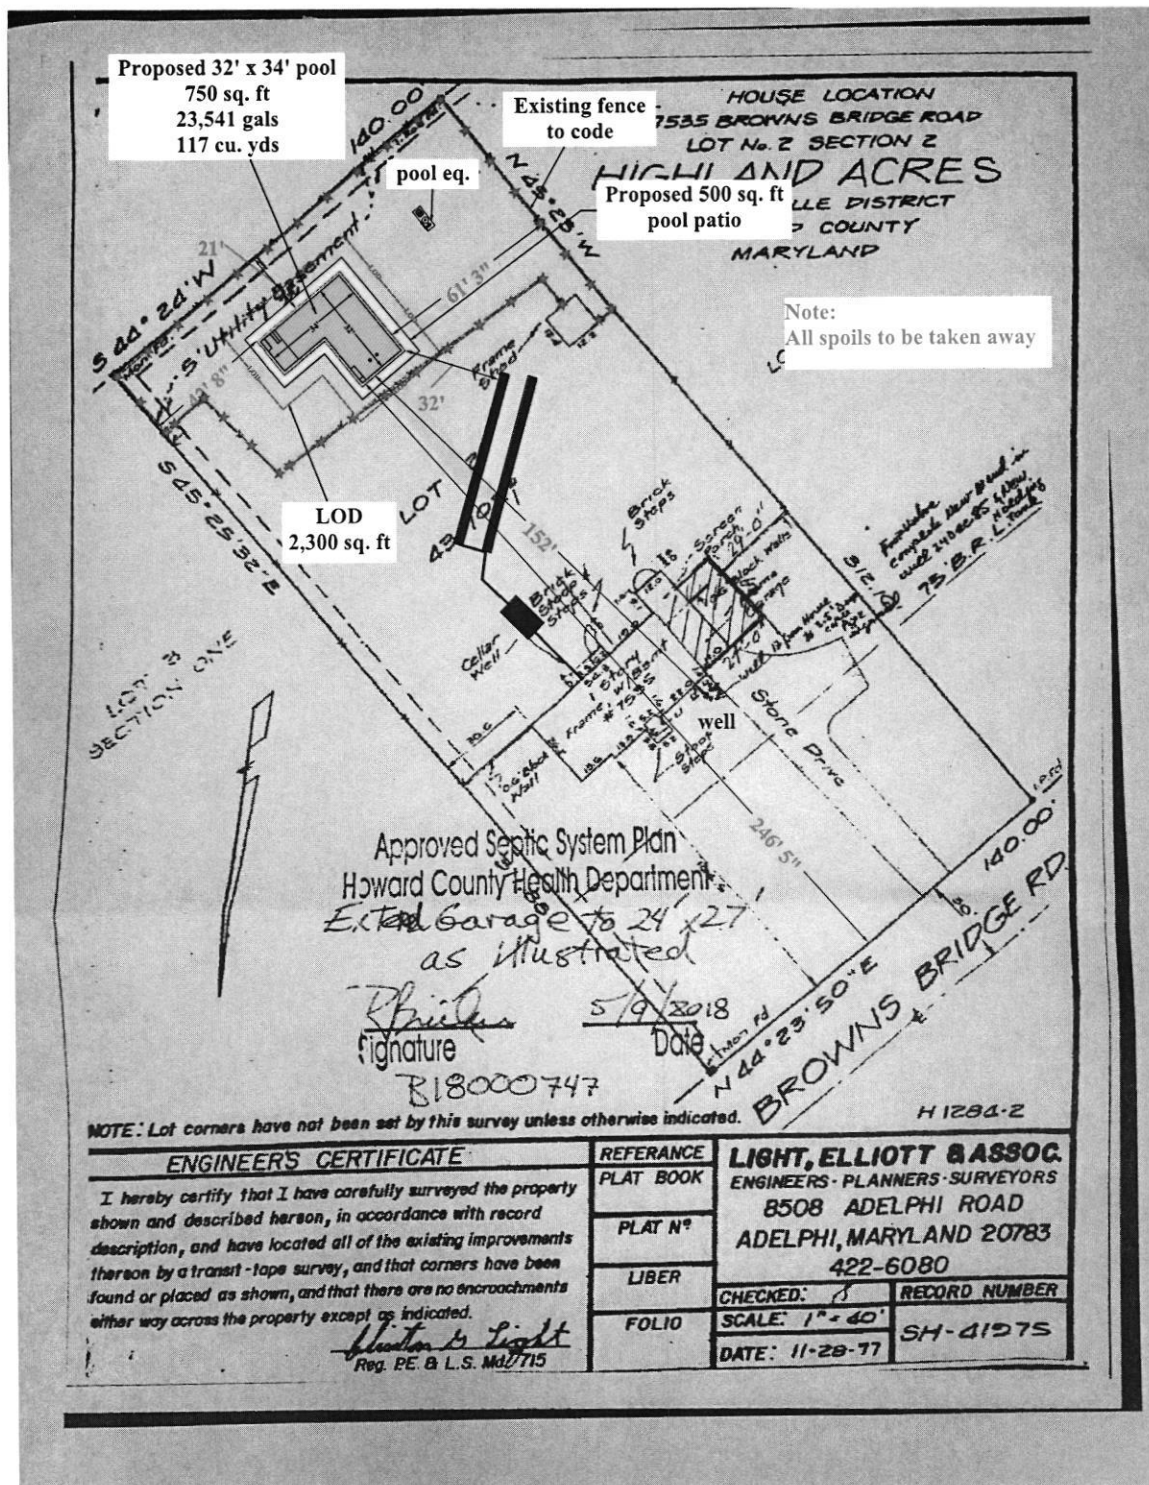

Michael Roeder
7535 Browns Bridge Rd
Highland MD 20777

well/septic
print on 11x 17 sheet

Scale: 1" = 40'
District: 05
Subdivision: 2001
Account #: 351014
Map: 0040, Grid: 0018, Parcel: 0236
Howard County