

Maura J. Rossman, M.D., Health Officer

**APPLICATION**  
**FOR PERCOLATION TESTING AND SITE EVALUATION**

**PROPERTY LOCATION**

SUBDIVISION/PROPERTY NAME \_\_\_\_\_

PROPERTY ADDRESS 5325 Kerger Road Ellicott City 21043  
STREET TOWN ZIP

TAX ACCOUNT # 185527 TAX MAP 0031 GRID 0022 PARCEL 0654 LOT NO. 48 PROPOSED LOT SIZE (ACRES) 3+

ZONING CATEGORY \_\_\_\_\_ TIER \_\_\_\_\_

**PROPERTY OWNER(S)** Phillip Quick

DAYTIME PHONE \_\_\_\_\_ CELL 410-790-9066 EMAIL Pquickjr@gmail.com

MAILING ADDRESS 5325 Kerger Road Ellicott City 21043  
STREET CITY, STATE ZIP

**APPLICANT** Hatfields Equipment Inc RELATIONSHIP TO OWNER: Contractor

DAYTIME PHONE 301-490-4289 CELL 410-984-0101 EMAIL khathfield@hatfieldsequipment.com

MAILING ADDRESS P o Box 519 Annapolis Junction MD 20701  
STREET CITY, STATE ZIP

**I HEREBY APPLY FOR THE NECESSARY TESTING/EVALUATION PRIOR TO ISSUANCE OF SEWAGE DISPOSAL SYSTEM PERMIT(S):**

**PROPERTY:**

- ☐ SUBDIVISION: NUMBER OF LOTS INCLUDING RESIDUE: \_\_\_\_\_  
SUBDIVISION CLASSIFICATION (PER DEPT. OF PLANNING AND ZONING) ☐ MAJOR ☐ MINOR
- ☐ CONSTRUCT NEW OSDS ON UNDEVELOPED LOT
- ☒ REPAIR OR REPLACE FAILING OSDS
- ☐ UPGRADE EXISTING OSDS

**BUILDING:**

- ☐ RESIDENTIAL WITH 4 EXISTING OR PROPOSED BEDROOMS IN THE COMPLETED STRUCTURE
- ☐ COMMERCIAL (PROVIDE DETAIL OF TYPE OF USE AND NUMBERS OF EMPLOYEES/CUSTOMERS ON ACCOMPANYING PLAN)

IS THE PROPERTY WITHIN 2500 FEET OF ANY RESERVOIR?

- ☐ YES
- ☒ NO

AS APPLICANT, I UNDERSTAND THE FOLLOWING:

- THIS APPLICATION IS VALID FOR TWO(2) YEARS FROM DATE OF FEE PAYMENT AND APPROVAL IS BASED UPON HEALTH OFFICER SIGNATURE OF A PERC CERTIFICATION PLAN PRIOR TO EXPIRATION OF THIS PERMIT.
- THE APPLICATION FEE IS NON-REFUNDABLE
- THIS APPLICATION MUST BE ACCOMPANIED BY ALL APPLICABLE FEES AND A SUITABLE SITE PLAN IN ORDER TO BE PROCESSED
- THIS IS A PUBLIC DOCUMENT


I declare and affirm that to the best of my knowledge, the information contained herein is correct. I declare that I am the owner of the property or duly authorized to make this application on behalf of the owner. I agree to comply with all applicable state and county regulations.

By signature of this application, I hereby grant Howard County Health Department officials the right to enter onto the property for the purpose of inspecting the property as directly related to the requested permit/service.

SIGNATURE OF APPLICANT

DATE

(wet season)

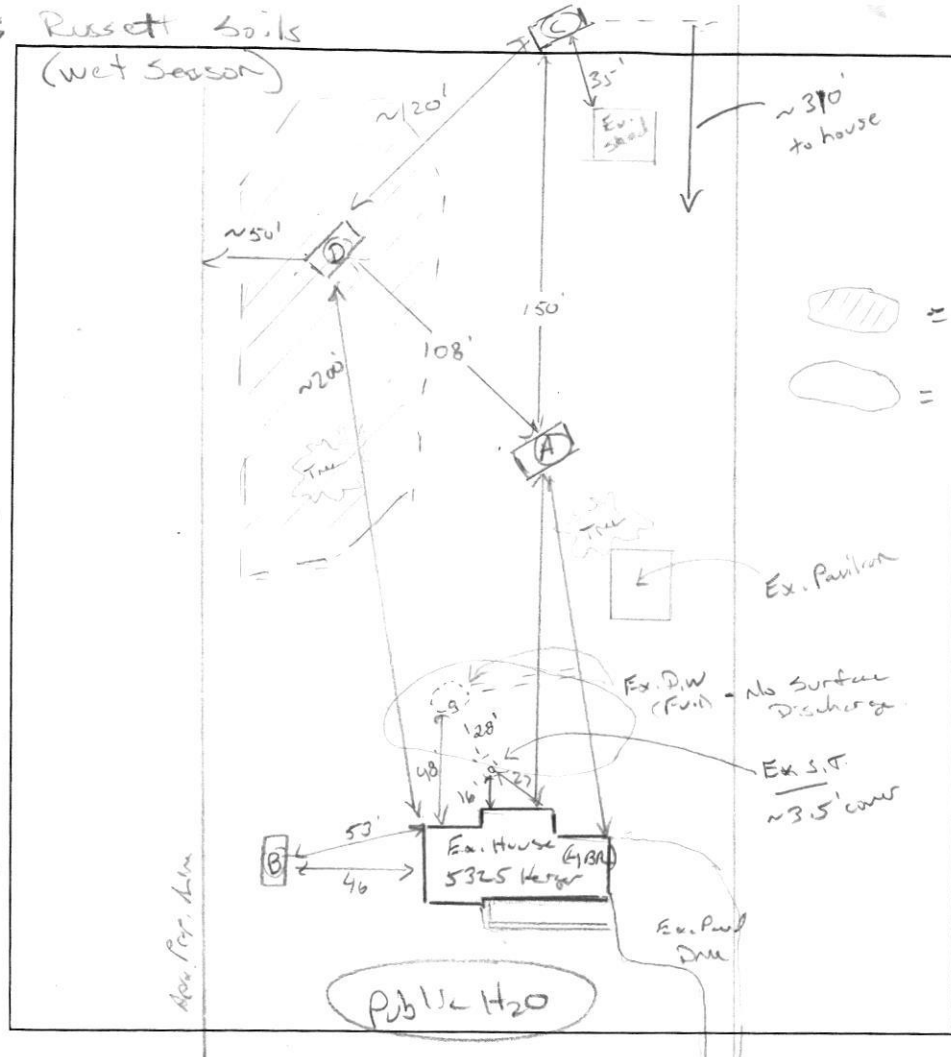

= Potential Perc Area for future SDA  
 = Proposed Pool Area via Home owner

(C)

Dr L  
M Co S BK, roots

2' 1.1 br / Y CL  
 inclusions  
 1.1 br / Y si CL  
 St. Co S BK  
 sticky, CL  
 4' 1.1 Br / Y CL  
 CS, m Co S BK  
 sticky  
 9' Hard Bottom

(D)

Dr K Br CL  
WK Co S BK

12" 1.1 br / Y CL  
 M F S BK  
 CS, sticky  
 4 1/2" Br / Y SL  
 WK Co PL  
 Friable,  
 granular  
 7' Br / Y FSL  
 WK Co PL  
 Friable,  
 micaceous  
 11 1/2" Hard Bottom

| DATE      | TEST # | DEPTH             | START        | BREAK<br>1" DROP | STOP<br>2" DROP | TIME OF<br>2ND INCH | P/F/H |
|-----------|--------|-------------------|--------------|------------------|-----------------|---------------------|-------|
| 4/28/2022 | (A)    | 7'6" / 13'6"      | 00:21        | No movement      | over 2 hrs      | →                   | F     |
|           | (B)    | Fail              | —            | Red on @ 4'      | —               | —                   | F     |
|           | (C)    | Did not test      | not suitable | —                | —               | —                   | F     |
|           | (D)    | 5' / 11 1/2'      | 00:22        | 00:23            | 00:24           | 1                   | P     |
|           |        | Report            | 00:24        | 00:26            | 00:29           | 3                   | P     |
|           |        | H2O pond @ 1 1/2' | —            | —                | —               | ~7 mpi              | P     |

REMARKS Soils very throughout. May need to stay low in elevation above perc D

SANITARIAN K. Wolf BACKHOE Nathan = Not full OTHERS Todd, Ker Sr., Homan

TEST HOLES USED IN SDA 4 AVG. PERC TIME SQ. FT/BR

TRENCH WIDTH 3' INLET DEPTH 3' MAX. BOT DEPTH 7' EFFECTIVE SW 5'-7' (.62)

$$4BR = \frac{600}{1.2} = 500 \div 3 = 166 (.62) = 103 LF (2 \times 52)$$

(A)

1.1 Br / Y CL  
 M Co S BK  
 2' Rd Br / Y CL  
 m Co S BK  
 ribbons 1/2"  
 CW, sticky  
 Fumera  
 4' 1.1 br / Y CL  
 M F BL,  
 CS, ribbons 1/2"  
 6' 1.1 br / Y si CL  
 WK F S BL  
 micaceous  
 clay films  
 5' 1/2" pith  
 7' Br / Y F si CL  
 m Co PL  
 15% Superf  
 WK Iron Inclusions  
 15% s. pith  
 10' Br / Y / Rd. si CL  
 m Co PL,  
 Tight, 10% R

(B)

Dr K Br CL  
 WK Co BK  
 roots  
 1' Rd Br / Y CL  
 m Co S BK  
 sticky  
 Gray inclusions  
 Redox  
 40" ↓  
 6'

# PERMIT

## SEWAGE DISPOSAL SYSTEM

### DEPARTMENT OF HEALTH AND MENTAL HYGIENE

HOWARD COUNTY HEALTH DEPARTMENT

BUREAU OF ENVIRONMENTAL HEALTH

INDEXED

P 48509

A REPAIR

DISTRICT

DATE

DATE SYSTEM APPROVED

PECTOR

ALTER ☒

8-4274

ad

461-9933

3132640

01-2470

Arlie Diehl

Keep w/  
File until  
Approved.

ADDRESS 5325 Kerger Road

SUBDIVISION ROY & EMERY

LOT 4B

PROPERTY OWNER

Arlie Diehl

5325 Kerger Road

ADDRESS

SEPTIC TANK CAPACITY GALLONS

NUMBER OF BEDROOMS

4

125 SQUARE FEET PER BEDROOM

LINEAR FEET OF TRENCH REQUIRED

84

1979  
old A 29129  
old P 30357

REPAIR - PURPOSE - Septic System has failed.

Call for inspection when ground is opened so sanitarian can recommend repair. 9/14/92

DEEP TRENCH OFF OLD DRY WELL 11 FT DEEP

INLET 5 FT DEEP 6 FT SIDE 2 FT WIDE

PLACE THE DITCH OFF THE OLD DRY WELL

RUNNING ALONG LEVEL GROUND TOWARD

THE REAR R/H

PLANS APPROVED BY DATE

COVER NO WORK UNTIL INSPECTED AND APPROVED

NEITHER THE HOWARD COUNTY COUNCIL NOR THE HEALTH DEPARTMENT IS RESPONSIBLE FOR THE SUCCESSFUL OPERATION OF ANY SYSTEM

NOTE: CLEANOUT REQUIRED EVERY 70 FEET OF SEWER LINE AND/OR AT 90° SWEEPS IN LINES FROM HOUSE TO DRAIN FIELDS, 90° ELBOWS NOT ACCEPTABLE.

NOTE: ALL PARTS OF SEPTIC SYSTEMS (I.E. TANK, DISTRIBUTION BOX TRENCHES) TO BE 100 FEET FROM WELL (UNLESS OTHERWISE SPECIFICALLY AUTHORIZED)

NOTE: IF DEEP TRENCH(ES) ARE USED CALL FOR INSPECTION BEFORE AND AFTER PLACING GRAVEL IN TRENCH(ES)

NOTE: NO DRY WELL SHALL EXCEED 15 FOOT IN DIAMETER NO ABSORPTION TRENCH TO EXCEED 100 FEET IN LENGTH

NOTE: ALL PIPE FROM HOUSE TO SEPTIC TANK MUST BE CAST IRON OR SCHEDULE 35/40 PVC OR ABS

PERMIT VOID AFTER TWO YEARS

NOTE: INSTALL STAND PIPE ON SEPTIC TANK AND DRY WELL STAND PIPES MUST BE 6 INCHES IN DIAMETER CAST IRON. CONCRETE OR TERRA COTTA OR PVA OR ABS ACCEPTED. IF TOP OF SEPTIC TANK IS DEEPER THAN 3 FEET. MANHOLE TO GRADE REQUIRED.



NOTE: DISTRIBUTION BOXES MUST HAVE BAFFLES

\*INSTALLER IS RESPONSIBLE FOR OBTAINING FINAL APPROVAL ON THIS PERMIT

HD-260(6-90)

\*CALL 461-9933 FOR INSPECTION OF SEPTIC SYSTEM.

48509

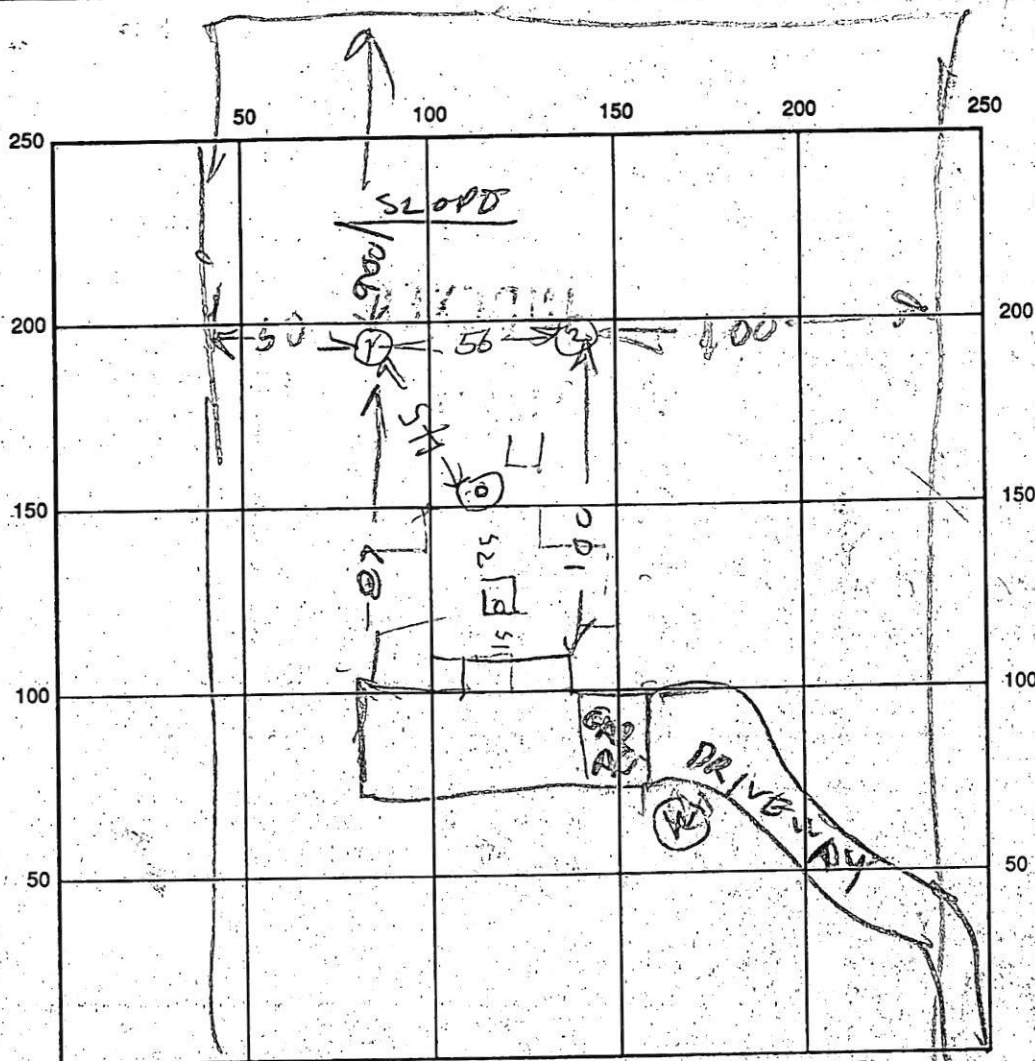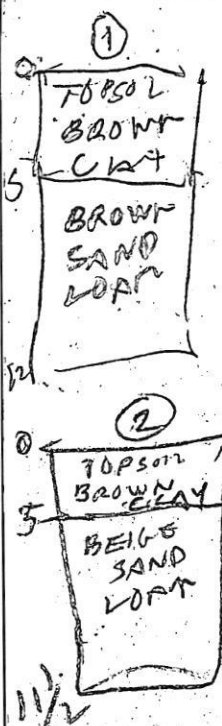

INDICATE NORTH - NAME ADJOINING ROADWAY AS BASE LINE

SEPTIC TANK LEVEL N/A CLEANOUTS \_\_\_\_\_

DISTRIBUTION BOX LEVEL \_\_\_\_\_

DRAIN FIELD/TITLE DEPTH 11 FT. TRENCH WIDTH 2 FT. INLET DEPTH 3 1/2 FT.

EFFECTIVE GRAVEL DEPTH \_\_\_\_\_ FT. TOTAL LENGTH 84 FT.

NUMBER OF TRENCHES 1 ONE SIDEWALL/BOTTOM AREA \_\_\_\_\_ SQ. FT.

DRYWALL INSIDE DIAMETER \_\_\_\_\_ FT. EFFECTIVE DEPTH BELOW INLET \_\_\_\_\_ FT.

ABSORBENT AREA \_\_\_\_\_ SQ. FT.

REMARKS: 9/15/92 AM City Water Weel over 150 FT from Septic tank  
not used. System installed 1979, SOIL OK. HOME  
OWNER TO MEASURE DEPTH OF TRENCH RH  
9/15/92 PM TRENCH DUG ADD STONE & CALL RH  
9/16/92 1:40 AM STONE ADDED

DATE SYSTEM APPROVED 9/16/92 INSPECTOR Raymond Hodge



# APPLICATION

SEWAGE DISPOSAL TESTING

STATE OF MARYLAND - DEPARTMENT OF HEALTH AND MENTAL HYGIENE

#39085

A 29129

P

HOWARD COUNTY HEALTH DEPARTMENT  
ENVIRONMENTAL HEALTH SERVICES

P.O. BOX 476 ELLICOTT, MARYLAND 21043  
TELEPHONE: 992-2330

DISTRICT 1st

DATE 11/2/78

Septic Tank - 1250 gal - 1500  
Dry Well - 60 ft absorbent sidewalk area to begin below the first 4 1/2 ft of dry well. Max depth permitted for DW is 11 1/2 ft below dry grade. Place Dry Well 135 ft from front lot line and 80 ft from left side as seen when facing from the front. Place second DW 45 ft directly behind the first one and connect in series.

TO: THE COUNTY HEALTH OFFICER  
ELLICOTT CITY, MARYLAND

I, HEREBY, APPLY FOR THE NECESSARY TEST IN ORDER TO CONSTRUCT (OR RECONSTRUCT) A SEWAGE DISPOSAL SYSTEM.

PROPERTY OWNER

~~Roy Emery property~~

Archie Diehl off DW after 5' east buffer

ADDRESS

5203 Arboretum Ave.

OK to install trench 30 ft long - 11 1/2 ft deep  
7 ft stone trench & follow contour  
to be completed before  
ground is installed.

PHONE

Balto., Md. 21227

PROPERTY LOCATION:

SUBDIVISION

5325

LOT NO.

4-B

ROAD AND DESCRIPTION

Kerger Road

SIZE OF LOT

?

TYPE BLDG.

3 or 4 bedrooms

THE SYSTEM INSTALLED UNDER THIS APPLICATION IS ACCEPTABLE ONLY UNTIL PUBLIC FACILITIES BECOME AVAILABLE.

I FULLY UNDERSTAND THE FEE CONNECTED WITH THE FILING OF THIS PERC TEST APPLICATION IS NON-REFUNDABLE UNDER ANY CIRCUMSTANCES.

ANY CIRCUMSTANCES.

SIGNATURE OF APPLICANT

/s/ Don Reuwer, Rhett Realty

APPROVED BY

RH

FOR

Archie Diehl

DATE

3-20-79

REJECTED BY

FOR

DATE

HOLD PENDING FURTHER TESTS

DATE

REASONS FOR REJECTION OR HOLDING

11/20/78 PERC OK BUT NO HOUSE SITE

THIS LOT TO BE COMBINED WITH ADJACENT LOT RH  
3/5/79 HOLD FOR REVIEW DM SAID ANOTHER #100 NEEDED  
BECAUSE THREE OF PERC HOLES DUG ON LOT 4B BUT TWO  
EXTRA PERC HOLES DUG ON EXTRA LAND FOR WHICH NO PERC

## THIS IS NOT A PERMIT



TEST FEE HAD BEEN PAID RH

SEE  
ATTACHED

PLAY  
STAKE

SOIL PROFILE

0'

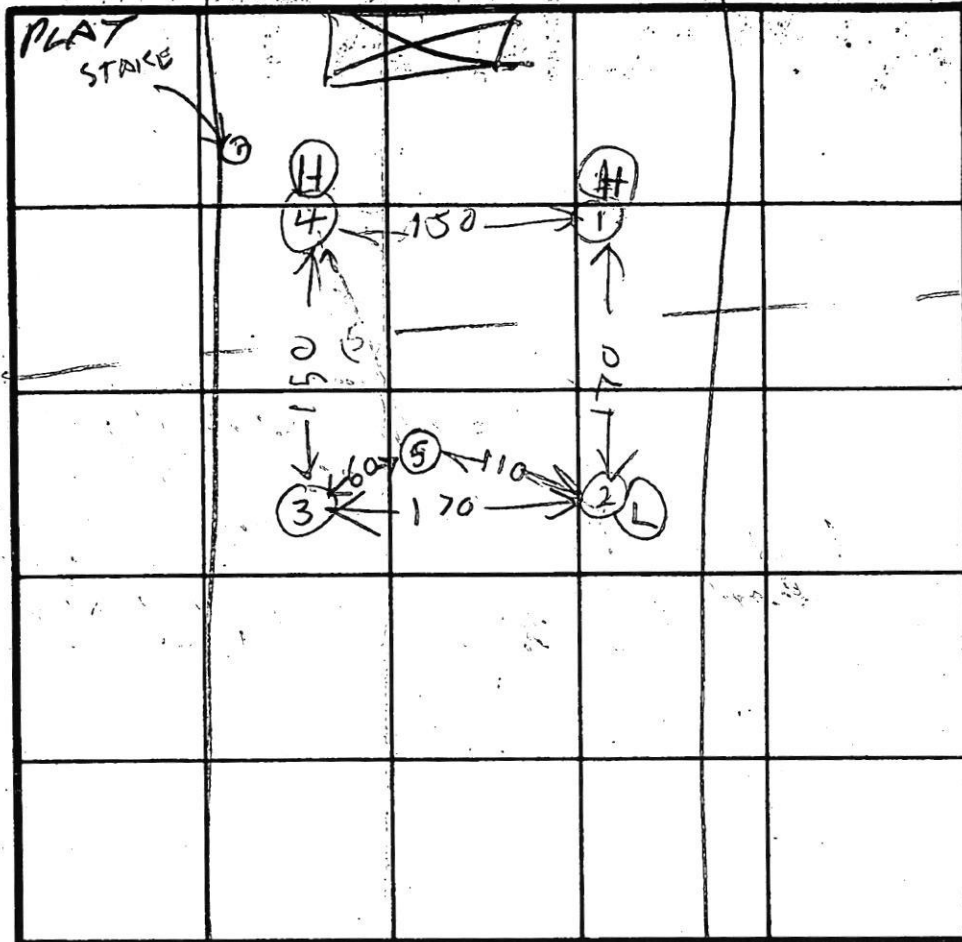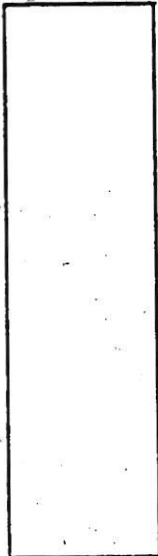

6.7  
2.7  
27

28  
7

INDICATE NORTH - NAME ADJOINING ROADWAY AS BASELINE.

| DATE     | TEST NO. | DEPTH  | PRE-WET                 |      | TEST - 1" DROP    |            | TIME       |
|----------|----------|--------|-------------------------|------|-------------------|------------|------------|
|          |          |        | START                   | STOP | START             | STOP       |            |
| 11/24/78 | 1S       | 5      | 210                     | 230  | 230               | 355        | 25         |
|          | 1V       | 13     | 210                     | 218  | 218               | 230        | 12         |
|          | 2S       | 4      | 213                     | 217  | 217               | 220        | 3          |
|          | 2D       | 13 1/2 | 213                     | 232  | 232               | 245        | 13         |
|          | 3S       | 5      | 221                     | 232  | 232               | 252        | little pen |
|          | 3D       | 14     | 221                     | 252  | 252               | little pen |            |
|          | 4S       | 3 1/2  | 227                     | 228  | 228               | 229        | 1          |
|          | 4V       | 12     | NOT TESTED<br>SOFT SAND |      | DANGER OF CAVE IN |            |            |
|          | 5S       | 3      | 306                     | 324  | 324               | little pen | FAIL       |
| 11/24/78 | 5V       | 12     | 307                     | 309  | 309               | 311        | 2          |
|          | 5M       | 5 1/2  | 322                     | 326  | 326               | 329        | 3          |

REMARKS

NO HOUSE ON THIS BUT LOT LINES  
TO BE CHANGED

TYPE OF SOIL

TESTED BY

BH

ALSO PRESENT

DENNEY DEURA  
D. REUER