

ci05188

SEQUENCE NO.
(MDE USE ONLY)

STATE OF MARYLAND
WELL COMPLETION REPORT

FILL IN THIS FORM COMPLETELY
PLEASE PRINT OR TYPE

THIS REPORT MUST BE SUBMITTED WITHIN
45 DAYS AFTER WELL IS COMPLETED.

COUNTY
NUMBER

A47764

1236
(THIS NUMBER IS TO BE PUNCHED
IN COLS. 3-6 ON ALL CARDS)

ST/CO USE ONLY
DATE Received
MM/YY
4/30/98

DATE WELL COMPLETED
MM/YY
04/03/98

Depth of Well
2230026
(TO NEAREST FOOT)

PERMIT NO.
FROM "PERMIT TO DRILL WELL"
HO-94-1457

OWNER
Sneikh Salman

STREET OR RFD
Benson Branch Rd

TOWN
Ellicott City

SUBDIVISION
Lower Property

SECTION

LOT
4

WELL LOG
Not required for driven wells

STATE THE KIND OF FORMATIONS PENETRATED, THEIR
COLOR, DEPTH, THICKNESS AND IF WATER BEARING

DESCRIPTION (Use additional sheets if needed)	FEET		check if water bearing
	FROM	TO	
top soil	0	2	
shale	2	50	
Brown milt	50	65	
gray milt	65	124	
granite	124	260	✓
gray milt	260	300	
Quartz			

GROUTING RECORD
WELL HAS BEEN GROUTED
(Circle Appropriate Box)

TYPE OF GROUTING MATERIAL (Circle one)

CEMENT [CM] BENTONITE CLAY [BC]

NO. OF BAGS 17 NO. OF POUNDS 85

GALLONS OF WATER 85

DEPTH OF GROUT SEAL (to nearest foot)

from 0 ft. to 58 ft.

CASING RECORD

ST STEEL CO CONCRETE

PL PLASTIC OT OTHER

MAIN CASING TYPE ST

Nominal diameter top (main) casing (nearest inch) 6

Total depth of main casing (nearest foot) 60

OTHER CASING (if used)

SCREEN RECORD

ST STEEL BR BRASS PL PLASTIC

HO OPEN HOLE OT OTHER

DEPTH (nearest ft.)

58 300

SCREEN RECORD

ST STEEL BR BRASS PL PLASTIC

HO OPEN HOLE OT OTHER

DEPTH (nearest ft.)

58 300

SCREEN RECORD

ST STEEL BR BRASS PL PLASTIC

HO OPEN HOLE OT OTHER

DEPTH (nearest ft.)

58 300

NUMBER OF UNSUCCESSFUL WELLS: 0

WELL HYDROFRACTURED [Y] [N]

CIRCLE APPROPRIATE LETTER

A A WELL WAS ABANDONED AND SEALED WHEN THIS WELL WAS COMPLETED

E ELECTRIC LOG OBTAINED

P TEST WELL CONVERTED TO PRODUCTION WELL

I HEREBY CERTIFY THAT THIS WELL HAS BEEN CONSTRUCTED IN ACCORDANCE WITH COMAR 26.04.04 "WELL CONSTRUCTION" AND IN CONFORMANCE WITH ALL CONDITIONS STATED IN THE ABOVE CAPTIONED PERMIT, AND THAT THE INFORMATION PRESENTED HEREIN IS ACCURATE AND COMPLETE TO THE BEST OF MY KNOWLEDGE.

DRILLERS LIC. NO. MWD 040

DRILLERS SIGNATURE

LIC. NO. MWD 481

SITE SUPERVISOR (sign. of driller or journeyman responsible for sitework if different from permittee)

PUMPING TEST

HOURS PUMPED (nearest hour) 3

PUMPING RATE (gal. per min.) 5

METHOD USED TO MEASURE PUMPING RATE Bucket

WATER LEVEL (distance from land surface)

BEFORE PUMPING 41 ft.

WHEN PUMPING 144 ft.

TYPE OF PUMP USED (for test)

A air P piston T turbine

C centrifugal R rotary O (describe below)

J jet S submersible

PUMP INSTALLED

DRILLER WILL INSTALL PUMP (CIRCLE) (YES OR NO)

IF DRILLER INSTALLS PUMP, THIS SECTION MUST BE COMPLETED FOR ALL WELLS.

TYPE OF PUMP INSTALLED

PLACE (A,C,J,P,R,S,T,O) IN BOX 29

CAPACITY: GALLONS PER MINUTE (to nearest gallon) 31 35

PUMP HORSE POWER 37 41

PUMP COLUMN LENGTH (nearest ft.) 43 47

CASING HEIGHT (circle appropriate box and enter casing height)

above 49

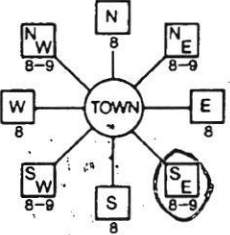
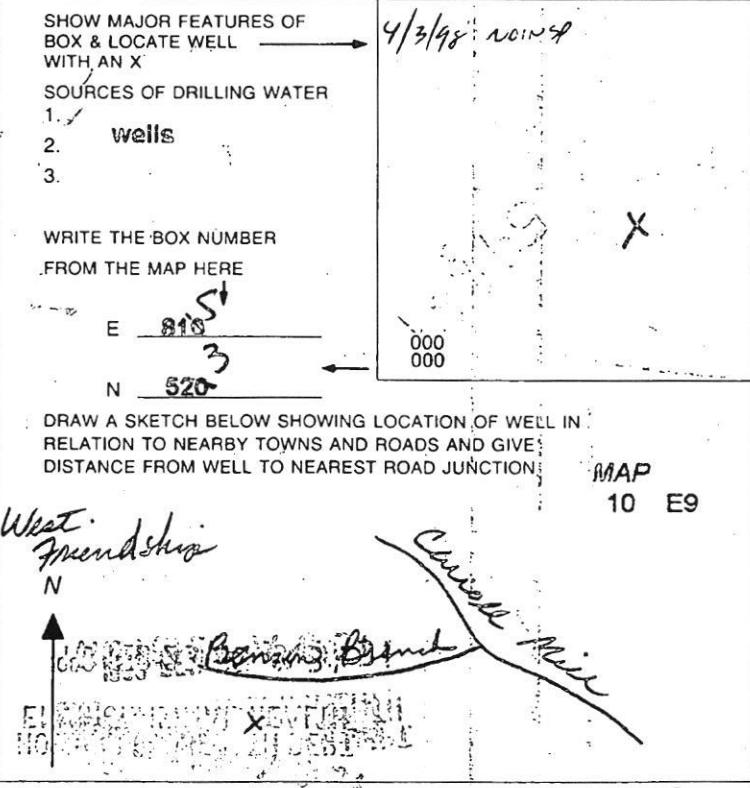
below 49

LAND SURFACE 2 (nearest foot)

LOCATION OF WELL ON LOT

SHOW PERMANENT STRUCTURE SUCH AS BUILDING, SEPTIC TANKS, AND /OR LANDMARKS AND INDICATE NOT LESS THAN TWO DISTANCES (MEASUREMENTS TO WELL)

Lot 4

B 1 2 & 49 1 2 3 4 5 6 THIS NUMBER IS TO BE PUNCHED IN COLS. 3-6 ON ALL CARDS)	SEQUENCE NO. (MDE USE ONLY)	STATE OF MARYLAND PERMIT TO DRILL WELL please print or type	STATE PERMIT NUMBER <u>HO-94-1457</u> 70 fill in this form completely 79
Date Received (APA) <u>2/23/98</u> 8 MM DO 13 OWNER INFORMATION RN 7368 15 <u>Sheikh</u> <u>Salman</u> Last Name Owner First Name 34 36 <u>3017 Cluster Pines Court</u> Street or RFD 55 <u>Ellicott City, Md. 21042</u> 57 Town 70 State 72 Zip 76		B 3 Howard LOCATION OF WELL CC# 8 COUNTY 21 <u>Lowe Property</u> 23 SUBDIVISION 42 SECTION <u>44</u> 46 LOT <u>4</u> 48 50 <u>West Friendship</u> 52 NEAREST TOWN 71 MILES FROM TOWN (enter 0 if in town) <u>73</u> M I 76 77 78	
DRILLER INFORMATION <u>George F. Easterday</u> M W D 040 Driller's Name 76 License No. 81 <u>L. Franklin Easterday, Inc.</u> Firm Name <u>9265 Brown Church Rd., MT. Airy, Md. 21771</u> Address <u>George F. Easterday</u> <u>2/20/98</u> Signature Date		B 4 1 2 DIRECTION OF WELL FROM TOWN (CIRCLE BOX)  <u>Benson Branch Rd</u> 11 NEAR WHAT ROAD 30 ON WHICH SIDE OF ROAD (CIRCLE APPROPRIATE BOX)  34 <u>2000</u> 37 DISTANCE FROM ROAD Ft. ENTER FT OR MI 38 39 TAX MAP: _____ BLK: _____ PARCEL: _____	
B 2 WELL INFORMATION 1 2 APPROX. PUMPING RATE (GAL. PER MIN.) 8 <u>5</u> 12 AVERAGE DAILY QUANTITY NEEDED (GAL. PER DAY) 14 <u>500</u> 20		NOT TO BE FILLED IN BY DRILLER HEALTH DEPARTMENT APPROVAL <u>Howard</u> <u>A 47764</u> COUNTY NAME COUNTY NO. STATE SIGNATURE INSERT S 41 DATE ISSUED <u>3/5/98</u> 43 MM DO YY 48 CO SIGNATURE EXP. DATE NORTH GRID <u>523</u> 0 0 0 EAST GRID <u>0815</u> 0 0 0 50 55 57 63	
USE FOR WATER (CIRCLE APPROPRIATE BOX) ☒ HOME (SINGLE OR DOUBLE HOUSEHOLD UNIT ONLY) ☐ FARMING (LIVESTOCK WATERING & AGRICULTURAL IRRIGATION) 22 ☐ INDUSTRIAL, COMMERCIAL, STATE AND FEDERAL GOV. OTHER (REQUIRES APPROPRIATION PERMIT) ☐ PUBLIC OR PRIVATE WATER COMPANY (REQUIRES APPROPRIATION PERMIT AND STATE APPROVAL) ☐ TEST, OBSERVATION, MONITORING (MAY REQUIRE APPROPRIATION PERMIT)		SHOW MAJOR FEATURES OF BOX & LOCATE WELL WITH AN X SOURCES OF DRILLING WATER 1. wells 2. 3. WRITE THE BOX NUMBER FROM THE MAP HERE E <u>815</u> N <u>520</u> 000 000 DRAW A SKETCH BELOW SHOWING LOCATION OF WELL IN RELATION TO NEARBY TOWNS AND ROADS AND GIVE DISTANCE FROM WELL TO NEAREST ROAD JUNCTION. MAP 10 E9 	
APPROXIMATE DEPTH OF WELL <u>300</u> FEET 24 28 APPROXIMATE DIAMETER OF WELL <u>6</u> INCH NEAREST INCH.		METHOD OF DRILLING (circle one) BORED (or Augered) JETTED Jetted & DRIVEN 30 <u>AIR-ROTARY</u> AIR-PERCussion ROTARY (Hydraulic Rotary) 37 <u>CABLE</u> REVERSE-ROTARY DRIVE POINT other: _____	
REPLACEMENT OR DEEPEMED WELLS (CIRCLE APPROPRIATE BOX) ☒ THIS WELL WILL NOT REPLACE AN EXISTING WELL ☐ THIS WELL WILL REPLACE A WELL THAT WILL BE ABANDONED AND SEALED 39 ☐ THIS WELL WILL REPLACE A WELL THAT WILL BE USED AS A STANDBY-CONTACT LOCAL APPROVING AUTHORITY FOR POLICY ON STANDBY WELLS ☐ THIS WELL WILL DEEPEMED AN EXISTING WELL PERMIT NUMBER OF WELL TO BE REPLACED OR DEEPEMED (IF AVAILABLE) 41 52		Not to be filled in by driller (MDE OR COUNTY USE ONLY) APPROP. PERMIT NUMBER 54 G A P 63 WRITE INITIALS IN BOX FORCE <u>PS</u> PERMIT No. <u>HO-94-1457</u> 67 68 70 71 72 73 74 75 76 77 78 79	
SPECIAL CONDITIONS NOTE - APPROVING AUTHORITIES SHOULD USE SEPARATE SHEET IF NEEDED -			

APPLICATION FOR A PERMIT TO APPROPRIATE AND USE WATERS OF THE STATE

Water Resources Administration
Water Supply Section
Tawes Office Building
Annapolis, Maryland 21401

☐ Surface Water ☒ Groundwater ☒ New Application ☐ Change in Existing Permit

Number _____

APPLICATION <u>LOIS H. LOWE</u> (Owner's Name) <u>12325 BENSON BRANCH ROAD</u> (Owner's Address) <u>ELLICOTT CITY</u> (Street) <u>MD</u> (Town) <u>21042</u> (State) <u>(410) 531-6732</u> (Zip Code) (Telephone Number)	
WITHDRAWAL GROUNDWATER Appropriate and use a yearly average of <u>214 GPD/LOT</u> <u>650</u> gallons per day, [total annual use ÷ 365 days] and <u>1100</u> gallons [highest total monthly use ÷ days in month] for the average day of the maximum month, from <u>3</u> well(s) having a diameter of [number] <u>6</u> inches, and a depth of [estimate] <u>100</u> ft. [estimate]	SURFACE WATER Appropriate and use a yearly average of _____ gallons per [total annual use ÷ 365 days] day, and a maximum use of _____ gallons in any one day, from: _____ [name of stream] _____ [exact location of withdrawal]
PROJECT LOCATION <u>SOUTH SIDE OF BENSON BRANCH ROAD 2400' ± WEST OF CARROLL MILL ROAD</u> [Location - be specific] County <u>HOWARD</u> Subdivision or town <u>MAYFIELD</u> Phone number <u>(410) 531-6732</u> Name and type of business <u>THREE (3) PROPOSED SINGLE FAMILY DETACHED DWELLINGS (LOTS 1, 3 AND 4)</u> ALL APPLICATIONS MUST INCLUDE A COPY OF LOCATION MAP SHOWING THE PROJECT SITE	
PURPOSE The water will be used for: ☐ Community Water Supply ☐ Non-Potable supply (sanitary uses, not for drinking water) ☒ Potable Supply (drinking water, etc.) ☐ Cooling Water ☐ Irrigation ☐ Process Water ☐ Other _____ [explain]	WASTEWATER TREATMENT AND DISPOSAL ☐ Public Sewer _____ [name of system] ☒ Groundwater ☒ Subsurface (tilefield, seepage pit, etc.) ☐ Spray Irrigation ☐ Other, explain _____ ☐ Surface Water _____ [name of stream] Discharge Permit # _____ or applied for _____
SIGNATURE Please sign here <u>BRUCE D. BURTON PE</u> [signature] <u>BRUCE D. BURTON PE (OWNERS AGENT) 9/15/93</u> [please print name, title, and date here]	
THIS APPLICATION WILL NOT BE PROCESSED WITHOUT A SIGNATURE AND A LOCATION MAP	
REVIEW BY COUNTY HEALTH DEPARTMENT OR DESIGNATED AGENCY THIS SECTION NOT TO BE COMPLETED BY APPLICANT Is this Project consistent with the County Water and Sewerage Plan and local planning and zoning? ☐ YES ☐ NO, explain _____ Signature of county representative _____ [signature] [title] [date]	

LAND DESIGN ENGINEERING, INC.

PLANNING • ENGINEERING • SURVEYING

Ron (CW)

September 21, 1993

Mr. Craig Williams, Program Director
Bureau of Environmental Health
Howard County Health Department
3525 H Ellicott Mills Drive
Ellicott City, MD 21043

re: Lowe Property
Lots 1, 3 and 4

WoodMark Subdiv

Dear Mr. Williams:

Please find a completed Ground Water Appropriation Permit Application and Location Map for the above referenced subdivision.

Should you have any questions regarding the processing of the application, please contact our office.

Very truly yours,

LAND DESIGN ENGINEERING, INC.

Bruce D. Burton

Bruce D. Burton, P.E.
Vice President

BDB:dmm

Encs.

cc: Lois H. Lowe