

2/19/92
ASAP

PERMIT

SEWAGE DISPOSAL SYSTEM

DEPARTMENT OF HEALTH AND MENTAL HYGIENE

HOWARD COUNTY HEALTH DEPARTMENT
BUREAU OF ENVIRONMENTAL HEALTH
461-9933

INDEXED

P 47830

A REPAIR

DISTRICT

DATE 2/12/92

DATE SYSTEM APPROVED 2/19/92

INSPECTOR RW

Jenkins Brothers

IS PERMITTED TO INSTALL _____ ALTER ☒

ADDRESS 7670 Smith's Private Road, Sykesville, Maryland PHONE 465-6646

SUBDIVISION _____ LOT _____ ROAD 1745 Marriottsville Road

PROPERTY OWNER Mr. Snyder
ADDRESS 1745 Marriottsville Road
Marriottsville, Maryland

SEPTIC TANK CAPACITY 1000 GALLONS

NUMBER OF BEDROOMS 2/3

SQUARE FEET PER BEDROOM

LINEAR FEET OF TRENCH REQUIRED

Neighboring Property

REPAIR - PURPOSE - TO REPAIR EXISTING, FAILING DRAINFIELDS.

Call for inspection when ground is opened so sanitarian can recommend repair.

VERY CONFINED AREA HAD TO MAKE DO
WITH A TRENCH OFF OLD TANK 60 FT
LONG 2 FT WIDE 6 FT OF STONE KEEP
TRENCH AT LEAST 50 FT FROM WELL

PLANS APPROVED BY C. Williams DATE 2/11/92

COVER NO WORK UNTIL INSPECTED AND APPROVED

NEITHER THE HOWARD COUNTY COUNCIL NOR THE HEALTH DEPARTMENT IS RESPONSIBLE FOR THE SUCCESSFUL OPERATION OF ANY SYSTEM

NOTE: CLEANOUT REQUIRED EVERY 70 FEET OF SEWER LINE AND/OR AT 90° SWEEPS IN LINES FROM HOUSE TO DRAIN FIELDS, 90° ELBOWS NOT ACCEPTABLE.

NOTE: ALL PARTS OF SEPTIC SYSTEMS (I.E. TANK, DISTRIBUTION BOX TRENCHES) TO BE 100 FEET FROM WELL (UNLESS OTHERWISE SPECIFICALLY AUTHORIZED)

NOTE: IF DEEP TRENCH(ES) ARE USED CALL FOR INSPECTION BEFORE AND AFTER PLACING GRAVEL IN TRENCH(ES)

NOTE: NO DRY WELL SHALL EXCEED 15 FOOT IN DIAMETER NO ABSORPTION TRENCH TO EXCEED 100 FEET IN LENGTH

NOTE: ALL PIPE FROM HOUSE TO SEPTIC TANK MUST BE CAST IRON OR SCHEDULE 35/40 PVC OR ABS

PERMIT VOID AFTER TWO YEARS

NOTE: INSTALL STAND PIPE ON SEPTIC TANK AND DRY WELL STAND PIPES MUST BE 6 INCHES IN DIAMETER CAST IRON. CONCRETE OR TERRA COTTA OR PVA OR ABS ACCEPTED. IF TOP OF SEPTIC TANK IS DEEPER THAN 3 FEET. MANHOLE TO GRADE REQUIRED.


NOTE: DISTRIBUTION BOXES MUST HAVE BAFFLES

*INSTALLER IS RESPONSIBLE FOR OBTAINING FINAL APPROVAL ON THIS PERMIT

HD-260(6-90)

*CALL 461-9933 FOR INSPECTION OF SEPTIC SYSTEM.

47830

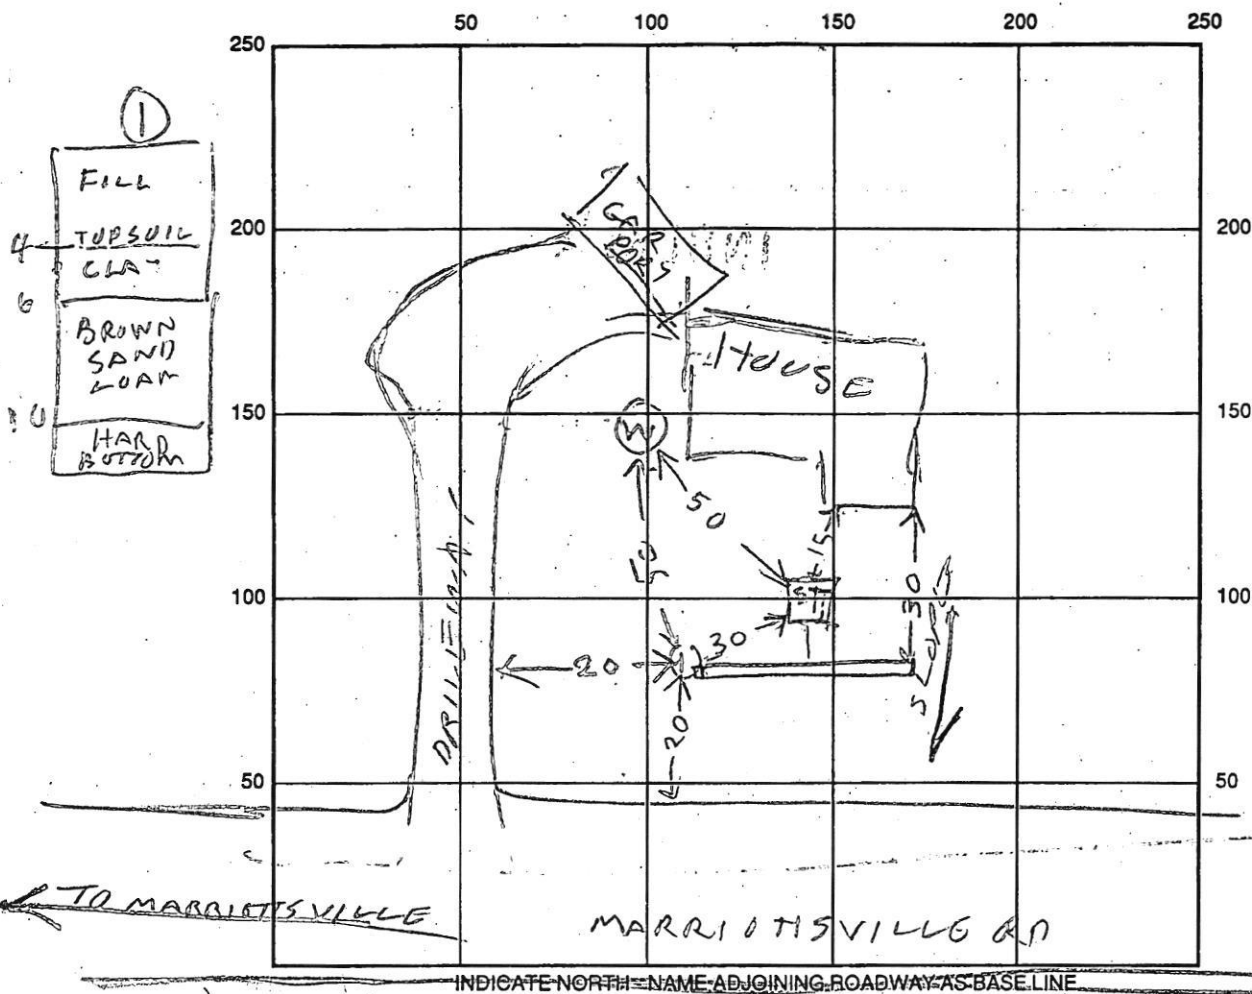

SEPTIC TANK LEVEL _____ CLEANOUTS _____

DISTRIBUTION BOX LEVEL _____

DRAIN FIELD/TITLE DEPTH 10 FT. TRENCH WIDTH 2 FT. INLET DEPTH 3 FT.

EFFECTIVE GRAVEL DEPTH 7 FT. TOTAL LENGTH 56 FT.

NUMBER OF TRENCHES 1 ONE SIDEWALL/BOTTOM AREA 39.2 SQ. FT.

DRYWALL INSIDE DIAMETER _____ FT. EFFECTIVE DEPTH BELOW INLET _____ FT.

ABSORBENT AREA _____ SQ. FT.

REMARKS: 2/19/92^{pm} SOIL OK BELOW 6 FT VISUAL HOLE
ONLY 50 FT FROM WATER WELL BUT DOWN HILL
FROM WELL. OLD SEPTIC SYSTEM IN USE AT LEAST 20 YEARS
NO ROOM TO DO A PROPER REPAIR JOB R/HOGG
2/19/92 OK TRENCH

DATE SYSTEM APPROVED 2/19/92 INSPECTOR Raymond Hodger

FOGLE'S SEPTIC CLEAN, INC.
 580 Obrecht Road • Sykesville • Maryland 21784
 (410) 795-5670



SEPTIC EVALUATION

☐ Buyer / ☐ Seller	Date: _____ Time: _____	Occupied? ☐ Yes / ☐ No
Client: <u>JDK Homes</u>	Ordered By: _____	If vacant, how long? _____
Property Address: <u>1725 Marriottsville Rd</u>	Phone: _____	Last pumped: <u>?</u>
<u>Marriottsville, MD 21104</u>	email: _____	Property age: <u>1958</u> # Bedrooms: <u>3</u>
<u>Ho-Co.</u>	Weather: _____	County Records: ☒ Requested ☐ Not Received
	Ground Conditions: _____	Confirmed: ☐ Yes ☐ Left Message

Liquid level: ☐ Above Normal / ☒ Normal / ☐ Below normal	Depth of tank: <u>18"</u>
Maintenance Appears: ☐ Good / ☒ Fair / ☐ Poor	Access to tank: <u>6" x 10"</u>
Effluent Filter present? ☐ Yes / ☒ No	Pump system: ☐ Yes / ☒ No

Type of Tank	Tank Composition & Size	Type of Absorption System
☒ Septic Tank (1 tank)	☐ Metal ☒ Concrete ☐ Unknown	☐ Drainfield
☐ Cesspool	Tank Size: <u>1000g</u>	☒ Drywell
☐ Aeration System	Baffles intact? ☒ Yes / ☐ No <u>Conc.</u>	☐ Sandmound
☐ Other:		☐ Other:

Inspected System Appears:	Inspector's Comments	Sketch of System
☐ Functional ☐ Marginal ☒ Unsatisfactory	Septic tank is due for cleaning. Outlet line is cast iron and needs to be replaced. Tank should have manhole access to grade for future maintenance. Both clean out pipes need to be replaced. Approx cost \$2500.	The sketch shows a vertical line representing a well, connected to a horizontal line representing the septic tank. Below the tank is a small circle representing a drywell. Labels include 'well', 'S. Tank', and 'Drywell'.
Inspector: _____		
Signature: <u>K. Cassell</u>		
Inspection Fee: <u>\$150</u>		
Locate/Hand Digging Fee: _____		
Water Test: ☐ U&O ☐ Lead ☐ Nitrite		
Water Test Other: _____		
Amount Due: _____		
Check # _____		

IMPORTANT:

- This is a subjective and visual inspection only, based upon many unknown and unseen factors.
- The condition of the Sewage Disposal system is reported as of the above date.
- This report does not WARRANT nor GUARANTEE continued functional Sewage Disposal System operations.
- If house has been unoccupied, this report may not be accurate. Little or no use of the septic system could have allowed the problems to temporarily clear themselves.
- If a larger family is moving in than is presently occupying the house, the septic system may be subject to failure.
- If the general ground condition is wet, this report may not be accurate, as ground moisture may cover or hide actual septic effluent on the surface.
- In the above cases, it is strongly suggested that the septic system be re-certified in 3 to 6 months.
- If the system is rated below as marginal or unsatisfactory, it is suggested that the local health department be contacted to inspect and confirm the findings.
- This report addresses the functionality of the system. It does not warrant or guarantee sizing for permitting code or regulation now or in the future.

Payment for this inspection signifies understanding and acceptance of above clauses.

LAYOUT _____ INSP 4 _____
INSP 2 _____ INSP 5 _____
INSP 3 _____ INSP 6 _____

ISSUE DATE: _____

APPROVAL DATE: _____

PERMIT

INDEXED

**ON-SITE SEWAGE DISPOSAL SYSTEM
HOWARD COUNTY HEALTH DEPARTMENT
BUREAU OF ENVIRONMENTAL HEALTH**

P _____

A 517322-A

IS PERMITTED TO INSTALL ☐ ALTER ☐

ADDRESS: _____ PHONE NUMBER: _____

SUBDIVISION: _____ LOT NUMBER: _____

ADDRESS: 1725 Marriottsville Road PROPERTY OWNER: Bruce McCurdy

SEPTIC TANK CAPACITY (GALLONS): _____ OUTLET BAFFLE FILTER REQUIRED ☐

PUMP CHAMBER CAPACITY (GALLONS): _____ COMPARTMENTED TANK REQUIRED ☐

NUMBER OF BEDROOMS: _____

SQUARE FEET PER BEDROOM: _____

LINEAR FEET OF TRENCH REQUIRED: _____

TRENCHES:	Trench to be _____ feet wide. Inlet _____ feet below original grade. Bottom maximum depth _____ feet below original grade. Effective area begins at _____ feet below original grade. _____ feet of stone below distribution pipe.
LOCATION:	BUILDING PERMIT SIGNED
NOTES:	AND RETURNED
	B00137042 - Porch - 6/20/2002

PLANS APPROVED: _____ DATE: _____

NOTE: PERMIT VOID AFTER 2 YEARS

NOTE: CONTRACTOR RESPONSIBLE FOR SCHEDULING A PRE-CONSTRUCTION INSPECTION FOR ALL INSTALLATIONS


NOTE: WATERTIGHT SEPTIC TANKS REQUIRED

NOTE: ALL PARTS OF SEPTIC SYSTEM SHALL BE 100 FEET FROM ANY WATER WELL

NOTE: MANHOLE RISERS REQUIRED ON ALL SEPTIC TANKS AND PUMP CHAMBERS UNLESS SPECIFICALLY AUTHORIZED

**NEITHER THE HOWARD COUNTY COUNCIL NOR THE HEALTH DEPARTMENT IS
RESPONSIBLE FOR THE SUCCESSFUL OPERATION OF ANY SYSTEM
PERMITTEE RESPONSIBLE FOR OBTAINING FINAL APPROVAL ON THIS PERMIT
CALL 410-313-2640 FOR INSPECTION OF SEPTIC SYSTEM**

FILE NOT FOUND

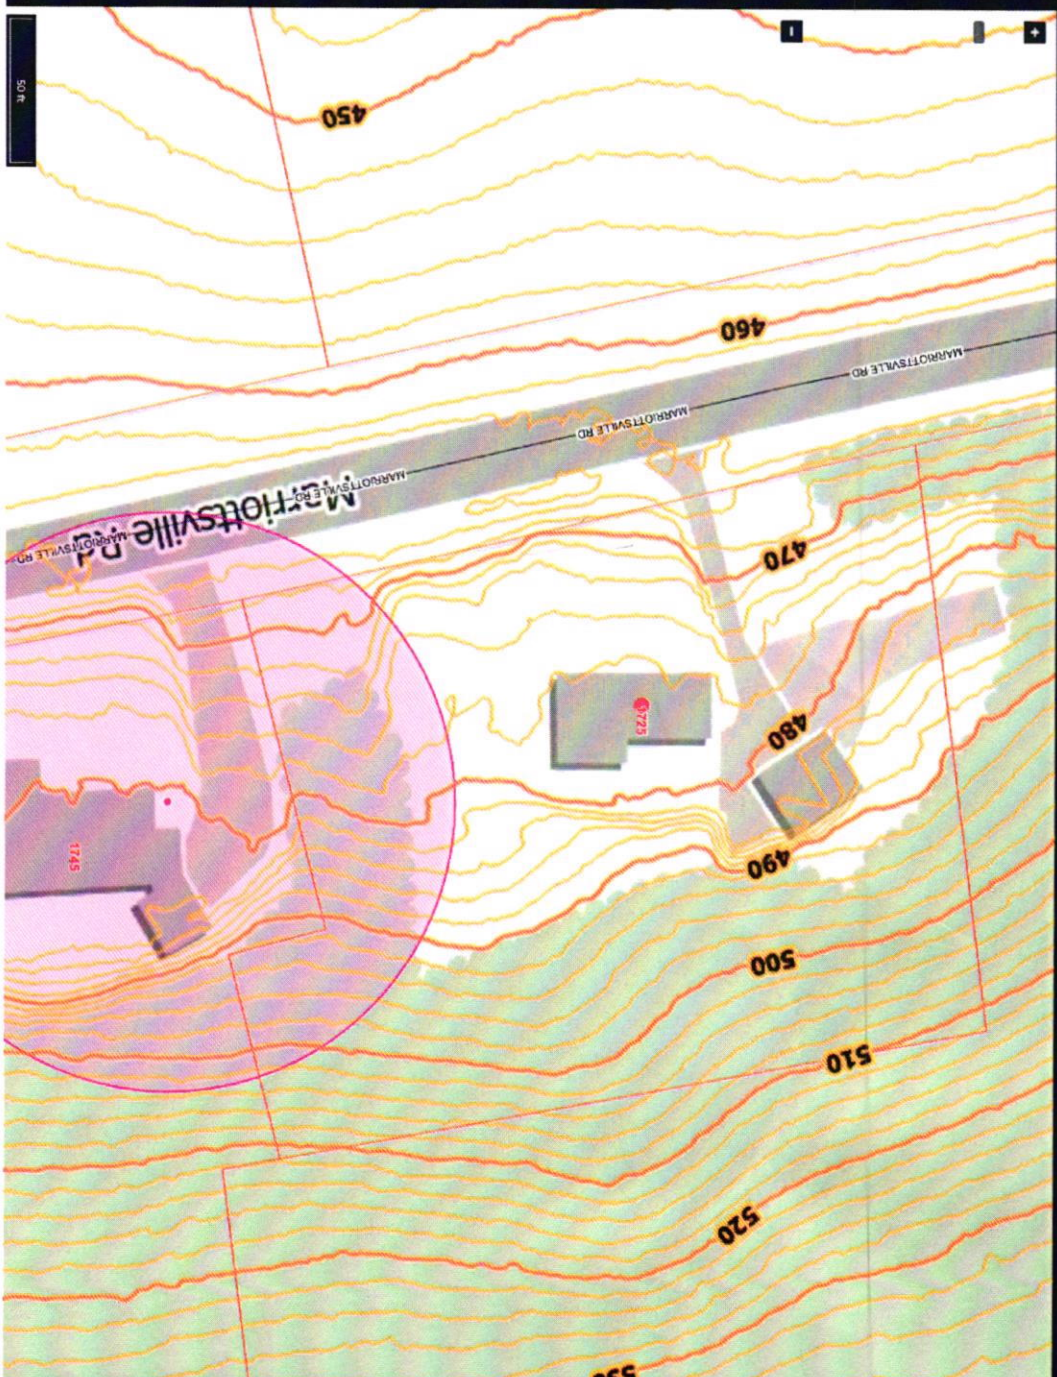

Info Tool

Property Public NoName

- ACTID: 403281426
- PLAT:
- MAP: 0010
- PARCEL: 0123
- LOT:
- GRID: 0022
- OWNNAME: MCCUBBER BRUCE
- OWNNAME2: MCCUBBER BRUCE
- ACREAGE: 1.15
- SOAT Link: click for Property info
- PREPARET: SE:20811

Address Points

- CDR: 110:20904
- FRADDRESS: 00917
- TRPARET: SE:20811
- ADDRESS: 1725
- FRENSAM: MARIOTTSVILLE
- FRENSAM: CO
- FRENSAM: MARIOTTSVILLE
- PREZIP: 21104
- GEODPRESS: 1725
- MARIOTTSVILLE RD
- STREETNAME: MARIOTTSVILLE
- ID:
- SUBADDRESS: null
- DATA: SOURCE: null
- NAME: AUD: null
- SPEC: AUD: null
- DATA: ESTAMP: null
- DIRSUF: null
- Creator: null
- Creation Date: null
- Last Editor: null
- Last Edit Date: null
- GlobalID: 1725d1770a46c1



1725
Marriottsville Rd

A517322-A
Could Not Find
Record

Septic Tank

Drywell





