

Record Detail * (This section is required.)

Permit Type	Permit Number	Opened Date
Building/Residential/Misc/Porch	B26002292	07/03/2026

Description of Work

SFD/CONSTRUCT A 14' X 22' OPEN PORCH W/ STEPS ON REAR OF HOUSE**HANDRAILS MAY BE REQUIRED FOR STEPS, SUBJECT TO FIELD INSPECTION**

[check spelling](#)

BP Approved.

gls 7/27/26

Address * (This section is required.)

Search Reset Clear Get Parcel & Owner

Street #	Street Name	Street Type
1730	BRICKELL	WAY

Unit Type	Unit #	X Coordinate	Y Coordinate
--Select--			

City	State	Zip Code	Primary
MARIOTTSVILLE	MD	21104	Yes

Parcel * (This section is required.)

Search Reset Clear Get Address & Owner

GIS ID *	Parcel	Parcel Area	Land Value	Improved Value	Exemption Value	Plan Area
11062885	274	1.15	272700	1464600	1191900	RURAL

Legal Description

IMPSLOT 9 1.152 A[]1730 BRICKELL WAY[]BRICKELL PROPERTY RESUB

[check spelling](#)

Block	Lot	Census Tract	Council Dist	Inspection Dist	Supervisor Dist	Map #	DAP Zone
1	9	603000	5				

Plan Area	State Tax Id	Subdivision Name
	1403605466	Brickell Property

Section	Area	Tax Map
		10

Grid	Zoning District	ADC Map
10-1	RR-DEO	4694-A6

SDP No.	Final Plan No.	WP File No.
	ECP-19-021	

Record Plat No.	WS Contract No.	FDP No.	Primary
26850-2685			Yes

Owner Occupied	Year Built	Historic District
☐ Yes ☐ No	2026	☐ Yes ☒ No

Historic District Registry No.	Stat Area	Flood Plain
	3-01	☐ Yes ☒ No

Building No

Owner * (This section is required.)

Search Reset Clear

Name *

NELLU

Address Line 1

1730 BRICKELL WAY

Address Line 2**Address Line 3****Mail City**

MARIOTTSVILLE

Mail State

MD

Mail Zip Code

21104

Phone

410-718-1460

Primary

Yes

E-mail**Cell Number****Fax Number****Professionals** (This section is not required.)**License # ***

162314

Business Name

NORTH SUN CONTRACTORS

License Type *

MHIC Ind

First Name

JORDAN

Middle Name**Last Name**

IRANI

Primary

Yes

Address Line 1

7680 WOOD PARK LANE

Address Line 2**City**

COLUMBIA

State

MD

ZIP Code

21046

Phone 1

4436033085

Phone 2**Fax****E-mail**

NORTHSUNCONTRACTORS@GMAIL.COM

Applicant (This section is not required.)**Search****As Owner****As Lic. Prof****As Contact****Type ***

Applicant

First Name

MICHELLE

MI**Last Name**

CLANCY

Relationship

Applicant

Full Name

MICHELLE CLANCY

Primary

Yes

Organization Name

APPLIED & APPROVED PERMITS LLC

Street Address

P.O. BOX 310

Address Line 2**City**

PERRY HALL

State

MD

Zip Code

21128

Phone

443-340-1229

Cell**Fax****E-mail ***

MICHELLE@APPLIEDANDAPPROVED.COM

Addtl Info**Est Construction Cost ***

33000

Housing Units *

0

Number of Buildings *

0

Public Owned

No

Construction Type


434 - Additions, Alterations and Conversions - Residential

PORCH INFORMATION

PORCH INFORMATION

Capital Project-No Fee *	Capital Project Number	Fee Exempt *	Roadside Tree Project Permit *	Roadside Tree Project Permit #
☐ Yes ☒ No	(Text)	☐ Yes ☒ No	☐ Yes ☒ No	(Text)
Existing Use *	Type of Porch *	Type of Porch Foundation *	Total Square Footage *	
SFD	Open Porch	New Deck	308 SQFT (Number)	
Water Supply	Sewage Disposal	Expiration Date		
Private	Public	1/17/2027		

Submit Cancel

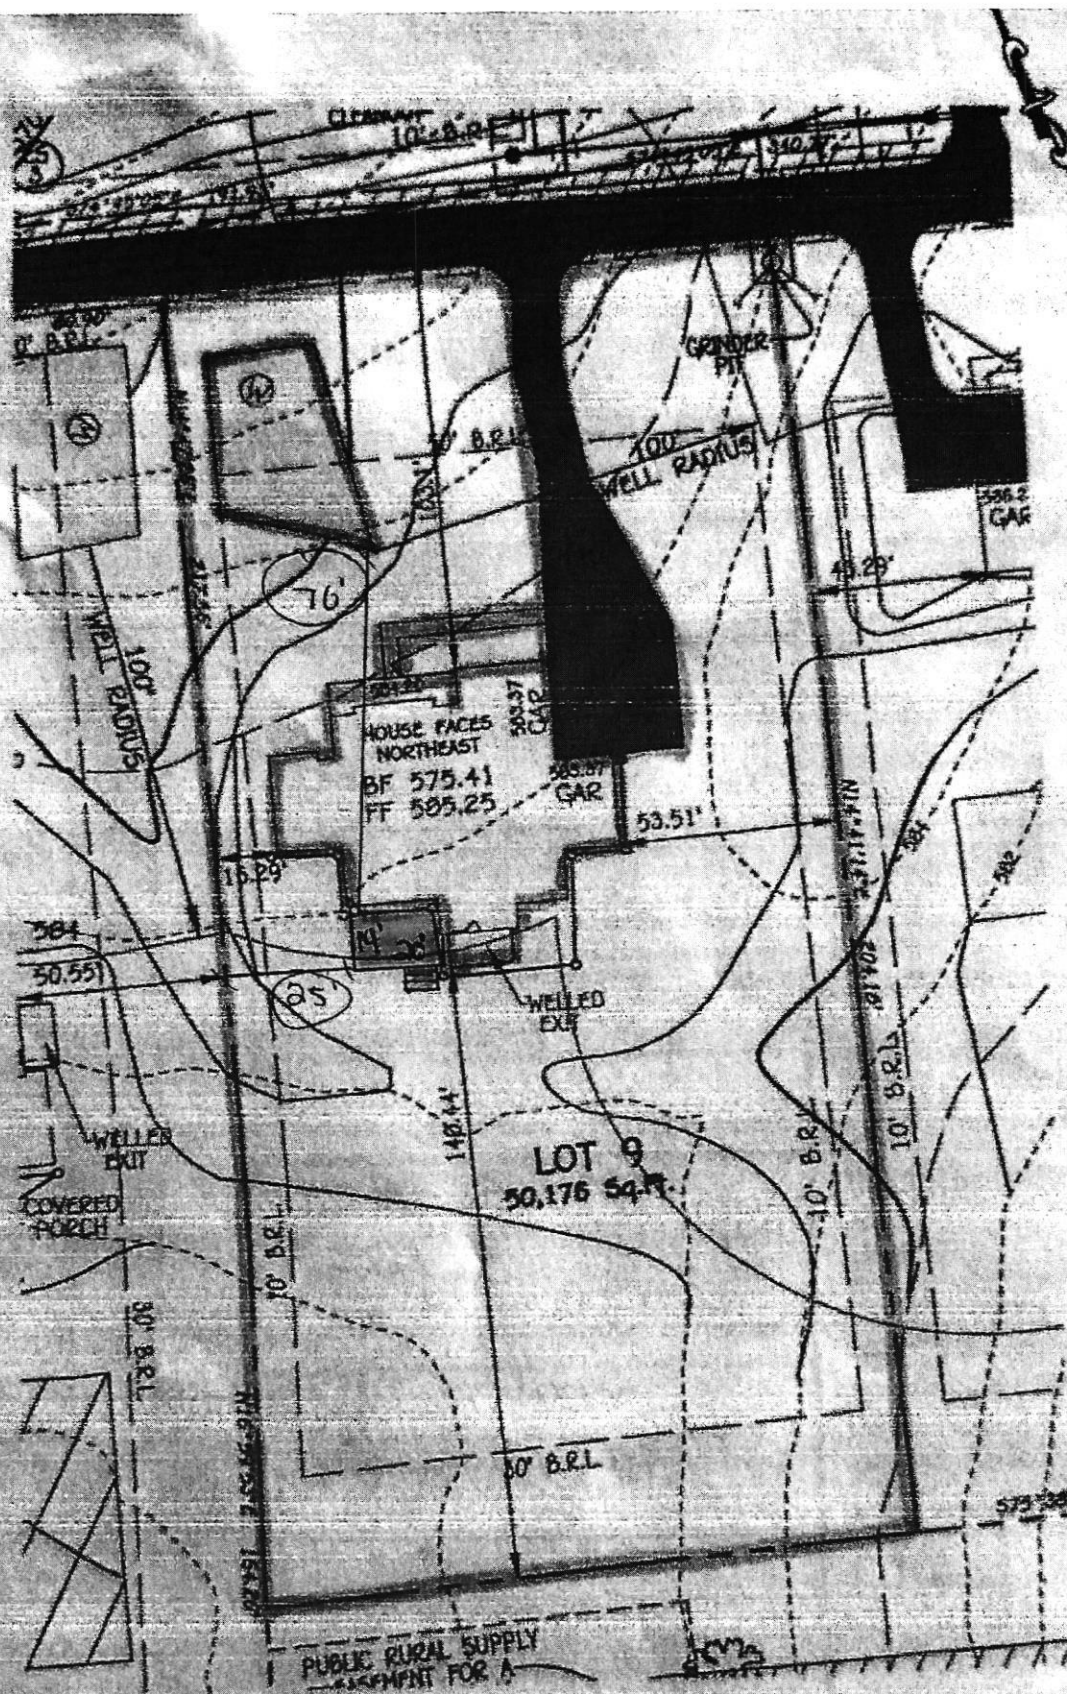


WELL CERTIFICATION

THE EXISTING WELL TAG NO. HO-22-0101, HAS BEEN FIELD LOCATED AND IS ACCURATELY SHOWN.

BRICKELL PROPERTY

PERMIT SITE PLAN
LOT 9

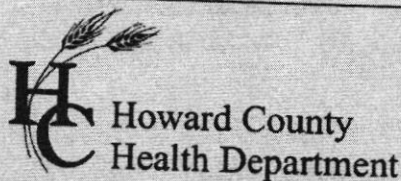**Bureau of Environmental Health**

8930 Stanford Boulevard, Columbia, MD 21045

Main: 410-313-2640 | Fax: 410-313-2648

TDD 410-313-2323 | Toll Free 1-866-313-6300

www.hchealth.orgFacebook: www.facebook.com/hocohealth

Maura J. Rossman, M.D., Health Officer

RECEIPT DATE: 9/22/25**ONSITE SEWAGE DISPOSAL SYSTEM**P 590215

INSTALLATION

APPROVAL DATE: 1/13/2026 **PERMIT**

A _____

SEWER HOUSE CONNECTIONPROPERTY ADDRESS: 1730 Brickell WaySUBDIVISION: Brickell PropertyLOT: 9

TAX ID: _____

CONTRACTOR: South Carroll Backhoe

EMAIL: _____

CONTRACTOR ADDRESS: 4410 Salem Bottom Road, Westminster, MD 21157PHONE: 410-596-3618PROPERTY OWNER: NVR. Inc.

EMAIL: _____

OWNER ADDRESS: 7080 Samuel Morse Drive, Columbia, MD 21046PHONE: 301-432-6611NUMBER OF BEDROOMS: 5 CONNECTED TO PUBLIC WATER: ☐ YES ☒ NO


LOCATION:	INSTALL 4" SEWER LINE PER APPROVED SITE PLAN.
NOTES:	Shared Septic System

ISSUED BY: Robert FreemanISSUE DATE: 1/9/26EXPIRATION DATE: 10/27 9-22-26**NOTE:**CONTRACTOR REGISTERED WITH THE STATE OF MD ON-SITE WASTEWATER PROFESSIONALS BOARD: CONFIRMED ☐**NOTE: HOWARD COUNTY BUREAU OF UTILITIES APPROVAL OF GRINDER PUMP INSTALLATION IS REQUIRED PRIOR TO SEPTIC PERMIT APPROVAL****NOTE: CONTRACTOR MUST SCHEDULE AN INSPECTION AND GAIN APPROVAL OF ALL COMPONENTS PRIOR TO COVERING****NOTE: AN ELECTRICAL PERMIT IS REQUIRED FOR INSTALLATION OF ANY ELECTRICAL COMPONENTS OF THE SYSTEM**

**NEITHER THE HOWARD COUNTY COUNCIL NOR THE HEALTH DEPARTMENT IS RESPONSIBLE
FOR THE SUCCESSFUL OPERATION OF ANY SYSTEM.**

PERMITTEE RESPONSIBLE FOR OBTAINING FINAL APPROVAL ON THIS PERMIT.

CALL 410-313-1771 FOR INSPECTION OF SEPTIC SYSTEM.

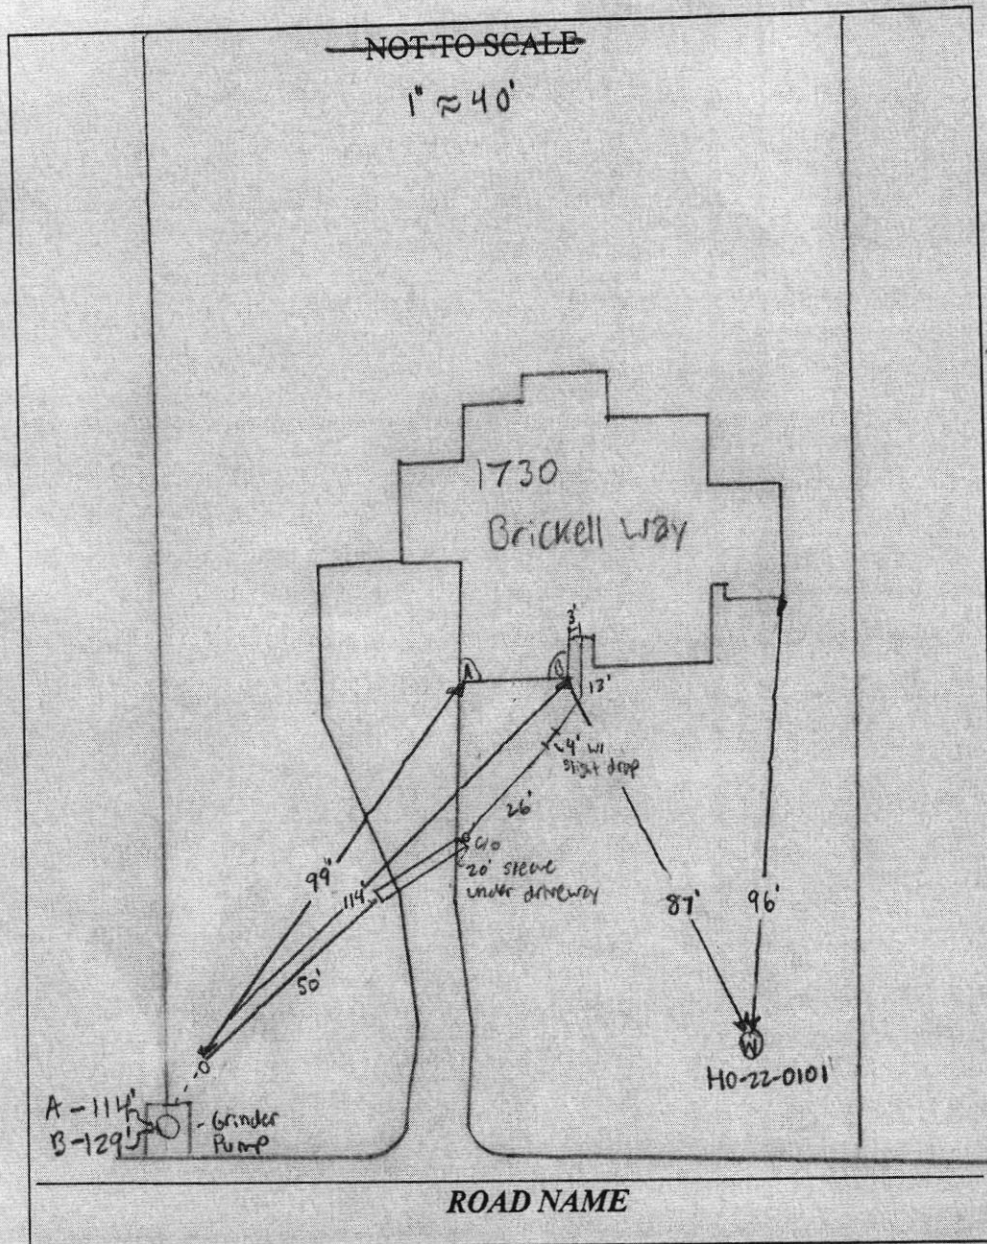

N/A

TRENCH/DRAINFIELD DATA		
WIDTH	INLET	BOTTOM
NUMBER OF TRENCHES _____		
TOTAL LENGTH _____		
ABSORPTION AREA _____		
DISTRIBUTION BOX LEVEL _____		
DISTRIBUTION BOX BAFFLE _____		
DISTRIBUTION BOX PORT _____		

N/A

SEPTIC TANK DATA	
SEPTIC TANK 1 LEVEL _____	
MANUFACTURER _____	
CAPACITY _____	GAL
SEAM LOC _____	
TANK LID DEPTH _____	
BAFFLES _____	
BAFFLE FILTER _____	
MANHOLE LOC _____	
6" PORT LOC _____	
WATERTIGHT TEST _____	
SLOTTED _____	
DATE ON LID _____	
PUMP/SEPTIC TANK LEVEL _____	
MANUFACTURER _____	
CAPACITY _____	GAL
SEAM LOC _____	
TANK LID DEPTH _____	
BAFFLES _____	
BAFFLE FILTER _____	
MANHOLE LOC _____	
6" PORT LOC _____	
WATERTIGHT TEST _____	
SLOTTED _____	
DATE ON LID _____	

SEPTIC CONTRACTOR ONSITE INSTALLING SYTEM: Andrew Schisler
 SEPTIC CONTRACTOR ONSITE LICENSED WITH THE STATE OF MD: YES/NO

PRE-CONSTRUCTION NOTES:

1/9/2026 - Plans Approved. RSE

N/A

CONTROL PANEL DATA	
CONTROL PANEL HEIGHT (MIN 30") _____	
INSPECTION DATE _____	
INSPECTION: PASS/FAIL (CIRCLE ONE) _____	

INSTALLATION NOTES:

1/13/2026 - Sewer coming out of house 15' from original loc. elevations the same, 1% fall on majority of line w/ more fall @ drop closer to house. SCHD 40 PVC used. 6" sleeve under driveway. OK to Backfill all work. SP

FINAL INSPECTOR S. Page DATE OF APPROVAL 1/13/2026