

Menu Save Reset Cancel Help

Record Detail * (This section is required.)

Permit Type Permit Number Opened Date
Building/Residential/Misc/Deck B26001675 05/19/2026
Description of Work
SF DUP/ CONSTRUCT 10' X 10' FREESTANDING DECK W/ 4' X 25' DECK SECTION**SUBJECT TO FIELD INSPECTION**

Need updated plot plan.

gls 6/8/25

[check spelling](#)

Address * (This section is required.)

Search Reset Clear Get Parcel & Owner
Street # Street Name Street Type
8545 LALLYBROCH LN
Unit Type Unit # X Coordinate Y Coordinate
--Select--
City State Zip Code Primary
FULTON MD 20759 Yes

New plan OK.
BP approved.
gls 6/30/26

Parcel * (This section is required.)

Search Reset Clear Get Address & Owner
GIS ID * Parcel Parcel Area Land Value Improved Value Exemption Value Plan Area
11062622 0135 0 0 0 0 RURAL
Legal Description

[check spelling](#)

Block Lot Census Tract Council Dist Inspection Dist Supervisor Dist Map # DAP Zone
24 PAR A 605102 4
Plan Area State Tax Id Subdivision Name
Section Area Tax Map
Grid Zoning District ADC Map
46-1 RR-DEO 5052-A6
SDP No. Final Plan No. WP File No.
SDP-23-018 ECP-17-056
Record Plat No. WS Contract No. FDP No. Primary
26646-2665
Owner Occupied Year Built Historic District
Yes No
Historic District Registry No. Stat Area Flood Plain
5-15A
Building No

Owner * (This section is required.)

Search Reset Clear

Name *
Steven
Address Line 1
8545 Lallybroch Lane

Address Line 2

Address Line 3

Mail City

Fulton

Mail State

MD

Mail Zip Code

20759

Phone

410-499-1536

Primary

Yes

E-mail

stevenjamar@gmail.com

Cell Number

Fax Number

Professionals (This section is not required.)

License # *

08050121532

License Type *

MHIC Co

Primary

Yes

Business Name

BUDDING BRANCH LANDSCAPE & DESIGN

First Name

✓ ROBERT

Middle Name

COGAN

Last Name

BOSWELL

Address Line 1

✓ 14900 TRIADELPHIA ROAD

Address Line 2

City

GLENELG

State

MD

ZIP Code

21737-0000

Phone 1

4103654000

Phone 2

Fax

4104890269

E-mail

ROB.BUDDINGBRANCH@GMAIL.COM

Applicant (This section is not required.)

Search

As Owner

As Lic. Prof

As Contact

Type *

Applicant

Relationship

Applicant

Primary

Yes

First Name

✓ ROBERT

MI

Last Name

COGAN BOSWELL

Full Name

✓

Organization Name

BUDDING BRANCH LANDSCAPE & DESIGN

Street Address

14900 TRIADELPHIA ROAD

Address Line 2

City

GLENELG

State

MD

Zip Code

21737-0000

Phone

4103654000

Cell

Fax

4104890269

E-mail *

ROB.BUDDINGBRANCH@GMAIL.COM

Addtl Info

Est Construction Cost *

10000

Housing Units *

0

Number of Buildings *

0

Public Owned

No

Construction Type

434 - Additions, Alterations and Conversions - Residential

MISC PERMIT INFO

MISCELLANEOUS PERMIT INFORMATION

Capital Project-No Fee *

Yes

No

Capital Project Number

(Text)

Fee Exempt *

Yes

No

Fee Exempt Group

--Select--

Roadside Tree Project Permit *

Yes

No

Roadside Tree Project Permit #

(Text)

Existing Use *

Duplex

Water

Private

Sewage


Private

Expiration Date

11/23/2026

Submit

Cancel

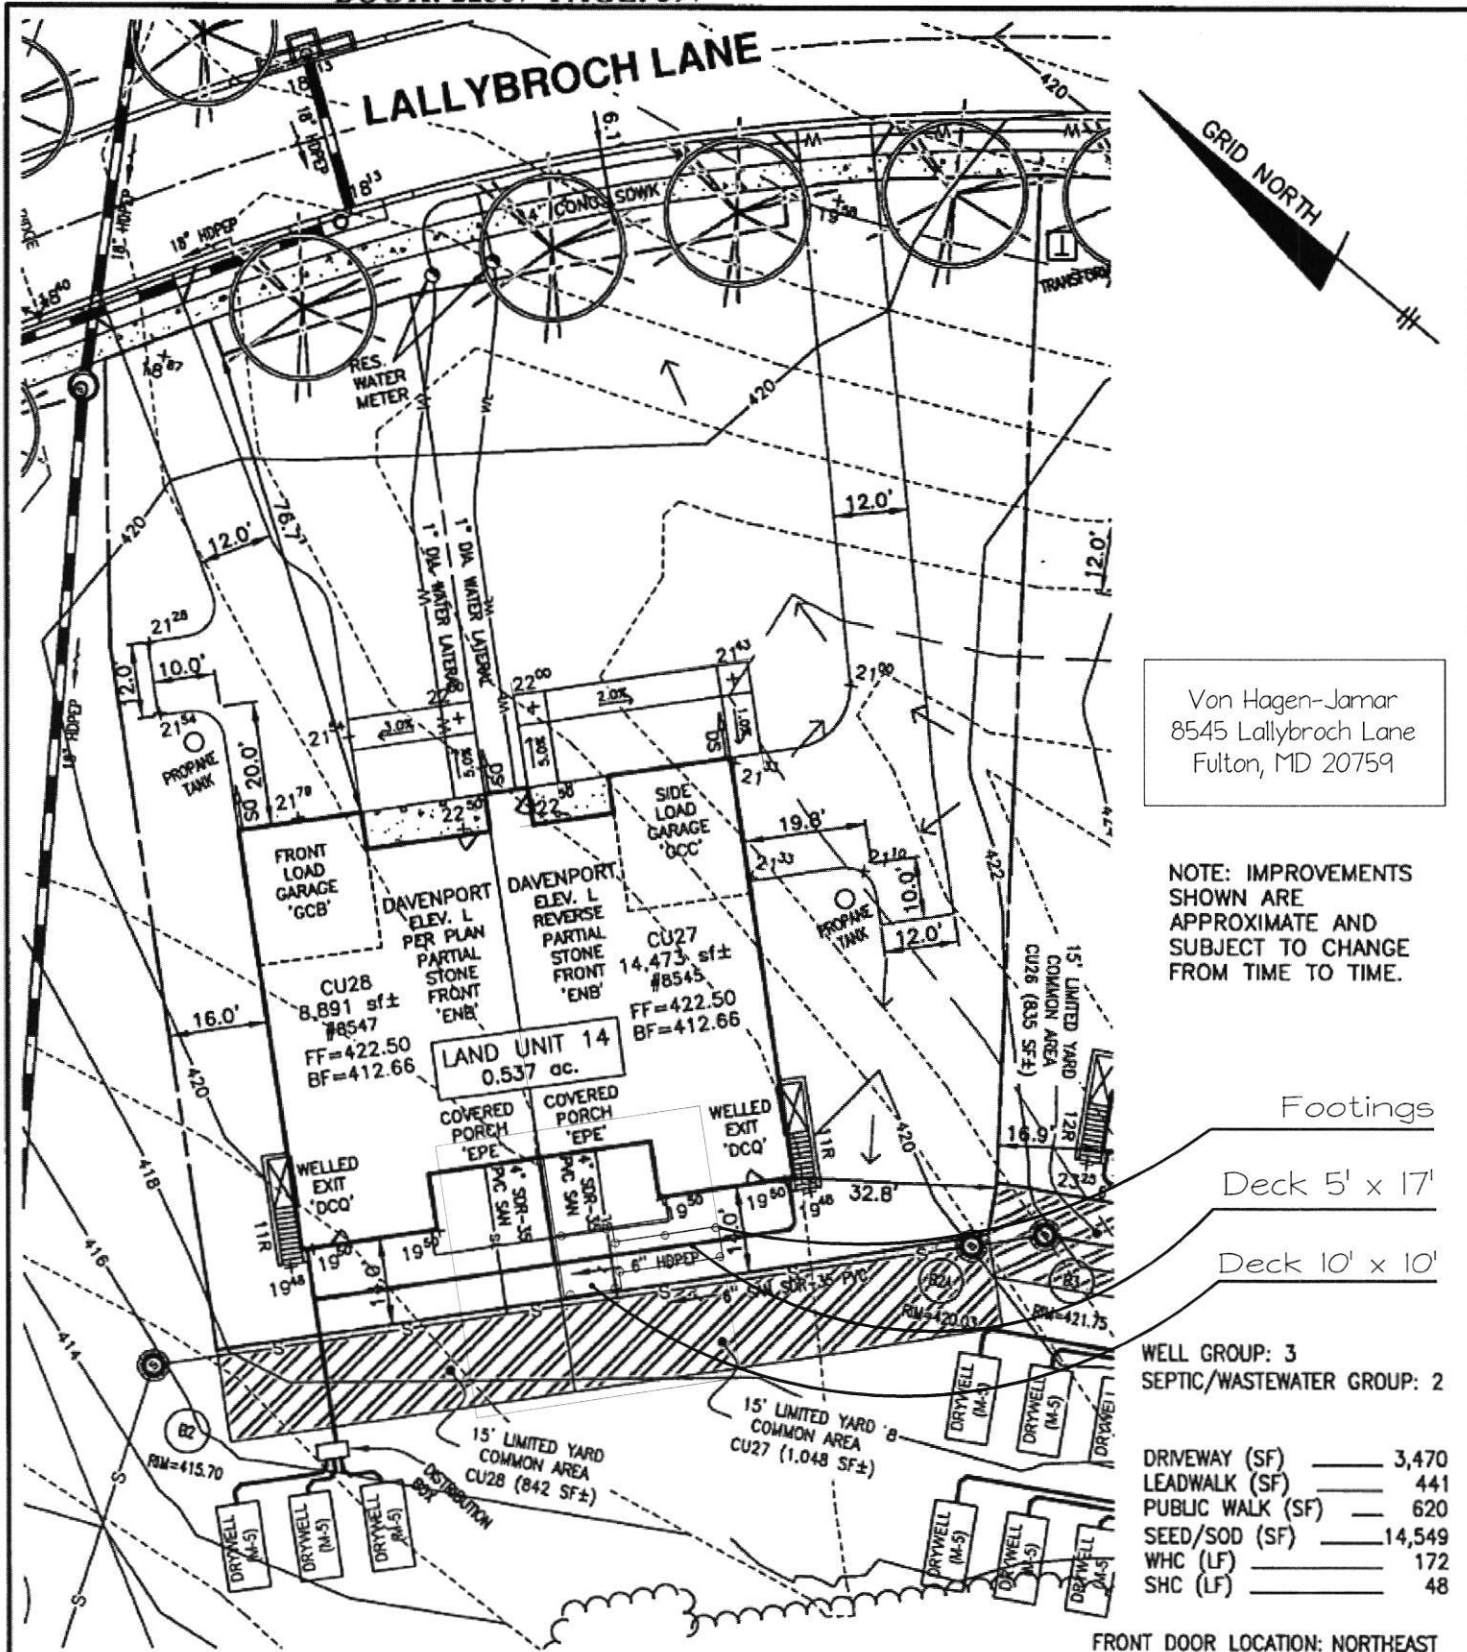

REFER TO RECORD PLAT #26616-26619
FOR ALL PROPERTY LINE DIMENSIONS,
EASEMENTS, AND RESTRICTIONS.

BENCHMARK

ENGINEERS & LAND SURVEYORS & PLANNERS


ENGINEERING, INC.

MAPLE HIGHLANDS SDP-23-018

LAND UNIT 14 - CU27/CU28
#8545 AND #8547 LALLYBROCH LN
BUILDING PERMIT PLAN

TM: 40
BLOCK: 24
PARCEL: 135
ZONE: RR-DEO

SCALE: 1" = 30'
NOVEMBER 8, 2024

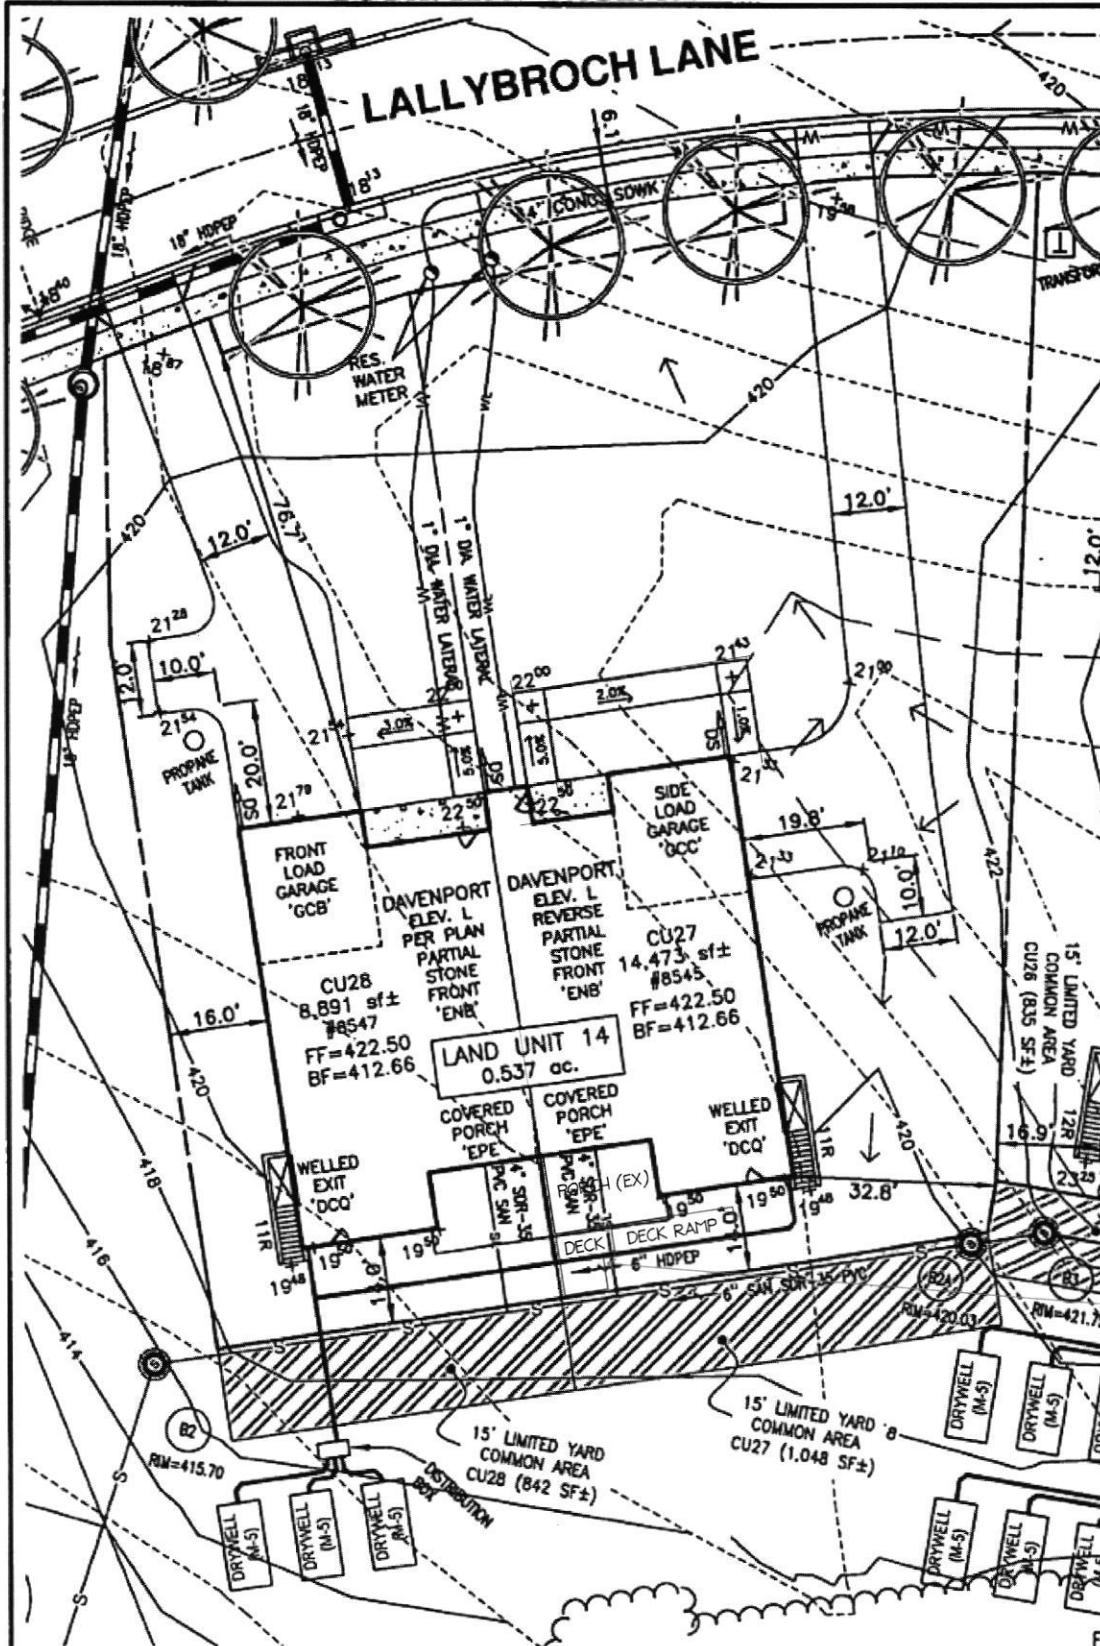

REFER TO RECORD PLAT #26616-26619
FOR ALL PROPERTY LINE DIMENSIONS,
EASEMENTS, AND RESTRICTIONS.

BENCHMARK

ENGINEERS • LAND SURVEYORS • PLANNERS
ENGINEERING, INC.

MAPLE HIGHLANDS **SDP-23-018**

LAND UNIT 14 - CU27/CU28
#8545 AND #8547 LALLYBROCH LN
BUILDING PERMIT PLAN

TM: 40
BLOCK: 24
PARCEL: 135
ZONE: RR-DEO

SCALE: 1" = 30'
NOVEMBER 8, 2024