

Approved 8/4/26

- H.O.

Menu Save Reset Cancel Help

Record Detail * (This section is required.)

Case

EH-PLANS-26-0

Type

EnvHealth/Environmental Health/Plan Check/Application

Status

In Review

Opened Date

08/03/2026

Single Entry Edit-View Record Form

Application Name

B26002553

Description

SFD INTERIOR ALTERATIONS TO UNFINISHED BASEMENT SPACE TO CREATE FINISHED REC ROOM, (1) FINISHED 14' X 14' STORAGE ROOM, WET BAR, SITTING ROOM, THEATER ROOM, (1) 14' X 14' UNFINISHED STORAGE ROOM, CREATE WALL FOR EXISTING GYM**SUBJECT TO FIELD INSPECTION**

Total Invoiced

0.00

Total Paid

0.00

Balance

0.00

Assigned to Department

Current Department

Well and Septic Program

Assigned to Staff

Current User

Zack Silvast

Address * (This section is required.)

New	Search	Delete	Set Primary											
☐ Primary	<u>Street # (start)</u>	<u>Direction</u>	<u>Street Name</u>	<u>Street Type</u>	<u>City</u>	<u>State</u>	<u>Zip Code</u>	<u>Address Status</u>	<u>Street Suffix (Direction)</u>	<u>Unit Type</u>	<u>U</u>			
☐ ☒	14905		Meriwether	DR	Glenelg	MD	21737							

Parcel (This section is not required.)

Search	Delete	Get Address & Owner		Set Primary						
☐ Primary	Parcel #	Book	Page	Parcel	Parcel Area	Land Value	Improved Value	Exemption Value	Legal Description	Tract
0 record(s) found.										

Owner (This section is not required.)

Search	Delete	Set Primary												
☐ Primary		Name	Mail Address Line1	Mail Address Line2	Mail Address Line3	Mail City	Mail State	Mail Zip Code	Phone	Country/Region				
☐ ☒		Yehonatan Palmor	14905 Meriwether Dr.			Glenelg	MD	21737		US				

Applicant * (This section is required.)

Search As Owner As Lic. Prof As Contact

Single Entry Applicant Form

Type *

Applicant

Primary

Yes

Full Name

First Name *

Chris

Middle Name

Last Name *

Berarducci

Organization Name *

Berarducci Builders Inc.

Mobile Phone ((xxx)xxx-xxxx)

(443) 797-9409

Home Phone ((xxx)xxx-xxxx)

E-mail

CFUCO1@HOTMAIL.COM

Business Phone ((xxx)xxx-xxxx)

Preferred Channel

--Select--

Applicant Address

New

Look Up

Deactivate

Remove

☐ Contact Address ID	Address Type	Address Line 1	City	State	Zip	Primary	Recipient	Status
0 record(s) found.								

Custom Fields

DATE TRACKING

Received Date

7/30/2026

Due Date

8/12/2026

Dates to Complete

14

(Number)

Received by Food

Food Review Type

--Select--

Equipment Specification Sheets Submitted

Equipment Specification Sheet

Received by Community Hygiene

Received by Well and Septic

7/30/2026

FACILITY INFORMATION

Name of Business (dba) *

n/a (Text)

Associated Building Permit Number

(Text)

Owner Switch Date

(Text)

Does the project include an Aquatic Facility such as a Public Pool? If Yes, forward to CH Program.

☐ Yes ☐ No

Does the project include Private Septic? If Yes, forward to WS Program.

☐ Yes ☐ No

Is this a Prototype Food Service Facility? If Yes, refer to State.

☐ Yes ☐ No

Facility Fax

0 (Text)

Days of Operation

0 (Text)

Does this project have a Building Permit?

☐ Yes ☐ No

Building Permit Issued Date

(Text)

☐ Non-Profit

Does the project include Private Well? If Yes, forward to WS Program.

☐ Yes ☐ No

Does the project include Food Services? If Yes, forward to FP Program.

☐ Yes ☐ No

Facility Phone

0 (Text)

Facility Email

0 (Text)

PROPERTY INFORMATION

Water Source

--Select--

Sewage Disposal

--Select--

Design Wastewater Flow

(Number)

Permit Type

--Select--

PLAT STATS

Total Number of buildable lots to be recorded 0 (Number)	Total number of open space lots to be recorded 0 (Number)
Total number of bulk parcels to be recorded 0 (Number)	Total number of lots / parcels to be recorded 0 (Number)
New buildable lots created 0 (Number)	Date PLAT signed by Health Officer [Date Picker]
PLAT Type --Select--	Date Preliminary Plan Signed by HO [Date Picker]

☐ Extension Granted**DEVELOPMENT PLANS**

Property Type Residential	Plan Version Initial
Signature Required ☐ Yes ☐ No	Engineer 0 (Text)
Number of paper copies 0 (Number)	Number of mylar copies 00 (Number)
Number of buildable lots created 0 (Number)	Number of non-buildable lots created 0 (Number)
Total Number of Lots 0 (Number)	Associated Plans [Text Area]

WELL AND SEPTIC INTERNAL

State Review Required ☐ Yes ☐ No	Coordinate State Review ☐ Yes ☐ No
Proposed Septic System Type --Select--	

FOOD ESTABLISHMENT FACILITY

Priority Assessment --Select--	Licensed Type --Select--
License Category --Select--	

FOOD ESTABLISHMENT INFORMATION

Hours of Operation [Text] (Text)	☐ Operating Seasonally Only
If Operating Seasonally, What is the start month? [Text] (Text)	Are pets allowed in a outdoor seating area? ☐ Yes ☐ No
Full Bar? ☐ Yes ☐ No	


RESTAURANT AND FOOD SERVICE

Food Service Facility Secondary Category --Select--	Total Seating Capacity [Text] (Number)
Number of Restrooms [Text] (Number)	Interior Restaurant Seating Capacity [Text] (Number)
Bar Seating Capacity [Text] (Text)	Outdoor Seating Capacity [Text] (Text)
Does the restaurant have outdoor seating ☐ Yes ☐ No	

EQUIPMENT

Evaluated non NSF, ANSI, CF or other standards ☐ Yes ☐ No	Description of Refrigeration Units [Text]
Number of Walk-In Refrigerator Units [Text] (Number)	Description of Walk-In Freezer Units [Text] (Text)
Is there a bulk ice machine available ☐ Yes ☐ No	Space Limitation [Text]
Number of Hand Sinks Available [Text]	Hood System [Text]


04-05-12 SV/AH

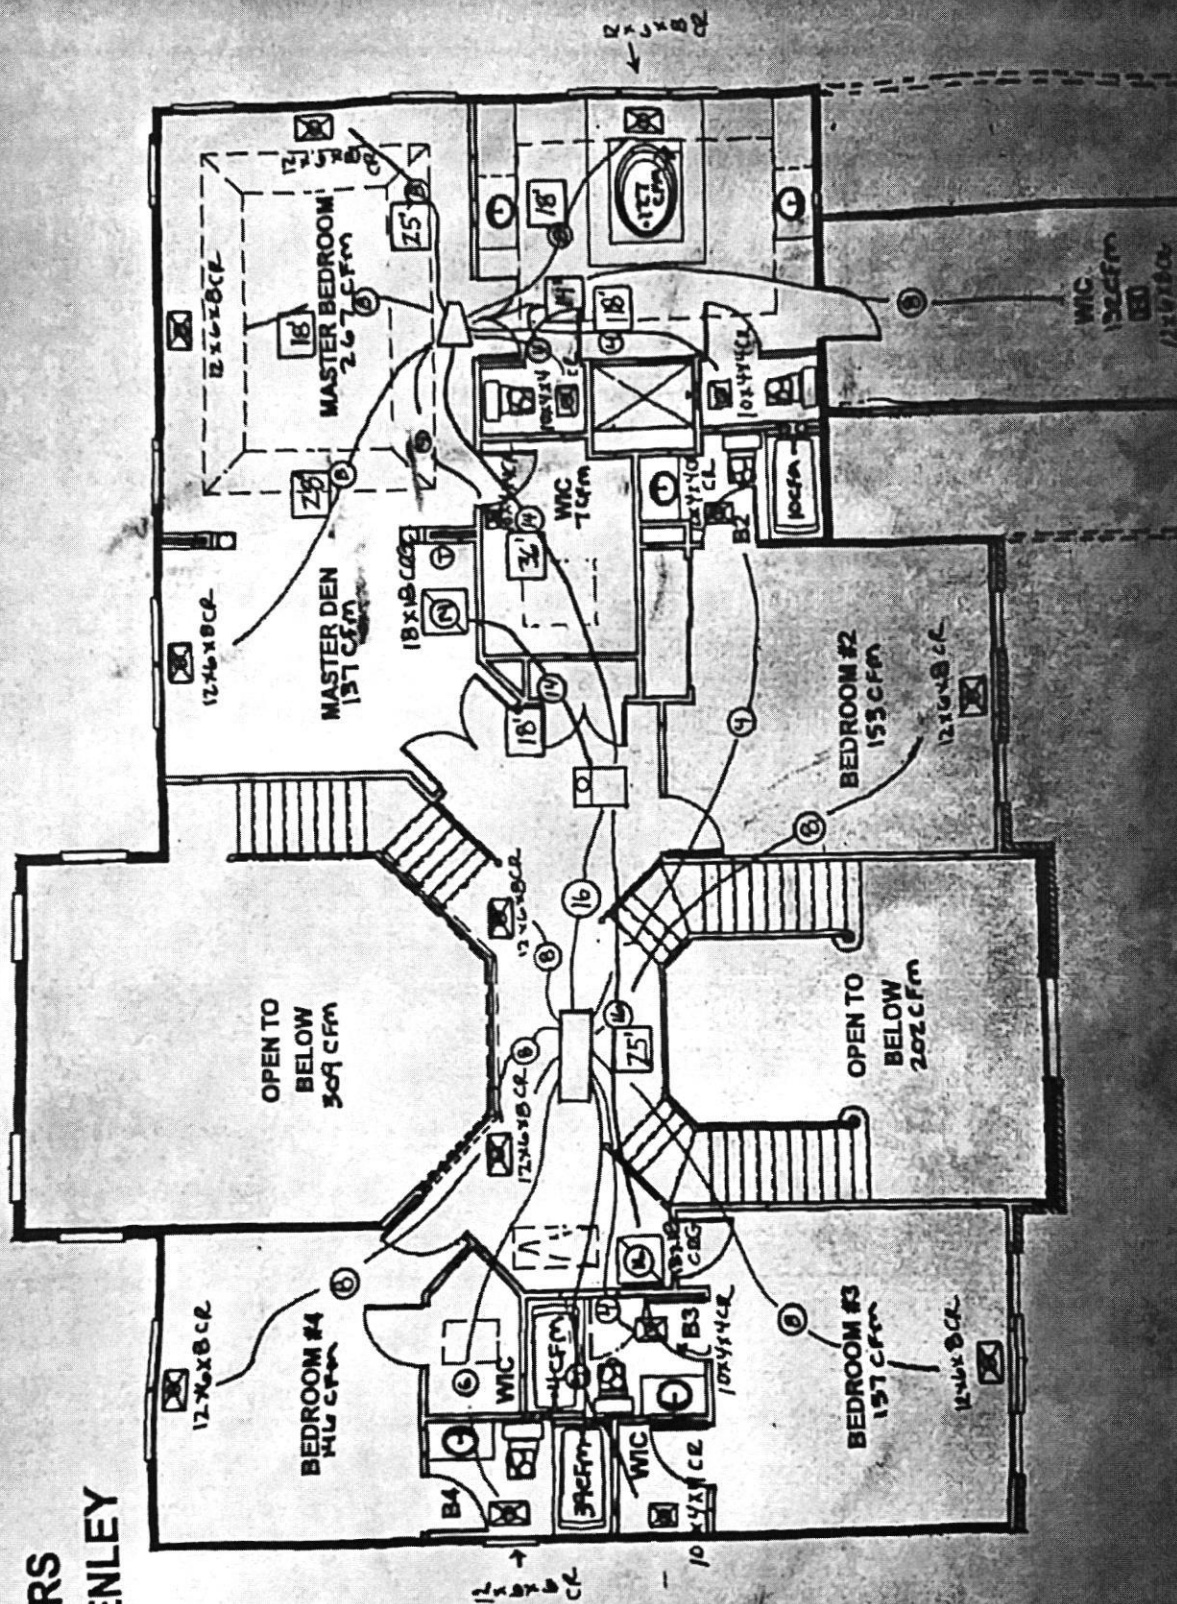

**TOLL BROTHERS
HAMPTON
1st FLOOR
#501 SOLARIUM**

2-12-09LR

3/4 ton

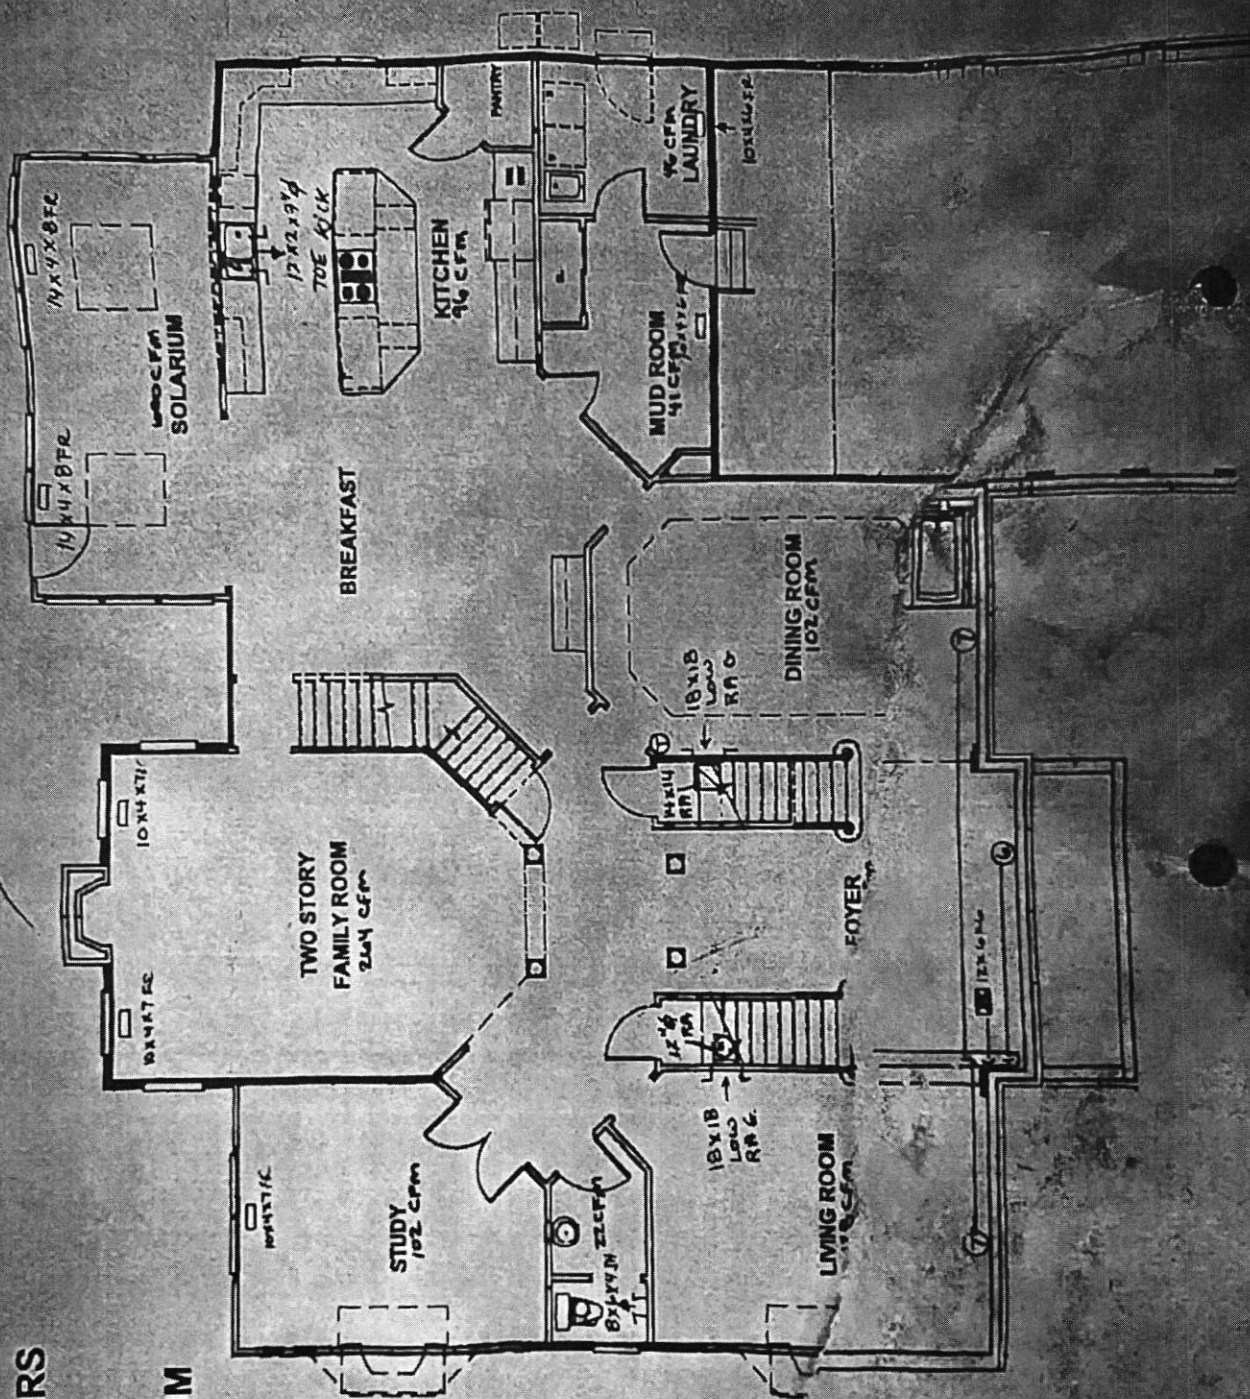

7/21/26

*BERARDINI COM

SCALE: $\frac{1}{8}" = 1'$

