

Menu Save Reset Cancel Help

Approved 7/27/26
-H.O.

Record Detail * (This section is required.)

Case

EH-PLANS-26-0

Type

EnvHealth/Environmental Health/Plan Check/Application

Status

In Review

Opened Date

07/09/2026

Single Entry Edit-View Record Form

Application Name

B26001993

Description

SFD/DEMO AND HAUL AWAY EXISTING DECK, BUILD A NEW 20X16 SCREEN PORCH AND A 16X6 DECK WITH STEPS TO GRADE

Total Invoiced

0.00

Total Paid

0.00

Balance

0.00

Assigned to Department Current Department

Well and Septic Program

Assigned to Staff Current User

Zack Silvast

Address * (This section is required.)

New Search Delete Set Primary

☐ Primary	Street # (start)	Direction	Street Name	Street Type	City	State	Zip Code	Address Status	Street Suffix (Direction)	Unit Type	U
☒	7290		Meadow ...	WAY	Clar...	MD	21029				

Parcel (This section is not required.)

Search Delete Get Address & Owner Set Primary

☐ Primary	Parcel #	Book	Page	Parcel	Parcel Area	Land Value	Improved Value	Exemption Value	Legal Description	Tract
0 record(s) found.										

Owner (This section is not required.)

Search Delete Set Primary

☐ Primary	Name	Mail Address Line1	Mail Address Line2	Mail Address Line3	Mail City	Mail State	Mail Zip Code	Phone	Country/f
☒	Matthew Schechter	7290 Meadow Wood Way			Clarksville	MD	21029		US

Applicant * (This section is required.)

Search As Owner As Lic. Prof As Contact

Single Entry Applicant Form

Type *

Applicant

Primary

Yes

Full Name

First Name *

Online BP. 9/8 7/13/26

Nicholas
Middle Name

Last Name *

Wilson

Organization Name *

Custom Works Inc.

Mobile Phone ((xxx)xxx-xxxx)

(443) 926-2619

Home Phone ((xxx)xxx-xxxx)

E-mail

nwilson@cwincmd.com

Business Phone ((xxx)xxx-xxxx)

Preferred Channel

--Select--

Applicant Address

New

Look Up

Deactivate

Remove

Custom Fields

DATE TRACKING

Received Date

7/9/2026

Due Date

7/23/2026

Dates to Complete

14

(Number)

Received by Food

Food Review Type

--Select--

Equipment Specification Sheets Submitted

Equipment Specification Sheet

Received by Community Hygiene

Received by Well and Septic

7/9/2026

FACILITY INFORMATION

Name of Business (dba) *

n/a (Text)

Associated Building Permit Number

(Text)

Owner Switch Date

Does the project include an Aquatic Facility such as a Public Pool? If Yes, forward to CH Program.

☐ Yes ☐ No

Does the project include Private Septic? If Yes, forward to WS Program.

☐ Yes ☐ No

Is this a Prototype Food Service Facility? If Yes, refer to State.

☐ Yes ☐ No

Facility Fax

(Text)

Days of Operation

(Text)

Does this project have a Building Permit?

☐ Yes ☐ No

Building Permit Issued Date

☐ Non-Profit

Does the project include Private Well? If Yes, forward to WS Program.

☐ Yes ☐ No

Does the project include Food Services? If Yes, forward to FP Program.

☐ Yes ☐ No

Facility Phone

(Text)

Facility Email

(Text)

PROPERTY INFORMATION

Water Source

--Select--

Sewage Disposal

--Select--

Design Wastewater Flow

(Number)

Permit Type

--Select--

DEVELOPMENT PLANS

Property Type

Residential

Plan Version

Initial

Signature Required

☐ Yes ☐ No

Engineer

(Text)

Number of paper copies

(Number)

Number of mylar copies

(Number)

Number of buildable lots created

(Number)

Number of non-buildable lots created

(Number)

(Number)

(Number)

Total Number of Lots

Associated Plans

0
(Number)

WELL AND SEPTIC INTERNAL

State Review Required

☐ Yes ☐ No

Coordinate State Review

☐ Yes ☐ No

Proposed Septic System Type

--Select--

FOOD ESTABLISHMENT FACILITY

Priority Assessment

--Select--

Licensed Type

--Select--

License Category

--Select--

FOOD ESTABLISHMENT INFORMATION

Hours of Operation

(Text)

☐ Operating Seasonally Only

If Operating Seasonally, What is the start month?

(Text)

Are pets allowed in a outdoor seating area?

☐ Yes ☐ No

Full Bar?

☐ Yes ☐ No**RESTAURANT AND FOOD SERVICE**

Food Service Facility Secondary Category

--Select--

Total Seating Capacity

(Number)

Number of Restrooms

(Number)

Interior Restaurant Seating Capacity

(Number)

Bar Seating Capacity

(Text)

Outdoor Seating Capacity

(Text)

Does the restaurant have outdoor seating

☐ Yes ☐ No**EQUIPMENT**

Evaluated non NSF, ANSI, CF or other standards

☐ Yes ☐ No

Description of Refrigeration Units

Number of Walk-In Refrigerator Units

(Number)

Description of Walk-In Freezer Units

(Text)

Is there a bulk ice machine available

☐ Yes ☐ No

Space Limitation

Number of Hand Sinks Available

(Number)

Hood System

(Text)

Ventless Equipment

(Text)

PLUMBING

Size and installation of the water heater?

(Text)

Is there a grease interceptor or grease trap?

--Select--

REFUSE AND RECYCLABLES

Dumpsters Located on a impervious surface?

--Select--

Will there be a grease receptacle?

--Select--

WAREWASHING DISHWASHING

Dishwashing Method

--Select--

HACCP

Plan Review Response Letter Received

☐ Yes ☐ No

Date HACCP Approved by the State

Date HACCP Plan Submitted

HACCP Plan Approved

Maura J. Rossman, M.D., Health Officer

APPLICATION FOR WAIVER

To Howard Co Code Subtitle 8: Onsite Sewage Disposal Systems and Subtitle 9: Individual Potable Water Supply Systems

Date Submitted: 7/14/26

Property Address: 7290 Meadow Wood Way

Simpson Woods

21

1405388929

Subdivision

Lot

Tax Map

Grid

Parcel

Tax Account #

Provide a brief site history including previously submitted and active plans with the Health Department or the County (subdivision plans, perc test applications, Building Permit applications):

Building permit application for a new screen porch and deck

In the area below, list the specific section of the Howard Co Code to which a waiver is being requested and provide a brief summary of the regulation and an explanation of why the waiver is being requested (Attach a separate sheet if necessary).

Regulation Section

Summary and Explanation

1. Section 3.805 (a)

Perc Certification Plan Requirements. Before a building permit is issued, a Perc certification plan shall be submitted and approved that complies with the provisions of this subtitle.

2. _____

Elizabeth Schacht

Property Owner's Signature

Health Department Use Only

Reviewed by

Hank Oswald
HCHD Staff

7/14/26
Date

Comments/Conditions:

approved for deck + porch at location shown on plot plan. Future permit will require revised perc cert plan to resolve setback conflict with house location.

Approved by:

[Signature]
BEH Deputy Director

7/17/26
Date

SITE INSPECTION SHEET

OWNER: Matthew & Elizabeth Schechter PHONE #: _____


ADDRESS: 7290 Meadow Wood Way CONTRACTOR: _____

Clarksville, MD WELL TAG #: HO -73 - 3873

SUBDIVISION: _____ LOT: 21 COUNTY #: _____

PROPOSAL: Construct 20'x16' screen porch & 16'x16' deck

LOCATION DIAGRAM

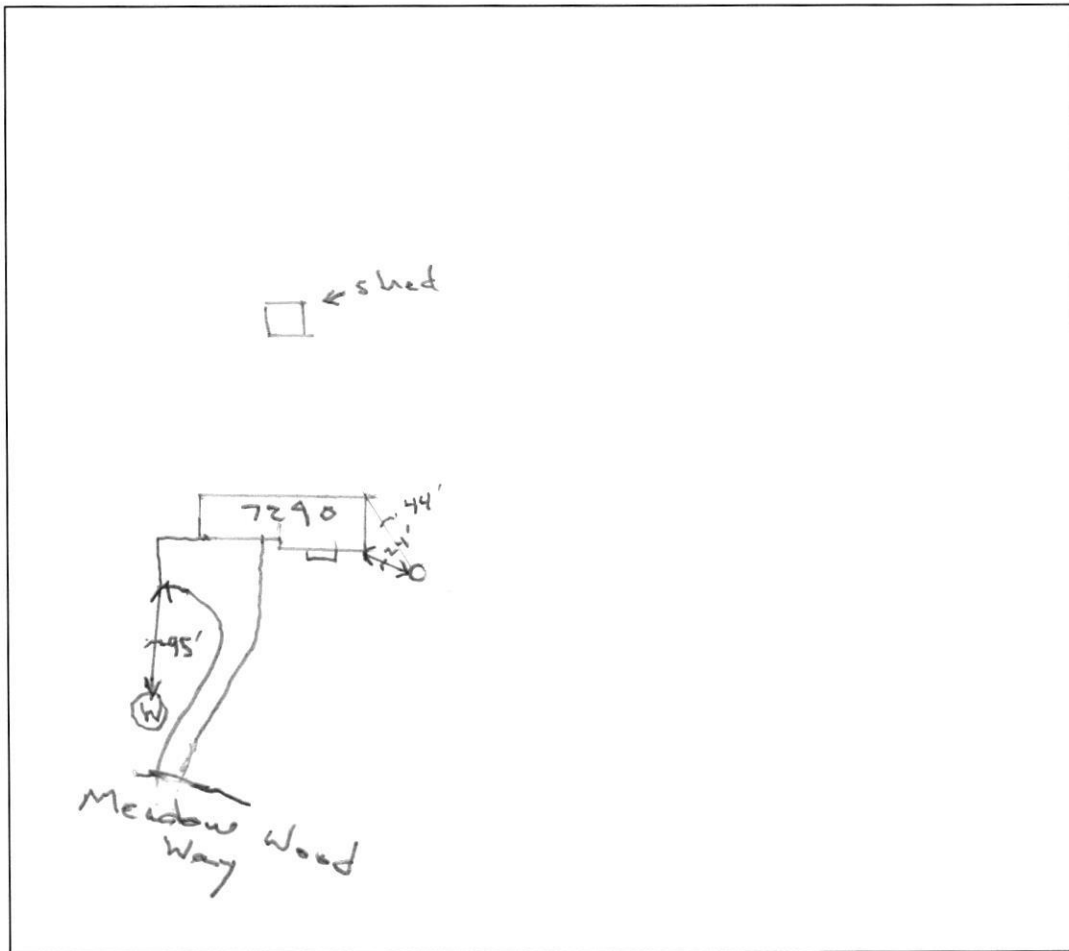

COMMENTS: No observed issues w/ the well or
septic system,


DATE: 7/16/26 INSPECTOR: Hank Oswald

Site Inspection – 7/16/26
7290 Meadow Wood Way
Clarksville, MD




Well

Site Inspection – 7/16/26
7290 Meadow Wood Way
Clarksville, MD

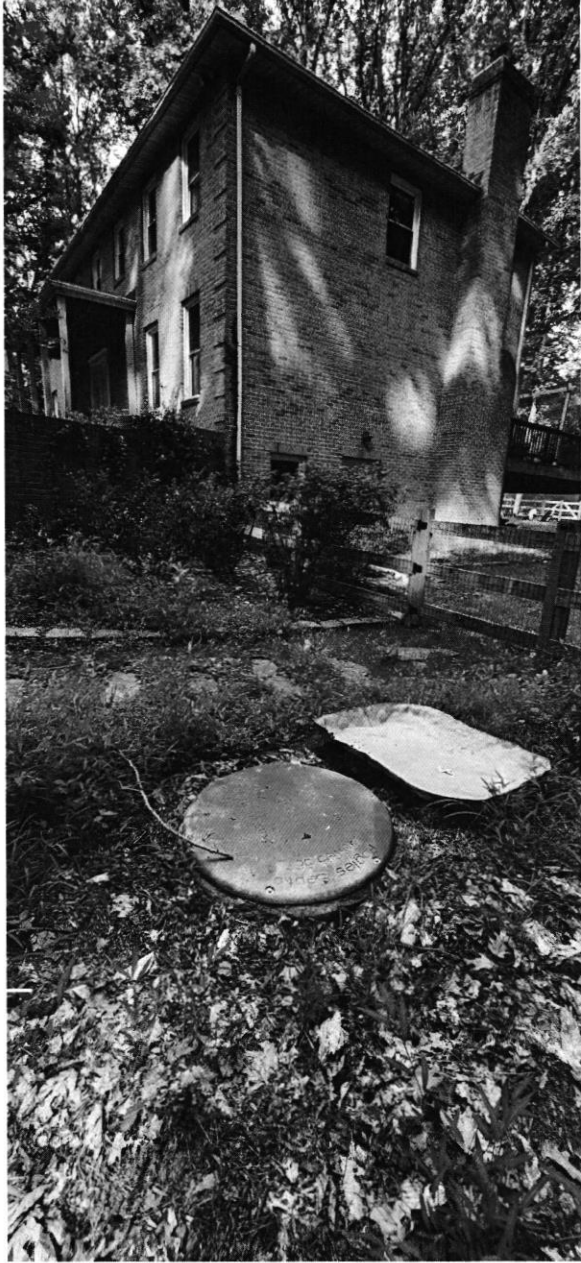

Septic Tank Cleanout

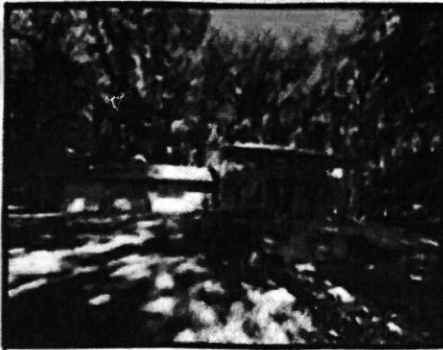


LEGEND


- FENCE
- BE BASEMENT ENTRANCE
- BRL BLDG. RESTRICTION LINE
- BSMT BASEMENT
- CS CONCRETE STOOP OR SLAB
- CONC CONCRETE
- UB UTILITY BOX

COLOR KEY

- (RED) RECORD INFORMATION
- (BLUE) IMPROVEMENTS
- (GREEN) EASEMENTS & RESTRICTION LINES

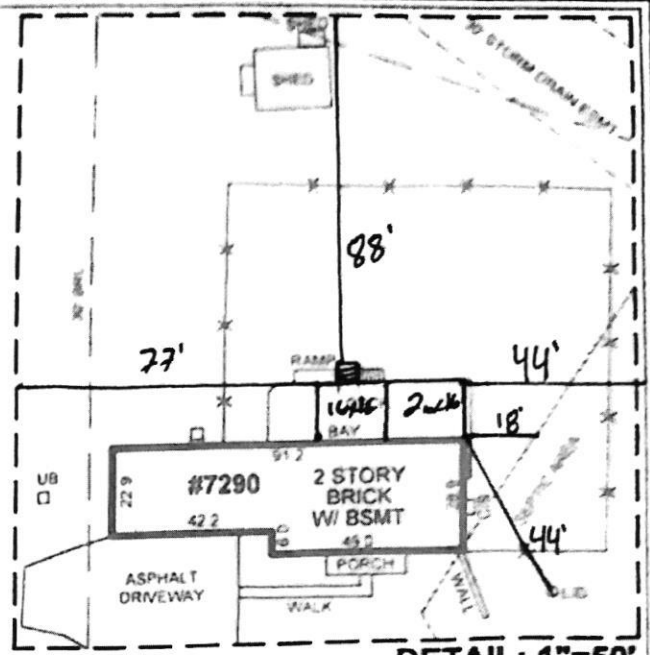

DETAIL: 1"=50'

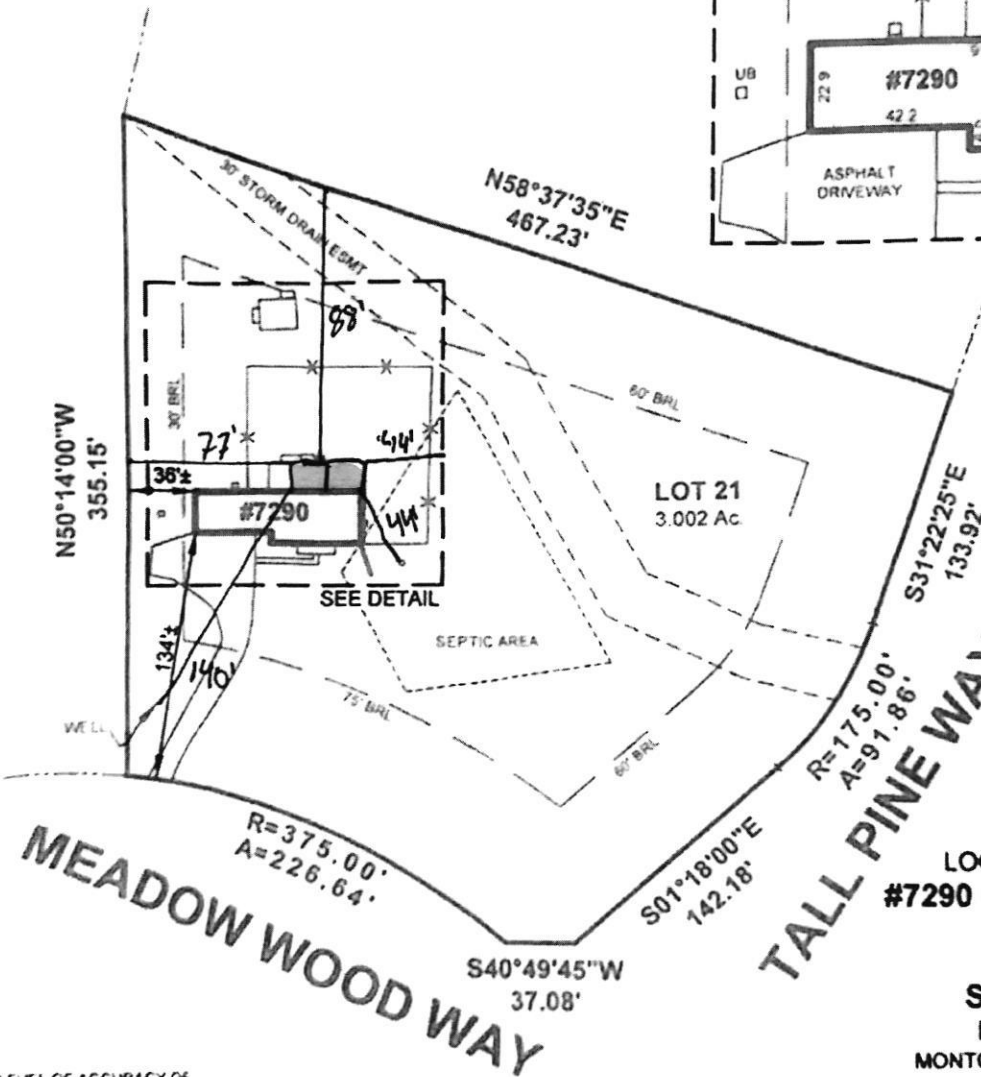

LOCATION DRAWING OF:
#7290 MEADOW WOOD WAY
LOT 21
 SHEET 2 OF 3
SIMPSON WOODS
 PLAT NUMBER 4563
 MONTGOMERY COUNTY, MARYLAND
 SCALE 1"=100' DATE 06-16-2026
 DRAWN BY: AP FILE #: 265156-200

THE LEVEL OF ACCURACY OF
 DISTANCES TO APPARENT
 PROPERTY LINES IS **1"**

SURVEYOR'S CERTIFICATE

I HEREBY STATE THAT I WAS IN RESPONSIBLE CHARGE OVER THE PREPARATION OF THIS DRAWING AND THE SURVEY WORK REFLECTED HEREIN AND IT IS IN COMPLIANCE WITH THE REQUIREMENTS SET FORTH IN REGULATION 12 CHAPTER 08 13 06 OF THE CODE OF MARYLAND ANNOTATED REGULATIONS. THIS SURVEY IS NOT TO BE USED OR RELIED UPON FOR THE ESTABLISHMENT OF FENCES, BUILDING OR OTHER IMPROVEMENTS. THIS PLAT DOES NOT PROVIDE FOR THE ACCURATE IDENTIFICATION OF PROPERTY BOUNDARY LINES BUT SUCH IDENTIFICATION MAY NOT BE REQUIRED FOR THE TRANSFER OF TITLE OR SECURING FINANCING OR REFINANCING. THIS PLAT IS OF BENEFIT TO A CONSUMER ONLY INsofar AS IT IS REQUIRED BY A LENDER OR A TITLE INSURANCE COMPANY OR ITS AGENTS IN CONNECTION WITH THE CONTEMPLATED TRANSFER, FINANCING OR REFINANCING. THE LEVEL OF ACCURACY FOR THIS DRAWING IS 1". NO TITLE REPORT WAS FURNISHED TO NOR DONE BY THIS COMPANY. SAID PROPERTY IS SUBJECT TO ALL NOTES, RESTRICTIONS AND EASEMENTS OF RECORD. BUILDING RESTRICTION LINES AND EASEMENTS MAY NOT BE SHOWN ON THIS SURVEY. IMPROVEMENTS WHICH IN THE SURVEYOR'S OPINION APPEAR TO BE IN A STATE OF DISREPAIR OR MAY BE CONSIDERED TEMPORARY MAY NOT BE SHOWN. IF IT APPEARS ENCROACHMENTS MAY EXIST, A BOUNDARY SURVEY IS RECOMMENDED.



A Land Surveying Company

DULEY

and
Associates, Inc.

Serving D.C. and MD.

14604 Elm Street, Upper Marlboro, MD 20772

Phone 301-888-1111

Fax 301-888-1114

Email orders@duley.biz

On the web: www.duley.biz

Oswald Jr, Woodin

From: Oswald Jr, Woodin
Sent: Tuesday, July 14, 2026 11:10 AM
To: 'nwilson@cwincmd.com'
Cc: 'GWILSON@CWINCMD.COM'
Subject: B26001993_7290 Meadow Wood Way
Attachments: County Waiver Form interactive_Perc Cert Plan Requirements.pdf

Hi Mr. Wilson,

While this is just a deck permit for 7290 Meadow Wood Way , the sewage disposal area (SDA) shown on the site plan does not meet the required 20 foot setback to the house foundation. The only way to reshape the SDA is to have an engineer submit a revised percolation certification plan. Alternatively, you could request a waiver to the perc cert plan requirements by completing the attached form and have the owner sign it. If you decide to request a waiver, I will need to conduct a quick site visit to inspect the existing well and septic area.

Please let me know how you wish to proceed. Should you have any questions, please don't hesitate to ask.

Regards,

Hank

Hank Oswald
Licensed Environmental Health Specialist
Bureau of Environmental Health
Howard County Health Department
8930 Stanford Blvd. Columbia, MD 21045
(410) 313 - 1786
www.hchealth.org

DISCLAIMER: This e-mail is intended only for the individual to whom it is addressed. It may be used only in accordance with applicable laws. If you are not the intended recipient, you are strictly prohibited from reading, disseminating, distributing, or copying this message. If you received this e-mail by mistake, please notify the sender and destroy this e-mail