

Menu Save Reset Cancel Help

Approved 7/13/26
-H.O.

Record Detail * (This section is required.)

Case

EH-PLANS-26-0

Type

EnvHealth/Environmental Health/Plan Check/Application

Status

In Review

Opened Date

07/08/2026

Single Entry Edit-View Record Form

Application Name

B26002240

Description

SFD/Remove existing deck. Existing screened room will stay. Remove and replace to exact same footprint of existing deck. Dig new footers to be code compliant. Decking to be composite with aluminum rails. Deck will be freestanding.**MAXIMUM JOIST SPAN 14 FT, SUBJECT TO FIELD INSPECTION**

Total Invoiced

0.00

Total Paid

0.00

Balance

0.00

Assigned to Department Current Department

Well and Septic Program

Assigned to Staff Current User

Zack Silvast

Address * (This section is required.)

New Search Delete Set Primary

Parcel (This section is not required.)

Search Delete Get Address & Owner Set Primary

☐ Primary Parcel # Book Page Parcel Parcel Area Land Value Improved Value Exemption Value Legal Description Tract
0 record(s) found.

Owner (This section is not required.)

Search Delete Set Primary

☐ Primary Name Mail Address Line1 Mail Address Line2 Mail Address Line3 Mail City Mail State Mail Zip Code Phone Country/Region
☒ Richard Demmitt 13840 Lakeside Drive Clarksville MD 21029 US

Applicant * (This section is required.)

Search As Owner As Lic. Prof As Contact

Single Entry Applicant Form

Type *

Applicant

Primary

Yes

Full Name

First Name *

Roger
Middle Name _____
Last Name * _____
Ford
Organization Name * _____
RLF Contractors
Mobile Phone ((xxx)xxx-xxxx)
(443) 670-2270
Home Phone ((xxx)xxx-xxxx)

E-mail _____
Rlfcontractorsllc@gmail.com
Business Phone ((xxx)xxx-xxxx)

Preferred Channel
--Select-- ▾
Applicant Address
New Look Up Deactivate Remove

Custom Fields

DATE TRACKING

Received Date 7/2/2026 [icon]	Due Date 7/17/2026 [icon]
Dates to Complete 14 (Number)	Received by Food [icon]
Food Review Type --Select-- ▾	Equipment Specification Sheets Submitted [icon]
Equipment Specification Sheet [icon]	Received by Community Hygiene [icon]
Received by Well and Septic 7/2/2026 [icon]	

FACILITY INFORMATION

Name of Business (dba) * n/a (Text)	Does this project have a Building Permit? ☐ Yes ☐ No
Associated Building Permit Number (Text)	Building Permit Issued Date [icon]
Owner Switch Date [icon]	☐ Non-Profit
Does the project include an Aquatic Facility such as a Public Pool? If Yes, forward to CH Program. ☐ Yes ☐ No	Does the project include Private Well? If Yes, forward to WS Program. ☐ Yes ☐ No
Does the project include Private Septic? If Yes, forward to WS Program. ☐ Yes ☐ No	Does the project include Food Services? If Yes, forward to FP Program. ☐ Yes ☐ No
Is this a Prototype Food Service Facility? If Yes, refer to State. ☐ Yes ☐ No	Facility Phone (Text)
Facility Fax (Text)	Facility Email (Text)
Days of Operation (Text)	

PROPERTY INFORMATION

Water Source --Select-- ▾	Sewage Disposal --Select-- ▾
Design Wastewater Flow (Number)	Permit Type --Select-- ▾

DEVELOPMENT PLANS

Property Type Residential ▾	Plan Version Initial ▾
Signature Required ☐ Yes ☐ No	Engineer (Text)
Number of paper copies (Number)	Number of mylar copies (Number)
Number of buildable lots created (Number)	Number of non-buildable lots created (Number)
Total Number of Lots	Associated Plans

0
(Number)

WELL AND SEPTIC INTERNAL

State Review Required

☐ Yes ☐ No

Coordinate State Review

☐ Yes ☐ No

Proposed Septic System Type

--Select--

FOOD ESTABLISHMENT FACILITY

Priority Assessment

--Select--

Licensed Type

--Select--

License Category

--Select--

FOOD ESTABLISHMENT INFORMATION

Hours of Operation

(Text)

☐ Operating Seasonally Only

If Operating Seasonally, What is the start month?

(Text)

Are pets allowed in a outdoor seating area?

☐ Yes ☐ No

Full Bar?

☐ Yes ☐ No**RESTAURANT AND FOOD SERVICE**

Food Service Facility Secondary Category

--Select--

Total Seating Capacity

(Number)

Number of Restrooms

(Number)

Interior Restaurant Seating Capacity

(Number)

Bar Seating Capacity

(Text)

Outdoor Seating Capacity

(Text)

Does the restaurant have outdoor seating

☐ Yes ☐ No**EQUIPMENT**

Evaluated non NSF, ANSI, CF or other standards

☐ Yes ☐ No

Description of Refrigeration Units

Number of Walk-In Refrigerator Units

(Number)

Description of Walk-In Freezer Units

(Text)

Is there a bulk ice machine available

☐ Yes ☐ No

Space Limitation

Number of Hand Sinks Available

(Number)

Hood System

(Text)

Ventless Equipment

(Text)

PLUMBING

Size and installation of the water heater?

(Text)

Is there a grease interceptor or grease trap?

--Select--

REFUSE AND RECYCLABLES

Dumpsters Located on a Impervious surface?

--Select--

Will there be a grease receptacle?

--Select--

WAREWASHING DISHWASHING

Dishwashing Method

--Select--

HACCP


Plan Review Response Letter Received

☐ Yes ☐ No

Date HACCP Approved by the State

Date HACCP Plan Submitted

HACCP Plan Approved

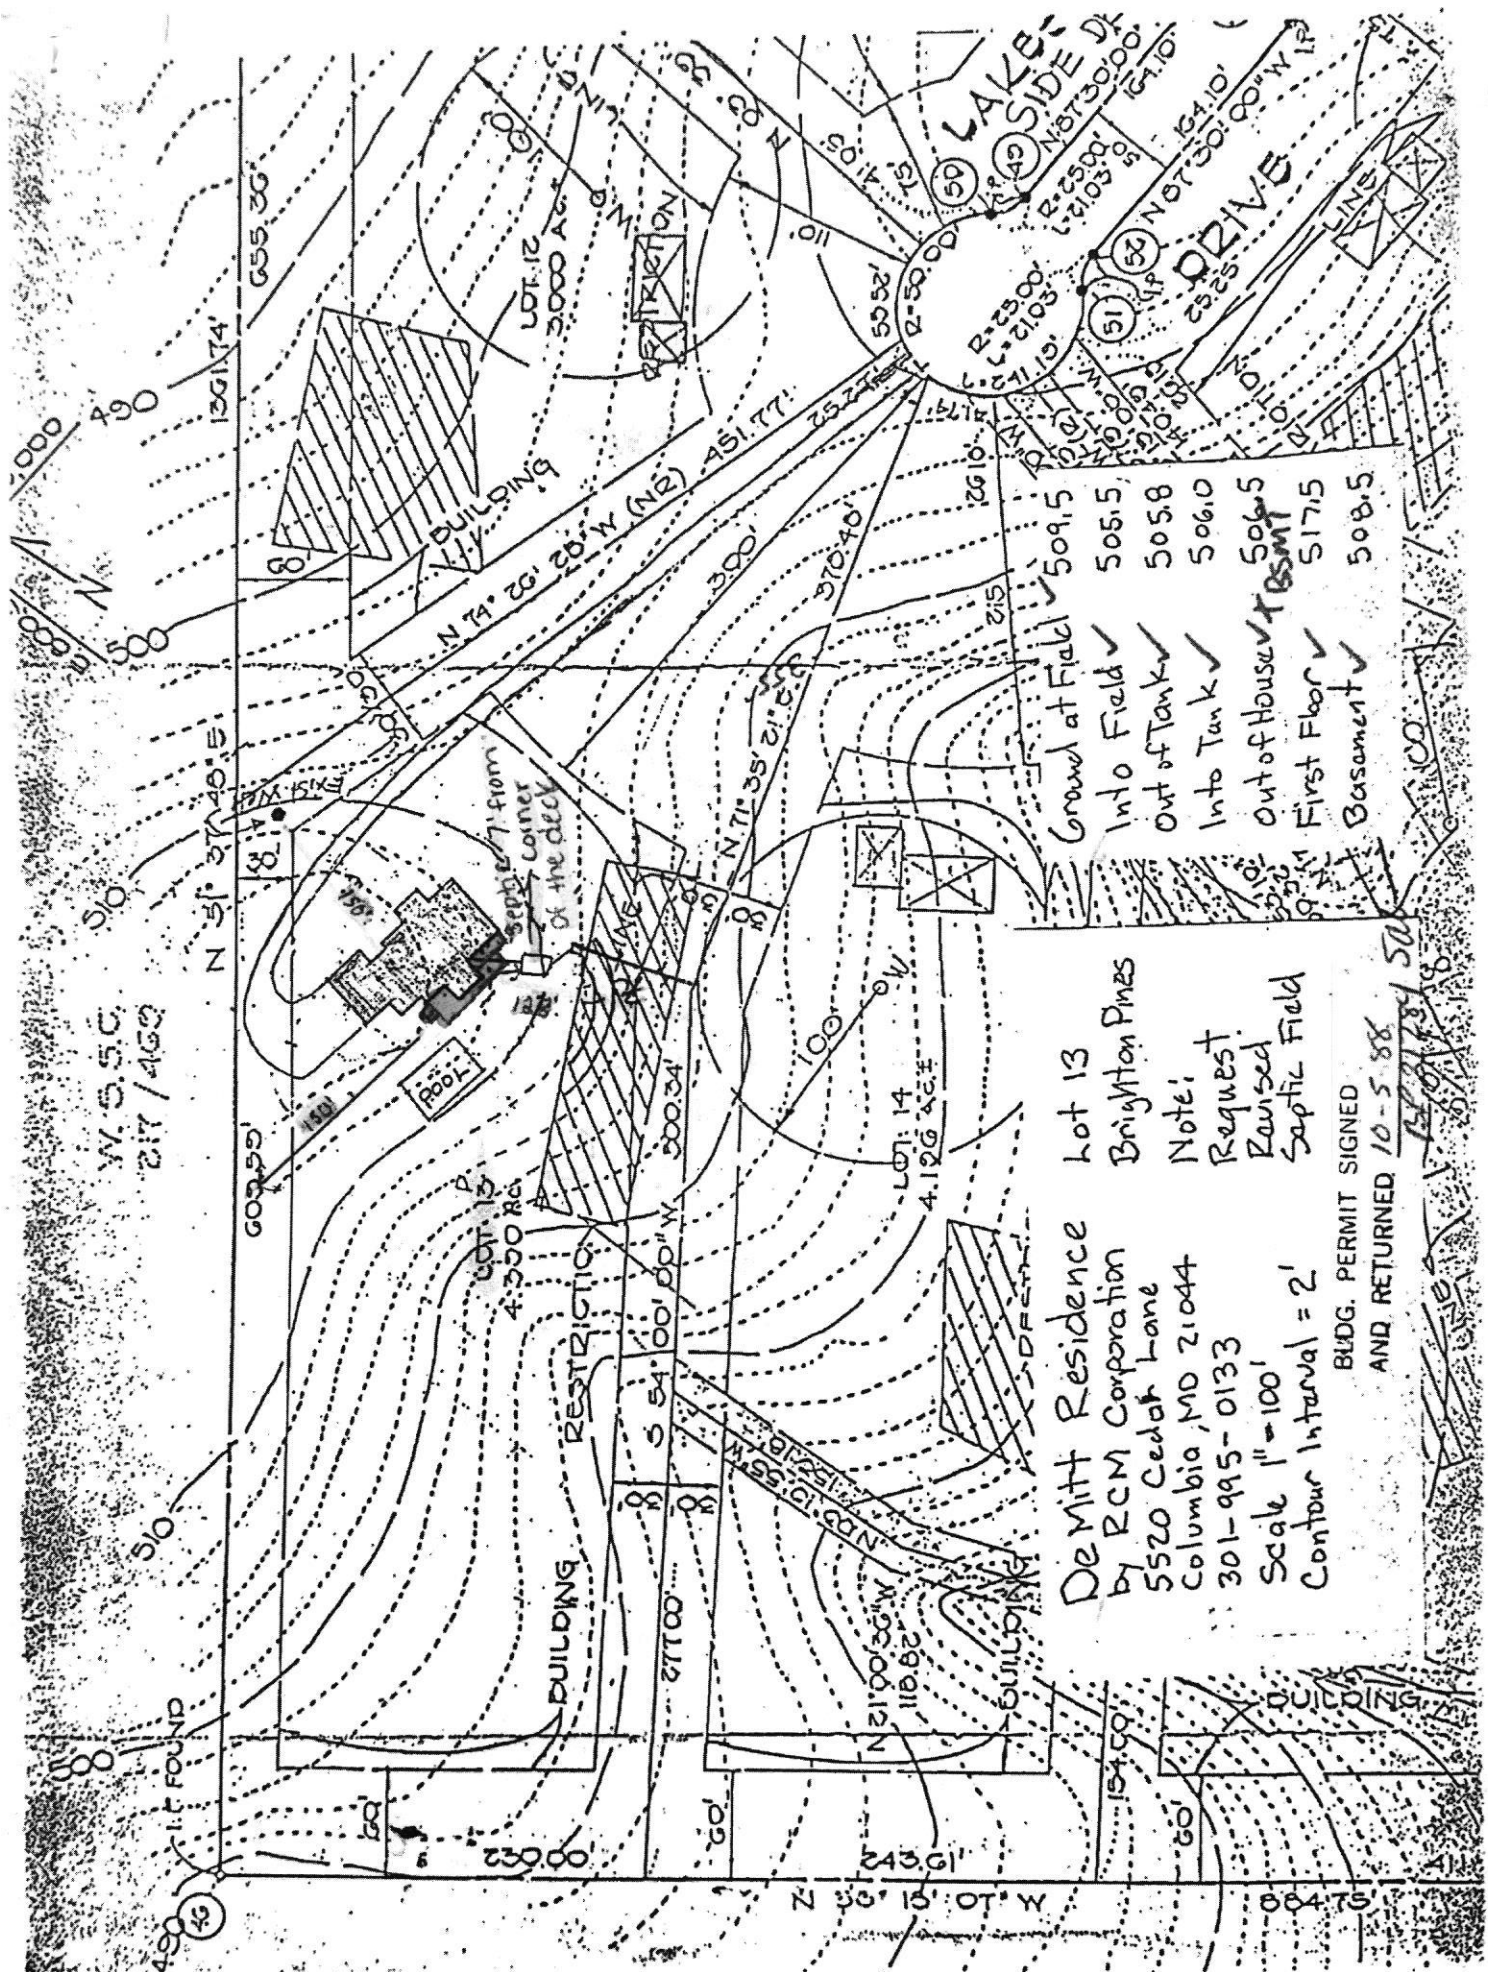

DeMitt Residence Lot 13
 by RCM Corporation
 5520 Cedar Lane
 Columbia, MD 21044
 301-995-0133
 Scale 1"=100'
 Contour Interval = 2'

- Ground at Field ✓ 509.5
- In to Field ✓ 505.5
- Out of Tank ✓ 505.8
- In to Tank ✓ 506.0
- Out of House ✓ 506.5
- First Floor ✓ 517.5
- Basement ✓ 508.5

BUDG. PERMIT SIGNED

AND RETURNED 10-5-88

12/10/88 50