


Record Detail * (This section is required.)

Permit Type	Permit Number	Opened Date
Building/Residential/Misc/Tanks	B26002934	08/19/2026
Description of Work		
SFD/ INSTALL (1) 320 GAL UNDERGROUND PROPANE TANK		

[check spelling](#)

Address * (This section is required.)

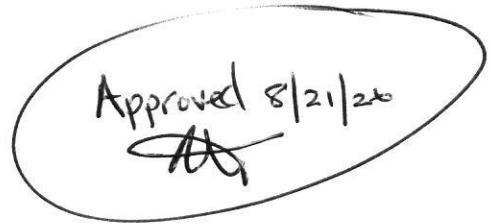

Search Reset Clear Get Parcel & Owner

Street #	Street Name	Street Type	
15905	UNION CHAPEL	RD	
Unit Type	Unit #	X Coordinate	Y Coordinate
--Select--		-77.06717	39.29367
City	State	Zip Code	Primary
WOODBINE	MD	21797	Yes

Parcel * (This section is required.)

Search Reset Clear Get Address & Owner

GIS ID *	Parcel	Parcel Area	Land Value	Improved Value	Exemption Value	Plan Area
904171	136	3.8	226000	642400	229500	RURAL
Legal Description						
3.805 A []15905 UNION CHAPEL RD []WOODBINE						

[check spelling](#)

Block	Lot	Census Tract	Council Dist	Inspection Dist	Supervisor Dist	Map #	DAP Zone
		605601	5				
Plan Area		State Tax Id	Subdivision Name				
		1404317629					
Section		Area	Tax Map				
			13				
Grid		Zoning District	ADC Map				
13-18		RC-DEO	4811-K4				
SDP No.		Final Plan No.	WP File No.				
Record Plat No.		WS Contract No.	FDP No.	Primary			
				Yes			
Owner Occupied		Year Built	Historic District				
☐ Yes ☐ No		1984	☐ Yes ☒ No				
Historic District Registry No.		Stat Area	Flood Plain				
		4-08	☐ Yes ☒ No				
Building No							

Owner * (This section is required.)

Search Reset Clear

Name *
NIEDEI
Address Line 1
15905 Union Chapel Rd
Address Line 2
Address Line 3

Mail City
WOODBINE
Mail State
MD
Mail Zip Code
21797
Phone
585-734-5041
Primary
Yes
E-mail

Cell Number Fax Number

Professionals (This section is not required.)

License # *
20100079809
License Type *
Propane Gs
Primary
Yes
Business Name
MID ATLANTIC COOPERATIVE SOLUTIONS DBA AERO ENERGY
First Name
RICHARD
Middle Name
THOMAS
Last Name
JARCY
Address Line 1
230 LINCOLN WAY EAST
Address Line 2
City
NEW OXFORD
State
PA
ZIP Code
17350-0000
Phone 1
2406744592
Phone 2
717-624-5809
Fax
E-mail
RJARC@AEROENERGY.COM

Applicant (This section is not required.)

Search As Owner As Lic. Prof As Contact

Type *
Applicant
Relationship
Applicant
Primary
Yes
First Name
steve
MI
Last Name
dannenfeldt
Full Name
steve dannenfeldt
Organization Name
Aero Energy
Street Address
230 lincoln way East
Address Line 2
City
New Oxford
State
PA
Zip Code
17350
Phone
301-606-8052
Cell
Fax
E-mail *
dfrazier@aeroenergy.com


Addtl Info

Est Construction Cost *
6000
Housing Units *
0
Number of Buildings *
0
Public Owned
No
Construction Type
329 - Structures Other Than Buildings (Retaining Walls/Tents)

TANK INFORMATION

RESIDENTIAL TANK INFORMATION

Capital Project-No Fee * Capital Project Number Fee Exempt * Roadside Tree Project Permit * Roadside Tree Permit #
☐ Yes ☒ No (Text) ☐ Yes ☒ No ☐ Yes ☒ No (Text)
Existing Use * Number of Tanks Installed * Number of Tanks Removed *
SFD 1 (Number) 0 (Number)

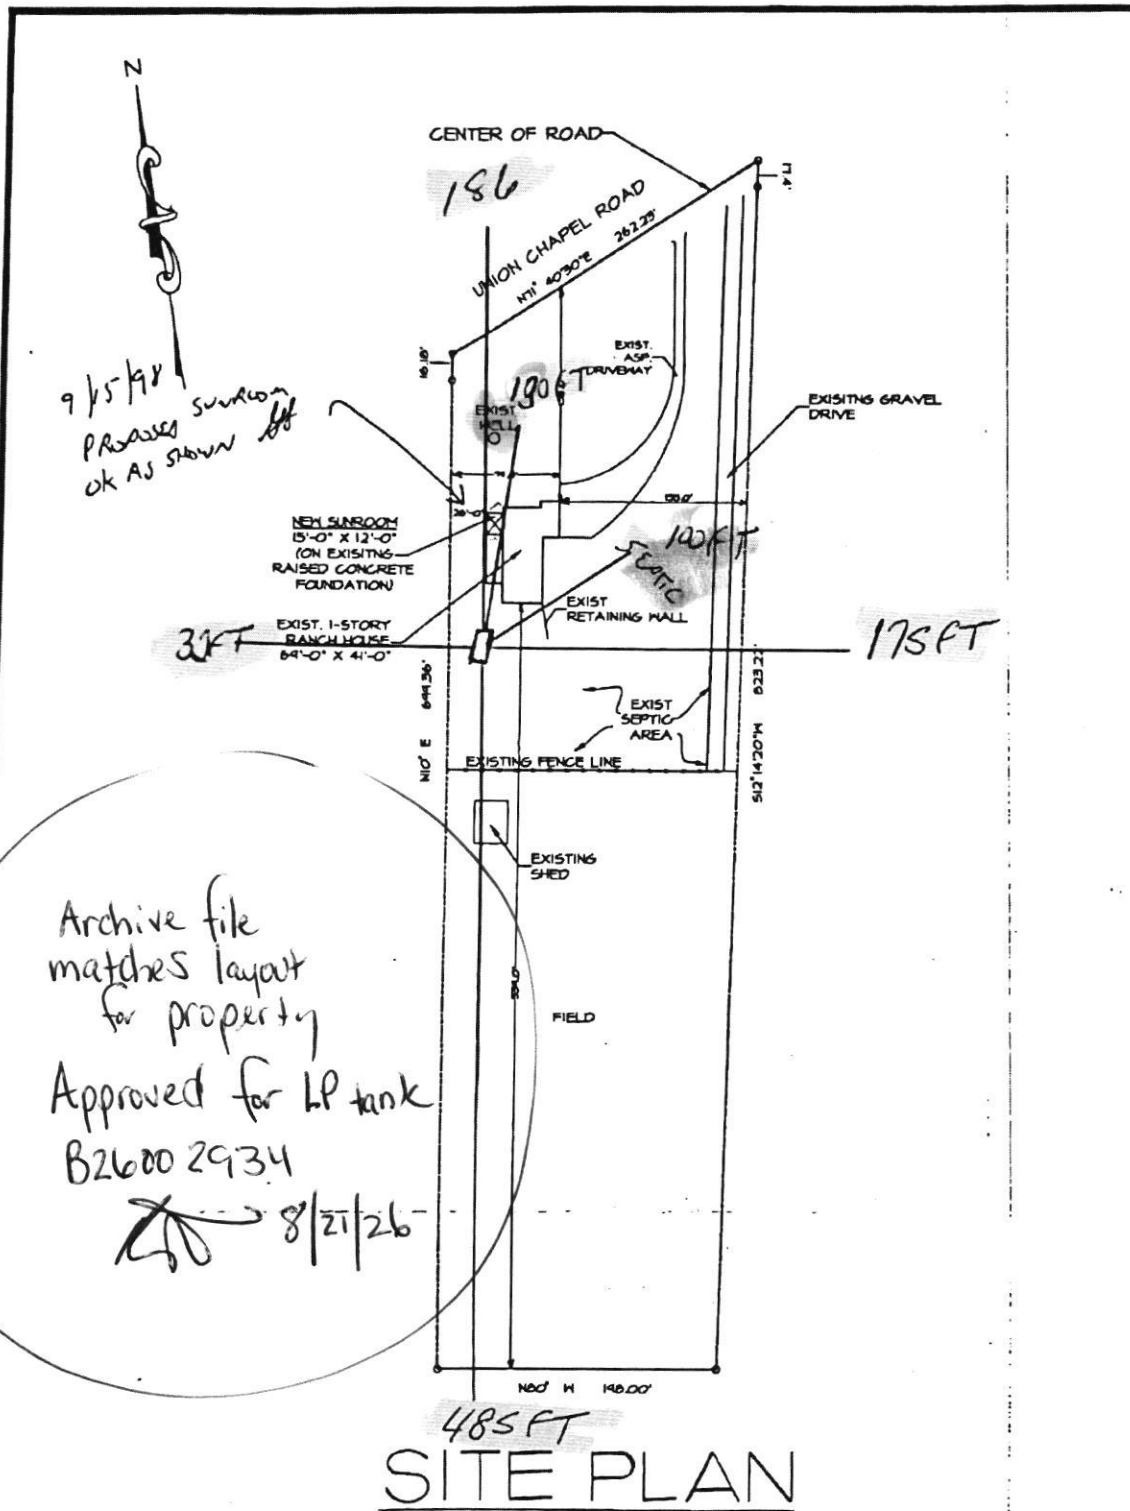


JOSEPH F. DEVLBISS CONSTRUCTION CO.
7730-B SUNDAYS LANE
FREDERICK, MARYLAND 21702
(301) 698-8344

SCALE: 1" = 100'
FILE: HILLST.DWG
DRAWN: JME
DATE: 9/10/98
REVISED:

SUNROOM ADDITION
HILL RESIDENCE
15905 UNION CHAPEL RD
WOODBINE, MARYLAND 21797

SHEET
1
OF
1

Quality Steel Corporation UG Propane Tanks

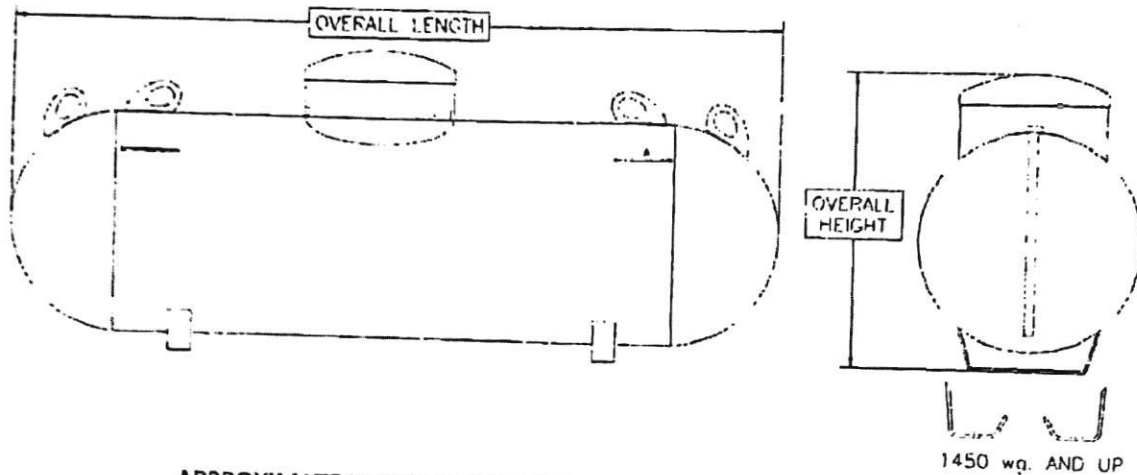

APPROXIMATE UNDERGROUND VESSEL DIMENSIONS AND SPECIFICATIONS

WATER CAPACITY	DIAMETER (OD)	HEAD TYPE	OVERALL LENGTH	OVERALL HEIGHT		LEG** WIDTH	WEIGHT (lbs.)	***QUANTITY	
				UGSR	UGLR			FULL LOAD	PER STACK
120 wg.	24"	Ellip.	5'-8"	3'-10"	4'-5"	1'-1 1/2"	260	48 60	6 10
250 wg.	30"	Heml.	7'-10"	4'-6"	5'-1"	1'-5"	480	30 42	5 7
320 wg.	30"	Heml.	9'-7"	4'-6"	5'-1"	1'-5"	620	25 35	5 7
500 wg.	37 1/2"	Heml.	10'	5'	5'-7"	1'-8"	950	25	5
1000 wg.	41"	Heml.	16'	5'-3"	5'-10"	1'-8"	1,800	15	5
1450 wg.	46 1/2"	Ellip.	17'-4"	5'-9"	6'-4"	1'-9"	2,650	12	4
1990 wg.	46 1/2"	Ellip.	23'-11"	5'-9"	6'-4"	1'-9"	3,550	8	4

Dimensions and specifications shown are approximate. Individual vessels may vary.

* Dual lifting lugs for 500 and 1000 wg. standard tanks.

** Leg widths and spacing may vary based on mfg. location. Check with your salesperson for details. 120, 250, 320 wg. standard tanks - no holes in legs (one center hole on request). 500 and 1000 wg. standard tanks - 2 holes 16" on center. 1450 wg. and up as shown above.

*** Full load and stack quantities vary by shipping location. Check with your salesperson for details.

General Specifications

- Conforms to the latest edition of ASME Rules for Construction of Pressure Vessels, Section VIII, Division 1. Complies with NFPA 58.
- Rated at 250 psig from -20° F to 125° F. All vessels registered with National Board. Some standard vessels available with CRN (Canadian Registration Number).
- Vessels shipped with durable ready-to-bury coating. Vessels, depending on manufacturing location, are either powder coated with phenolic epoxy or primed with liquid epoxy and coated with liquid urethane top coat - all providing a durable ready-to-bury coating.
- All vessels are shipped vacuum pre-purged to enable simplified first fill of the vessel.
- Green composite dome provides large working space and is resistant to the elements. Anode stud attached to riser pipe to enable ease of cathodic connection.

Applicable federal, state, or local regulations may contain specific requirements for protective coatings and cathodic protection. The purchaser and installer are responsible for compliance with all federal, state, local and NFPA industry regulations, including proper purging for first fill per NGPA 133-89(a). Cathodic protection required. Coating must be continuous and uninterrupted and must comply with an local, state or national code.