

Approved 7/8/26

Menu Save Reset Cancel Help

Record Detail * (This section is required.)

Permit Type	Permit Number	Opened Date
Building/Residential/Misc/Deck	B26000840	03/24/2026
Description of Work		
SFD/ REPLACE EXISTING 10' X 29' DECK****SUBJECT TO FIELD INSPECTION**		

Online BP.

7/8/23/26

[check spelling](#)

Address * (This section is required.)

Search Reset Clear Get Parcel & Owner

Street #	Street Name	Street Type
5095	GREEN BRIDGE	RD
Unit Type	Unit #	X Coordinate
--Select--		-76.9936
City	State	Zip Code
DAYTON	MD	21036
	Primary	Yes

Parcel * (This section is required.)

Search Reset Clear Get Address & Owner

GIS ID *	Parcel	Parcel Area	Land Value	Improved Value	Exemption Value	Plan Area
915875	56	1	276200	560000	283800	RURAL
Legal Description						
IMPS1.000 ACRES[]5095 GREEN BRIDGE RD[]DAYTON						

[check spelling](#)

Block	Lot	Census Tract	Council Dist	Inspection Dist	Supervisor Dist	Map #	DAP Zone
		605101	5				
Plan Area	State Tax Id	Subdivision Name					
	1405353734						
Section	Area	Tax Map					
		28					
Grid	Zoning District	ADC Map					
28-13	RR-DEO	4933-A4					
SDP No.	Final Plan No.	WP File No.					
Record Plat No.	WS Contract No.	FDP No.	Primary				
			Yes				
Owner Occupied	Year Built	Historic District					
☐ Yes ☐ No	1966	☐ Yes ☒ No					
Historic District Registry No.	Stat Area	Flood Plain					
	5-04A	☐ Yes ☒ No					
Building No							

Owner * (This section is required.)

Search Reset Clear

Name *

DEY RI

Address Line 1

5095 GREEN BRIDGE RD

Address Line 2

Address Line 3

Mail City
DAYTON
Mail State
MD
Mail Zip Code
21036
Phone
410-336-7155
Primary
Yes
E-mail
Denag1@aol.com
Cell Number

Fax Number

Professionals (This section is not required.)

License # *
0
License Type *
Property Owner
Primary
Yes
Business Name
PROPERTY OWNER TO ACT AS CONTRACTOR
First Name
RITA
Middle Name
Last Name
DEY
Address Line 1
Address Line 2
City
State
ZIP Code
Phone 1
Phone 2
Fax
E-mail
Denag1@aol.com

Applicant (This section is not required.)

Search As Owner As Lic. Prof As Contact

Type *
Applicant
Relationship
Applicant
Primary
Yes
First Name
Rita
MI
Last Name
Dey
Full Name
Rita Dey
Organization Name
Street Address
5095 green bridge rd
Address Line 2
City
dayton
State
MD
Zip Code
21036
Phone
410-336-7155
Cell
Fax
E-mail *
Denag1@aol.com

Addtl Info


Est Construction Cost *
15000
Housing Units *
0
Number of Buildings *
0
Public Owned
No
Construction Type
434 - Additions, Alterations and Conversions - Residential

MISC PERMIT INFO

MISCELLANEOUS PERMIT INFORMATION

Capital Project-No Fee *
☐ Yes ☒ No
Capital Project Number
(Text)
Fee Exempt *
☐ Yes ☒ No
Roadside Tree Project Permit *
☐ Yes ☒ No
Roadside Tree Project Permit #
(Text)
Existing Use *
SFD
Water
Private
Sewage
Private
Expiration Date
10/19/2026


5095 Green Bridge Road
Dayton, MD 20136

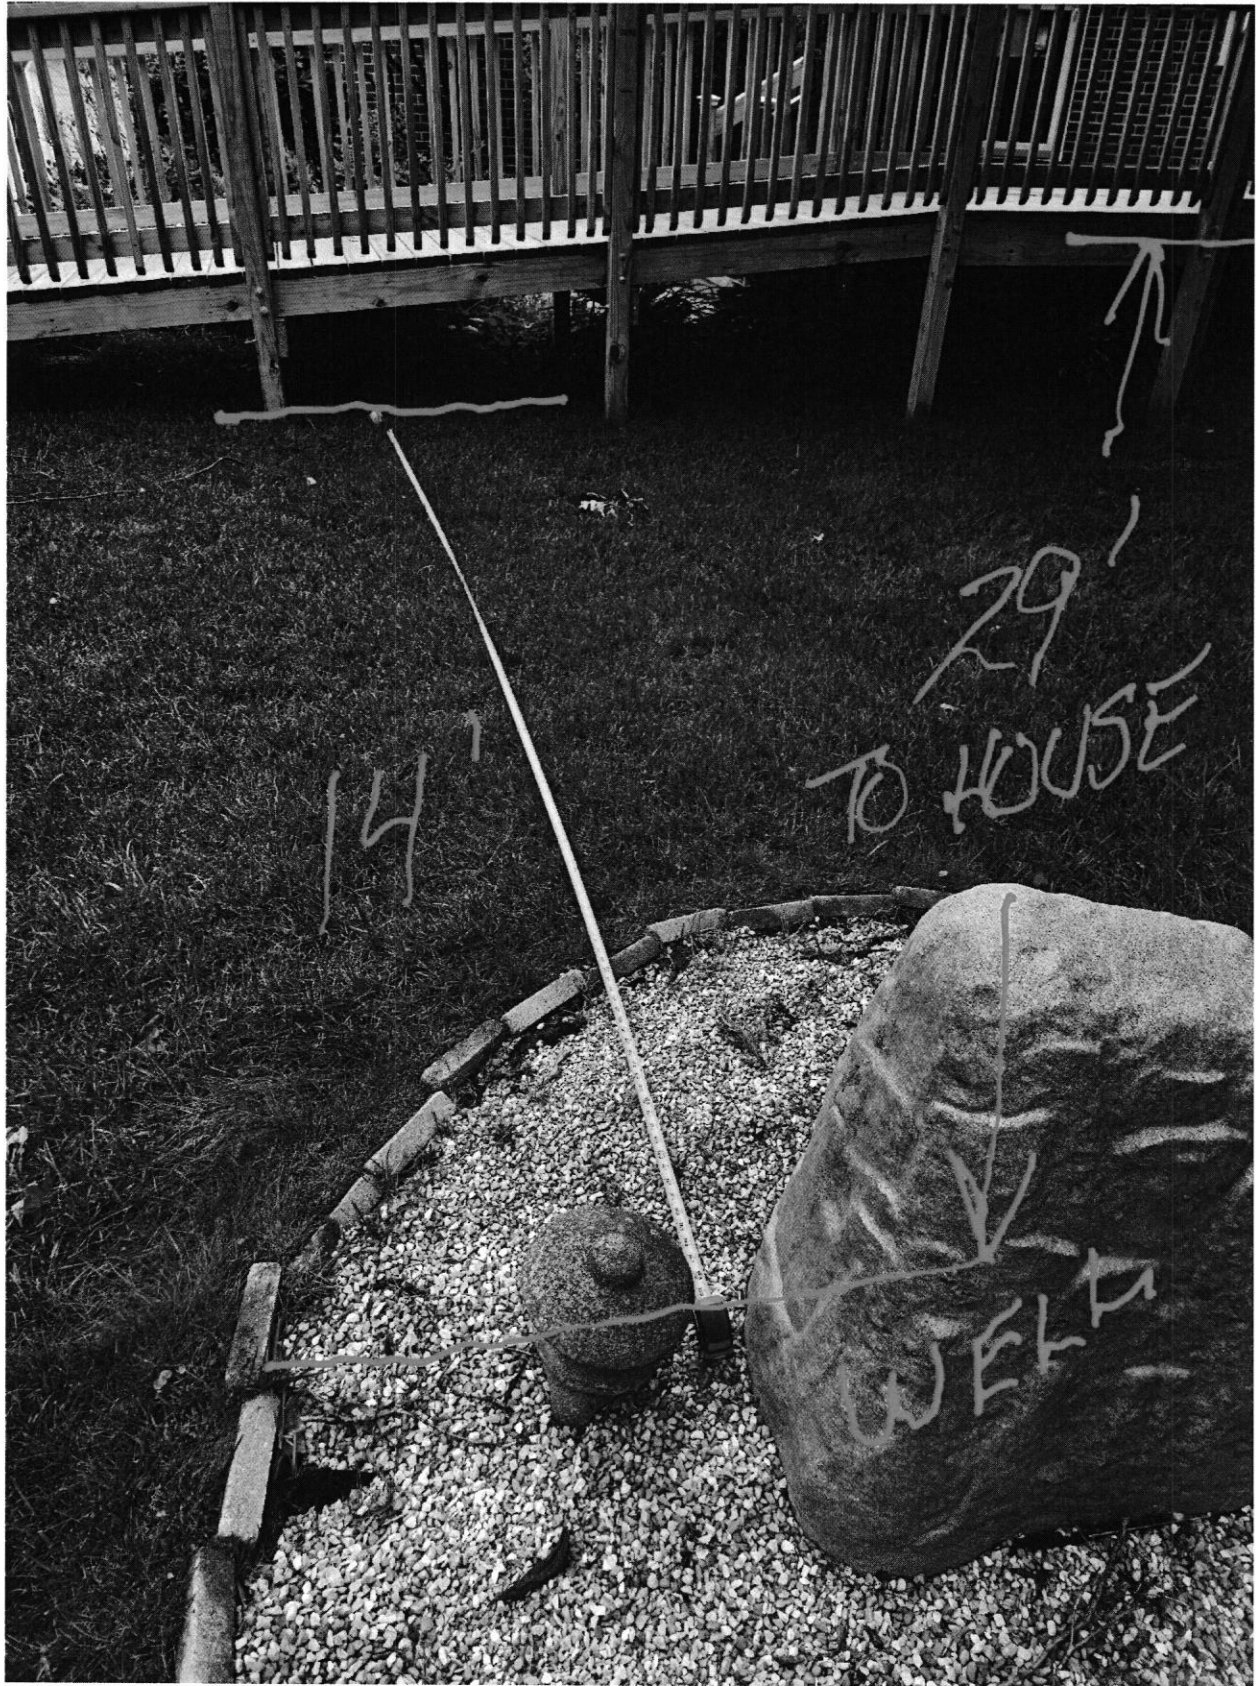

5095 Green Bridge Road
Dayton, MD 20136




5095 Green Bridge Road
Dayton, MD 20136

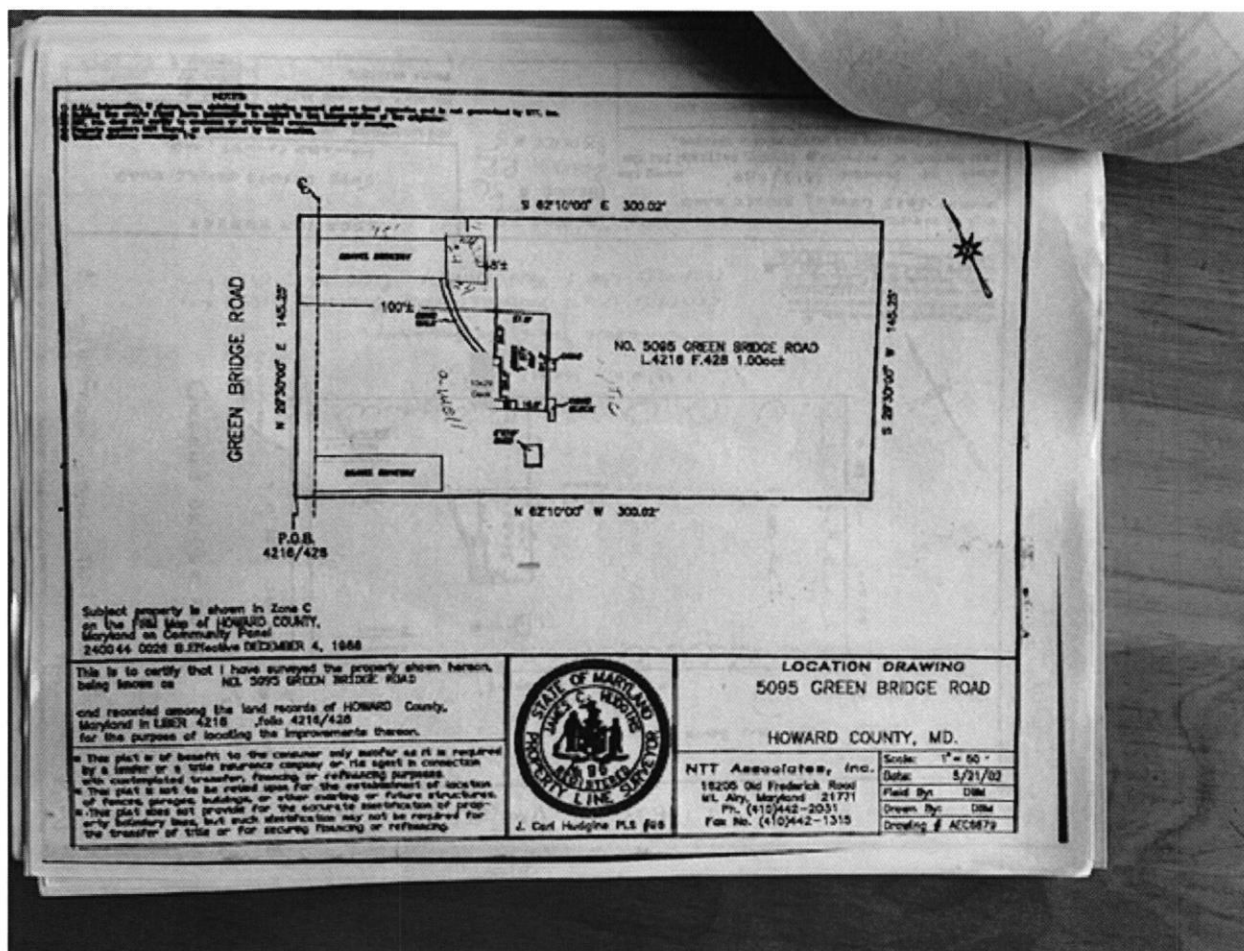

NOTES:

1. All information shown, was obtained from existing records and is not guaranteed by NIT, Inc.
 2. Making the survey and plat is subject to the interpretation of the engineer.
 3. The owner of the property is advised that the plat is not a warranty of title or a guarantee of accuracy.
 4. The plat is not to be relied upon for the establishment of location of fences, parages, buildings or other existing or future structures.
 5. This plat does not provide for the accurate identification of property boundary lines, but such identification may not be required for the transfer of title or for securing financing or refinancing.

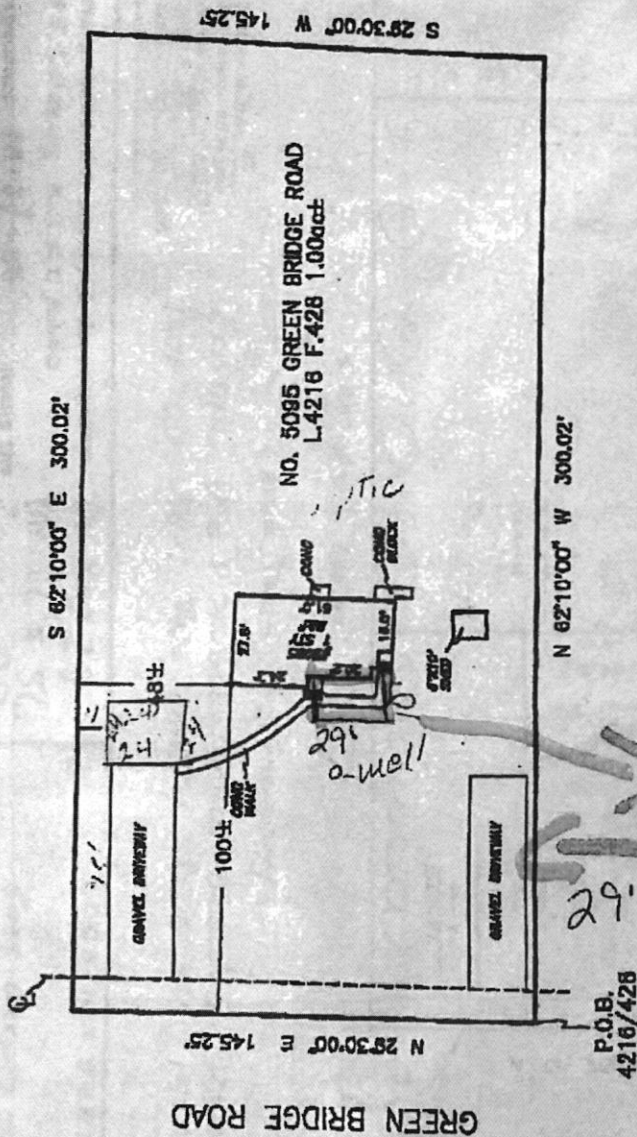

Subject property is shown in Zone C on the FIRM Map of HOWARD COUNTY, Maryland on Community Panel 2400 44 0028 B. Effective DECEMBER 4, 1988

This is to certify that I have surveyed the property shown hereon, being known as NO. 5095 GREEN BRIDGE ROAD and recorded among the land records of HOWARD County, Maryland in LIBER 4216, folio 4216/428 for the purpose of locating the improvements thereon.

This plat is of benefit to the consumer only insofar as it is required by a lender or a title insurance company or its agent in connection with contemplated transfer, financing or refinancing purposes. This plat is not to be relied upon for the establishment of location of fences, parages, buildings or other existing or future structures. This plat does not provide for the accurate identification of property boundary lines, but such identification may not be required for the transfer of title or for securing financing or refinancing.



J. Carl Hudgins PLS #98

LOCATION DRAWING
5095 GREEN BRIDGE ROAD
HOWARD COUNTY, MD.

NTT Associates, Inc.
 18205 Old Frederick Road
 Mt. Airy, Maryland 21771
 Ph: (410)442-2031
 Fax No. (410)442-1315
 Scale: 1" = 50'
 Date: 5/21/02
 Field By: DBM
 Drawn By: DBM
 Drawing # AEC6879

Oswald Jr, Woodin

From: Oswald Jr, Woodin
Sent: Monday, April 27, 2026 10:19 AM
To: 'Denag1@aol.com'
Subject: B26000840_5095 Green Bridge Road_Site Plan
Attachments: Septic Permit_As built.pdf

Hi Ms. Dey,

The building permit site plan (BP# B26000840) does not print to scale. Please make sure the site plan is to scale before you upload it to the system. Add the distance between the existing well and the proposed deck. Also add the septic tank and drywell components to the plan.

I've attached the as-built drawing (on page #2) to assist you. Please let me know when this has been completed, so I can look for it in the system.

If you have any questions, please don't hesitate to ask.

Regards,

Hank

Hank Oswald
Licensed Environmental Health Specialist
Bureau of Environmental Health
Howard County Health Department
8930 Stanford Blvd. Columbia, MD 21045
(410) 313 - 1786
www.hchealth.org

DISCLAIMER: This e-mail is intended only for the individual to whom it is addressed. It may be used only in accordance with applicable laws. If you are not the intended recipient, you are strictly prohibited from reading, disseminating, distributing, or copying this message. If you received this e-mail by mistake, please notify the sender and destroy this e-mail

Oswald Jr, Woodin

From: Oswald Jr, Woodin
Sent: Wednesday, April 29, 2026 7:49 AM
To: 'Denag1@aol.com'
Cc: Silvast, Zackary
Subject: RE: B26000840_5095 Green Bridge Road_Site Plan
Attachments: image0 (2).jpeg

Hi Ms. Dey,

It looks like you uploaded another picture of the site plan, and it did not include the septic system components. This office cannot accept a picture copy of the site plan, because it doesn't print to scale. If you cannot scan in the site plan where it prints to scale on a sheet of paper no larger than 11 x 17, then please submit a hard copy of the scaled site plan to the permits office and ask them to upload it for you, or reach out to them directly for other possible options.

Should you have any questions, please feel free to contact me.

Regards,

Hank

Hank Oswald
Licensed Environmental Health Specialist
Bureau of Environmental Health
Howard County Health Department
8930 Stanford Blvd. Columbia, MD 21045
(410) 313 - 1786
www.hchealth.org

DISCLAIMER: This e-mail is intended only for the individual to whom it is addressed. It may be used only in accordance with applicable laws. If you are not the intended recipient, you are strictly prohibited from reading, disseminating, distributing, or copying this message. If you received this e-mail by mistake, please notify the sender and destroy this e-mail

From: Oswald Jr, Woodin
Sent: Monday, April 27, 2026 10:19 AM
To: 'Denag1@aol.com' <Denag1@aol.com>
Subject: B26000840_5095 Green Bridge Road_Site Plan

Hi Ms. Dey,

The building permit site plan (BP# B26000840) does not print to scale. Please make sure the site plan is to scale before you upload it to the system. Add the distance between the existing well and the proposed deck. Also add the septic tank and drywell components to the plan.

I've attached the as-built drawing (on page #2) to assist you. Please let me know when this has been completed, so I can look for it in the system.

If you have any questions, please don't hesitate to ask.

Regards,

Hank

Hank Oswald
Licensed Environmental Health Specialist
Bureau of Environmental Health
Howard County Health Department
8930 Stanford Blvd. Columbia, MD 21045
(410) 313 - 1786
www.hchealth.org

DISCLAIMER: This e-mail is intended only for the individual to whom it is addressed. It may be used only in accordance with applicable laws. If you are not the intended recipient, you are strictly prohibited from reading, disseminating, distributing, or copying this message. If you received this e-mail by mistake, please notify the sender and destroy this e-mail