

Menu

Save

Reset

Cancel

Help

## Record Detail \* (This section is required.)

## Permit Type

Building/Residential/Misc/Tanks

## Permit Number

B26002122

## Opened Date

06/24/2026

## Description of Work

SFD/Install (1) 325-gallon underground propane tank for pool heater

[check spelling](#)

## Address \* (This section is required.)

Search

Reset

Clear

Get Parcel &amp; Owner

## Street #

11675

## Street Name

FOXSPUR

## Street Type

CT

## Unit Type

--Select--

## Unit #

## X Coordinate

-76.91374

## Y Coordinate

39.24757

## City

ELLCOTT CITY

## State

MD

## Zip Code

21042

## Primary

Yes

6/25 - on hold →  
revised plan required  
showing the well setback (R)

6/29 - emailed applicant  
about revised plan  
requirements

## Parcel \* (This section is required.)

Search

Reset

Clear

Get Address &amp; Owner

## GIS ID \*

888797

## Parcel

126

## Parcel Area

3.82

## Land Value

387300

## Improved Value

926500

## Exemption Value

539200

## Plan Area

RURAL

## Legal Description

IMPSLOT 22 3.822 AR[ ]11675 FOXSPUR CT N[ ]FAR SIDE

[check spelling](#)

revision  
rec'd - Approved 6/29/26

Att

## Block

## Lot

22

## Census Tract

603000

## Council Dist

5

## Inspection Dist

## Supervisor Dist

## Map #

## DAP Zone

## Plan Area

## State Tax Id

1403306976

## Subdivision Name

FAR SIDE

## Section

## Area

## Tax Map

29

## Grid

29-3

## Zoning District

RC-DEO

## ADC Map

4934-D1

## SDP No.

## Final Plan No.

## WP File No.

## Record Plat No.

4407

## WS Contract No.

## FDP No.

## Primary

Yes

## Owner Occupied

☐ Yes ☐ No

## Year Built

1983

## Historic District

☐ Yes ☒ No

## Historic District Registry No.

## Stat Area

3-09A

## Flood Plain

☐ Yes ☒ No

## Building No

## Owner \* (This section is required.)

Search

Reset

Clear

## Name \*

REDDI

## Address Line 1

11675 FOXSPUR CT

## Address Line 2

## Address Line 3

**Mail City**

ELLICOTT CITY

**Mail State**

MD

**Mail Zip Code**

21042

**Phone**

410-984-2714

**Primary**

Yes

**E-mail****Cell Number****Fax Number****Professionals** (This section is not required.)**License # \***

20100079809

**Business Name**

MID ATLANTIC COOPERATIVE SOLUTIONS DBA AERO ENERGY

**License Type \***

Propane Gs

**First Name**

RICHARD

**Middle Name**

THOMAS

**Last Name**

JARCY

**Primary**

Yes

**Address Line 1**

230 LINCOLN WAY EAST

**Address Line 2****City**

NEW OXFORD

**State**

PA

**ZIP Code**

17350-0000

**Phone 1**

2406744592

**Phone 2**

717-624-5809

**Fax****E-mail**

RJARCY@AEROENERGY.COM

**Applicant** (This section is not required.)**Search****As Owner****As Lic. Prof****As Contact****Type \***

Applicant

**First Name**

David

**MI****Last Name**

Frazier

**Relationship**

Applicant

**Full Name**

steve dannenfeldt

**Primary**

Yes

**Organization Name**

Aero Energy

**Street Address**

230 lincoln way East

**Address Line 2****City**

New Oxford

**State**

PA

**Zip Code**

17350

**Phone**

301-606-8052

**Cell****Fax****E-mail \***

dfrazier@aeroenergy.com

**Addtl Info****Est Construction Cost \***

6600

**Housing Units \***

0

**Number of Buildings \***

0

**Public Owned**

No

**Construction Type**

329 - Structures Other Than Buildings (Retaining Walls/Tents)

**TANK INFORMATION****RESIDENTIAL TANK INFORMATION****Capital Project-No Fee \***☐ Yes ☒ No**Capital Project Number**

(Text)

**Fee Exempt \***☐ Yes ☒ No**Roadside Tree Project Permit \***☐ Yes ☒ No**Roadside Tree Permit #**

(Text)

**Existing Use \***

SFD

**Number of Tanks Installed \***


1

(Number)


**Number of Tanks Removed \***

0

(Number)

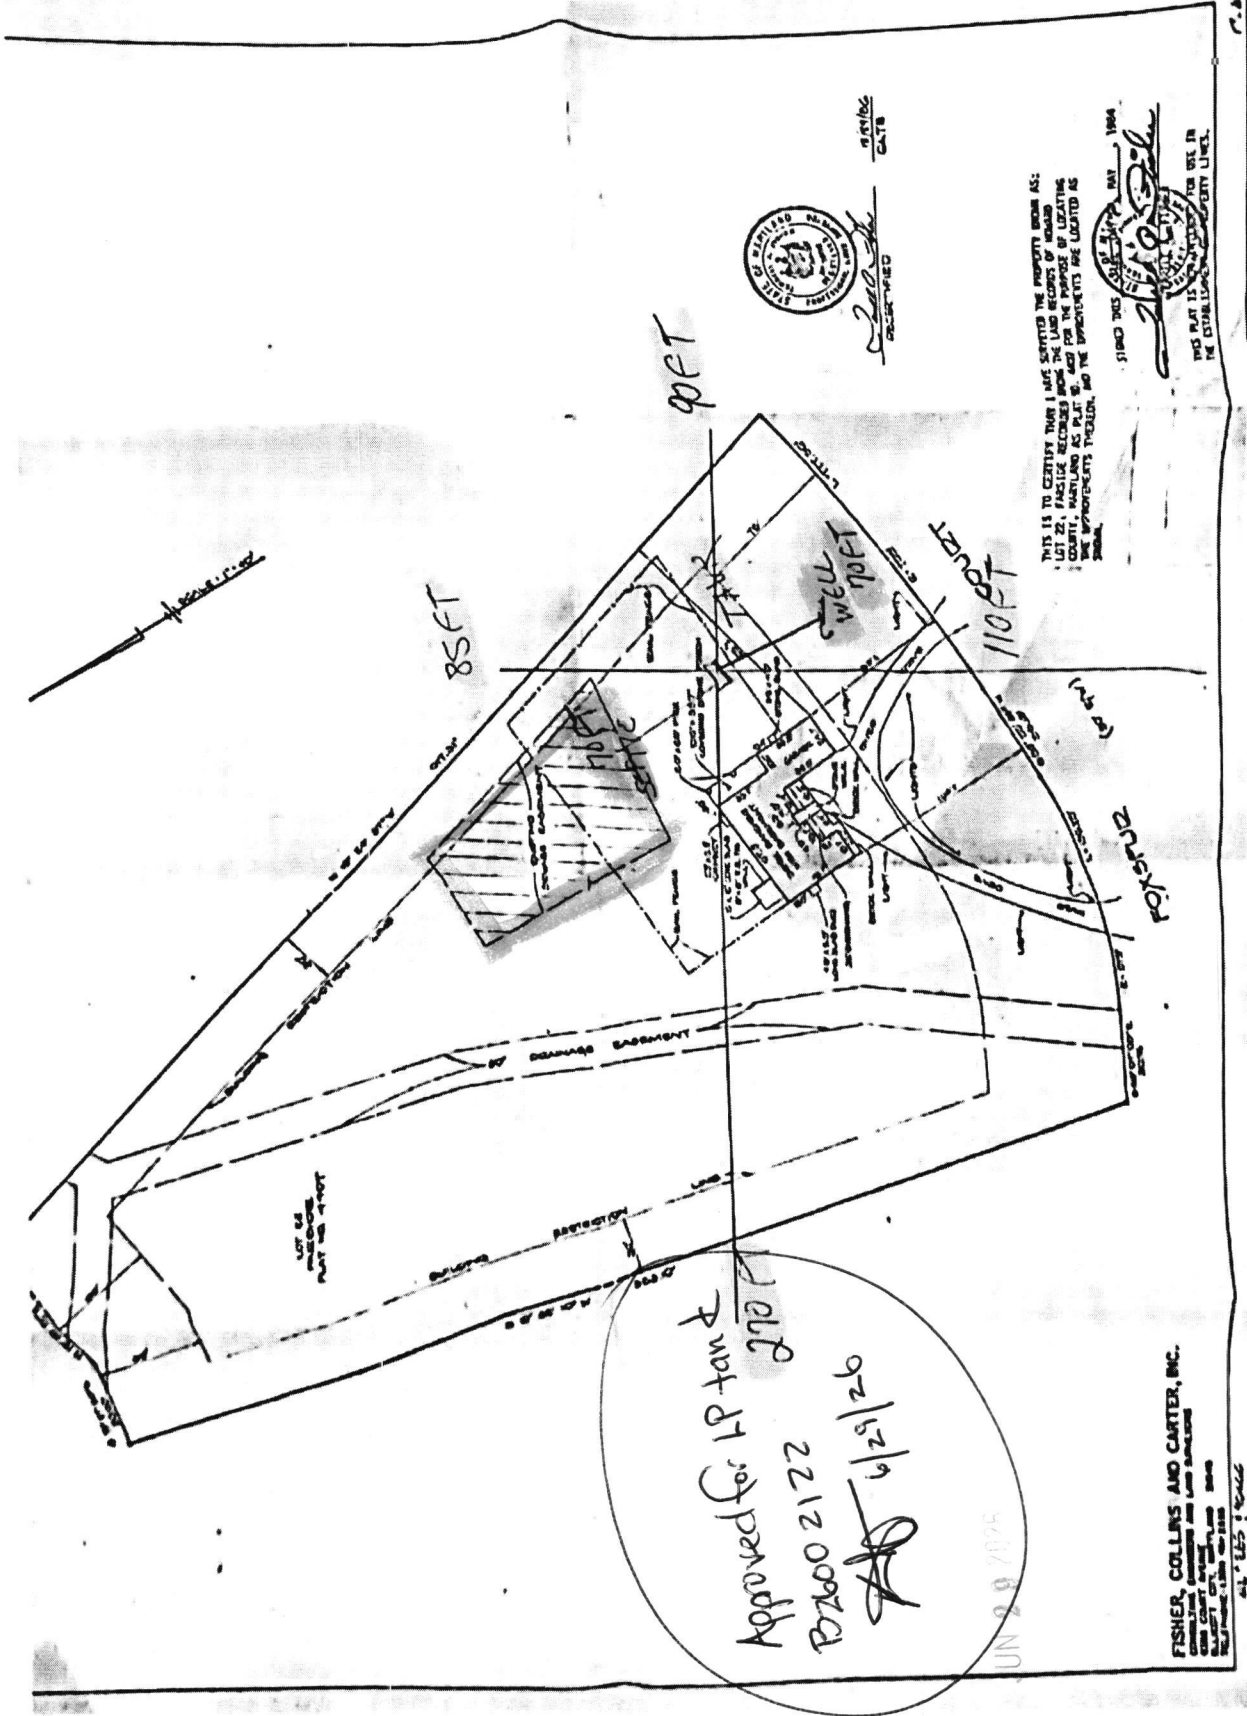

## Quality Steel Corporation UG Propane Tanks

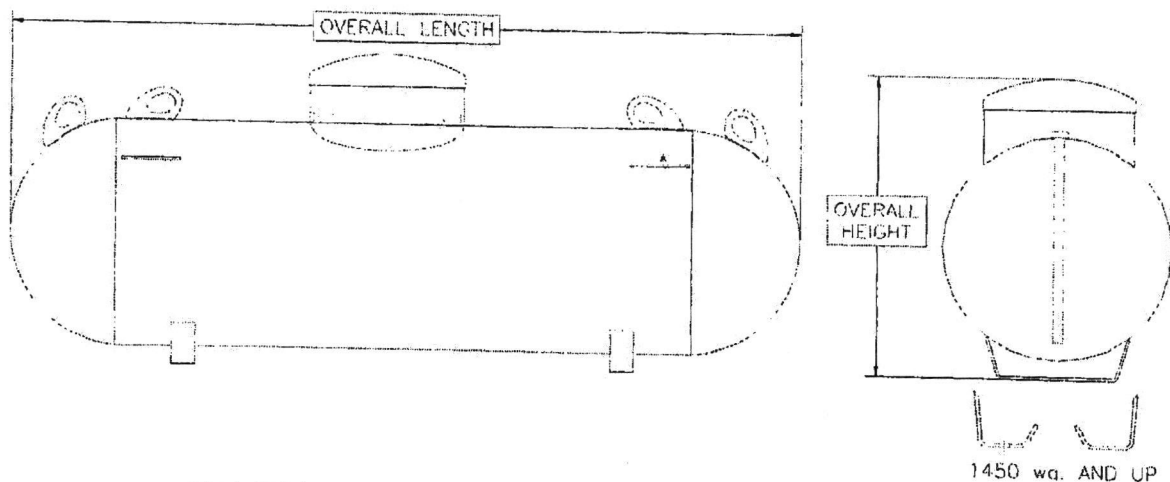

APPROXIMATE UNDERGROUND VESSEL DIMENSIONS AND SPECIFICATIONS

| WATER CAPACITY | DIAMETER (OD) | HEAD TYPE | OVERALL LENGTH | OVERALL HEIGHT |        | LEG** WIDTH | WEIGHT (lbs.) | ***QUANTITY |           |
|----------------|---------------|-----------|----------------|----------------|--------|-------------|---------------|-------------|-----------|
|                |               |           |                | UGSR           | UGLR   |             |               | FULL LOAD   | PER STACK |
| 120 wg.        | 24"           | Ellip.    | 5'-8"          | 3'-10"         | 4'-5"  | 1'-1 1/2"   | 260           | 48   60     | 6   10    |
| 250 wg.        | 30"           | Hemi.     | 7'-10"         | 4'-6"          | 5'-1"  | 1'-5"       | 480           | 30   42     | 5   7     |
| 320 wg.        | 30"           | Hemi.     | 9'-7"          | 4'-6"          | 5'-1"  | 1'-5"       | 620           | 25   35     | 5   7     |
| 500 wg.        | 37 1/2"       | Hemi.     | 10'            | 5'             | 5'-7"  | 1'-8"       | 950           | 25          | 5         |
| 1000 wg.       | 41"           | Hemi.     | 16'            | 5'-3"          | 5'-10" | 1'-8"       | 1,800         | 15          | 5         |
| 1450 wg.       | 46 1/2"       | Ellip.    | 17'-4"         | 5'-9"          | 6'-4"  | 1'-9"       | 2,650         | 12          | 4         |
| 1990 wg.       | 46 1/2"       | Ellip.    | 23'-11"        | 5'-9"          | 6'-4"  | 1'-9"       | 3,550         | 8           | 4         |

Dimensions and specifications shown are approximate. Individual vessels may vary.

\* Dual lifting lugs for 500 and 1000 wg. standard tanks.

\*\* Leg widths and spacing may vary based on mfg. location. Check with your salesperson for details. 120, 250, 320 wg. standard tanks - no holes in legs (one center hole on request). 500 and 1000 wg. standard tanks - 2 holes 16" on center. 1450 wg. and up as shown above.

\*\*\* Full load and stack quantities vary by shipping location. Check with your salesperson for details.

### General Specifications

- Conforms to the latest edition of ASME Rules for Construction of Pressure Vessels, Section VIII, Division 1. Complies with NFPA 58.
- Rated at 250 psig from -20° F to 125° F. All vessels registered with National Board. Some standard vessels available with CRN (Canadian Registration Number).
- Vessels shipped with durable ready-to-bury coating. Vessels, depending on manufacturing location, are either powder coated with phenolic epoxy or primed with liquid epoxy and coated with liquid urethane top coat - all providing a durable ready-to-bury coating.
- All vessels are shipped vacuum pre-purged to enable simplified first fill of the vessel.
- Green composite dome provides large working space and is resistant to the elements. Anode stud attached to riser pipe to enable ease of cathodic connection.

Applicable federal, state, or local regulations may contain specific requirements for protective coatings and cathodic protection. The purchaser and installer are responsible for compliance with all federal, state, local and NFPA industry regulations, including proper purging for first fill per NGPA 133-89(a). Cathodic protection required. Coating must be continuous and uninterrupted and must comply with an local, state or national code.