

Menu Save Reset Cancel Help

Approved 6/30/26
- H.O.

Record Detail * (This section is required.)

Case #

EH-PLANS-26-0

Type

EnvHealth/Environmental Health/Plan Check/Application

Status

In Review

Opened Date

06/29/2026

Single Entry Edit-View Record Form

Application Name

B26002153

Description

SFD/ 8' X 6.5' OPEN DECK WITH STEPS. EXISTING DECK TO BE REMOVED.**SUBJECT TO FIELD INSPECTION**

Online BP. 8/8 6/29/26

Total Invoiced

0.00

Total Paid

0.00

Balance

0.00

Assigned to Department Current Department

Well and Septic Program

Assigned to Staff Current User

Zack Silvest

Address * (This section is required.)

New Search Delete Set Primary

☐ Primary	<u>Street # (start)</u>	<u>Direction</u>	<u>Street Name</u>	<u>Street Type</u>	<u>City</u>	<u>State</u>	<u>Zip Code</u>	<u>Address Status</u>	<u>Street Suffix (Direction)</u>	<u>Unit Type</u>	<u>U</u>
☐ ☒	14120		Twisting	LN	Dayton	MD	21036				

Parcel (This section is not required.)

Search Delete Get Address & Owner Set Primary

☐ Primary	<u>Parcel #</u>	<u>Book</u>	<u>Page</u>	<u>Parcel</u>	<u>Parcel Area</u>	<u>Land Value</u>	<u>Improved Value</u>	<u>Exemption Value</u>	<u>Legal Description</u>	<u>Tract</u>
0 record(s) found.										

Owner (This section is not required.)

Search Delete Set Primary

☐ Primary	<u>Name</u>	<u>Mail Address Line1</u>	<u>Mail Address Line2</u>	<u>Mail Address Line3</u>	<u>Mail City</u>	<u>Mail State</u>	<u>Mail Zip Code</u>	<u>Phone</u>	<u>Country/Region</u>	<u>I</u>
☐ ☒	Frances Minni	14120 Twisting Ln.			Dayton	MD	21036		US	

Applicant * (This section is required.)

Search As Owner As Lic. Prof As Contact

Single Entry Applicant Form

Type *

Applicant

Primary

Yes

Full Name

First Name *

Hailey

Middle Name

Last Name *

Shulski

Organization Name *

Absolute Scapes

Mobile Phone ((xxx)xxx-xxxx)

(410) 489-0655

Home Phone ((xxx)xxx-xxxx)

E-mail

info@absolutescapes.com

Business Phone ((xxx)xxx-xxxx)

Preferred Channel

--Select--

Applicant Address

[New](#) [Look Up](#) [Deactivate](#) [Remove](#)

☐ Contact Address ID	Address Type	Address Line 1	City	State	Zip	Primary	Recipient	Status
0 record(s) found.								

Custom Fields

DATE TRACKING

Received Date

6/26/2026



Due Date

7/12/2026



Dates to Complete

14

(Number)

Received by Food



Food Review Type

--Select--

Equipment Specification Sheets Submitted



Equipment Specification Sheet

Received by Community Hygiene



Received by Well and Septic

6/26/2026



FACILITY INFORMATION

Name of Business (dba) *

n/a (Text)

Associated Building Permit Number

(Text)

Owner Switch Date

Does the project include an Aquatic Facility such as a Public Pool? If Yes, forward to CH Program.

☐ Yes ☐ No

Does the project include Private Septic? If Yes, forward to WS Program.

☐ Yes ☐ No

Is this a Prototype Food Service Facility? If Yes, refer to State.

☐ Yes ☐ No

Facility Fax

(Text)

Days of Operation

(Text)

Does this project have a Building Permit?

☐ Yes ☐ No

Building Permit Issued Date

☐ Non-Profit

Does the project include Private Well? If Yes, forward to WS Program.

☐ Yes ☐ No

Does the project include Food Services? If Yes, forward to FP Program.

☐ Yes ☐ No

Facility Phone

(Text)

Facility Email

(Text)

PROPERTY INFORMATION

Water Source

--Select--

Sewage Disposal

--Select--

Design Wastewater Flow

(Number)

Permit Type

--Select--

DEVELOPMENT PLANS**Property Type**

Residential = ▾

Signature Required☐ Yes ☐ No**Number of paper copies**
(Number)**Number of buildable lots created**
(Number)**Total Number of Lots**
(Number)**Plan Version**

Initial ▾

Engineer
(Text)**Number of mylar copies**
(Number)**Number of non-buildable lots created**
(Number)**Associated Plans****WELL AND SEPTIC INTERNAL****State Review Required**☐ Yes ☐ No**Coordinate State Review**☐ Yes ☐ No**Proposed Septic System Type**

--Select-- ▾

FOOD ESTABLISHMENT FACILITY**Priority Assessment**

--Select-- ▾

Licensed Type

--Select-- ▾

License Category

--Select-- ▾

FOOD ESTABLISHMENT INFORMATION**Hours of Operation**
(Text)☐ Operating Seasonally Only**If Operating Seasonally, What is the start month?**
(Text)**Are pets allowed in a outdoor seating area?**☐ Yes ☐ No**Full Bar?**☐ Yes ☐ No**RESTAURANT AND FOOD SERVICE****Food Service Facility Secondary Category**

--Select-- ▾

Total Seating Capacity
(Number)**Number of Restrooms**
(Number)**Interior Restaurant Seating Capacity**
(Number)**Bar Seating Capacity**
(Text)**Outdoor Seating Capacity**
(Text)**Does the restaurant have outdoor seating**☐ Yes ☐ No**EQUIPMENT****Evaluated non NSF, ANSI, CF or other standards**☐ Yes ☐ No**Description of Refrigeration Units****Number of Walk-In Refrigerator Units**
(Number)**Description of Walk-In Freezer Units**
(Text)**Is there a bulk ice machine available**☐ Yes ☐ No**Space Limitation****Number of Hand Sinks Available**
(Number)**Hood System**
(Text)**Ventless Equipment**
(Text)**PLUMBING****Size and installation of the water heater?**
(Text)**Is there a grease interceptor or grease trap?**

--Select-- ▾

REFUSE AND RECYCLABLES**Dumpsters Located on a impervious surface?**

--Select-- ▾

Will there be a grease receptacle?

--Select-- ▾

INSURANCE PANEL # 28 6025 B
UNITY PANEL # 240044
EFFECTIVE DATE DEC 4 1986




SCALE: 1" = 50'
DATE: JUNE 25, 2026

THE DRAWINGS, SPECIFICATIONS AND NOTES ARE THE PROPERTY OF ABSOLUTE LANDSCAPES. NO PART OF THIS DOCUMENT IS TO BE REPRODUCED OR TRANSMITTED IN ANY FORM OR BY ANY MEANS, ELECTRONIC OR MECHANICAL, WITHOUT THE WRITTEN PERMISSION OF ABSOLUTE LANDSCAPES. THIS PROJECT IS FOR THE LANDSCAPE ARCHITECT'S USE ONLY. IT IS NOT TO BE USED FOR ANY OTHER PURPOSES WITHOUT THE WRITTEN PERMISSION OF ABSOLUTE LANDSCAPES.

PROPOSED DECK-ON PLAT
FRACIS MINNI
14120 TWISTING LANE
DAYTON, MD 21036

REVISIONS	NOTES
DATE: XX/XX/XXXX	
DATE: XX/XX/XXXX	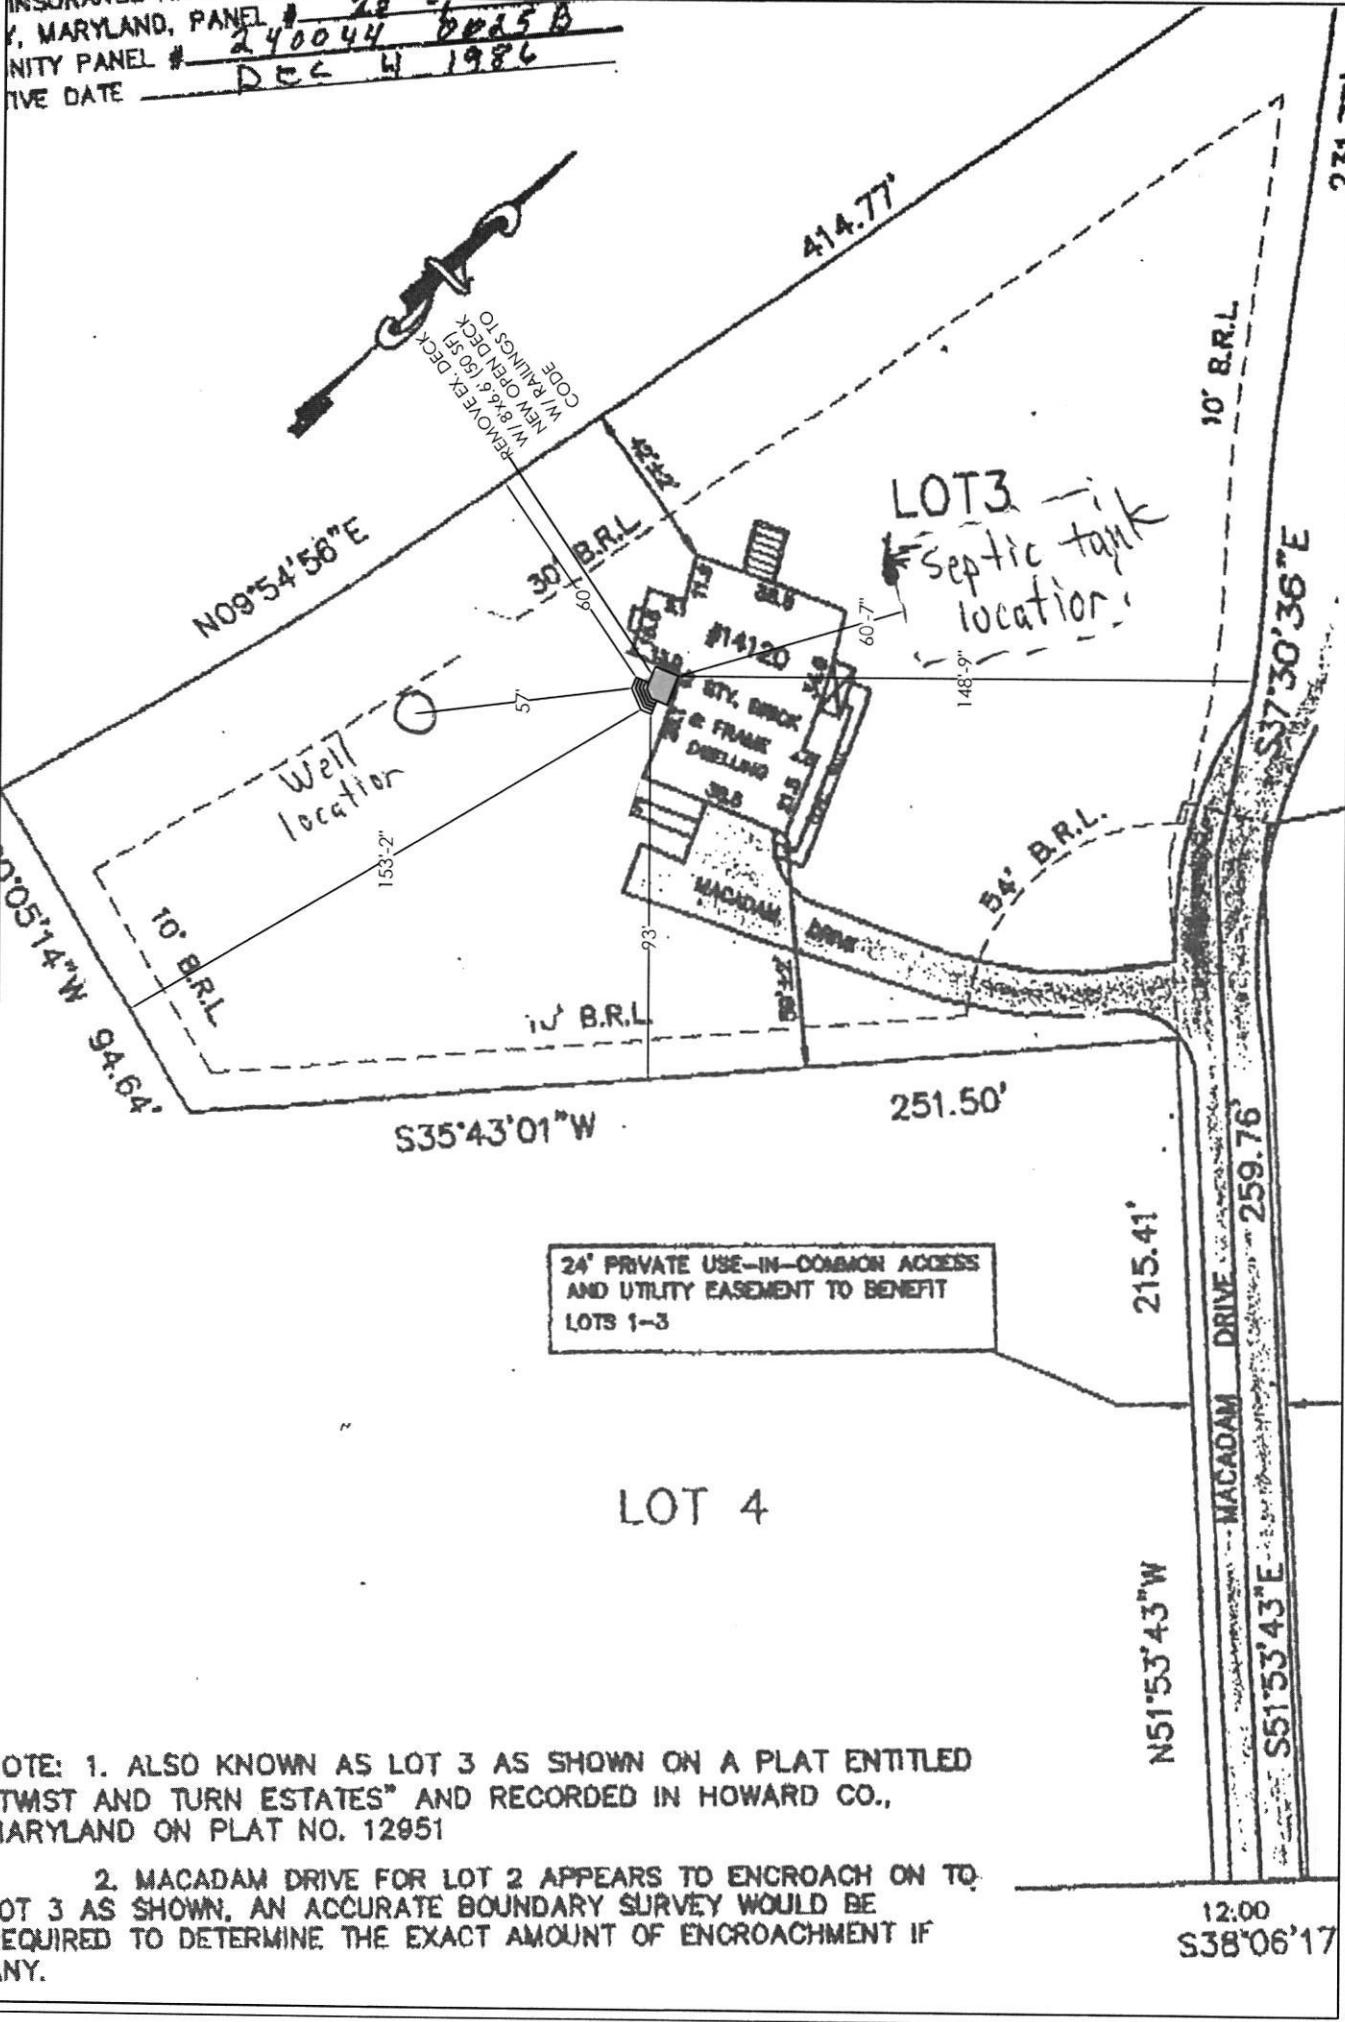
NOTE: 1. ALSO KNOWN AS LOT 3 AS SHOWN ON A PLAT ENTITLED "TWIST AND TURN ESTATES" AND RECORDED IN HOWARD CO., MARYLAND ON PLAT NO. 12951

2. MACADAM DRIVE FOR LOT 2 APPEARS TO ENCROACH ON TO LOT 3 AS SHOWN. AN ACCURATE BOUNDARY SURVEY WOULD BE REQUIRED TO DETERMINE THE EXACT AMOUNT OF ENCROACHMENT IF ANY.