

Menu Save Reset Cancel Help

Record Detail * (This section is required.)

Permit Type Building/Residential/Alteration/SFD Permit Number B26002095 Opened Date 06/22/2026

Description of Work

SFD/ KITCHEN ALTERATION TO INCLUDE: Replace load bearing wall with lam beam per structural engineering plans to relocate kitchen wall

[check spelling](#)

Address * (This section is required.)

Search Reset Clear Get Parcel & Owner
Street # 5465 Street Name HARRIS FARM Street Type LN
Unit Type -Select- Unit # X Coordinate -76.98203 Y Coordinate 39.22375
City CLARKSVILLE State MD Zip Code 21029 Primary Yes

Parcel * (This section is required.)

Search Reset Clear Get Address & Owner
GIS ID * 915693 Parcel 277 Parcel Area 2.02 Land Value 286400 Improved Value 679400 Exemption Value 393000 Plan Area RURAL

Legal Description

IMPSPAR L-A 2.023AR[]5465 HARRIS FARM LN[]CLARKSVILLE

[check spelling](#)

Block Lot P LA Census Tract 605101 Council Dist 5 Inspection Dist Supervisor Dist Map # DAP Zone
Plan Area State Tax Id 1405375479 Subdivision Name
Section Area Tax Map 28
Grid Zoning District RR-DEO ADC Map 4933-C5
SDP No. Final Plan No. WP File No.
Record Plat No. WS Contract No. FDP No. Primary Yes
Owner Occupied Year Built 1979 Historic District Yes No
Historic District Registry No. Stat Area 5-04A Flood Plain Yes No
Building No

Owner (This section is not required.)

Search Reset Clear
Name * DICK F
Address Line 1 5465 HARRIS FARM LN
Address Line 2
Address Line 3
Mail City CLARKSVILLE
Mail State MD
Mail Zip Code 21029
Phone 301-785-1122
Primary Yes
E-mail

Approved 6/25/26

- H.O.

Online BP.
JL 6/24/26

ryan.w.dick@gmail.com

Cell Number

Fax Number

Professionals (This section is not required.)

License # * 0	Business Name PROPERTY OWNER TO ACT AS CONTRACTOR			
License Type * Property Owner	First Name ▼ RYAN	Middle Name	Last Name DICK	
Primary Yes	Address Line 1 ▼ 5465 HARRIS FARM LN			
	Address Line 2			
	City CLARKSVILLE	State MD	ZIP Code 21029	
	Phone 1 301-785-1122	Phone 2	Fax	
	E-mail			

Applicant (This section is not required.)

Search	As Owner	As Lic. Prof	As Contact
Type * Applicant	First Name ▼ Ryan	MI	Last Name Dick
Relationship Applicant	Full Name ▼ DICK RYAN		
Primary No	Organization Name DICK RYAN		
	Street Address 5465 HARRIS FARM LN		
	Address Line 2		
	City CLARKSVILLE	State MD	Zip Code ▼ 21029
	Phone 301-785-1122	Cell	Fax
	E-mail * ryan.w.dick@gmail.com		

Contact (This section is not required.)

Search	As Owner	As Lic. Prof	As Contact
Type Contact	First Name ▼ Ryan	MI	Last Name Dick
Relationship Applicant	Full Name ▼ DICK RYAN		
Primary Yes	Organization Name DICK RYAN		
	Street Address 5465 HARRIS FARM LN		
	Address Line 2		
	City CLARKSVILLE	State MD	Zip Code ▼ 21029
	Phone 301-785-1122	Cell	Fax
	E-mail ryan.w.dick@gmail.com		

Addtl Info

Est Construction Cost * 16000	Housing Units * 0	Number of Buildings * 0	Public Owned No	▼
Construction Type 434 - Additions, Alterations and Conversions - Residential				

RESIDENTIAL ALTERATION INFO

RESIDENTIAL ALTERATION INFORMATION

Total Square Footage * 225	No of Stories * SQFT (Number) 1	Basement (Number) Partially Finished	Bedrooms ▼ 0	Full Baths (Number) 0	Half Baths (Number) 0	Water * (Number) Private	Sewage * ▼ Private
--------------------------------------	---	--	------------------------	---------------------------------	---------------------------------	------------------------------------	------------------------------

Existing Utilities *
Gas & Electric ▼

Existing Heating System *
Electric & Natural Gas ▼


Existing Sprinkler System *
None ▼

Type of New Fireplace
--Select-- ▼

Expiration Date
12/21/2026 


Submit Cancel

5465 Hwy. 5 Farm Lk.
Single Story Rancher

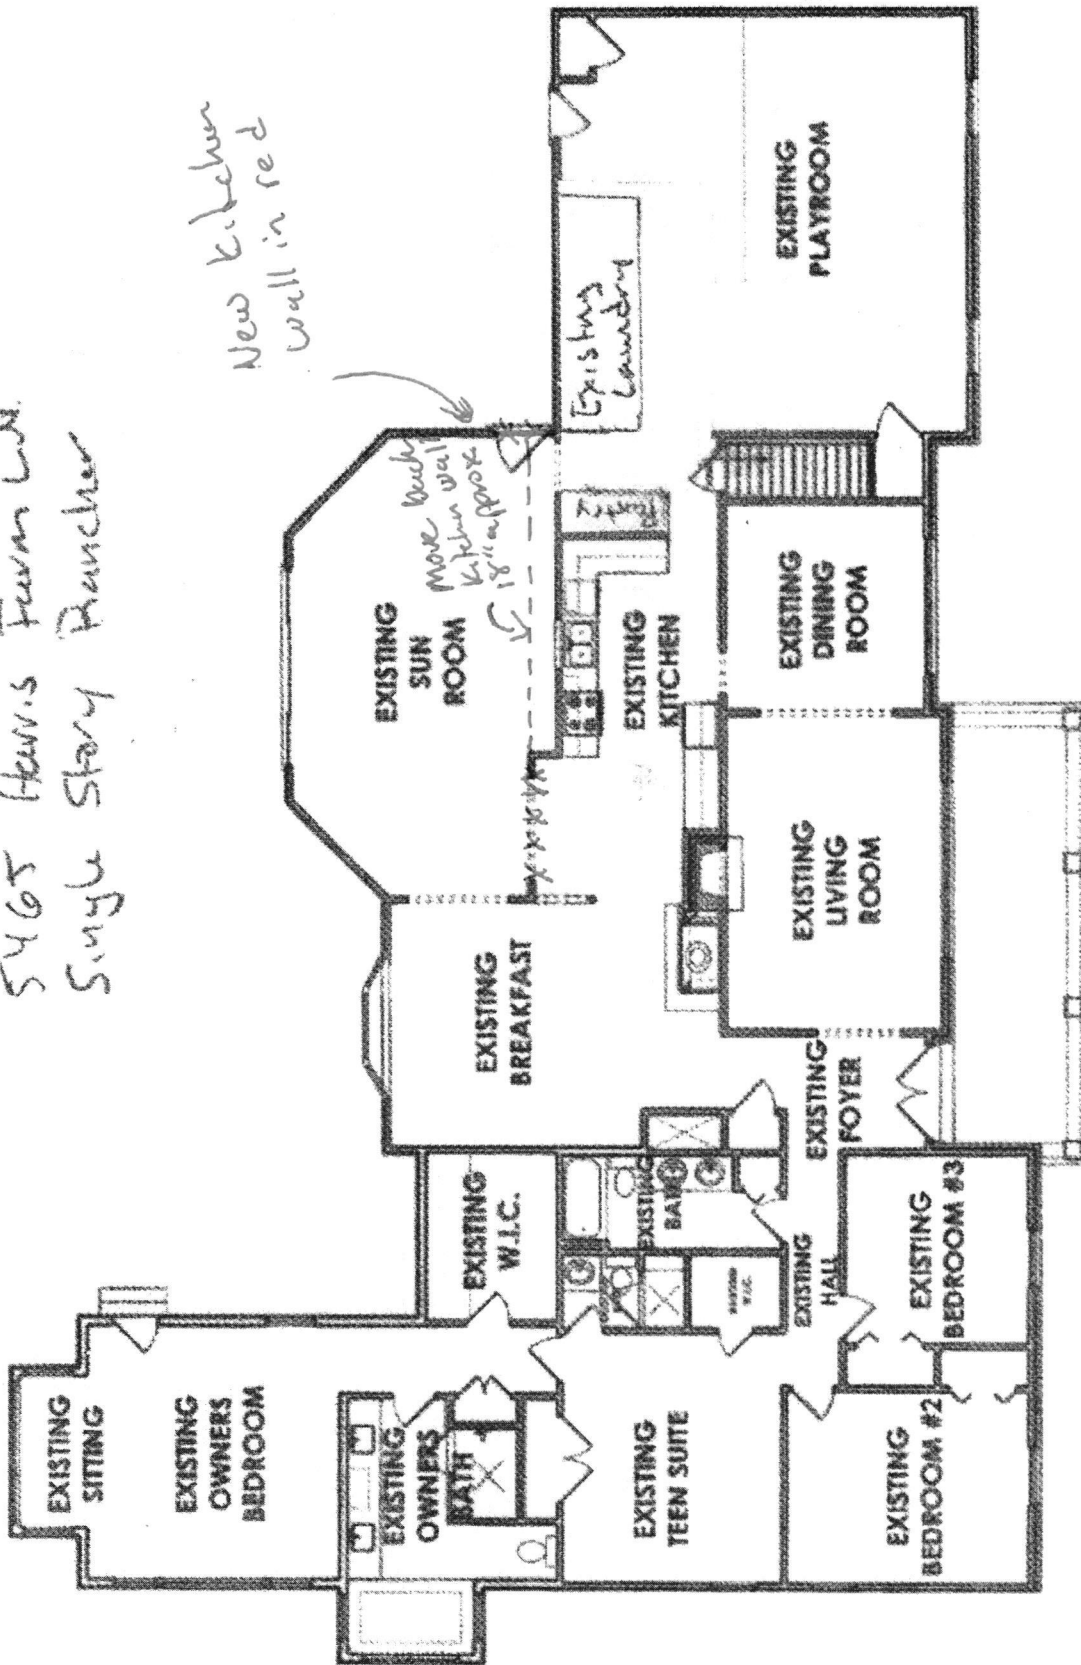

EXISTING FIRST FLOOR

5465 Harris Farm Ln.
Single Story Rancher

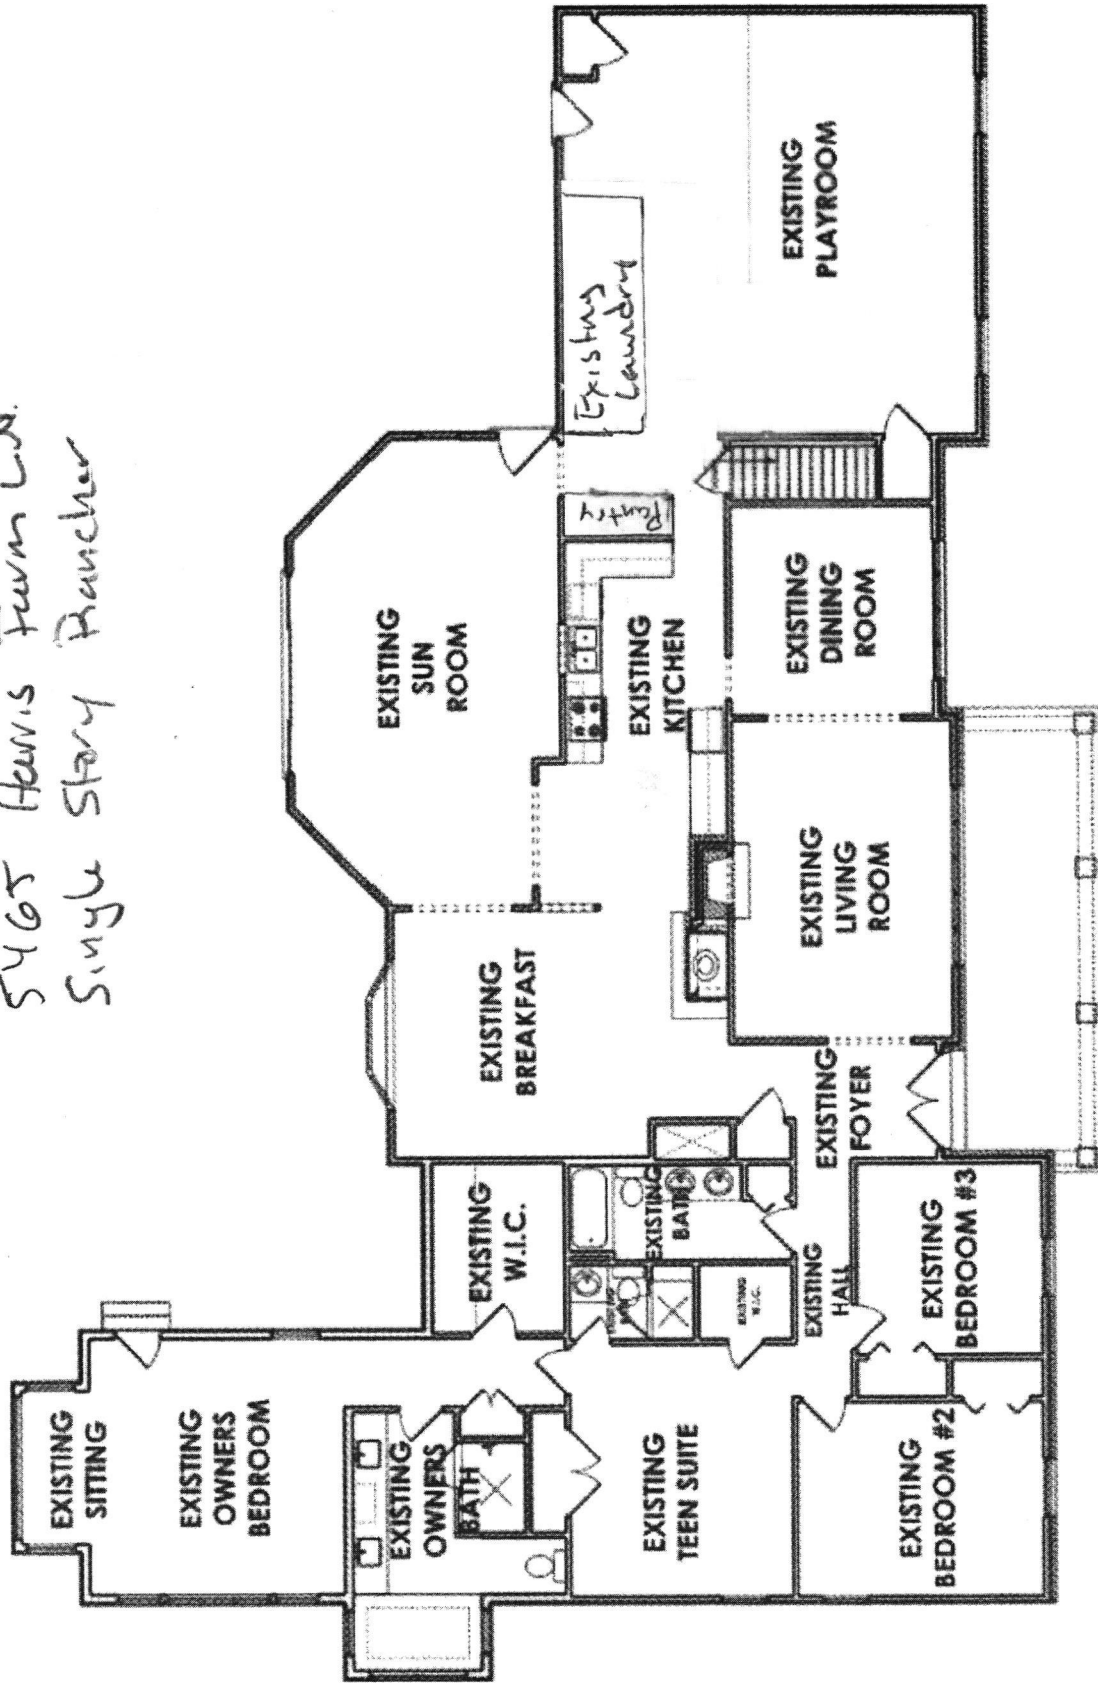

EXISTING FIRST FLOOR