

Record Detail * (This section is required.)

Permit Type	Permit Number	Opened Date
Building/Residential/Misc/Tanks	B26000743	03/16/2026
Description of Work		
SFD//INSTALL (1) 500 GAL UNDERGROUND PROPANE TANK		

[check spelling](#)

Address * (This section is required.)

Search Reset Clear Get Parcel & Owner

Street #	Street Name	Street Type
2805	BELLE HOLLOW	CT
Unit Type	Unit #	X Coordinate
--Select--		-77.01203
		Y Coordinate
		39.30557
City	State	Zip Code
GLENWOOD	MD	21738
	Primary	Yes

Approved 3/25/26
At

Parcel * (This section is required.)

Search Reset Clear Get Address & Owner

GIS ID *	Parcel	Parcel Area	Land Value	Improved Value	Exemption Value	Plan Area
905601	123	1.26	298800	1176300	877500	RURAL
Legal Description						
IMPSLOT 19 1.266 A [2805 BELLE HOLLOW CT [] GWYNDYL OAK ESTATES						

[check spelling](#)

Block	Lot	Census Tract	Council Dist	Inspection Dist	Supervisor Dist	Map #	DAP Zone
	19	605601	5				
Plan Area	State Tax Id	Subdivision Name					
	1404356152	GWYNDYL OAK ESTATES					
Section	Area	Tax Map					
		14					
Grid	Zoning District	ADC Map					
14-11	RC-DEO	4812-J2					
SDP No.	Final Plan No.	WP File No.					
		FDP No.					
Record Plat No.	WS Contract No.	Primary					
11550		Yes					
Owner Occupied	Year Built	Historic District					
☐ Yes ☐ No	1997	☐ Yes ☒ No					
Historic District Registry No.	Stat Area	Flood Plain					
	4-06	☐ Yes ☒ No					
Building No							

Owner * (This section is required.)

Search Reset Clear

Name *
O'DON
Address Line 1
2805 BELLE HOLLOW CT
Address Line 2
Address Line 3

Mail City

GLENWOOD

Mail State

MD

Mail Zip Code

21738

Phone

443-610-7515

Primary

Yes

E-mail**Cell Number****Fax Number****Professionals** (This section is not required.)**License # ***

20100085886

Business Name

GREAT VALLEY PROPANE INC.

License Type *

Propane Gs

First Name

SCOTT

Middle Name

ERIC

Last Name

ANTKOWIAK

Primary

Yes

Address Line 1

57 LANCASTER AVENUE

Address Line 2**City**

MALVERN

State

PA

ZIP Code

19355-0000

Phone 1

4104584767

Phone 2**Fax**

4103742425

E-mail

SANTKOWIAK@TEVISPROPANE.COM

Applicant (This section is not required.)**Search****As Owner****As Lic. Prof****As Contact****Type ***

Applicant

First Name

MICHELLE

MI**Last Name**

CLANCY

Relationship

Applicant

Full Name

MICHELLE CLANCY

Primary

Yes

Organization Name

APPLIED & APPROVED PERMITS LLC

Street Address

P.O. BOX 310

Address Line 2**City**

PERRY HALL

State

MD

Zip Code

21128

Phone

443-340-1229

Cell**Fax****E-mail ***

MICHELLE@APPLIEDANDAPPROVED.COM

Addtl Info**Est Construction Cost ***

750

Housing Units *

0

Number of Buildings *

0

Public Owned

No

Construction Type

434 - Additions, Alterations and Conversions - Residential

TANK INFORMATION**RESIDENTIAL TANK INFORMATION****Capital Project-No Fee ***☐ Yes ☒ No**Capital Project Number** (Text)**Fee Exempt ***☐ Yes ☒ No**Roadside Tree Project Permit ***☐ Yes ☒ No**Roadside Tree Permit #** (Text)**Existing Use ***

SFD

Number of Tanks Installed *

1


Number of Tanks Removed *

(Number) 0

(Number)

LANDTECH ASSOCIATES, INC.

1410 CRAIN HIGHWAY, N.W. SUITE 700 GLEN BURLEIGH, MD 21061
(410) 764-2121 FAX (410) 553-9081

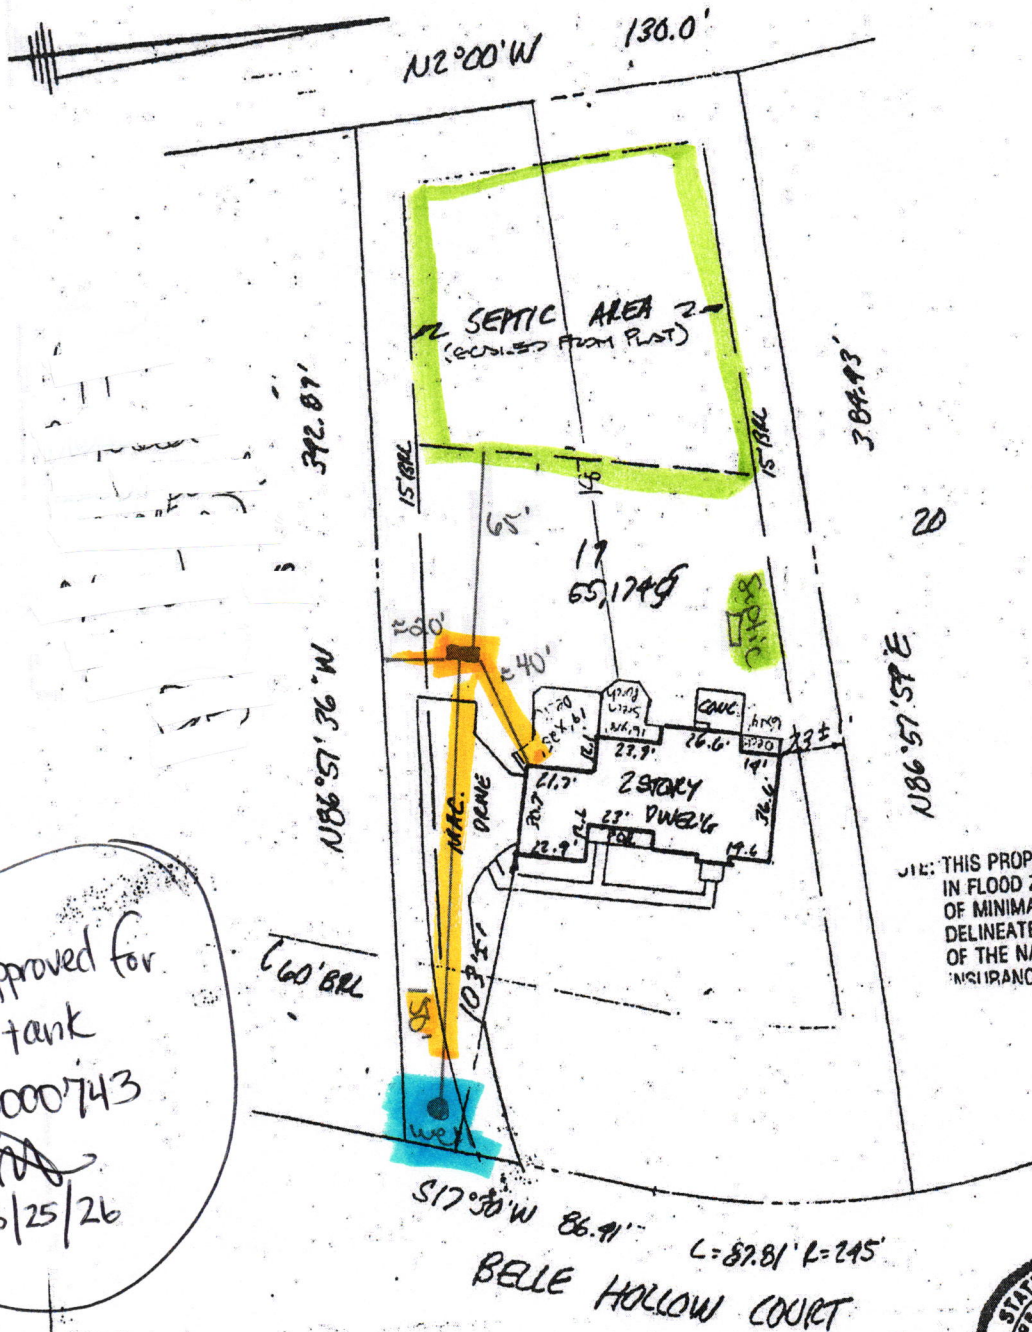

NOTE: THIS PROPERTY LIES IN FLOOD ZONE C, AN AREA OF MINIMAL FLOODING, AS DELINEATED ON THE MAPS OF THE NATIONAL FLOOD INSURANCE PROGRAM

Approved for
LP tank
B26000743
3/25/26

Notes:

- 1) This plat is of benefit to a consumer only insofar as it is required by a lender or a title insurance company or its agent in connection with contemplated transfer, financing or re-financing.
- 2) This plat is not to be relied upon for the establishment or location of fences, garages, buildings, or other existing or future improvements.
- 3) This plat does not provide for the accurate identification of property boundary lines, but such identification may not be required for the transfer of title or securing financing or refinancing.
- 4) No title report furnished.

Certification: This is to certify that the improvements indicated hereon are located as shown.

LIBER _____ FOLIO _____
LOT 19 BLOCK _____ SECT. _____ PLAT _____
PLAT ENTITLED GWYNIDYL OAK ESTATES
RECORDED IN HOWARD CO. MD.
PLAT BOOK 11530 FOLIO _____



Graden A. Rogers
GRADEN A. ROGERS - Prof. L.S. MD. Lic. No. 119

2805 BELLE HOLLOW CT.

SCALE 1" = 50' CASE NO. 29829201
DATE 7-22 1998 JOB NO. TWP8201

Notes:

1. Lot shown contains 55,174 s.f. of land and recorded at plot # 11550 among the land records of Howard County, Maryland.
2. Prepared by Gutschick, Little and Weber, P.A.
3. Grading around house may vary due to field conditions.
4. No construction stockpiling refuse or excess material shall be buried in septic easement.
5. Wells shown per SP-93-15.
6. Install sediment controls as required by Site Inspector. See Sediment Control Plan # GP-95-26.
7. Disturbed area shown is 17,213 s.f.
8. Pile excavated material on high side of trench when installing septic field prior to disposal of excess material.
9. Length of trench for septic system to be determined and specified by Howard County Department of Health.

SEPTIC SYSTEM DATA:

BASEMENT FLOOR AREA = 528.66
 INV. OUT OF HOUSE = 526.65
 INV. IN AT SEPTIC TANK = 525.25
 INV. OUT AT SEPTIC TANK = 525.00
 EX. ELEV. AT SEPTIC TANK = 527.52
 PROP. ELEV. AT SEPTIC TANK = 527.32
 INV. IN AT DIST. BOX = 521.40
 EX. ELEV. AT DIST. BOX = 524.42

LOT 19

GWYNDRY OAK ESTATES

4th ELEC. DIST.

HOWARD CO., MD



July 31, 1996

1"=50'

Approved Septic System Plan
 Howard County Health Department


Sonia K See
 Signature

8/7/96
 Date

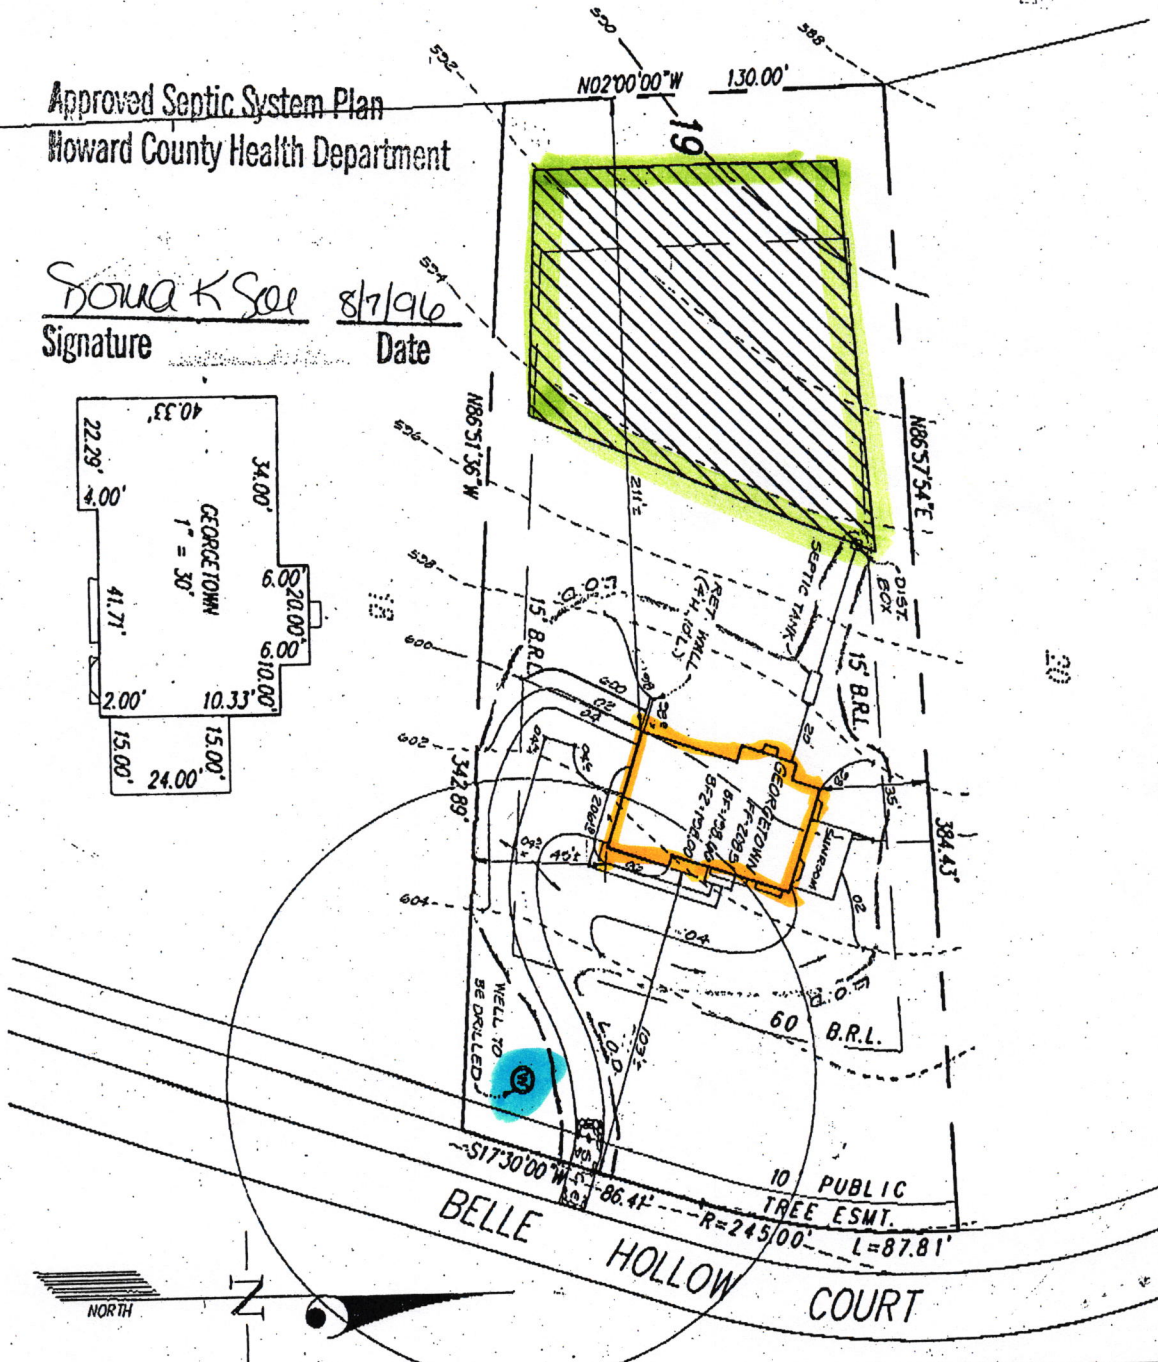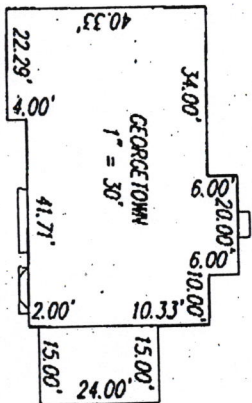



ABOVEGROUND/UNDERGROUND PROPANE STORAGE TANKS 120 - 1000 Gallons

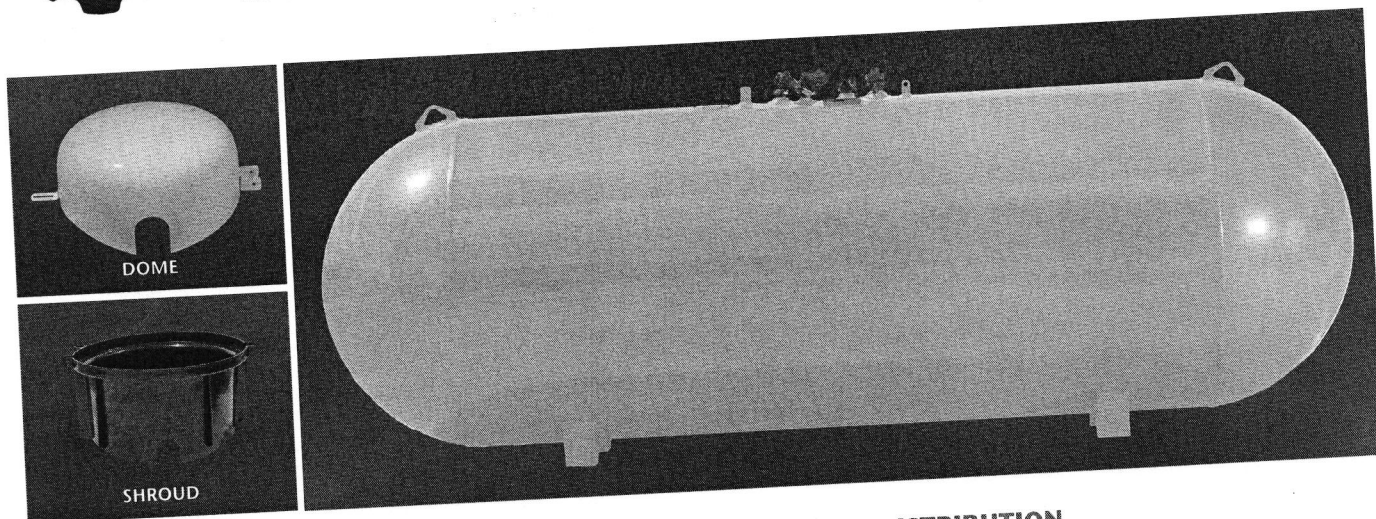

PRESSURE VESSEL CODES & REGISTRATION

- Designed and constructed in accordance with the ASME Section VIII, Division 1 Code
- Registered with the National Board of Boiler & Pressure Vessels Inspectors
- Complies with NFPA 58
- Conforms to specifications set forth by the Railroad Commission of Texas

VESSEL FEATURES

- Tanks fully fitted with RegO valves and Rochester liquid level gauges
- Dual service options for aboveground or underground applications
- Product supplied with steel dome (custom colors available upon request) or plastic AG/UG shroud, specify at time of order
- Container pressure rated at 250 PSI @ 400°F
- Vacuum purged
- Stainless steel data plate
- Anode bolt connection located under the dome
- #54 liquid level outage valve orifice

PROCESS CONTROL

All welded products are x-rayed and pressure tested @ 325 PSI per ASME Sec VIII, Div I requirements, followed by rigorous leak test inspections, both pre and post valving

STORAGE & DISTRIBUTION

Contact Propane Education & Research Council for additional resources and information at propane.com

PAINT SPECIFICATIONS

At the time of order, customer must specify intended application thus determining paint applied at the time of manufacturing


Aboveground tank applications:

- Painted Sky White with super durable TGIC polyester powder paint for maximum rust protection
- Custom colors available upon request
- If an aboveground painted tank is intended for underground use, tank must be field painted for such application

Underground tank applications:

- Painted gray with a "ready to bury", durable epoxy powder paint for underground applications
- Product used underground may require additional protective coating and cathodic protections, contact your federal, state or local authorities for specifications

Made With Pride

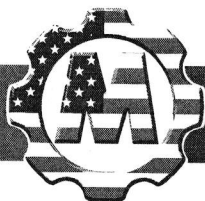

Made In the U.S.A.



ABOVEGROUND/UNDERGROUND PROPANE STORAGE TANKS 120 - 1000 Gallons

ABOVEGROUND/UNDERGROUND VESSEL DIMENSIONS & SPECIFICATIONS

(All Vessel Dimensions are Approximate)

Part Number	Description	Water Capacity Gal/l	Outside Diameter In/mm	Head Type	Overall Length In/mm	Overall Height In/mm	Leg Width In/mm	Leg Spacing In/mm	Weight Lbs/kg	Quantity Full Load	Per Stack
68280.6	120 Gallon AG/UG Storage Tank, Gray	120 454.2	24" 609.6	Ellip	5' 8" 1727.2	3' 1 3/16" 944.5	10 1/8" 257.2	3' 0" 914.4	312 141.5	96	12
68281.6	250 Gallon AG/UG Storage Tank, Gray	250 946.3	30" 762	Hemi	7' 10" 2387.6	3' 6 15/16" 1090.6	12 3/4" 323.9	3' 6" 1066.8	462 209.5	54	9
68282.6	320 Gallon AG/UG Storage Tank, Gray	320 1211.3	30" 762	Hemi	9' 7" 2921	3' 6 15/16" 1090.6	12 3/4" 323.9	4' 0 1/4" 1225.6	567 257.2	45	9
68283.26**	500 Gallon AG/UG Storage Tank, Gray	500 1892.7	41" 1041.4	Hemi	8' 8 1/2" 2654.3	4' 4" 1320.8	16 1/4" 412.8	3' 6" 1066.8	987 447.7	30	5
68284.26**	1000 Gallon AG/UG Storage Tank, Gray	1000 3785.4	41" 1041.4	Hemi	15' 11" 4851.4	4' 5 3/4" 1365.3	16 1/4" 412.8	9' 0" 2743.2	1739 788.8	15	5

† Federal, state or local regulations may contain specific applicable requirements for protective coatings and cathodic protection. The purchaser and installer are responsible for compliance with such federal, state, local and NFPA industry regulations, including, but not limited to, proper purging prior to putting into service. Cathodic protection is required. Coating (s) must be continuous, uninterrupted and must comply with local, state or national codes or regulations.

* Drain **No Drain

