

Permit cancelled
closed 3/25/26
-H.O.

Record Detail * (This section is required.)

Permit Type	Permit Number	Opened Date
Building/Residential/Misc/Deck	B26000764	03/17/2026
Description of Work		
SFD/ REPLACE SOME STRUCTURAL ELEMENTS AND RAILINGS ON EXISTING DECK		

Online BP.
3/18/26

[check spelling](#)

Address * (This section is required.)

Search Reset Clear Get Parcel & Owner

Street #	Street Name	Street Type
5095	GREEN BRIDGE	RD
Unit Type	Unit #	X Coordinate
--Select--		-76.9936
		Y Coordinate
		39.23063
City	State	Zip Code
DAYTON	MD	21036
	Primary	
	Yes	

Parcel * (This section is required.)

Search Reset Clear Get Address & Owner

GIS ID *	Parcel	Parcel Area	Land Value	Improved Value	Exemption Value	Plan Area
915875	56	1	276200	560000	283800	RURAL
Legal Description						
IMPS1.000 ACRES[]5095 GREEN BRIDGE RD[]DAYTON						

[check spelling](#)

Block	Lot	Census Tract	Council Dist	Inspection Dist	Supervisor Dist	Map #	DAP Zone
		605101	5				
Plan Area		State Tax Id	Subdivision Name				
		1405353734					
Section		Area	Tax Map				
			28				
Grid		Zoning District	ADC Map				
28-13		RR-DEO	4933-A4				
SDP No.		Final Plan No.	WP File No.				
Record Plat No.		WS Contract No.	FDP No.	Primary			
				Yes			
Owner Occupied		Year Built	Historic District				
☐ Yes ☐ No		1966	☐ Yes ☒ No				
Historic District Registry No.		Stat Area	Flood Plain				
		5-04A	☐ Yes ☒ No				
Building No							

Owner * (This section is required.)

Search Reset Clear

Name *

DEY RI

Address Line 1

5095 GREEN BRIDGE RD

Address Line 2

Address Line 3

Mail City
DAYTON
Mail State
MD
Mail Zip Code
21036
Phone
410-336-7155
Primary
Yes
E-mail

Cell Number Fax Number

Professionals (This section is not required.)

License # * Business Name
License Type * First Name Middle Name Last Name
--Select--
Primary Address Line 1
Yes Address Line 2
City State ZIP Code
Phone 1 Phone 2 Fax
E-mail

Applicant (This section is not required.)

Search As Owner As Lic. Prof As Contact

Type * First Name MI Last Name
Applicant Dena Goldsmith
Relationship Full Name
Applicant Dena Goldsmith
Primary Organization Name
Yes Home Safe Home
Street Address
6 farrington ct
Address Line 2
City State Zip Code
Baltimore MD 21209
Phone Cell Fax
410-394-8955
E-mail *
dena@homesafehomemd.com

Addl Info

Est Construction Cost * Housing Units * Number of Buildings * Public Owned
15000 0 0 No
Construction Type
434 - Additions, Alterations and Conversions - Residential

MISC PERMIT INFO


MISCELLANEOUS PERMIT INFORMATION

Capital Project-No Fee * Capital Project Number Fee Exempt * Roadside Tree Project Permit * Roadside Tree Project Permit #
☐ Yes ☒ No (Text) ☐ Yes ☒ No ☐ Yes ☒ No
Existing Use * Water Sewage Expiration Date
SFD Private Private 9/14/2026

Submit

Cancel

*** SEE DECK CODE COMPLIANCE GUIDELINES FOR MINIMUM SPECIFICATIONS

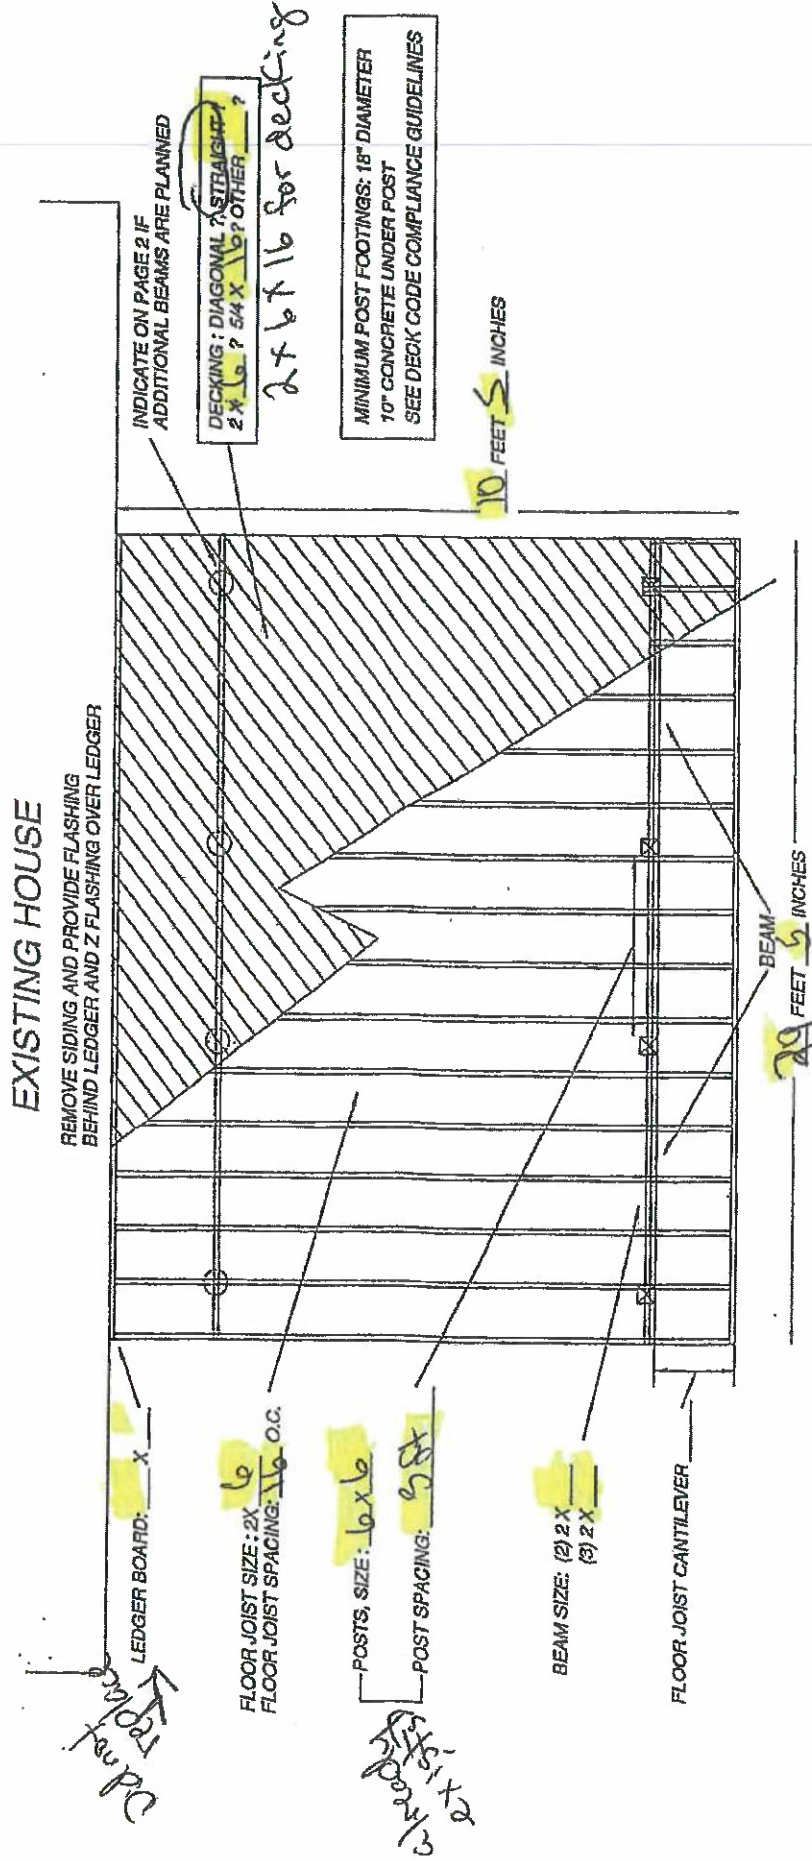


Sample ① DECK FLOOR FRAMING PLAN EXAMPLE

1 OF 2

OPEN DECK

*** SEE DECK CODE COMPLIANCE GUIDELINES
FOR MINIMUM SPECIFICATIONS

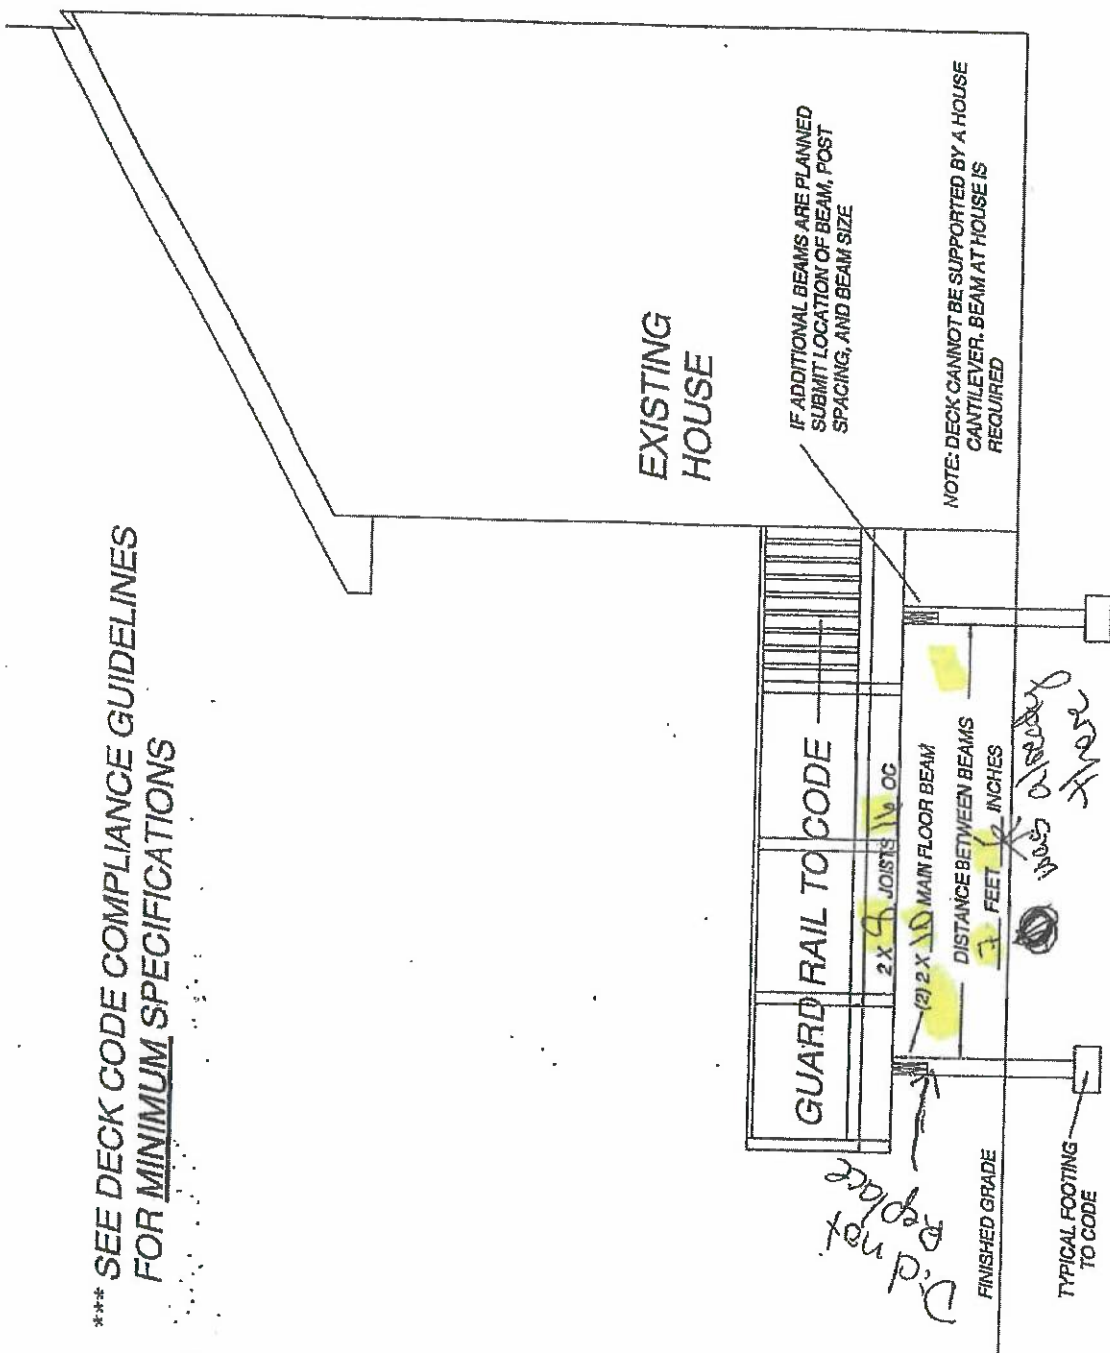

DECK CROSS SECTION

Oswald Jr, Woodin

From: Oswald Jr, Woodin
Sent: Monday, March 23, 2026 8:25 AM
To: 'Home Safe Home'
Subject: RE: B26000764_5095 Green Bridge Road_Site Plan Request
Attachments: Building Permit Application Process.pdf

Hi Dena,

Good morning. We still need a site plan with this building permit application. Please see attached.

Thanks,

Hank

Hank Oswald
Licensed Environmental Health Specialist
Bureau of Environmental Health
Howard County Health Department
8930 Stanford Blvd. Columbia, MD 21045
(410) 313 - 1786
www.hchealth.org

DISCLAIMER: This e-mail is intended only for the individual to whom it is addressed. It may be used only in accordance with applicable laws. If you are not the intended recipient, you are strictly prohibited from reading, disseminating, distributing, or copying this message. If you received this e-mail by mistake, please notify the sender and destroy this e-mail

From: Home Safe Home <Dena@homesafehomemd.com>
Sent: Friday, March 20, 2026 9:29 AM
To: Oswald Jr, Woodin <hoswald@howardcountymd.gov>
Subject: Re: B26000764_5095 Green Bridge Road_Site Plan Request

WARNING!!!

This email originated from someone outside of Howard County
*****DO NOT CLICK LINKS OR OPEN ATTACHMENTS*****
unless you recognize the sender and know for sure that the content is safe

Septic tank is in the back of the house we were not working there.

Dena Goldsmith, CAPS
Home Safe Home
410-394-8955

Homesafehomemd.com
Dena@homesafehomemd.com

On Fri, Mar 20, 2026 at 8:39 AM Oswald Jr, Woodin <hoswald@howardcountymd.gov> wrote:

Hi Dena,

Good morning. Please provide a scaled site plan printable to engineer scale on a sheet of paper no larger than 11" x 17", and include all existing/proposed structures including the location of the existing well and septic system components.

I've attached a copy of the septic record and the list of well and septic setback distances. Should you have any questions, please feel free to contact me.

Regards,

Hank

Hank Oswald

Licensed Environmental Health Specialist

Bureau of Environmental Health

Howard County Health Department

8930 Stanford Blvd. Columbia, MD 21045

(410) 313 - 1786

www.hchealth.org

DISCLAIMER: This e-mail is intended only for the individual to whom it is addressed. It may be used only in accordance with applicable laws. If you are not the intended recipient, you are strictly prohibited from reading, disseminating, distributing, or copying this message. If you received this e-mail by mistake, please notify the sender and destroy this e-mail

Oswald Jr, Woodin

From: Martin, Sharhonda
Sent: Wednesday, March 25, 2026 1:23 PM
To: Oswald Jr, Woodin
Subject: FW: Howard County Permit #B26000764

FYI

From: DILP@howardcountymd.gov <DILP@howardcountymd.gov>
Sent: Wednesday, March 25, 2026 8:23 AM
To: Silvast, Zackary <zsilvast@howardcountymd.gov>; Martin, Sharhonda <smmartin@howardcountymd.gov>; Taylor, Aleetta <ataylor@howardcountymd.gov>; Briscoe, Jamie <jabriscoe@howardcountymd.gov>; Harding, Trina <tharding@howardcountymd.gov>; Dekroney, Vicki <edekroney@howardcountymd.gov>; Williams, Jeffrey <jewilliams@howardcountymd.gov>
Subject: Howard County Permit #B26000764

This email is to inform you that Permit #B26000764 located at **5095 GREEN BRIDGE RD DAYTON MD 21036** has been **cancelled** by Howard County Licenses & Permits. The reason for the cancellation is/are

CANCELLED AT REQUEST OF APPLICANT - HOMEOWNER HAS APPLIED FOR THEIR OWN PERMIT

If you have any questions, please call 410-313-2455. **This is a system generated email-DO NOT REPLY.**