

Record Detail * (This section is required.)

Permit Type	Permit Number	Opened Date
Building/Residential/Alteration/SFD	B26000643	03/04/2026
Description of Work		
SFD/ Second floor alterations to Demo existing bathroom and relocate tub, vanity and toilet. New plumbing, and electrical rough in will occur. Existing door will be closed in, and new pocket doors will be installed to make bathroom a jack and jill.**APPROVAL FOR BATHROOM WORK ONLY, SUBJECT TO FIELD INSPECTION**		

[check spelling](#)

Address * (This section is required.)

Search	Reset	Clear	Get Parcel & Owner		
Street #	Street Name	Street Type			
15335	SWEETBAY	ST			
Unit Type	Unit #	X Coordinate	Y Coordinate		
-Select-		-77.05081	39.2892		
City	State	Zip Code	Primary		
WOODBINE	MD	21797	Yes		

Parcel * (This section is required.)

Search	Reset	Clear	Get Address & Owner			
GIS ID *	Parcel	Parcel Area	Land Value	Improved Value	Exemption Value	Plan Area
926430	66	40019	294500	1112000	817500	RURAL
Legal Description						
IMPSLOT 5 40019 SQ[]15335 SWEETBAY STREET[]BELLE HAVEN ESTATES						

[check spelling](#)

Block	Lot	Census Tract	Council Dist	Inspection Dist	Supervisor Dist	Map #	DAP Zone
	5	605601	5				
Plan Area	State Tax Id		Subdivision Name				
	1404373685		Belle Haven Estates				
Section	Area		Tax Map				
			14				
Grid	Zoning District		ADC Map				
14-20	RC-DEO		4812-B4				
SDP No.	Final Plan No.		WP File No.				
	F-07-038						
Record Plat No.	WS Contract No.		FDP No.		Primary		
19948-1995					Yes		
Owner Occupied	Year Built		Historic District				
☐ Yes ☐ No	2013		☐ Yes ☒ No				
Historic District Registry No.	Stat Area		Flood Plain				
	4-08		☐ Yes ☒ No				
Building No							

Owner (This section is not required.)

Search	Reset	Clear
Name *		
DUAN		
Address Line 1		
15335 SWEETBAY ST		
Address Line 2		
Address Line 3		
Mail City		
WOODBINE		
Mail State		
MD		
Mail Zip Code		
21797		
Phone		
603-286-0248		
Primary		
Yes		
E-mail		

Cell Number

Fax Number

Professionals

License # *

Business Name

License Type *

First Name

Middle Name

Last Name

Primary

Address Line 1

Yes

Address Line 2

City

State

ZIP Code

Phone 1

Phone 2

Fax

E-mail

Applicant

Search

As Owner

As Lic. Prof

As Contact

Type *

First Name

MI

Last Name

Relationship

Full Name

Primary

Organization Name

No

Vs Home Improvement

Street Address

13905 Penn Shop Rd

Address Line 2

City

State

Zip Code

Phone

Cell

Fax

E-mail *

vshomeimp@yahoo.com

Contact

Search

As Owner

As Lic. Prof

As Contact

Type

First Name

MI

Last Name

Relationship

Full Name

Primary

Organization Name

Yes

Vs Home Improvement

Street Address

13905 Penn Shop Rd

Address Line 2

City

State

Zip Code

Phone

Cell

Fax

E-mail

vshomeimp@yahoo.com

Addtl Info

Est Construction Cost *

Housing Units *

Number of Buildings *

Public Owned

21000

0

0

No

Construction Type

434 - Additions, Alterations and Conversions - Residential

RESIDENTIAL ALTERATION INFO

RESIDENTIAL ALTERATION INFORMATION

Total Square Footage *

No of Stories *

Basement

Bedrooms

Full Baths

Half Baths

Water *

Sewage *

60

SQFT (Number) 2

(Number) --Select--

(Number)

(Number)

(Number) Private

Private

Existing Utilities *

Unknown

Existing Heating System *

Unknown

Existing Sprinkler System *

NFPA #13D

Type of New Fireplace


--Select--

Expiration Date

9/5/2026


Submit

Cancel

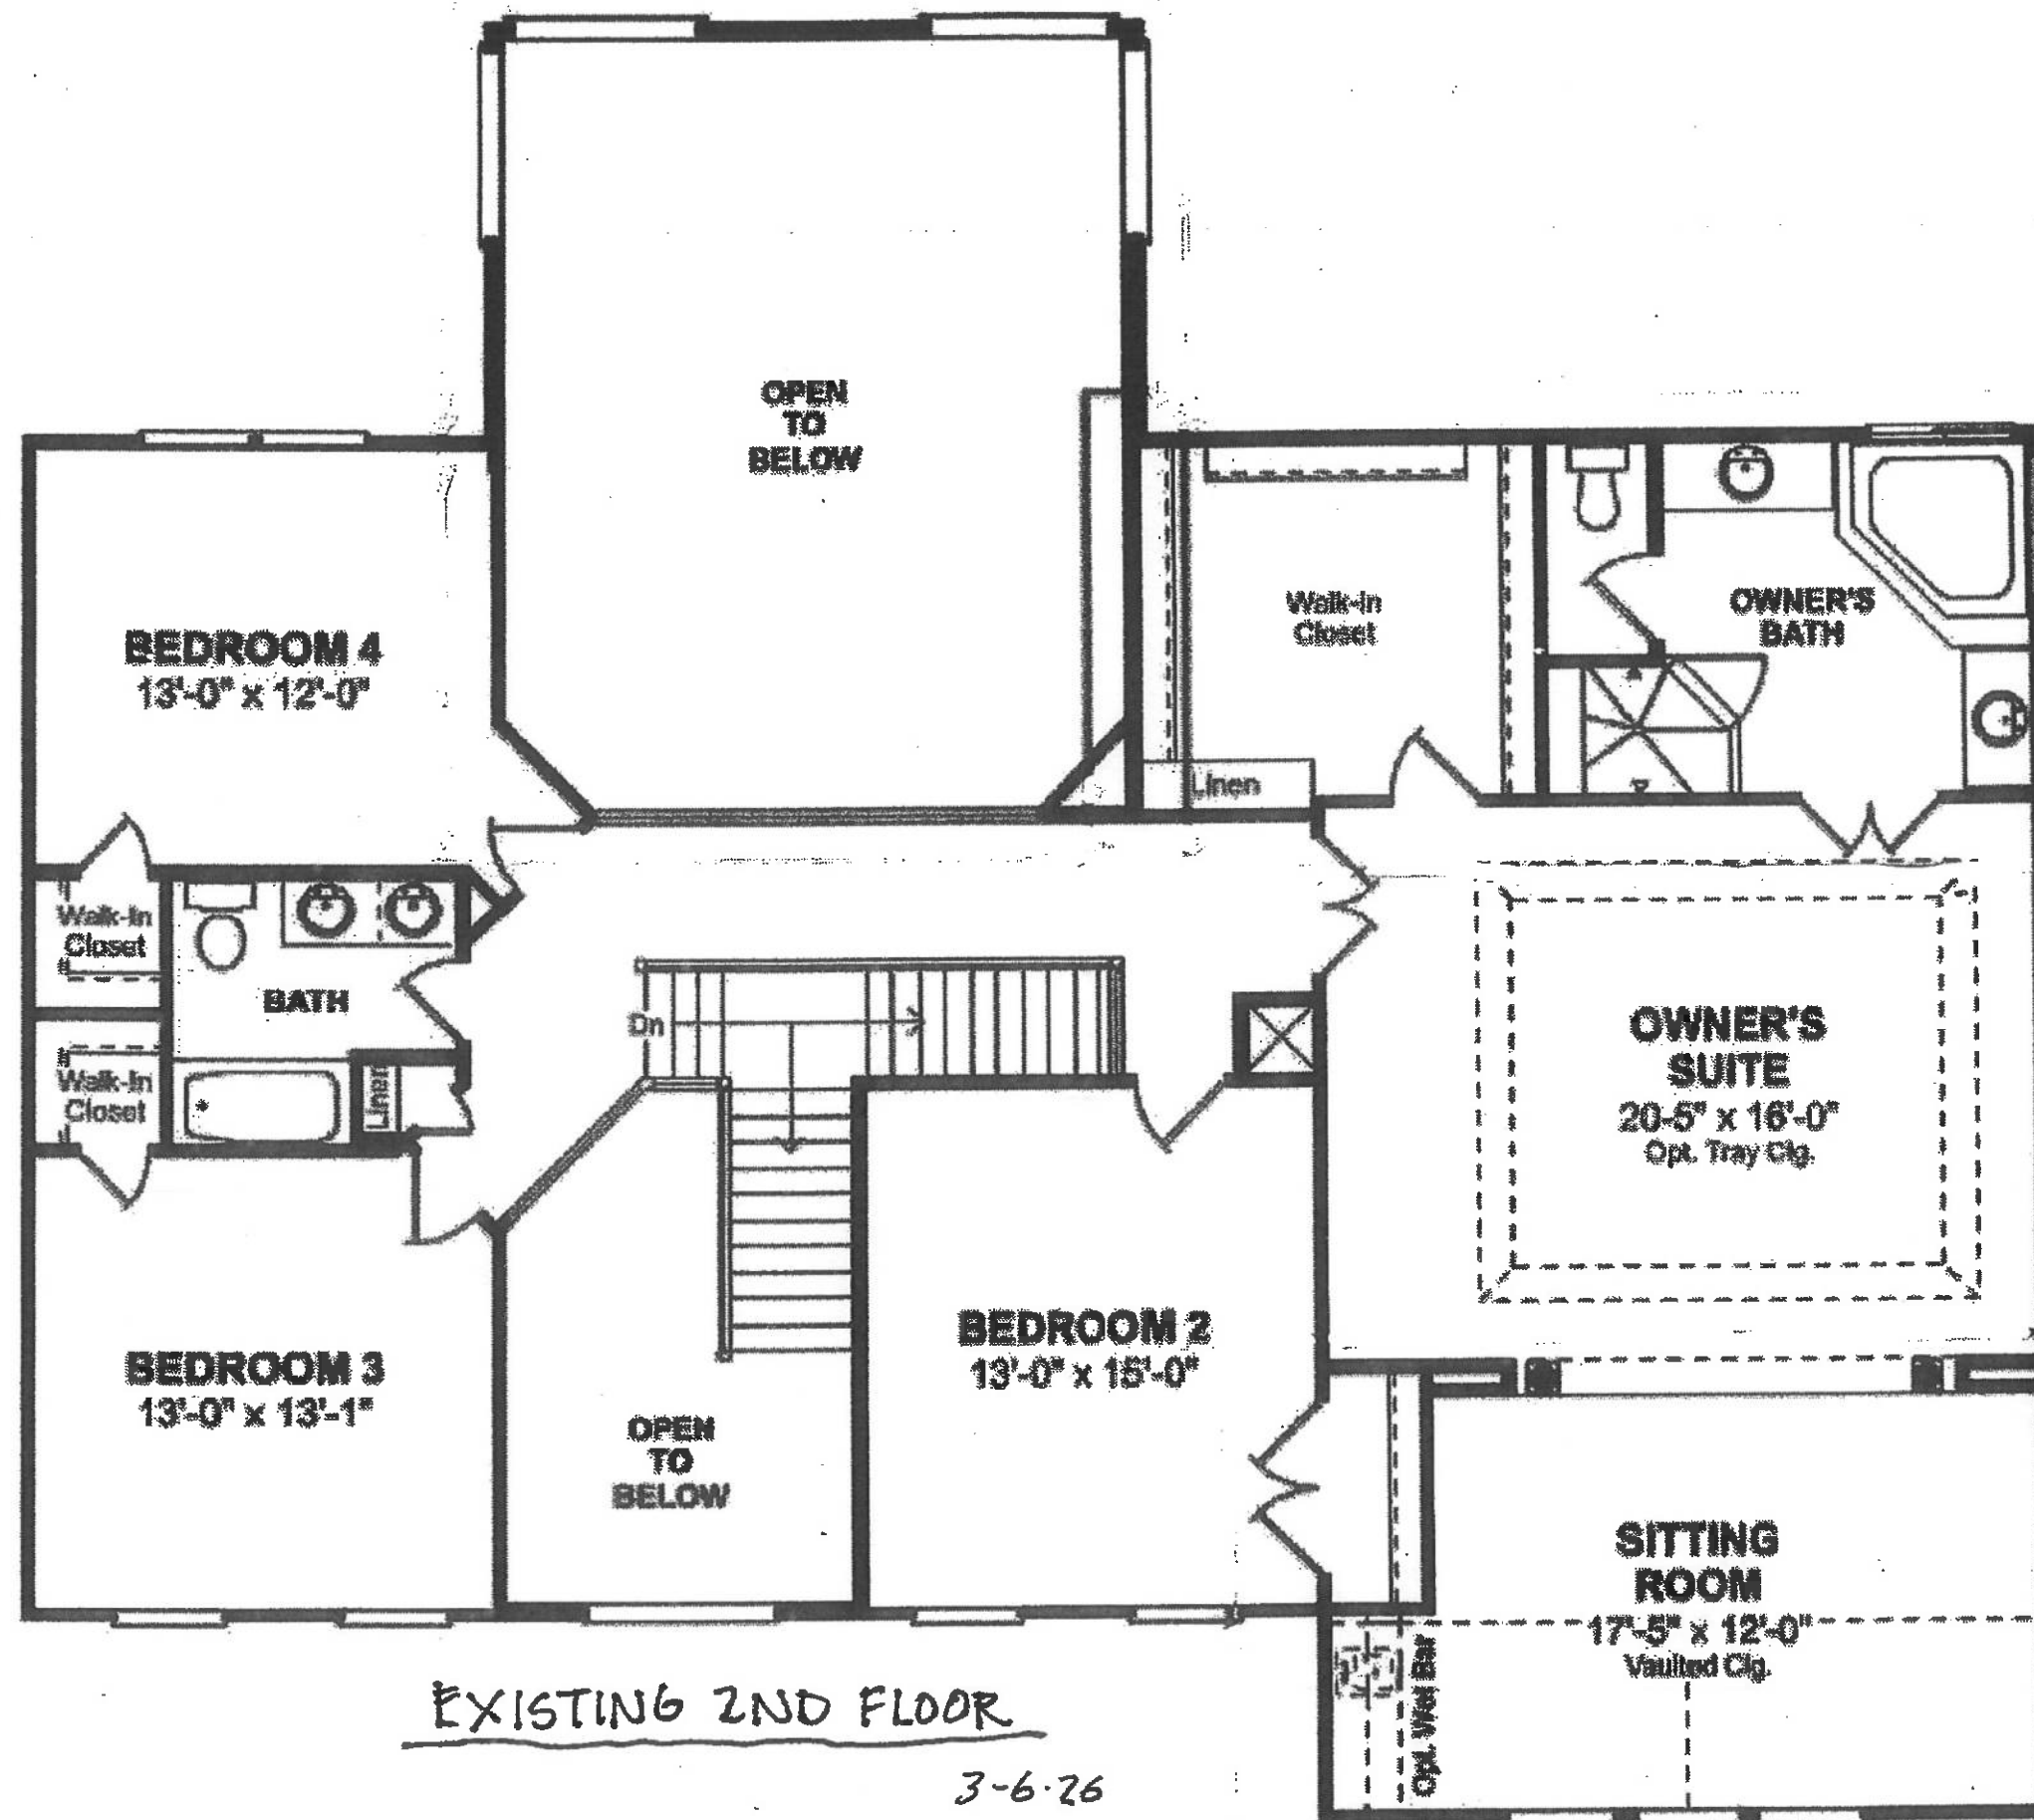


EXISTING 2ND FLOOR

3-6-26

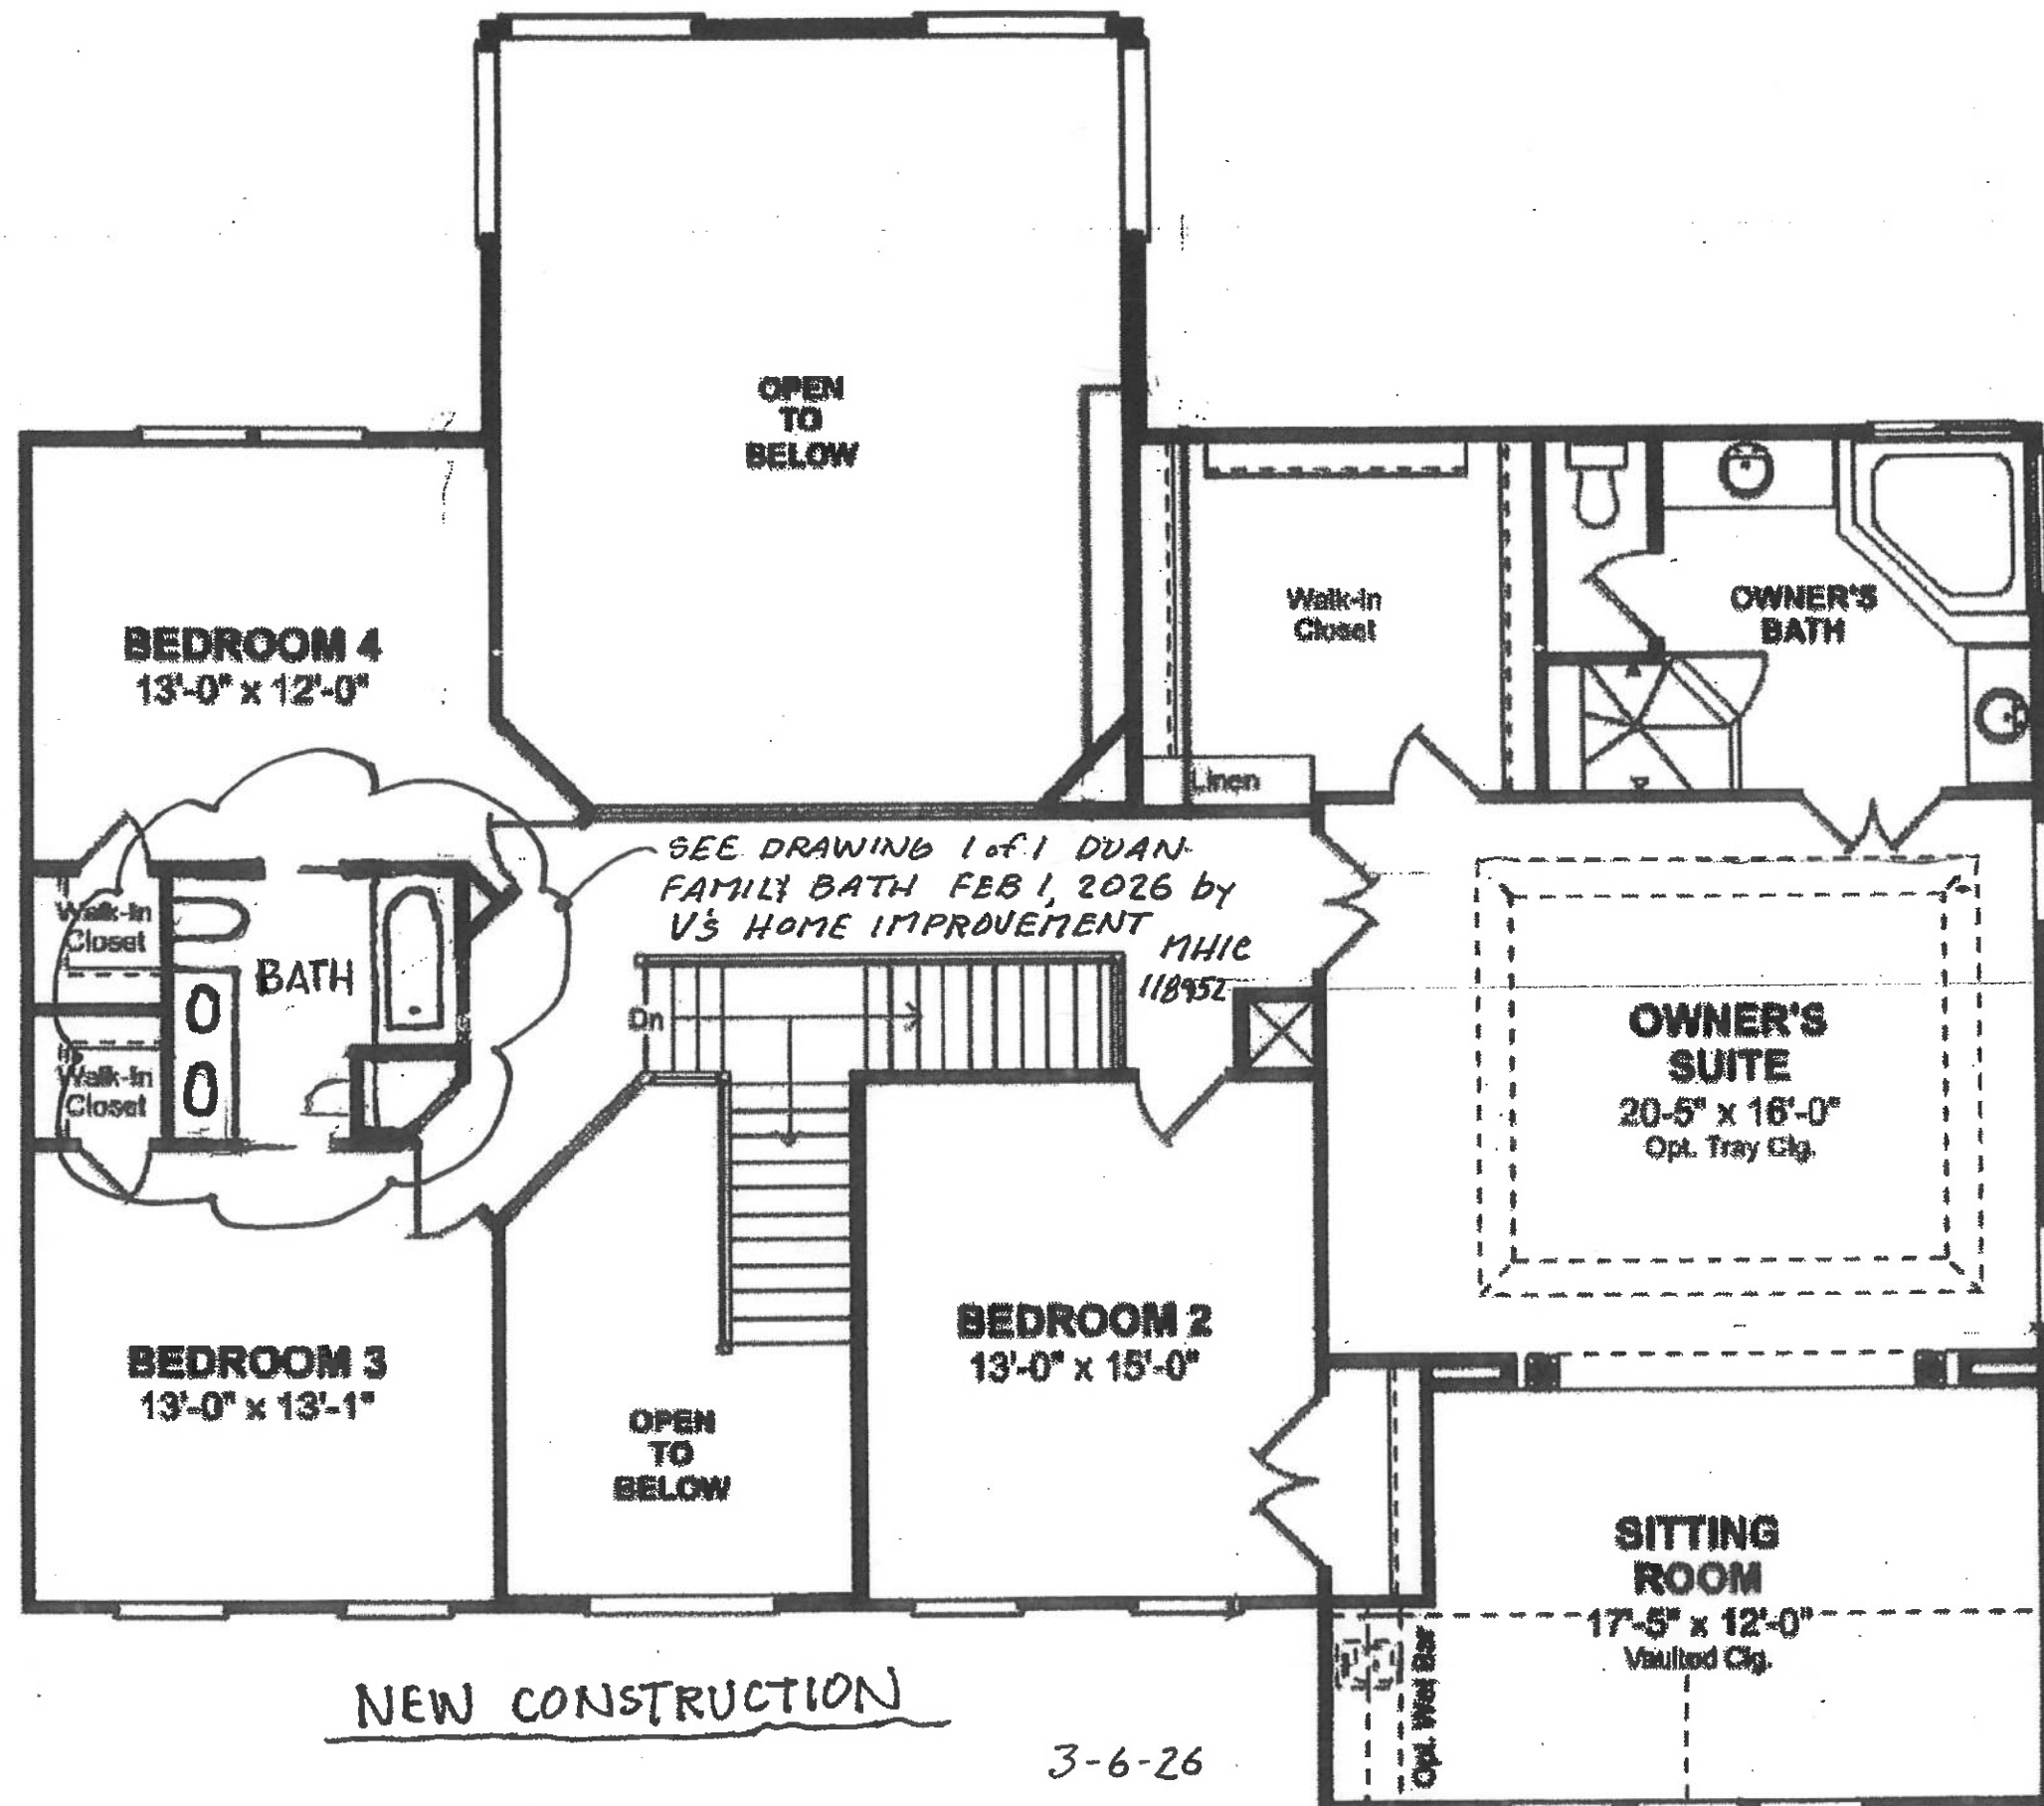

3-6-26

NOT TO SCALE

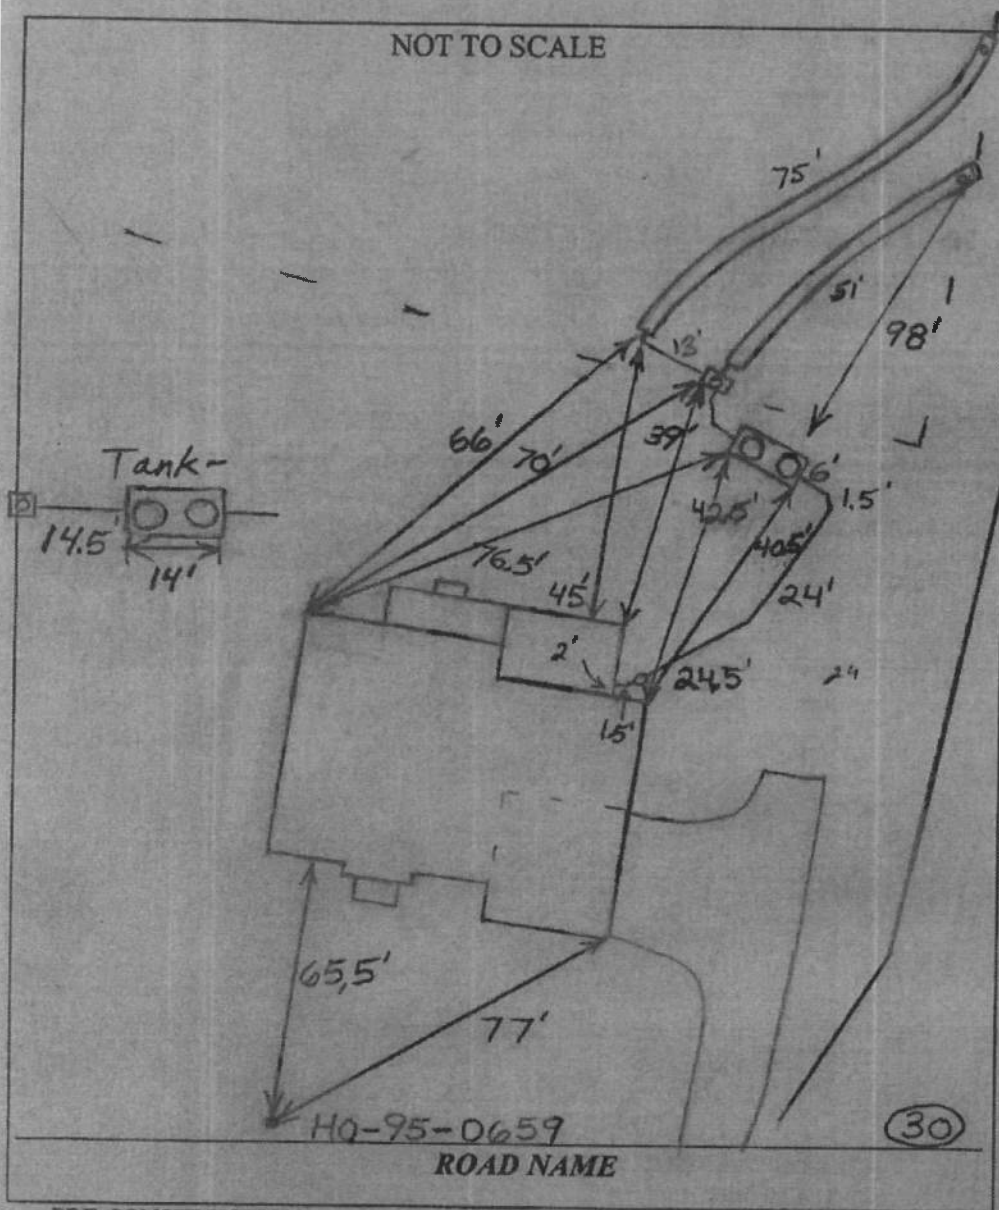

TRENCH/DRAINFIELD DATA

WIDTH INLET BOTTOM
3' 4.5' 6.5'

NUMBER OF TRENCHES 2

TOTAL LENGTH 130'

ABSORPTION AREA 390' ^{LOW}

DISTRIBUTION BOX LEVEL Levelers

DISTRIBUTION BOX BAFFLE Yes

DISTRIBUTION BOX PORT Yes

SEPTIC TANK DATA

SEPTIC TANK 1 LEVEL Yes

MANUFACTURER Mayer Bros.

CAPACITY 2000 GAL

SEAM LOC Top

TANK LID DEPTH 1'-2.5'

BAFFLES Yes

BAFFLE FILTER No

MANHOLE LOC Front + Rear

6" PORT LOC None

WATERTIGHT TEST No

SLOTTED Yes

DATE ON LID Dry

~~RUMP/SEPTIC TANK LEVEL N/A~~

~~MANUFACTURER~~

~~CAPACITY GAL~~

~~SEAM LOC~~

~~TANK LID DEPTH~~

~~BAFFLES~~

~~BAFFLE FILTER~~

~~MANHOLE LOC~~

~~6" PORT LOC~~

~~WATERTIGHT TEST~~

~~SLOTTED~~

~~DATE ON LID~~

PRE-CONSTRUCTION:

2/14/2013 No wall check in file. Install a 50' and a 75' trench on contour as high as possible in the septic easement. O.K. to put the septic tank in the very top of the easement. (BB)

INSTALLATION: 2/22/13 Trenches complete. per layout inspection. Done at Tank hole dig. No plumbing to house installed. OK to continue (PW)

2/25/2013 Plumbing to house installed except for hole through wall. (BB)

3/5/2013 House connection made. (BB)

FINAL INSPECTOR B. Baker DATE OF APPROVAL 3/5/2013

Septic Tank 3/19/2026



Well 3/19/2026



OSTS 3/17/2026

