

Name: Victor Glazov

Street Address: 122858 Howard Lodge Dr

City, State, Zip: Sykesville, MD, 21784

Date: 07/21/2025

Approved Mark
8/15/25

Amendment, Permit # B24003600

Ms. Debbie Whalen
Division of Plan Review
Department of Inspections, Licenses and Permits
Howard County Government
3430 Court House Dr
Ellicott City, MD 21043

Dear Ms. Whalen:

I am requesting to amend Permit # B24003600 at
12285 Howard Lodge Dr to
to support Hut Tub placed on top of the deck we are adding dual 2x10 joists in the section
~~under hot tub. Joists are going over three dual 2x10 girders.~~
Electric inspection will be done for hut tub electric wiring

Enclosed:

- ☐ Fee: _____
☒ Plot Plans
☒ Sets of Construction Drawings
☐ Other: _____

If there is anything we can do to assist you, please let me know.

Sincerely,

Victor Glazov

Name: Victor Glazov

Title: _____

Phone: 484-319-8094


Email: viktarhl@yahoo.com

1 cm = 2 ft


①

dual joists 2x10 over girder (dual 2x10)

Hot tub

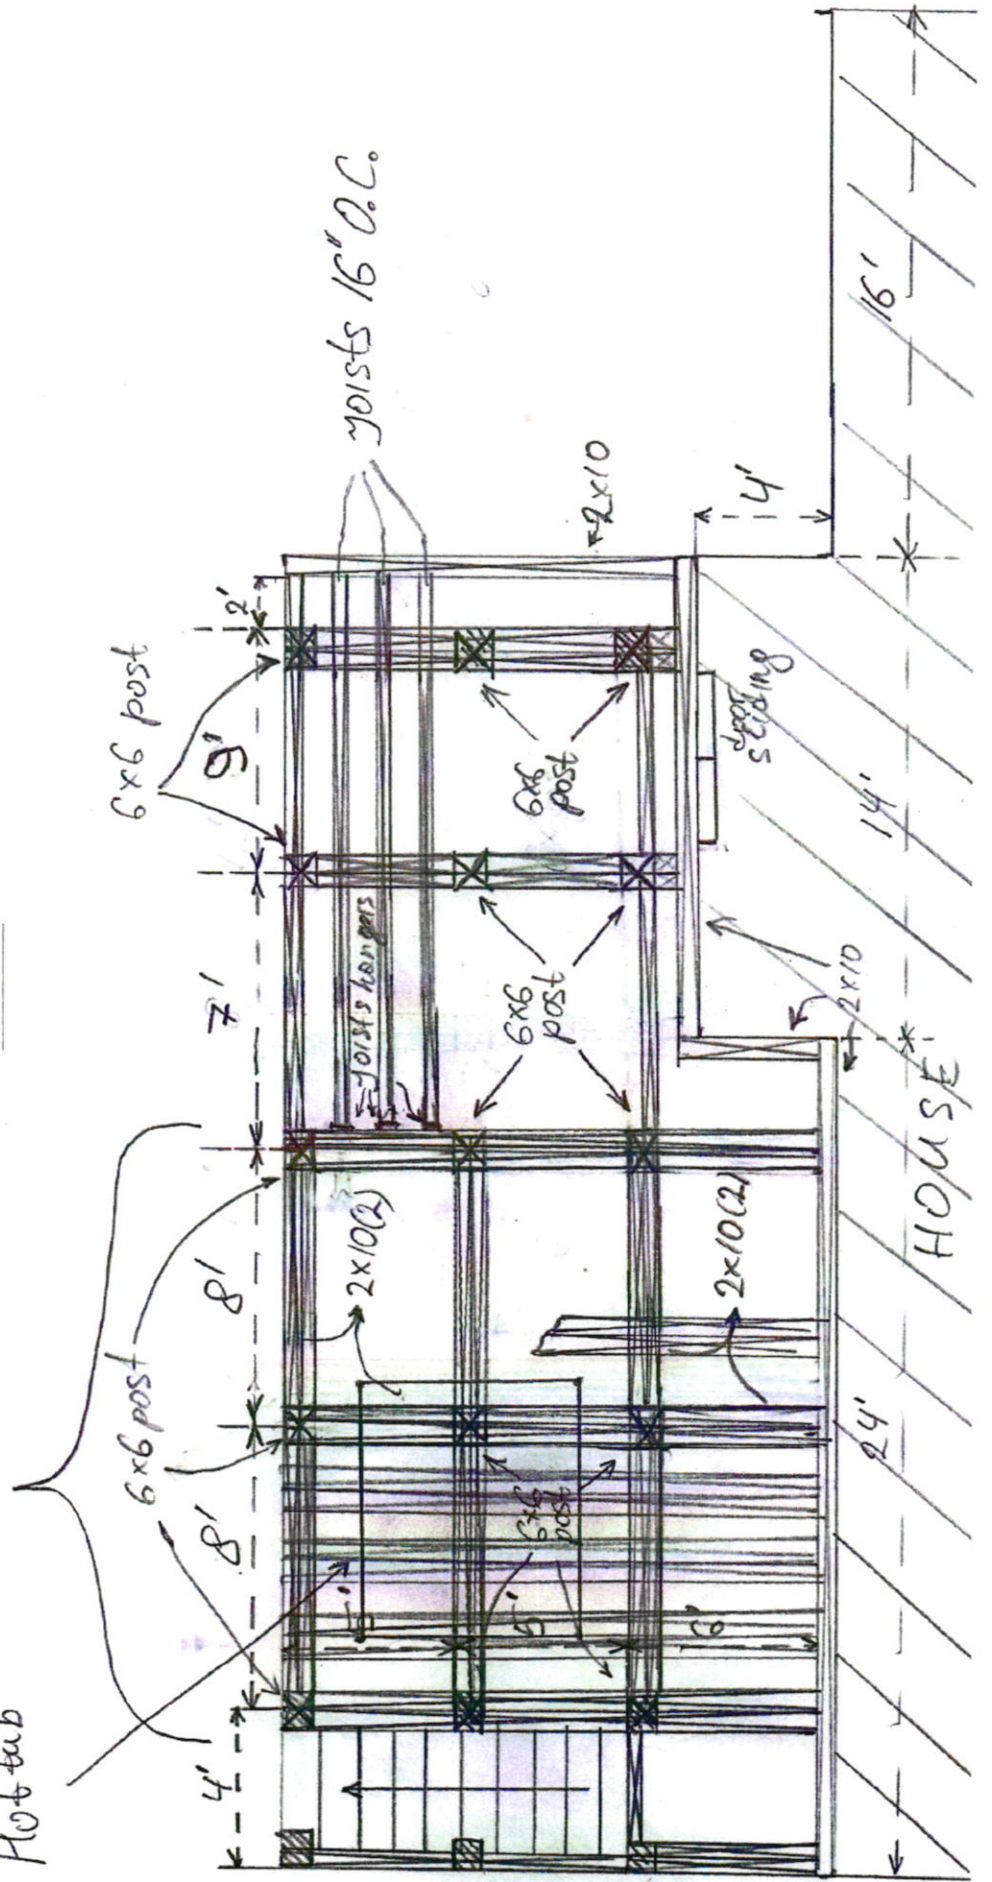

8

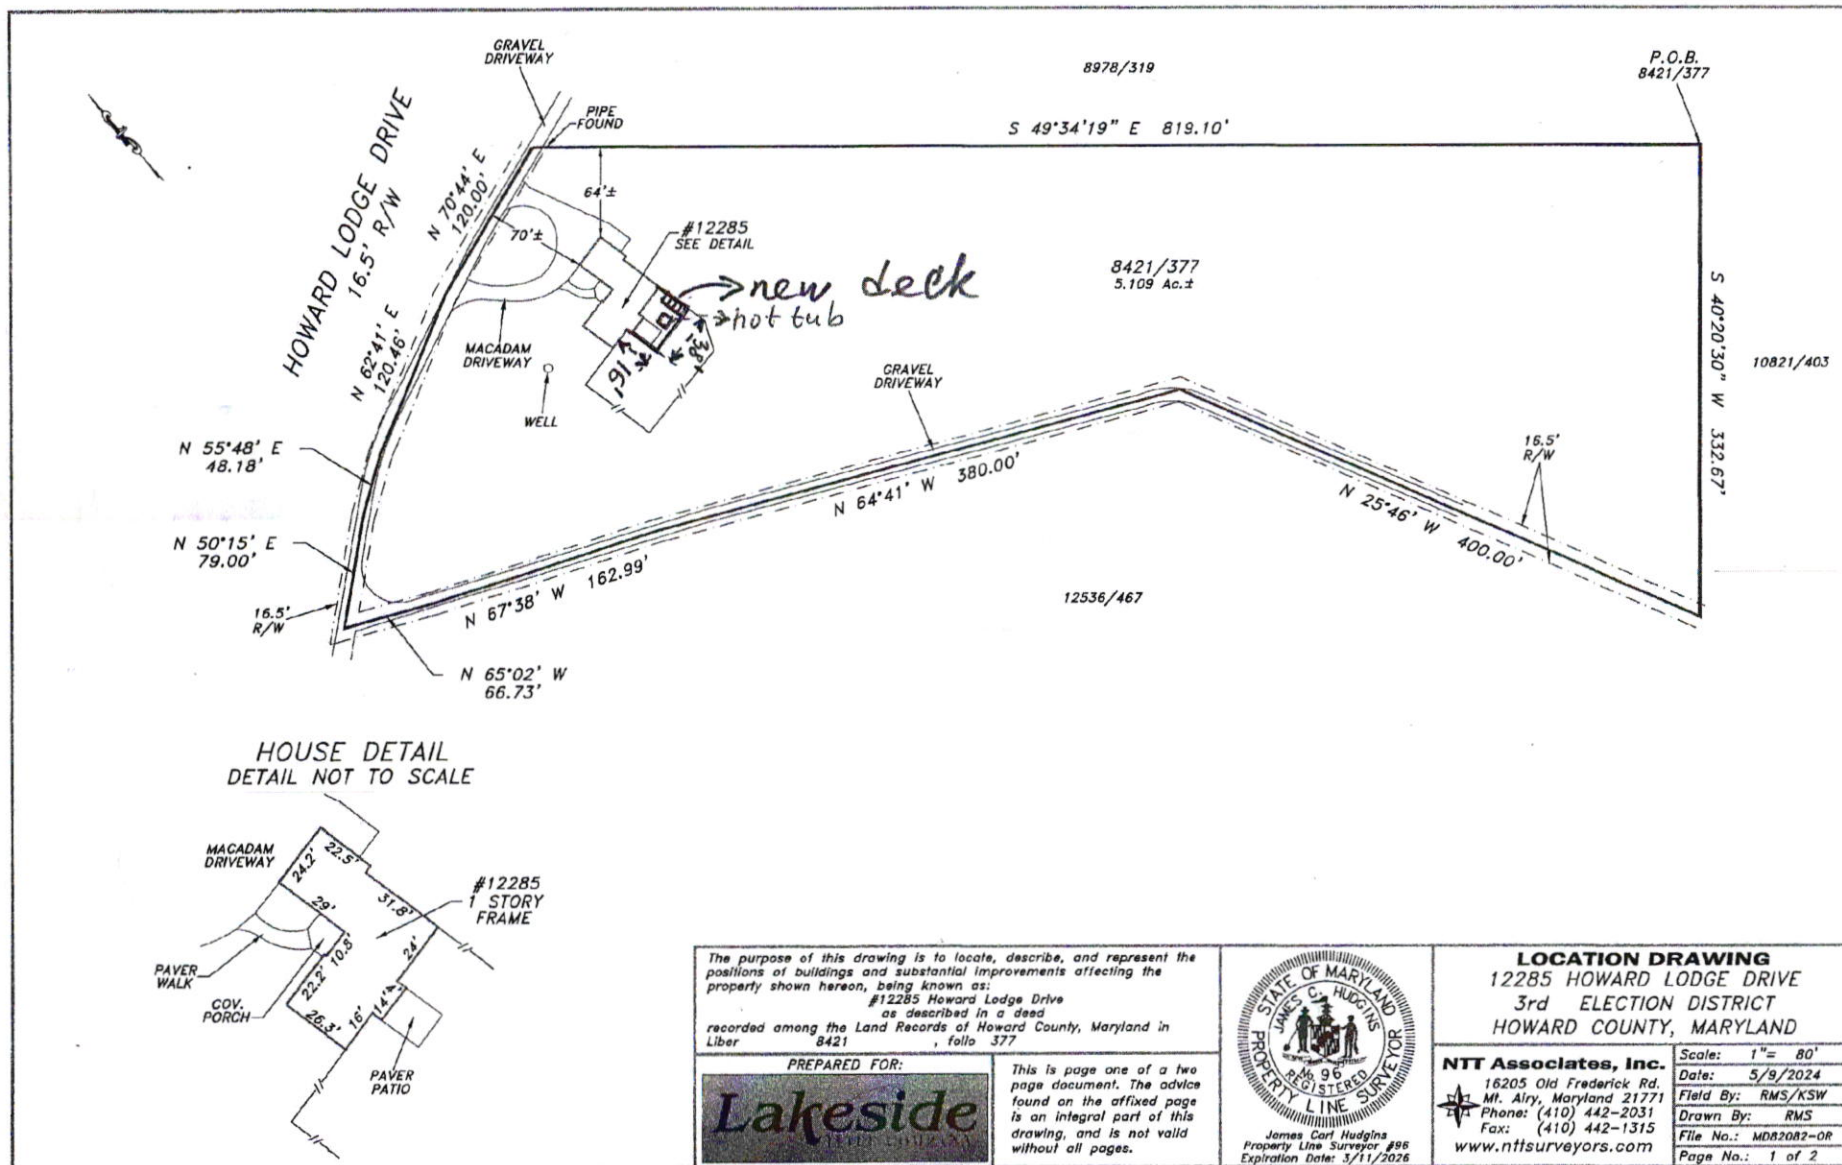

The purpose of this drawing is to locate, describe, and represent the positions of buildings and substantial improvements affecting the property shown hereon, being known as:
#12285 Howard Lodge Drive
as described in a deed
recorded among the Land Records of Howard County, Maryland in
Liber 8421, folio 377

PREPARED FOR:

Lakeside
REAL ESTATE

This is page one of a two page document. The advice found on the affixed page is an integral part of this drawing, and is not valid without all pages.




James Carl Hudgins
Property Line Surveyor #96
Expiration Date: 3/11/2026

LOCATION DRAWING
12285 HOWARD LODGE DRIVE
3rd ELECTION DISTRICT
HOWARD COUNTY, MARYLAND

NTT Associates, Inc.
16205 Old Frederick Rd.
Mt. Airy, Maryland 21771
Phone: (410) 442-2031
Fax: (410) 442-1315
www.nttsurveyors.com

Scale: 1" = 80'
Date: 5/9/2024
Field By: RMS/KSW
Drawn By: RMS
File No.: MDR2082-OR
Page No.: 1 of 2

* pump & abandon existing Pwell
 * 5 ft elevation drop between tank & fields
 * probe existing drain fields functioning properly at this time

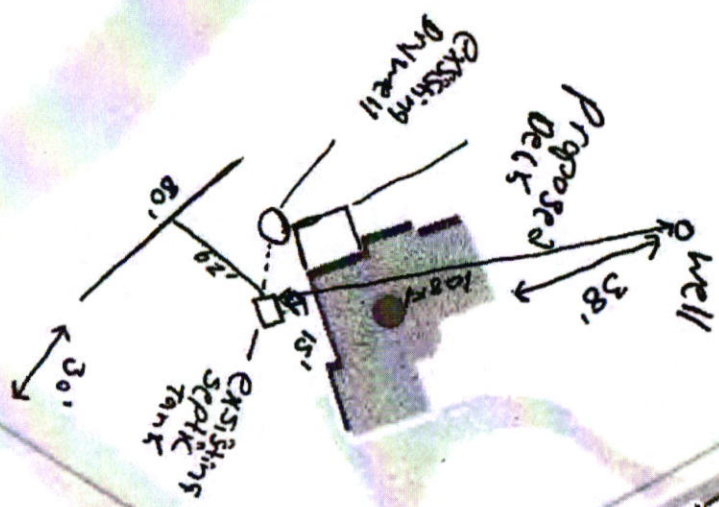


Installer
 Jet Septic inc
 440 bear branch rd
 Westminster MD, 21157
 Home owner
 Viktar hiazu
 12285 Howard Lodge Dr
 Sykesville MD 21784
 3 bedrooms

* Trench detail
 1 Trench
 2 ft wide
 80 ft long
 11 ft depth
 6" gravel depth

Approved Septic System Plan
 Howard County Health Department
 Signature
 Date 11/18/2021

NOT TO SCALE

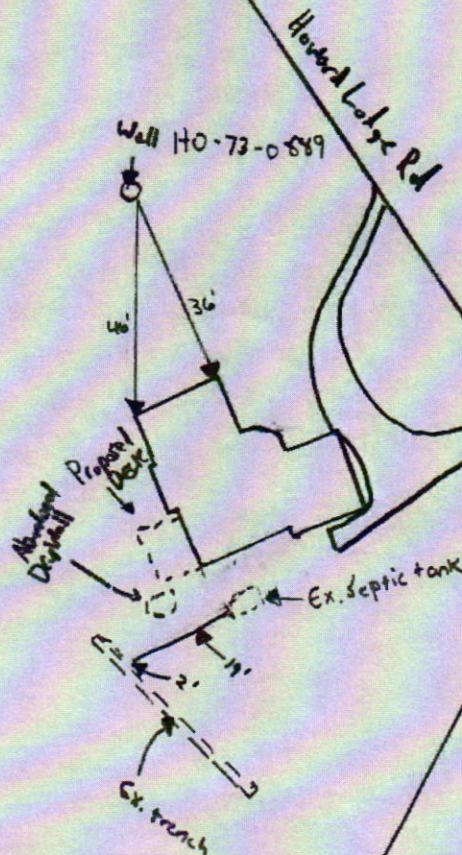

ROAD NAME

TRENCH/DRAINFIELD DATA

WIDTH Ex.	INLET Ex.	BOTTOM Ex.
NUMBER OF TRENCHES		
TOTAL LENGTH		
ABSORPTION AREA		
DISTRIBUTION BOX LEVEL		
DISTRIBUTION BOX BAFFLE		
DISTRIBUTION BOX PORT		

SEPTIC TANK DATA

SEPTIC TANK 1 LEVEL Ex.

MANUFACTURER _____

CAPACITY _____ GAL

SEAM LOC _____

TANK LID DEPTH _____

BAFFLES _____

BAFFLE FILTER _____

MANHOLE LOC _____

6" PORT LOC _____

WATERTIGHT TEST _____

SLOTTED _____

DATE ON LID _____

PUMP/SEPTIC TANK LEVEL _____

MANUFACTURER _____

CAPACITY _____ GAL

SEAM LOC _____

TANK LID DEPTH _____

BAFFLES _____

BAFFLE FILTER _____

MANHOLE LOC _____

6" PORT LOC _____

WATERTIGHT TEST _____

SLOTTED _____

DATE ON LID _____

SEPTIC CONTRACTOR ONSITE INSTALLING SYTEM: Charles Garrett III
 SEPTIC CONTRACTOR ONSITE LICENSED WITH THE STATE OF MD: YES NO

PRE-CONSTRUCTION NOTES:

11/18/2024 - Design plan approved. Permit released SP

CONTROL PANEL DATA

CONTROL PANEL HEIGHT (MIN 30") _____

INSPECTION DATE _____

INSPECTION: PASS/FAIL (CIRCLE ONE)

INSTALLATION NOTES:

11/21/2024 Contractor on site. They pumped, crushed, and abandoned the old drywell. Installed a 19' and 2' pipe connecting the septic tank to the existing trench. Contractor scoped the current trench and stated it is dry and in good condition. Asked contractor to back part of the pipe. OK to backfill. MB/SP

FINAL INSPECTOR M. Burns/S. Page DATE OF APPROVAL 11/21/2024

Eshenbaugh, Melanie

From: Viktor Hlazau <viktarhl@yahoo.com>
Sent: Friday, August 15, 2025 6:16 PM
To: Eshenbaugh, Melanie
Subject: Re: B24003600

WARNING!!!

This email originated from someone outside of Howard County
DO NOT CLICK LINKS OR OPEN ATTACHMENTS
unless you recognize the sender and know for sure that the content is safe

Thank you Melanie! Have a great weekend!
Sent from my iPhone

On Aug 15, 2025, at 14:18, Eshenbaugh, Melanie <MEshenbaugh@howardcountymd.gov> wrote:

Thank you for clarifying. I have given HD approval in the online portal. Hope you have a nice weekend.

Melanie Eshenbaugh
Bureau of Environmental Health
Howard County Health Dept.
8930 Stanford Blvd. Columbia, MD 21045
www.hchealth.org

<image001.png>

CONFIDENTIALITY NOTICE

This message and the accompanying documents are intended only for the use of the individual or entity to which they are addressed and may contain information that is privileged, confidential, or exempt from disclosure under applicable law. If the reader of this email is not the intended recipient, you are hereby notified that you are strictly prohibited from reading, disseminating, distributing, or copying this communication. If you have received this email in error, please notify the sender immediately and destroy the original transmission.

From: Viktor Hlazau <viktarhl@yahoo.com>
Sent: Thursday, August 14, 2025 11:27 PM
To: Eshenbaugh, Melanie <MEshenbaugh@howardcountymd.gov>
Subject: Re: B24003600

WARNING!!!

This email originated from someone outside of Howard County
DO NOT CLICK LINKS OR OPEN ATTACHMENTS

Hi Melanie,
No changes to deck posts.
Only change to joists and girders.
- Joists were reinforced (double joists).
- Direction of girders was changed to improve the support under hot tub.
- The deck is built now and includes hot tub.
Thank you
Victor

Sent from my iPhone

On Aug 14, 2025, at 16:20, Eshenbaugh, Melanie
<MEshenbaugh@howardcountymd.gov> wrote:

Hi Viktor,

I just spoke with Jeff about this, and we wanted to confirm whether any additional deck posts were to be added or if it's just the joists & girders to support the area under the hot tub? The deck I assume is constructed now with the amendment to include the hot tub. Please let me know and thank you.

Melanie Eshenbaugh
Bureau of Environmental Health
Howard County Health Dept.
8930 Stanford Blvd. Columbia, MD 21045
www.hchealth.org

<image001.png>

CONFIDENTIALITY NOTICE

This message and the accompanying documents are intended only for the use of the individual or entity to which they are addressed and may contain information that is privileged, confidential, or exempt from disclosure under applicable law. If the reader of this email is not the intended recipient, you are hereby notified that you are strictly prohibited from reading, disseminating, distributing, or copying this communication. If you have received this email in error, please notify the sender immediately and destroy the original transmission.

From: Viktor Hlazau <viktarl@yahoo.com>
Sent: Thursday, August 14, 2025 2:00 PM
To: Eshenbaugh, Melanie <MEshenbaugh@howardcountymd.gov>
Subject: Re: B24003600

WARNING!!!

This email originated from someone outside of Howard County

*****DO NOT CLICK LINKS OR OPEN
ATTACHMENTS*****

unless you recognize the sender and know for sure that the content is safe

Thank you Melanie,
I just wanted to check in. I didn't receive any updates yet, the application has been with
Health Department since 28 July
Thank you for looking into this.
Victor
484-319-8094

On Monday, August 11, 2025 at 12:32:32 PM EDT, Eshenbaugh, Melanie
<meshenbaugh@howardcountymd.gov> wrote:

Good afternoon Viktor,

I will look into this for you and provide you with a response soon. Thank you.

Melanie Eshenbaugh

Bureau of Environmental Health

Howard County Health Dept.

8930 Stanford Blvd. Columbia, MD 21045

www.hchealth.org

<image001.png>

CONFIDENTIALITY NOTICE

This message and the accompanying documents are intended only for the use of the individual or entity to which they are addressed and may contain information that is privileged, confidential, or exempt from disclosure under applicable law. If the reader of this email is not the intended recipient, you are hereby notified that you are strictly prohibited from reading, disseminating, distributing, or copying this communication. If you have received this email in error, please notify the sender immediately and destroy the original transmission.

From: Viktor Hlazau <viktarhl@yahoo.com>
Sent: Friday, August 8, 2025 3:07 PM
To: Eshenbaugh, Melanie <MEshenbaugh@howardcountymd.gov>
Subject: Re: B24003600

WARNING!!!

This email originated from someone outside of Howard County

*****DO NOT CLICK LINKS OR OPEN
ATTACHMENTS*****

unless you recognize the sender and know for sure that the content is safe

Hi Melanie,

I hope you are doing well and had a great summer.

I think my amendment on B24003600 is now pending with Health Department. Could you please check.

Thank you

Victor