

Menu Save Reset Cancel Help

Record Detail * (This section is required.)

Permit Type	Permit Number	Opened Date
Building/Residential/Misc/Tanks	B25004290	09/30/2025

Description of Work

SFD/ Install (1)120 gal ABOVE GROUND propane tank under elevated deck to supply existing gas logs and stove.

[check spelling](#)

Address * (This section is required.)

Search Reset Clear Get Parcel & Owner

Street #	Street Name	Street Type
14084	BARBARA	CIR
Unit Type	Unit #	X Coordinate
--Select--		-77.00182
		Y Coordinate
		39.32367
City	State	Zip Code
COOKSVILLE	MD	21723
	Primary	
	Yes	

Approved 10/16/25

[Signature]

Parcel * (This section is required.)

Search Reset Clear Get Address & Owner

GIS ID *	Parcel	Parcel Area	Land Value	Improved Value	Exemption Value	Plan Area
908633	203	1.13	186300	416300	230000	RURAL

Legal Description
IMPSLOT 6[]14084 BARBARA CIR[]WOODBINE

[check spelling](#)

Block	Lot	Census Tract	Council Dist	Inspection Dist	Supervisor Dist	Map #	DAP Zone
	6	605601	5				
Plan Area	State Tax Id	Subdivision Name					
	1404314964	VILLA MONTICELLO SECTIO					
Section	Area	Tax Map					
		8					
Grid	Zoning District	ADC Map					
8-24	RC-DEO	4692-K9					
SDP No.	Final Plan No.	WP File No.					
Record Plat No.	WS Contract No.	FDP No.					
67							
Owner Occupied	Year Built	Historic District					
☐ Yes ☐ No	1974	☐ Yes ☒ No					
Historic District Registry No.	Stat Area	Flood Plain					
	4-03	☐ Yes ☒ No					
Building No							

Primary

Yes

Owner * (This section is required.)

Search Reset Clear

Name *

SMITH

Address Line 1

14084 BARBARA CIR

Address Line 2

Address Line 3

Mail City

COOKSVILLE

Mail State

MD

Mail Zip Code

21723

Phone

410-409-5847

Primary

Yes

E-mail

Cell Number

Fax Number

Professionals *(This section is not required.)*

License # *

Business Name

License Type *

--Select--

First Name

Middle Name

Last Name

Primary

Yes

Address Line 1

Address Line 2

City

State

ZIP Code

Phone 1

Phone 2

Fax

E-mail

Applicant *(This section is not required.)*

Search

As Owner

As Lic. Prof

As Contact

Type *

Applicant

First Name

Franklin

MI

Edward

Last Name

Winn

Relationship

--Select--

Full Name

Franklin Edward Winn

Primary

Yes

Organization Name

Ferrellgas

Street Address

3601 Francis Scott Key Hwy

Address Line 2

City

Taneytown

State

MD

Zip Code

21787

Phone

240-772-6899

Cell

Fax

E-mail *

Frankwinn@ferrellgas.com

Addtl Info

Est Construction Cost *

1000

Housing Units *

0

Number of Buildings * Public Owned

0

No

Construction Type

--Select--

TANK INFORMATION

RESIDENTIAL TANK INFORMATION

Capital Project-No Fee *

☐ Yes ☐ No

Capital Project Number

(Text)

Fee Exempt *

☐ Yes ☐ No

Roadside Tree Project Permit *

☐ Yes ☒ No

Roadside Tree Permit

(Text)

Existing Use *

SFD

Number of Tanks Installed *

1


Number of Tanks Removed *

(Number) 0

(Number)

Barbara Circle

Monticello Drive

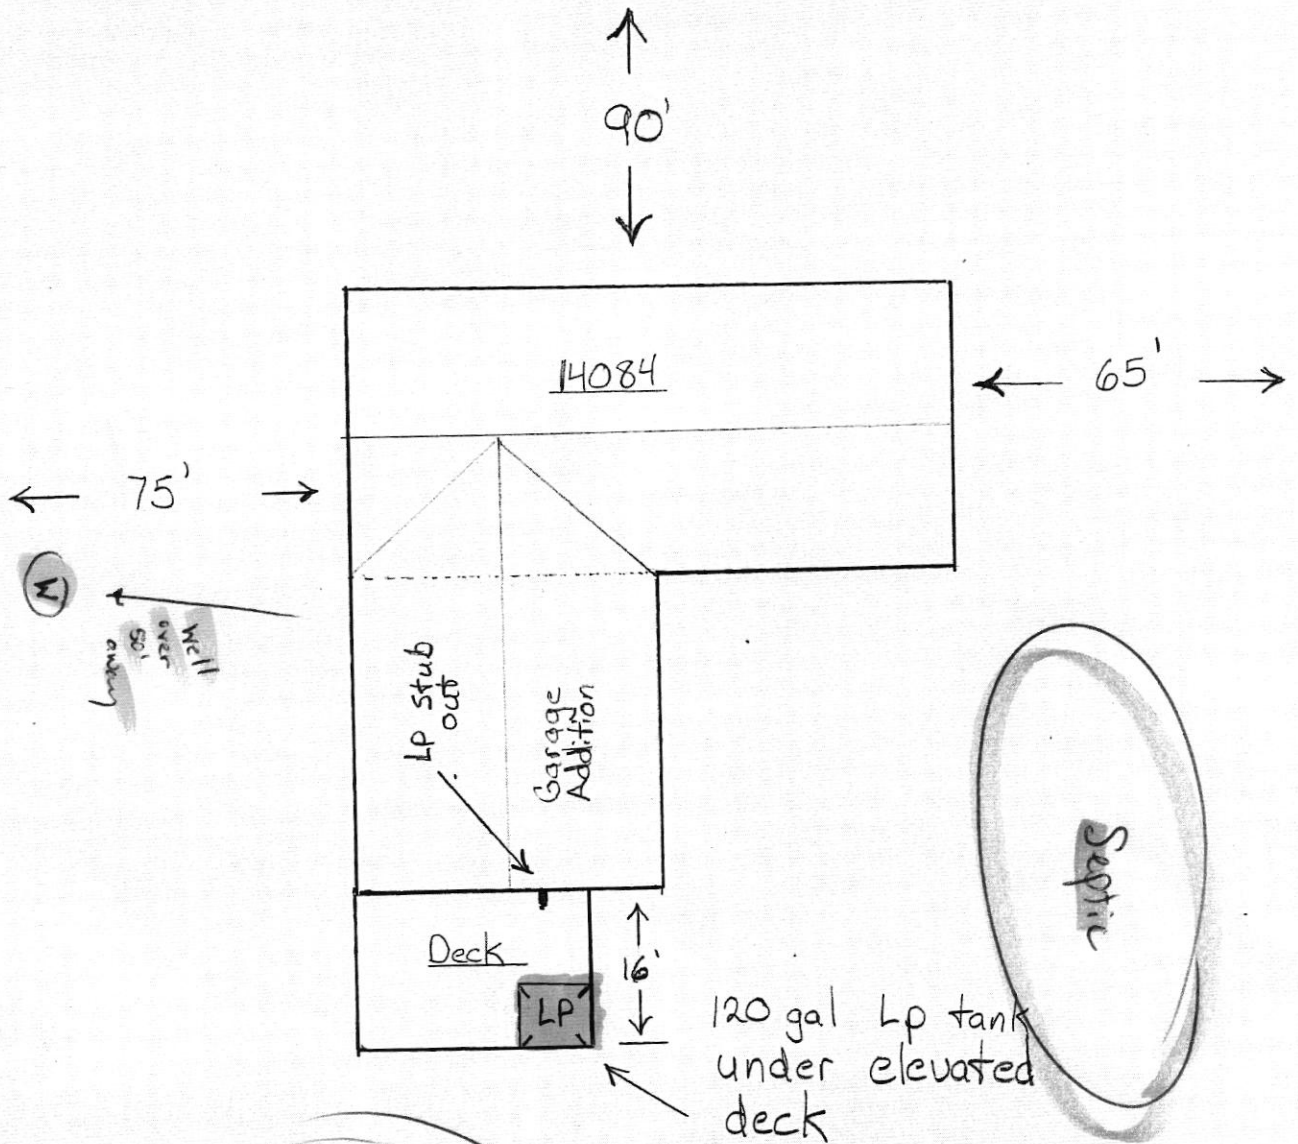

Approved for LP tank
B25004290

[Signature] 10/16/25

Jeff Smith
14084 Barbara Circle
Cookeville Md 21723.



STEEL TANKS & CYLINDERS FOR LP GAS SYSTEMS



100 LB
(POL VALVE)
1428




100 LB
(MULTI-VALVE)
1436



28.6 GALLON ASME
Manchester's 'MINI'
68143



57 GALLON ASME
6765.11
200 LB DOT
14205TC.11

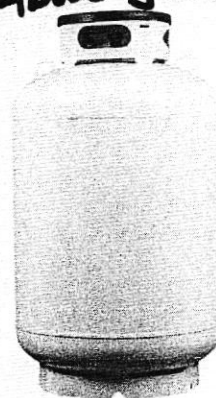

118 GALLON ASME
6762.11
420 LB DOT
1499TC.11

118 gal
Above ground.

STANDARD

SIZE (LB)
LPG CAPACITY (GAL)
WATER CAPACITY (LB)
OVERALL HEIGHT (IN)
BODY HEIGHT (IN)
CYLINDER DIAMETER (IN)
BASE DIAMETER (IN)
TARE WEIGHT (LB)
STANDARDS SPECIFICATION
VALVE
SIGHT GAUGE
COLOR
PALLET QUANTITY

DOT	100 LB	200 LB	420 LB
22.9	22.9	45.6	95.9
238	238	476	1000
46.6	46.6	41.9	53.8
41	41	34.1	45.6
15.1	15.1	24	30
14	14	20	23.1
71	71	152	278
48W240	48W240	48W240	48W240
POL	POL	CGA-510	CGA-510
(VAPOR OR LIQUID)	(VAPOR OR LIQUID)		
MULTI-VALVE	MULTI-VALVE		
N/A	N/A	YES	YES
DOT-GRAY / TC-WHITE	DOT-GRAY / TC-WHITE	WHITE	WHITE
18	18	16	9

ASME

28.6 GAL "MINI"	57 GAL	118 GAL
22.9	45.6	95.9
28.5 GAL	57 GAL	118 GAL
37.1	41.9	53.8
29.8	34.1	45.6
18	24	30
15.5	20	23.1
85	188	291
ASME	ASME	ASME
CGA-510	CGA-510	CGA-510
YES	YES	YES
WHITE	WHITE	WHITE
20	16	9

METRIC

SIZE (LB)
LPG CAPACITY (L)
WATER CAPACITY (KG)
OVERALL HEIGHT (MM)
BODY HEIGHT (MM)
CYLINDER DIAMETER (MM)
BASE DIAMETER (MM)
TARE WEIGHT (KG)
STANDARDS SPECIFICATION
VALVE
SIGHT GAUGE
COLOR
PALLET QUANTITY

DOT	100 LB	200 LB	420 LB
87	87	172.9	363
108	108	216	450
1184	1184	1064	1366
1041	1041	865	1159
383	383	610	762
356	356	508	587
31.8	31.8	85.3	126.1
48W240	48W240	48W240	48W240
POL	POL	CGA-510	CGA-510
(VAPOR OR LIQUID)	(VAPOR OR LIQUID)		
MULTI-VALVE	MULTI-VALVE		
N/A	N/A	YES	YES
DOT-GRAY / TC-WHITE	DOT-GRAY / TC-WHITE	WHITE	WHITE
18	18	16	9

ASME

28.6 GAL "MINI"	57 GAL	118 GAL
86.6	172.9	363
108.3	216	450
942	1064	1366
756	865	1159
457	610	762
394	508	587.0
38.6	85.3	132.0
ASME	ASME	ASME
CGA-510	CGA-510	CGA-510
YES	YES	YES
WHITE	WHITE	WHITE
20	16	9