

Menu Save Reset Cancel Help

Record Detail * (This section is required.)

Case

EH-PLANS-25-0

Type

EnvHealth/Environmental Health/Plan Check/Application

Status

In Review

Opened Date

09/23/2025

Single Entry Edit-View Record Form

Application Name

B25004022

Description

NOV/ SFD/ Remodel Interior of Main Level to include, Laundry Room, 1/2 Bathroom, Dining Area, Kitchen Island, Living Room TV center, and installation of shiplap and tile. CB250984

Total Invoiced

0.00

Total Paid

0.00

Balance

0.00

Assigned to Department Current Department

Well and Septic Progr

Assigned to Staff Current User

Zack Silvest

Address * (This section is required.)

New

Search

Delete

Set Primary

Online BP.

9/26/25

Approved RAC
9/30/2025

15600 Bushy Park

Parcel (This section is not required.)

Search

Delete

Get Address & Owner

Set Primary

Owner (This section is not required.)

Search

Delete

Set Primary

Applicant * (This section is required.)

Search

As Owner

As Lic. Prof

As Contact

Single Entry Applicant Form

Type *

Applicant

Primary

Yes

First Name *

Jack

Middle Name

Last Name *

league

Home Phone ((xxx)xxx-xxxx)

Organization Name *

Sunset Kitchen & Baths, LLC.

Mobile Phone ((xxx)xxx-xxxx)

(410) 744-4488

E-mail

infosunsetkb3@gmail.com

Business Phone ((xxx)xxx-xxxx)

Preferred Channel

--Select--

Applicant Address

New

Look Up

Deactivate

Remove

Custom Fields

DATE TRACKING

Received Date

9/23/2025

Due Date

10/7/2025

Dates to Complete

14
(Number)

Received by Food

Food Review Type

--Select--

Equipment Specification Sheets Submitted

Equipment Specification Sheet

Received by Community Hygiene

Received by Well and Septic

9/23/2025

FACILITY INFORMATION

Name of Business (dba) *

n/a (Text)

Associated Building Permit Number

(Text)

Owner Switch Date

Does the project include an Aquatic Facility such as a Public Pool? If Yes, forward to CH Program.

☐ Yes ☐ No

Does the project include Private Septic? If Yes, forward to WS Program.

☐ Yes ☐ No

Is this a Prototype Food Service Facility? If Yes, refer to State.

☐ Yes ☐ No

Facility Fax

(Text)

Days of Operation

(Text)

Does this project have a Building Permit?

☐ Yes ☐ No

Building Permit Issued Date

☐ Non-Profit

Does the project include Private Well? If Yes, forward to WS Program.

☐ Yes ☐ No

Does the project include Food Services? If Yes, forward to FP Program.

☐ Yes ☐ No

Facility Phone

(Text)

Facility Email

(Text)

PROPERTY INFORMATION

Water Source

--Select--

Sewage Disposal

--Select--

Design Wastewater Flow

(Number)

Permit Type

--Select--

DEVELOPMENT PLANS

Property Type

Residential

Signature Required

☐ Yes ☐ No

Number of paper copies

0
(Number)

Number of buildable lots created

0
(Number)

Total Number of Lots

0
(Number)

Plan Version

Initial

Engineer

0
(Text)

Number of mylar copes

0
(Number)

Number of non-buildable lots created

0
(Number)

Associated Plans

WELL AND SEPTIC INTERNAL

State Review Required

☐ Yes ☐ No

Coordinate State Review

☐ Yes ☐ No

Proposed Septic System Type

--Select--

FOOD ESTABLISHMENT FACILITY

Priority Assessment

--Select--

Licensed Type

--Select--

License Category

--Select--

FOOD ESTABLISHMENT INFORMATION

Hours of Operation

(Text)

If Operating Seasonally. What is the start month?

(Text)

☐ Operating Seasonally Only

Are pets allowed in a outdoor seating area?

☐ Yes ☐ No

Full Bar?

☐ Yes ☐ No

RESTAURANT AND FOOD SERVICE

Food Service Facility Secondary Category

--Select--

Total Seating Capacity

(Number)

Number of Restrooms

(Number)

Interior Restaurant Seating Capacity

(Number)

Bar Seating Capacity

(Text)

Outdoor Seating Capacity

(Text)

Does the restaurant have outdoor seating

☐ Yes ☐ No

EQUIPMENT

Evaluated non NSF, ANSI, CF or other standards

☐ Yes ☐ No

Description of Refrigeration Units

Number of Walk-In Refrigerator Units

(Number)

Description of Walk-In Freezer Units

(Text)

Is there a bulk ice machine available

☐ Yes ☐ No

Space Limitation

Number of Hand Sinks Available

(Number)

Hood System

(Text)

Ventless Equipment

(Text)

PLUMBING

Size and installation of the water heater?

(Text)

Is there a grease interceptor or grease trap?

--Select--

REFUSE AND RECYCLABLES

Dumpsters Located on a impervious surface?

--Select--

Will there be a grease receptacle?

--Select--

WAREWASHING DISHWASHING

Dishwashing Method

--Select--

HACCP

Plan Review Response Letter Received

☐ Yes ☐ No

Date HACCP Approved by the State

Date HACCP Plan Submitted

HACCP Plan Approved

HACCP Plan Review

Plan Review Letter Mailed

HACCP Plan Revision Submitted

HACCP Fee Type

--Select--

FINISHING SCHEDULE

Kitchen Floor / Bar Flooring

--Select--

Kitchen Cove Base

--Select--

--Select--

Storage - Food Storage Flooring

--Select--

Storage - Food Storage Cove

--Select--

--Select--

Utensil Washing Area Flooring

--Select--

Utensil Washing Area Cove

--Select--

--Select--

Dressing / Locker Room Flooring

--Select--

Dressing / Locker Room Cove

--Select--

--Select--

Toilet Area Flooring

--Select--

Toilet Area Cove

--Select--

--Select--

Walk-In Refrigerator Flooring

--Select--

Walk-in Refrigerator Cove

--Select--

--Select--

Kitchen Walls

--Select--

Utensil Washing Area Walls

--Select--

--Select--

Restroom Walls

Are Kitchen Ceilings tiles smooth non-fiberglass backing?


Proposed Changes1.2



- Reconfiguring Laundry, ½ Bathroom, and breakfast nook/dining area space for better functionality for the homeowner.

****Please see edits here to the location of new walls to create proposed layout.****

PLEASE SEE ATTACHED 2020 DESIGN LAYOUTS FOR EACH AREA

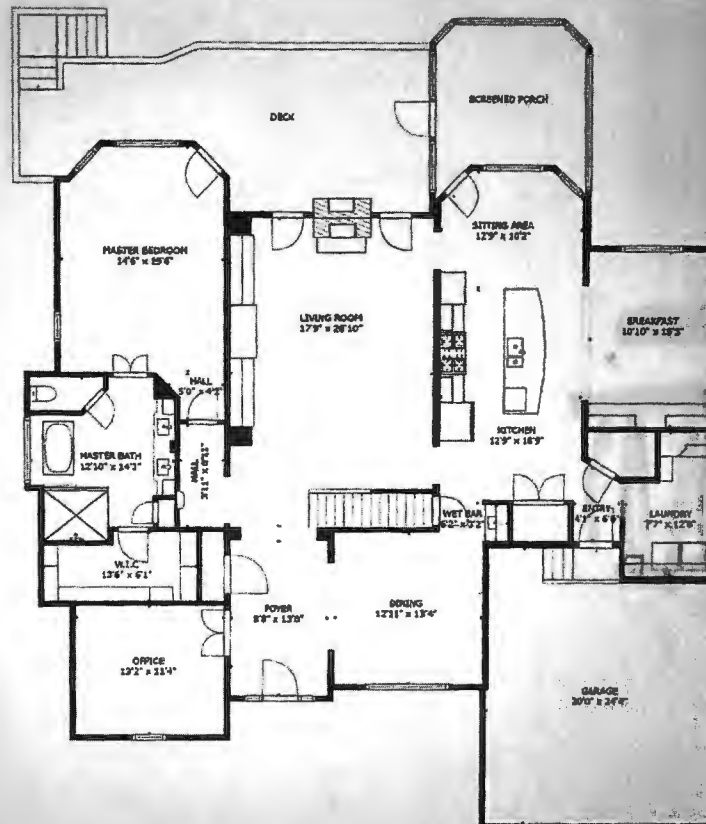


GROSS INTERNAL AREA
 FLOOR 1: 2100 sq ft, FLOOR 2: 2294 sq ft
 FLOOR 3: 1125 sq ft, EXCLUDED AREAS:
 PORCH: 167 sq ft, GARAGE: 458 sq ft
 TOTAL: 5518 sq ft

NOTES AND DIMENSIONS ARE APPROXIMATE, ACTING FROM SAT

MLS

Matter

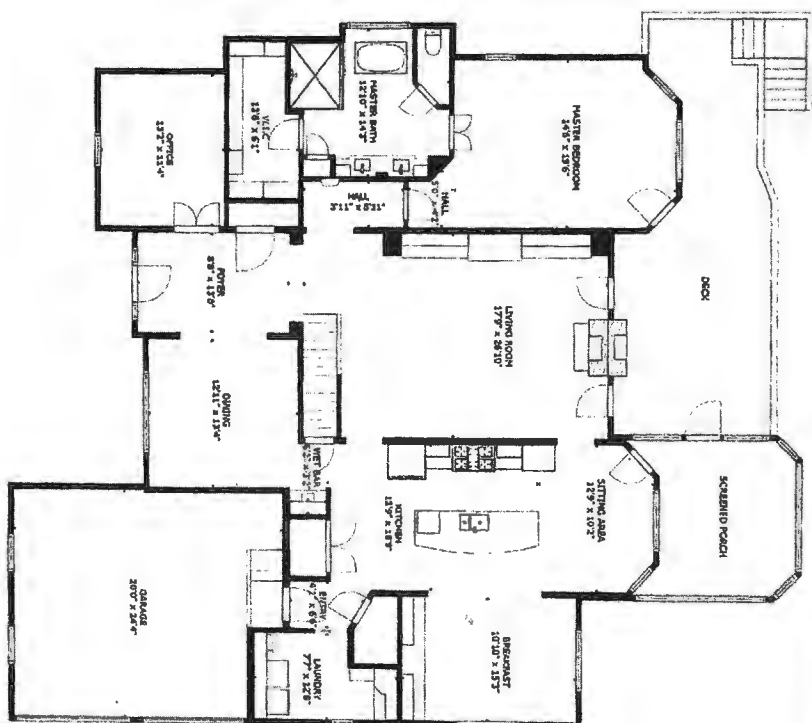

GROSS INTERNAL AREA
 FLOOR 1: 2100 sq ft, FLOOR 2: 2294 sq ft
 FLOOR 3: 1125 sq ft, EXCLUDED AREAS:
 PORCH: 187 sq ft, GARAGE: 458 sq ft
 TOTAL: 5519 sq ft
 SIZE 5.5 ALSO DIMENSIONS ARE APPROXIMATE. ACTUAL VARY WHEN

15600 8

Matte

76 OF 78

Q Search