

Menu Save Reset Cancel Help

Record Detail * (This section is required.)

Case

EH-PLANS-25-0

Type

EnvHealth/Environmental Health/Plan Check/Application

Status

In Review

Opened Date

07/18/2025

Single Entry Edit-View Record Form

Application Name

B25002790

Description

SFD/ REPLACE EXISTING W/ NEW 15x28 open deck w/ steps

Approved. g& 6/11/25

Total Invoiced

0.00

Total Paid

0.00

Balance

0.00

Assigned to Department Current Department

Well and Septic Progre

Assigned to Staff Current User

Zack Silvast

Address * (This section is required.)

New

Search

Delete

Set Primary

706 Chessie Crossing Way

Parcel (This section is not required.)

Search

Delete

Get Address & Owner

Set Primary

Owner (This section is not required.)

Search

Delete

Set Primary

Applicant * (This section is required.)

Search

As Owner

As Lic. Prof

As Contact

Single Entry Applicant Form

Type *

Applicant

Primary

Yes

First Name *

Garrick

Middle Name

Last Name *

Hoffman

Home Phone ((xxx)xxx-xxxx)

Organization Name *

Archway Remodeling

Mobile Phone ((xxx)xxx-xxxx)

(410) 259-5068

E-mail

archwayis@yahoo.com

Business Phone ((xxx)xxx-xxxx)

Preferred Channel

--Select--

Applicant Address

New

Look Up

Deactivate

Remove

Custom Fields

DATE TRACKING

Received Date

7/18/2025

Due Date

8/1/2025

Dates to Complete

14

(Number)

Food Review Type

--Select--

Equipment Specification Sheet

Received by Food

Equipment Specification Sheets Submitted

Received by Community Hygiene

Received by Well and Septic

7/18/2025

FACILITY INFORMATION

Name of Business (dba) *

n/a

(Text)

Associated Building Permit Number

(Text)

Owner Switch Date

Does the project include an Aquatic Facility such as a Public Pool? If Yes, forward to CH Program.

☐ Yes

☐ No

Does the project include Private Septic? If Yes, forward to WS Program.

☐ Yes

☐ No

Is this a Prototype Food Service Facility? If Yes, refer to State.

☐ Yes

☐ No

Facility Fax

0

(Text)

Days of Operation

0

(Text)

Does this project have a Building Permit?

☐ Yes

☐ No

Building Permit Issued Date

☐ Non-Profit

Does the project include Private Well? If Yes, forward to WS Program.

☐ Yes

☐ No

Does the project include Food Services? If Yes, forward to FP Program.

☐ Yes

☐ No

Facility Phone

0

(Text)

Facility Email

0

(Text)

PROPERTY INFORMATION

Water Source

Private

Design Wastewater Flow

(Number)

Sewage Disposal

Private

Permit Type

--Select--

PLAT STATS

Total Number of buildable lots to be recorded

0

(Number)

Total number of open space lots to be recorded

0

(Number)

Total number of bulk parcels to be recorded

0

(Number)

Total number of lots / parcels to be recorded

0

(Number)

New buildable lots created

(Number)

Date PLAT signed by Health Officer

PLAT Type

--Select--

Date Preliminary Plan Signed by HO

☐ Extension Granted

DEVELOPMENT PLANS

Property Type

Residential

Signature Required

☐ Yes

☐ No

Number of paper copies

0

(Number)

Number of buildable lots created

0

(Number)

Total Number of Lots

0

(Number)

Plan Version

Initial

Engineer

0

(Text)

Number of mylar copes

0

(Number)

Number of non-buildable lots created

0

(Number)

Associated Plans

WELL AND SEPTIC INTERNAL

State Review Required

☐ Yes

☐ No

Proposed Septic System Type

--Select--

Coordinate State Review

☐ Yes

☐ No

FOOD ESTABLISHMENT FACILITY

Priority Assessment

--Select--

Licensed Type

--Select--

License Category

--Select--

FOOD ESTABLISHMENT INFORMATION

Hours of Operation

(Text)

☐ Operating Seasonally Only

Are pets allowed in a outdoor seating area?

☐ Yes ☐ No

If Operating Seasonally, What is the start month?

(Text)

Full Bar?

☐ Yes ☐ No

RESTAURANT AND FOOD SERVICE

Food Service Facility Secondary Category

--Select--

Total Seating Capacity

(Number)

Number of Restrooms

(Number)

Interior Restaurant Seating Capacity

(Number)

Bar Seating Capacity

(Text)

Outdoor Seating Capacity

(Text)

Does the restaurant have outdoor seating

☐ Yes ☐ No

EQUIPMENT

Evaluated non NSF, ANSI, CF or other standards

☐ Yes ☐ No

Description of Refrigeration Units

Number of Walk-In Refrigerator Units

(Number)

Description of Walk-In Freezer Units

(Text)

Is there a bulk ice machine available

☐ Yes ☐ No

Space Limitation

Number of Hand Sinks Available

(Number)

Hood System

(Text)

Ventless Equipment

(Text)

PLUMBING

Size and installation of the water heater?

(Text)

Is there a grease interceptor or grease trap?

--Select--

REFUSE AND RECYCLABLES

Dumpsters Located on a Impervious surface?

--Select--

Will there be a grease receptacle?

--Select--

WAREWASHING DISHWASHING

Dishwashing Method

--Select--

HACCP

Plan Review Response Letter Received

☐ Yes ☐ No

Date HACCP Approved by the State

Date HACCP Plan Submitted

HACCP Plan Approved

HACCP Plan Review

Plan Review Letter Mailed

HACCP Plan Revision Submitted

HACCP Fee Type

--Select--

FINISHING SCHEDULE

Kitchen Floor / Bar Flooring


--Select--

Kitchen Cove Base

--Select--

NOTES:


- 1) B.L.L. information, if shown, was obtained from existing record plat or local agencies and is not guaranteed by NIT, Inc.
- 2) Surveying line and/or Flood Zone information is subject to the interpretation of the originator.
- 3) NIT, Inc. does not carry on engineering or land surveying work.
- 4) Property features not shown, are guaranteed by this location.
- 5) Subsequent changes are not shown.

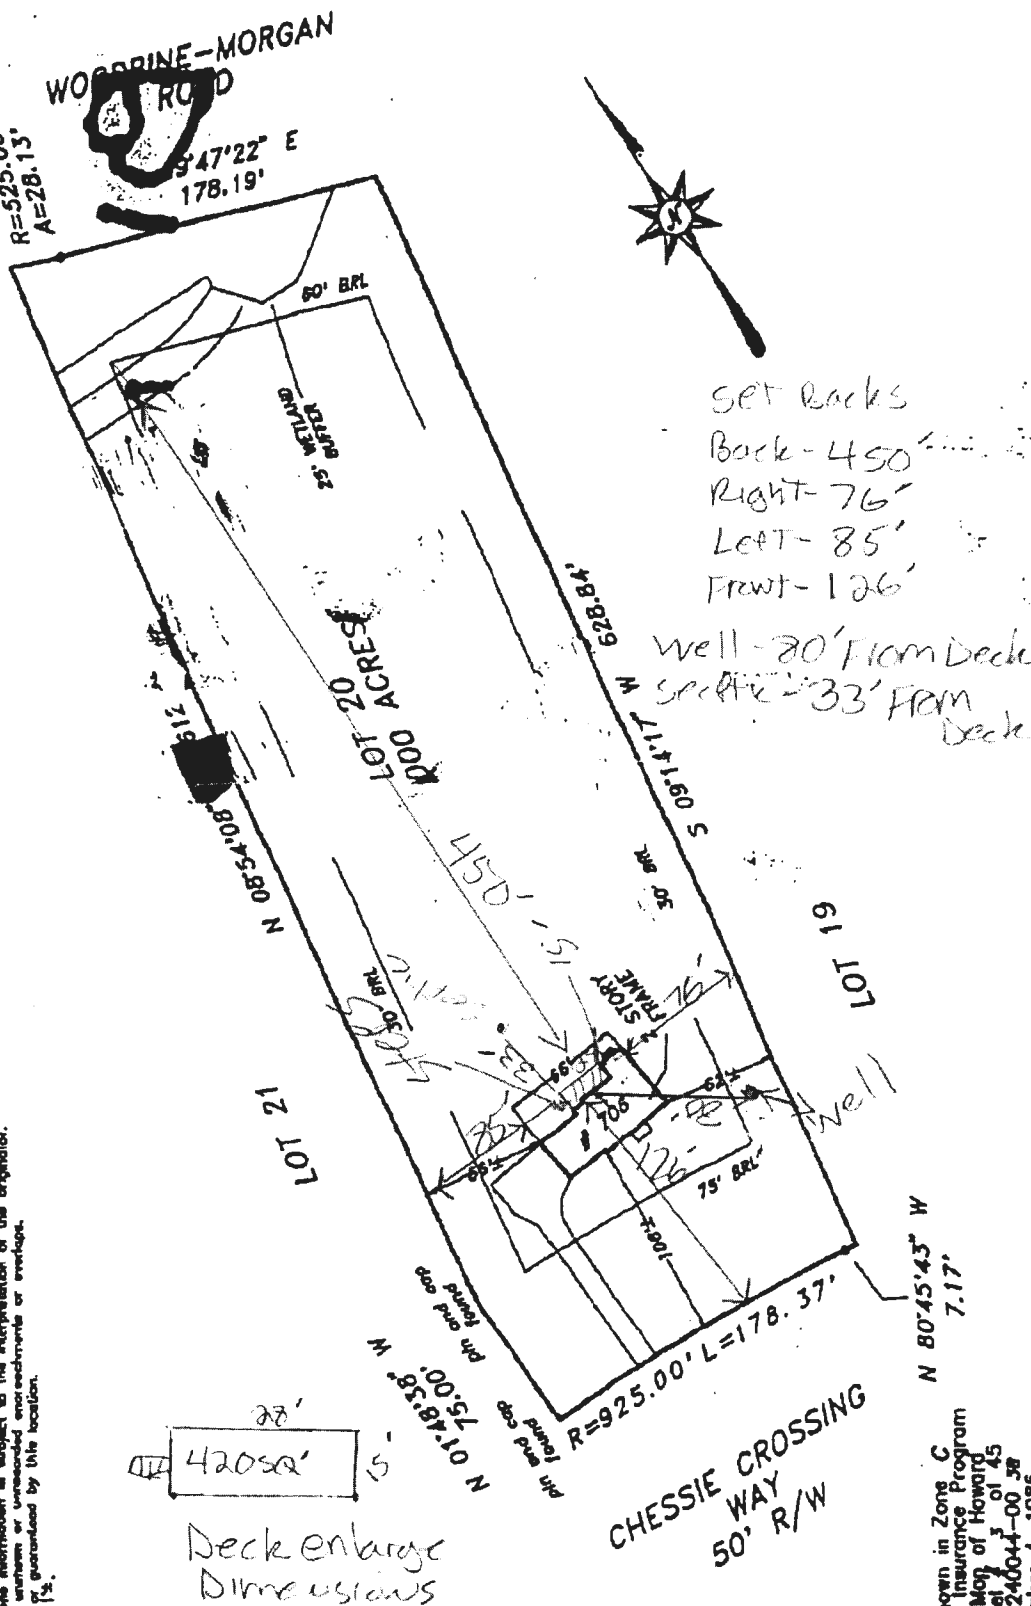

LOCATION DRAWING
706 CHESSIE CROSSING WAY
CHESSIE CROSSING
4TH ELECTION DISTRICT
HOWARD COUNTY, MARYLAND

Scale: 1" = 100'
Date: MARCH 25, 1987
Field by: JLM
Drawn by: JLM

NTT Associates, Inc.
16205 Old Frederick Road
Mt. Airy, Maryland 21771
Ph: (410)442-2031

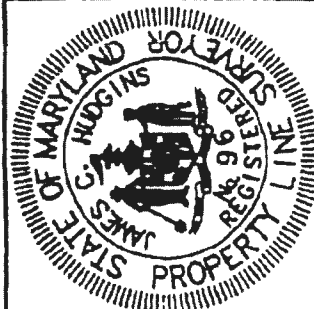

Subject property is shown in Zone C on the National Flood Insurance Program Flood Insurance Rate Map of Howard County, Maryland, Panel 2 of 45 Community Panel 240044-00.38 Effective date: December 4, 1986

This is to certify that I have surveyed the property shown herein, being known as LOT 20 706 CHESSIE CROSSING WAY recorded in the Land Records of Howard County, Maryland in Plat Bk. 10462 Liber Folio for the purpose of locating the improvements thereon.

This plat is of benefit to the consumer only insofar as it is required by a lender or a title insurance company or its agent in connection with contemplated transfer, financing or refinancing purposes. This plat is not to be relied upon for the establishment of location of fences, garages, buildings, or other existing or future structures. This plat does not provide for the accurate identification of property boundary lines, but such identification may not be required for the transfer of title or for securing financing or refinancing.