

APPLICATION

PERCOLATION TESTING

A 36755

P _____

HOWARD COUNTY HEALTH DEPARTMENT
BUREAU OF ENVIRONMENTAL HEALTH
P.O. BOX 476 ELLICOTT CITY, MARYLAND 21043
TELEPHONE: 461-9933

DISTRICT _____

DATE 4/3/86

TO: THE COUNTY HEALTH OFFICER
ELLICOTT CITY, MARYLAND

I, HEREBY, APPLY FOR THE NECESSARY TEST IN ORDER TO CONSTRUCT (OR RECONSTRUCT) A SEWAGE DISPOSAL SYSTEM.

PROPERTY OWNER ARVID JACOBSON, PAUL JACOBSON, RANDALL JACOBSON
ADDRESS 11906 BLUE FEBRUARY WAY PHONE 730-1845

PROSPECTIVE BUYER _____

ADDRESS _____ PHONE _____

PROPERTY LOCATION:

SUBDIVISION TRIADELPHIA ESTATES LOT NO. 3
ROAD AND DESCRIPTION TRIADELPHIA ROAD

TAX MAP 21 PARCEL # 33 LOT 2
SIZE OF LOT 3.0 ACRES TYPE BLDG. SINGLE FAMILY
(SINGLE FAMILY DWELLING OR COMMERCIAL)

THE SYSTEM INSTALLED UNDER THIS APPLICATION IS ACCEPTABLE ONLY UNTIL PUBLIC FACILITIES BECOME AVAILABLE. I FULLY UNDERSTAND THE
FEE CONNECTED WITH THE FILING OF THIS PERC TEST APPLICATION IS NON-REFUNDABLE UNDER ANY CIRCUMSTANCES. I ALSO AGREE TO COMPLY
WITH ALL M.O.S.H.A. REQUIREMENTS IN TESTING THIS LOT.

Randall Jacobson
(SIGNATURE OF APPLICANT)

APPROVED BY _____ FOR _____ DATE _____

REJECTED BY _____ FOR _____ DATE _____



HOLD PENDING FURTHER TESTS _____ DATE _____

REASONS FOR REJECTION OR HOLDING _____

THIS IS NOT A PERMIT

Lot 3 Tridelphi Estate

③
SOIL PROFILE

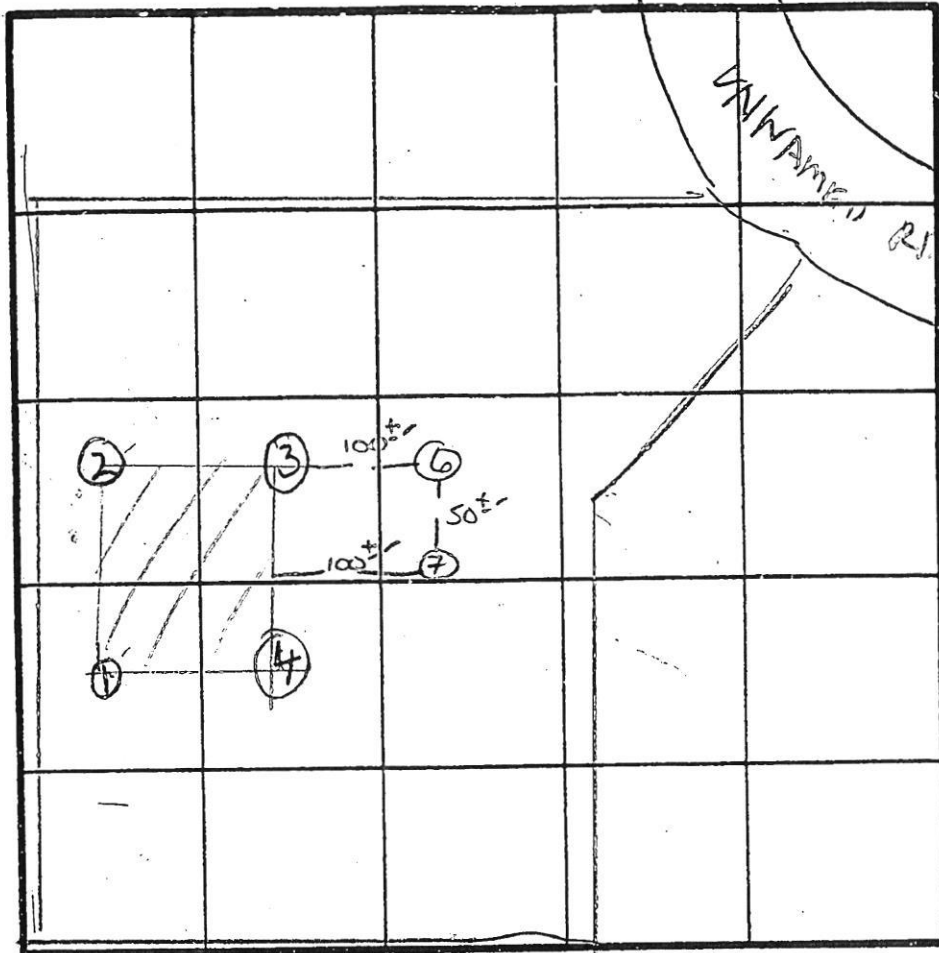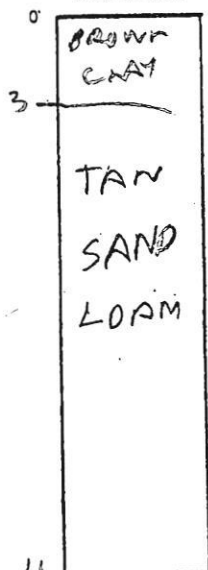

UNNAMED RD.

See other sheet for drawing of Lot new 3

INDICATE NORTH - NAME ADJOINING ROADWAY AS BASE LINE.

TRIDELPHIA RD.

DATE	TEST NO.	DEPTH	PRE-WET		TEST - 1" DROP		TIME
			START	STOP	START	STOP	
5/5/86	1 B	9	1117	1121	1121	1126	5
	1 S	3	1129	1130	1136	1134	4
	IV	13.5	LOOK	OK			
	2 S	4.5	1132	1140	1140	1143	3
8/14/86	2 V	14.5	WATER	1143	1143	1143	
	3 S	5	1158	1200	1200	1205	5
	3 V	14	LOOK	OK			
	4 S	4.5	1213	1217	1217	1223	6
	4 V	12.5	LOOK	OK			
	5 S	3.5	2113:30	2115:30	2115:30	2118:00	2.5min
	5 V	13	uniform soil below	3"			
	6 S	4	2122	2124	2124	2127	3min
	6 V	13	uniform soil below	3"			

HOLES DUG PER SURVEY OR STAKE
LATE START BACK HOE NOT READY

TYPE OF SOIL

TESTED BY R. HODGES

ALSO PRESENT

R. JACOBSEN

④
BROWN CLAY
TAN SAND LOAM
EH-12-10799

12.5