

LAYOUT 8/21/08 INSP 4 _____
INSP 2 9/12/08 INSP 5 _____
INSP 3 9/16/08 INSP 6 _____

ISSUE DATE: 8/21/08

APPROVAL DATE: 9/17/08

PERMIT

TAX ID # 05442745

ON-SITE SEWAGE DISPOSAL SYSTEM
HOWARD COUNTY HEALTH DEPARTMENT
BUREAU OF ENVIRONMENTAL HEALTH

P 529523

A 519664

*5A construction
674-6730*

*Entered into
Permit Trail*

Brenda Greis IS PERMITTED TO INSTALL ☒ ALTER ☐

ADDRESS: 4520 Jansky Ct PHONE NUMBER: 301-674-6551

SUBDIVISION: Triadelphia Mill Road Property LOT NUMBER: 3

ADDRESS: 14265 Triadelphia Mill Rd PROPERTY OWNER: Donald Holliday Jr.

SEPTIC TANK CAPACITY (GALLONS): 2000 OUTLET BAFFLE FILTER REQUIRED ☐

PUMP CHAMBER CAPACITY (GALLONS): _____ COMPARTMENTED TANK REQUIRED ☒

NUMBER OF BEDROOMS: 4

SQUARE FEET PER BEDROOM: _____

LINEAR FEET OF TRENCH REQUIRED: 138

TRENCHES:	Trench to be 3.0 feet wide. Inlet 3.0 feet below original grade. Bottom maximum depth 6.0 feet below original grade. Effective area begins at 5.0 feet below original grade. 3.0 feet of stone below distribution pipe.
LOCATION:	
NOTES:	Install per plan unless directed by HCHD. Layout required prior to septic installation.

PLANS APPROVED: Sara Sappington DATE: 11/20/07

NOTE: PERMIT VOID AFTER 2 YEARS

NOTE: CONTRACTOR RESPONSIBLE FOR SCHEDULING A PRE-CONSTRUCTION INSPECTION FOR ALL INSTALLATIONS

NOTE: WATERTIGHT SEPTIC TANKS REQUIRED

NOTE: ALL PARTS OF SEPTIC SYSTEM SHALL BE 100 FEET FROM ANY WATER WELL

NOTE: MANHOLE RISERS REQUIRED ON ALL SEPTIC TANKS AND PUMP CHAMBERS UNLESS SPECIFICALLY AUTHORIZED

NEITHER THE HOWARD COUNTY COUNCIL NOR THE HEALTH DEPARTMENT IS
RESPONSIBLE FOR THE SUCCESSFUL OPERATION OF ANY SYSTEM
PERMITTEE RESPONSIBLE FOR OBTAINING FINAL APPROVAL ON THIS PERMIT
CALL 410-313-1771 FOR INSPECTION OF SEPTIC SYSTEM

NOT TO SCALE

*See Separate
sheet for AS-Brief*

TRENCH/DRAINFIELD DATA

WIDTH .44" INLET 3 BOTTOM 5
NUMBER OF TRENCHES 2
TOTAL LENGTH _____
ABSORPTION AREA _____
DISTRIBUTION BOX LEVEL below
DISTRIBUTION BOX BAFFLE Yes
DISTRIBUTION BOX PORT Yes

SEPTIC TANK DATA

SEPTIC TANK 1 LEVEL Yes
MANUFACTURER Babylon
CAPACITY 2000 GAL
SEAM LOC Top
TANK LID DEPTH 1.5'
BAFFLES Front /
BAFFLE FILTER _____
MANHOLE LOC Front /
6" PORT LOC side
WATERTIGHT TEST _____
SLOTTED Yes
PUMP/SEPTIC TANK LEVEL _____
MANUFACTURER _____
CAPACITY _____ GAL
SEAM LOC _____
TANK LID DEPTH _____
BAFFLES _____
BAFFLE FILTER _____
MANHOLE LOC _____
6" PORT LOC _____
WATERTIGHT TEST _____
SLOTTED _____

PRE-CONSTRUCTION

8/21/08 Contractor to
install a 6.5' and
7.2' trench on contour.
Keep tanks 20' from
dwelling

9/12/08 Tank set. Plumbing installed from house to tanks.
INSTALLATION: Contractor had installed plumbing from "Guest house"
into line to tanks. Was not aware of the 4" runs (KW)
9/16/08 Contractor has finished up tanks. Approx. 4" on the
width. They used the wrong type of filter cloth and all
have to change and keep uncovered (KW) 9/17/08 Correct
filter fabric used. Dbox had to be adjusted to make
fall to first trench. looks good. OK to backfill (KW)

FINAL INSPECTOR

[Signature]

DATE OF APPROVAL

9-17-08

NOT TO SCALE

107'

9' 6" 8

120'

118'

224'

86'

39'

15'

5'

5'

5'


2'


14265 Triadelphia mill

35'

32'

HO-94-3954

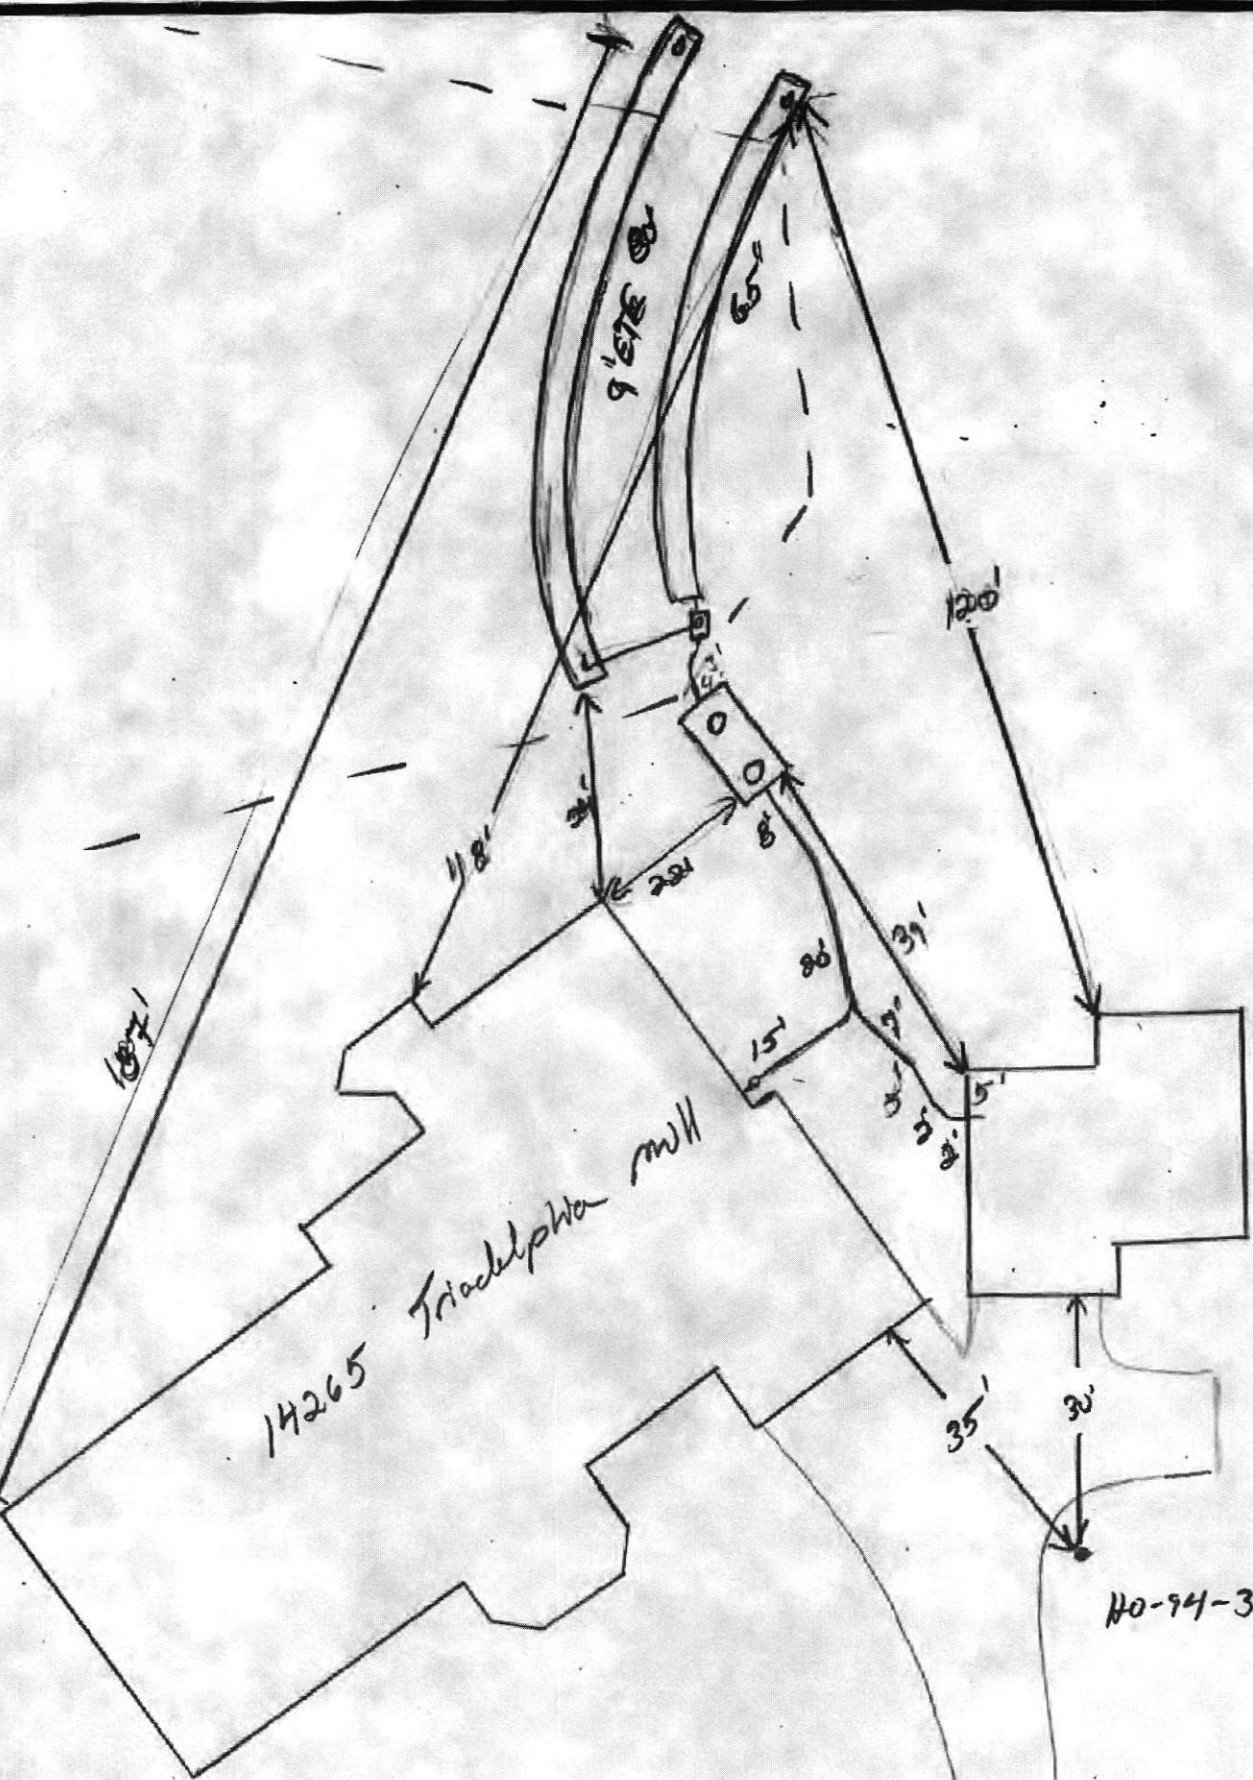

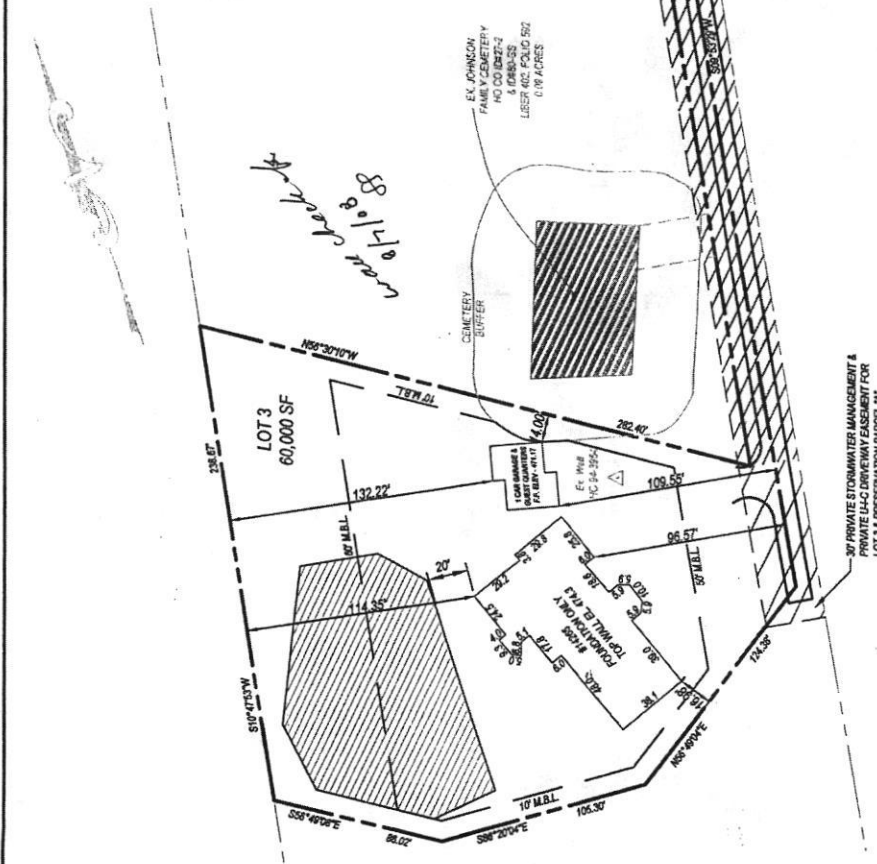

N73°53'11"W
12.07'

EX. 307 PRIVATE STORMWATER MANAGEMENT & U+AC DRIVEWAY EASEMENT FOR LOTS 1, 2, & FUTURE RESUBDIVISION OF LOT 2 (F-04-537)

E. L. JOHNSON
 MILV CEMETERY
 HQ CO ID#27-2
 6 10480-55
 BR 402, FOLIO 592
 0.08 ACRES

30' PRIVATE STORMWATER MANAGEMENT &
PRIVATE U+G DRIVEWAY EASEMENT FOR
LOT 1 & PRESERVATION PARCEL "A"

WALL CHECK DRAWING

LOT 3

TRIADELPHIA MILL ROAD
PROPERTY

RECORDED IN PLAT No. 18055
RECORDED IN BOOK 10861, PAGE 620
5th ELECTION DISTRICT
HOWARD COUNTY, MARYLAND

NOTES

- NOTES
1. All fence lines must be verified by a boundary survey.
 2. A statement of minimum advice is an integral part of the plat and is detailed on the attached general notes.
 3. The property shown hereon is not affected by the Flood Hazard Zone as shown on Flood Insurance Rate Map for Carroll County, Maryland Panel No. 25 of 45, Community Panel No. 240004 0025 B as prepared by the National Flood Insurance Program, revision date December 04, 1996.

BPR^{INC}
SURVEYORS • LAND PLANNERS

Suite 4
Westminster, Maryland 21157
Phone: (410)-857-9030
(410)-876-0333
Fax: (410)876-1532
www.bprsurveying.com


I, Donald Maryland Surveyor either personally prepared the Location Drawing as shown hereon, or was in responsible charge over its preparation and the surveying work reflected in it, in compliance with chapter 60, §13-06.12 of the Maryland Mineral Standards of Practice for Land Surveyors. Exact property corners have not been established or set. We assume responsibility or liability for any rights-of-way or easements recorded or unrecorded, not appearing on the record hereon, notwithstanding the title deed referred to hereon.

Signed this 1st day of JULY 2008
Surveyor's Signature

Date: May 9, 2008
BPR Job No. 07-022-005
Scale: 1 inch = 6'

Also known as #14265 Triadelphia Mill Road



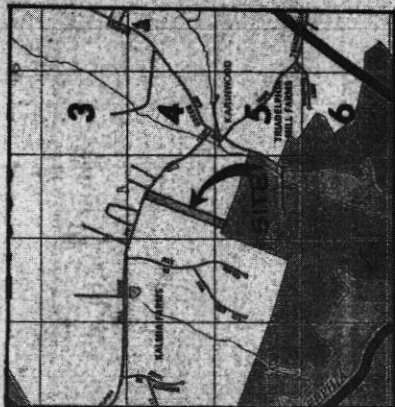


VICINITY MAP
SCALE: 1"=2000'

TABULATION

TOTAL NO. OF LOTS 3
TOTAL AREA 14.47 AC

CARL A. & SALLY ANN THOMPSON
980/570

TRIADDELPHIA ROAD

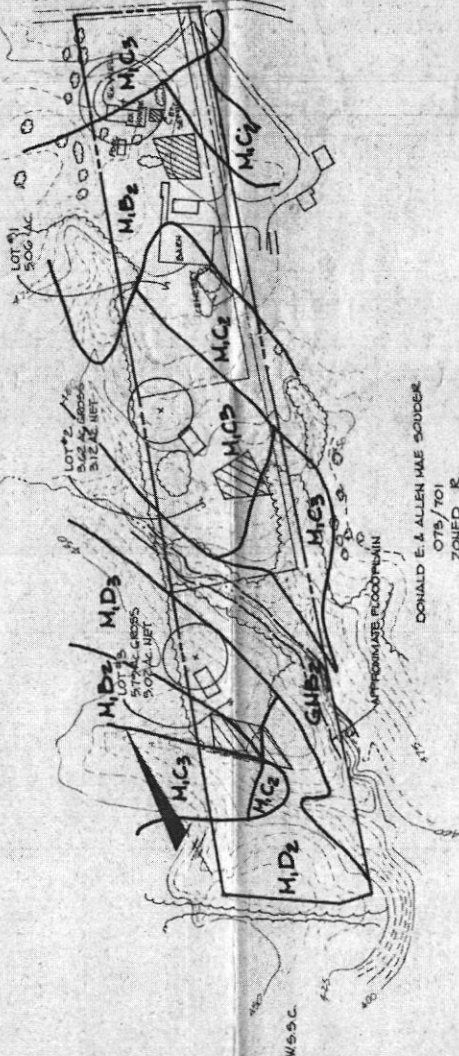

SOILS CLASSIFICATION

GENTLE SLOPE, 3 TO 8 PERCENT SLOPES, MODERATELY ERODED
MODERATE SLOPE, 8 TO 15 PERCENT SLOPES, MODERATELY ERODED
MODERATE SLOPE, 8 TO 15 PERCENT SLOPES, SEVERELY ERODED
MODERATE SLOPE, 8 TO 15 PERCENT SLOPES, SEVERELY ERODED
MODERATE SLOPE, 15 TO 25 PERCENT SLOPES, SEVERELY ERODED


LEGEND

- PROPOSED 10000 SQ. FT. SEPTIC AREA
- PROPOSED WELL
- PROPOSED HOUSE
- FLOOD PLAIN

DATE	NO.	REVISION
OWNER / DEVELOPER AFFILIATE REAL ESTATE PARTNERSHIP 10920 LITTLE PATRICK PKWY. COLUMBIA, MARYLAND 21045		
PROJECT TRIADDELPHIA MILL ROAD		
AREA TAX MAP 27		PARCEL 13
5TH ELECTION DISTRICT HOWARD COUNTY, MARYLAND		
TITLE SEPTIC PLAN		
THE RIEMER GROUP, INC. The Riemer Group, Inc. A Land Planning, Design & Civil Engineering Firm 3105 North Ridge Road, Ellicott City, Maryland 21043 (301) 461-8800		
DESIGNED BY J.J.D.		DATE
DRAWN BY K.J.B.		
PROJECT NO. 9401		
DATE: MARCH 10, 1988		
SCALE: 1"=200'		
DRAWING NO. 1 OF 1		


N.B.	RAD.	Δ	TAN.	ARC.	CHD.	L.C.B.
159-156	5160.00	09° 07' 22"	10.65	281.23	281.20	N47°15'58"W

N9	NORTH	EAST
123	505,924.979	796,774.259
156	507,901.434	797,153.326
159	507,825.024	797,423.945
202	505,811.349	797,008.024
203	505,804.785	797,088.924
232	507,931.036	797,159.003
233	507,855.280	797,428.962

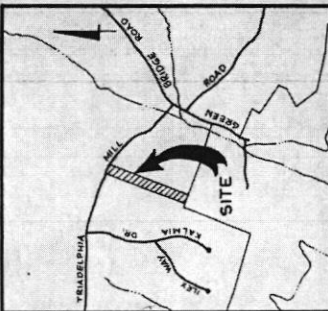

PROPERTY OF
DONALD E. SOUDER, ET AL.
L. 908, F. 714

TRIADAPLHIA MILL ROAD
LAND DEDICATED TO HOWARD COUNTY
EX. ROAD 1.5 (200' x 300' x 300')

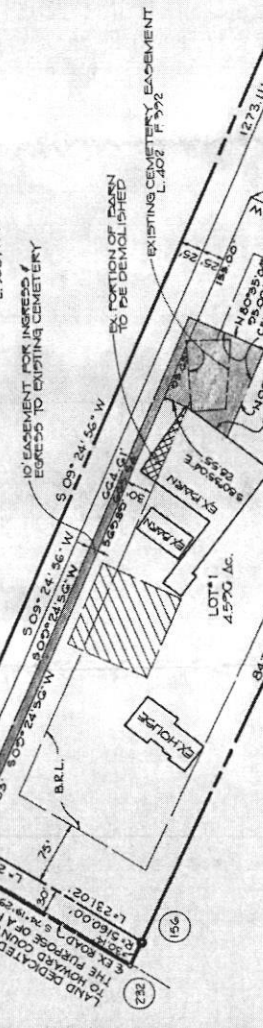

PROPERTY OF
CARL A. HARRISON AND
SALLY L. HARRISON ET UX
L. 988, F. 570

GENERAL NOTES

- THIS AREA DESIGNATES A PRIVATE SEWERAGE EASEMENT OF 10,000 SQUARE FEET AS REQUIRED BY THE MARYLAND STATE DEPARTMENT OF HEALTH AND MENTAL HYGIENE FOR INDIVIDUAL SEWAGE DISPOSAL IMPROVEMENTS OF ANY NATURE IN THIS AREA. EASEMENTS SHALL BE IN FULL FORCE AND EFFECT UPON CONNECTION TO A PUBLIC SEWAGE SYSTEM. THE COUNTY HEALTH OFFICER SHALL HAVE THE AUTHORITY TO GRANT VARIANCES FOR ENCROACHMENTS INTO THE PRIVATE SEWER EASEMENT. RECORDATION OF A MODIFIED SEWAGE EASEMENT SHALL NOT BE NECESSARY.
- THE PROPERTY HEREON IS BASED ON THE MARYLAND STATE GRID SYSTEM AS PROJECTED BY HOWARD COUNTY STATIONS NUMBERED # 2730001 (# 2830001) (# 2830002).
- SUBJECT PROPERTY IS ZONED R PER 8-2-85 COMPREHENSIVE ZONING PLAN.
- B.L. DENOTES BUILDING RESTRICTION LINE.
- EXISTING BUILDINGS OR STRUCTURES ON LOT #1, NO NEW BUILDINGS, EXTENSIONS, OR ADDITIONS TO THE EXISTING BUILDING ARE TO BE CONSTRUCTED AT A DISTANCE LESS THAN THE ZONING REGULATIONS REQUIRE.
- FOR FLAG OR PIPE STEM LOTS, REFUSE COLLECTION, SNOW REMOVAL AND ROAD MAINTENANCE ARE PROVIDED TO THE JUNCTION OF THE FLAG OR PIPE STEM AND THE ROAD RIGHT-OF-WAY LINE.

TOTAL TABULATION THIS SUBMISSION	TOTALS
1) TOTAL NUMBER OF LOTS TO BE RECORDED	3
2) TOTAL AREA OF LOTS TO BE RECORDED INCLUDING WIDENING STRIPS	14.311 AC
3) TOTAL AREA OF LOTS TO BE RECORDED EXCLUDING WIDENING STRIPS	0.203 AC
4) TOTAL AREA OF THIS SUBMISSION TO BE RECORDED	14.514 AC

APPROVED: FOR PRIVATE WATER AND PRIVATE SEWERAGE IN CONFORMANCE WITH THE MASTER PLAN OF WATER AND SEWERAGE FOR HOWARD COUNTY.

HOWARD COUNTY HEALTH OFFICER DATE
APPROVED: HOWARD COUNTY OFFICE OF PLANNING AND ZONING.

DIRECTOR DATE
APPROVED: STORM DRAINAGE SYSTEM AND PUBLIC ROADS, HOWARD COUNTY DEPARTMENT OF PUBLIC WORKS
DIRECTOR DATE

SURVEYOR'S CERTIFICATE
I HEREBY CERTIFY THAT THE BEST OF MY KNOWLEDGE AND BELIEF THAT THE FINAL PLAN SHOWN HEREON IS CORRECT; THAT IT IS A SUBDIVISION OF ALL OF THE LAND CONVEYED BY RICHARD G. NEWHOUSE TO AFFILIATE REAL ESTATE PARTNERSHIP, INC. AND THE RECORDS OF HOWARD COUNTY, MARYLAND, IN LIBER 1809 OF FOLIO 360, AND THAT ALL MONUMENTS ARE IN PLACE OR WILL BE IN PLACE PRIOR TO THE ACCEPTANCE OF THE STREET IN THE SUBDIVISION. I HAVE ALSO ANNOTATED CODE OF MARYLAND, AS AMENDED.

THE RIEMER GROUP, INC.
3105 NORTH RIDGE ROAD
ELLCOTT CITY, MD, 21043
PROFESSIONAL LAND SURVEYOR
ARTHUR E. MUEGE - 10751 DATE

OWNER'S CERTIFICATE
WE, AFFILIATE REAL ESTATE PARTNERSHIP, STEVE GOLDBURG, PRESIDENT, OWNERS OF THE PROPERTY SHOWN AND DESCRIBED HEREON, HEREBY ADOPT THIS PLAN OF SUBDIVISION, AND IN CONSIDERATION OF THE APPROVAL OF THIS PLAN BY THE OFFICE OF PLANNING AND ZONING, HOWARD COUNTY, MARYLAND, ITS SUCCESSORS AND ASSIGNS, (1) THE RIGHT TO LAY, CONSTRUCT AND MAINTAIN SEWERS, DRAINS, WATER PIPES, AND OTHER MUNICIPAL UTILITIES AND SERVICES, IN AND UNDER ALL ROADS AND STREET RIGHT-OF-WAYS AND THE SPECIFIC EASEMENT AREAS SHOWN HEREON; (2) THE RIGHT TO REQUIRE DEDICATION FOR PUBLIC USES OF THE BEDS OF THE STREETS AND OTHER VALUABLE CONSIDERATION, HEREBY GRANT THE RIGHT AND OPTION TO HOWARD COUNTY TO ACQUIRE THE FEE SIMPLE TITLE TO THE BEDS OF THE STREETS AND/OR ROADS AND FLOOD PLAINS, STORM DRAINAGE FACILITIES AND OPEN SPACE WHERE APPLICABLE; AND (3) THE RIGHT TO REQUIRE A SPECIFIC PURPOSE OF WATERWAY CONSTRUCTION, REPAIR AND MAINTENANCE; AND (4) THAT NO BUILDING OR SIMILAR STRUCTURE OF ANY KIND SHALL BE ERECTED ON OR OVER THE SAID EASEMENTS OR RIGHT-OF-WAYS. THIS DAY OF August 1988
WITNESS MY/OUR HANDS THIS 3 DAY OF August 1988
STEVE GOLDBURG, PRESIDENT


ENGINEER'S CERTIFICATE
THE RIEMER GROUP, INC.
3105 NORTH RIDGE RD
ELLCOTT CITY, MARYLAND 21043
(301) 461-2630
RECORDED AS PLAT NO. 1988 AMONG THE LAND RECORDS OF HOWARD COUNTY, MARYLAND.
TRIADAPLHIA MILL ROAD
LOTS 1, 2 & 3
F-89-24
5th ELECTION DISTRICT HOWARD COUNTY, MARYLAND
TAX MAP # 27 PARCEL # 15
SHEET 1 OF 1 8/12 DATE: 7-15-88
SCALE 1"=100' Rpt OK - Comments sheet
Signed



VICINITY MAP
SCALE 1" = 100'

NOTES:

1. The area shown above indicates a proposed change of use from residential to commercial. The area is located in the center of the grid, near the intersection of roads. The map is titled 'VICINITY MAP' and 'SCALE 1" = 100'.
2. The area shown above indicates a proposed change of use from residential to commercial. The area is located in the center of the grid, near the intersection of roads. The map is titled 'VICINITY MAP' and 'SCALE 1" = 100'.
3. The area shown above indicates a proposed change of use from residential to commercial. The area is located in the center of the grid, near the intersection of roads. The map is titled 'VICINITY MAP' and 'SCALE 1" = 100'.
4. The area shown above indicates a proposed change of use from residential to commercial. The area is located in the center of the grid, near the intersection of roads. The map is titled 'VICINITY MAP' and 'SCALE 1" = 100'.
5. The area shown above indicates a proposed change of use from residential to commercial. The area is located in the center of the grid, near the intersection of roads. The map is titled 'VICINITY MAP' and 'SCALE 1" = 100'.
6. The area shown above indicates a proposed change of use from residential to commercial. The area is located in the center of the grid, near the intersection of roads. The map is titled 'VICINITY MAP' and 'SCALE 1" = 100'.

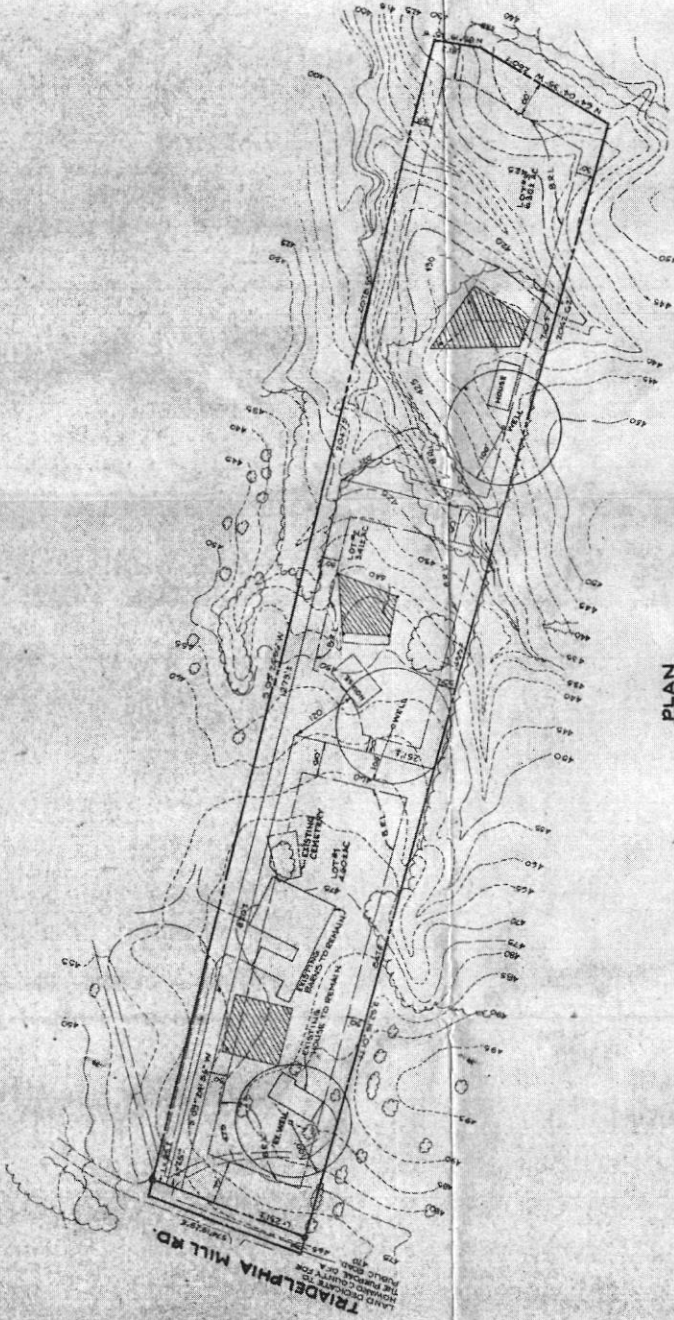


PLAN
SCALE 1" = 100'

DATE	NO.	REVISION
OWNER/DEVELOPER	THE RIEMER GROUP, INC. 1000 LITTLE PATENT ROAD COLUMBIA, MARYLAND 21046	
PROJECT	TRIADAPLUM MILL RD LAND SUBDIVISION	
AREA	15.5 AC. MAP HOWARD COUNTY, MARYLAND	
TITLE	PERC TEST PLAN	
THE RIEMER GROUP, INC. 1000 LITTLE PATENT ROAD COLUMBIA, MARYLAND 21046		
DESIGNED BY	D.S.L.	
DRAWN BY	A.P.C.	
PROJECT NO.	10001	
DATE	JULY 28, 1988	
SCALE	AS SHOWN	
SHEET NO.	1 OF 1	

APPROVED: For private water and private sewerage systems

7/28/88
[Signature]
[Signature]

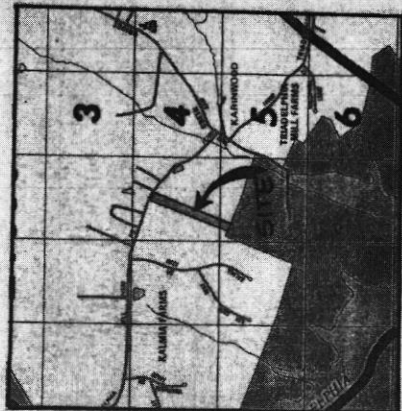


VICINITY MAP
SCALE: 1"=2000'

TABULATION

TOTAL NO. OF LOTS 5
TOTAL AREA 14.47 AC

CARL A. & SALLY ANN THOMPSON
786/570

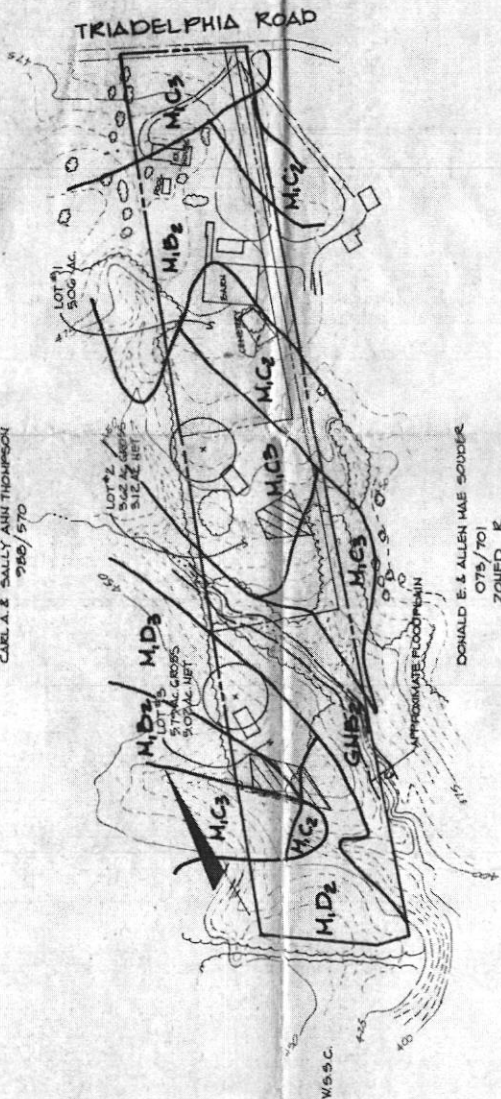


SOILS CLASSIFICATION

- G002 GLENVILLE SILT LOAM, 3 TO 8 PERCENT SLOPES, MODERATELY ERODED
- M1C2 MANOR LOAM, 3 TO 8 PERCENT SLOPES, MODERATELY ERODED
- M1C3 MANOR LOAM, 8 TO 15 PERCENT SLOPES, MODERATELY ERODED
- M1D2 MANOR LOAM, 8 TO 15 PERCENT SLOPES, SEVERELY ERODED
- M1D3 MANOR LOAM, 15 TO 25 PERCENT SLOPES, MODERATELY ERODED
- M1D4 MANOR LOAM, 15 TO 25 PERCENT SLOPES, SEVERELY ERODED

LEGEND

- PROPOSED 10000' 500 FT SEPTIC AREA
- PROPOSED WELL
- PROPOSED HOUSE
- FLOOD PLAIN

DATE	NO.	REVISION
OWNER / DEVELOPER		
AFFILIATE REAL ESTATE PARTNERSHIP 0980 LITTLE PATRICK PT. PKWY. COLUMBIA, MARYLAND 21045		
PROJECT		
TRIADDELPHIA MILL ROAD		
AREA TAX MAP 27		PARCEL 15
5TH ELECTION DISTRICT		HOWARD COUNTY, MARYLAND
TITLE		
SEPTIC PLAN		
THE RIEMER GROUP, INC.		
The Riemer Group, Inc. A Land Planning, Design & Civil Engineering Firm. 3105 North Ridge Road, Ellicott City, Maryland 21043 (301) 471-2990		
DATE		DESIGNED BY J.J.D.
DRAWN BY K.J.B.		PROJECT NO 91401
DATE MARCH 10, 1998		SCALE 1"=200'
DRAWING NO. 1		OF 1

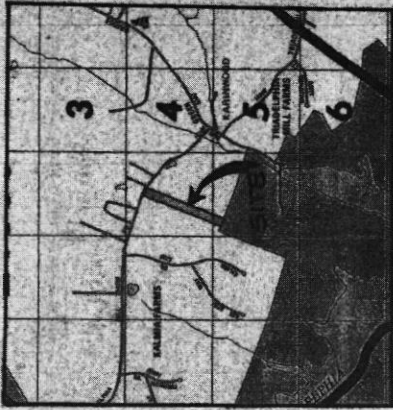


VICINITY MAP
SCALE: 1"=200'

TABULATION

TOTAL NO. OF LOTS 9
TOTAL AREA 14.47 AC.

CARL A. & SALLY ANN THOMPSON
286/570

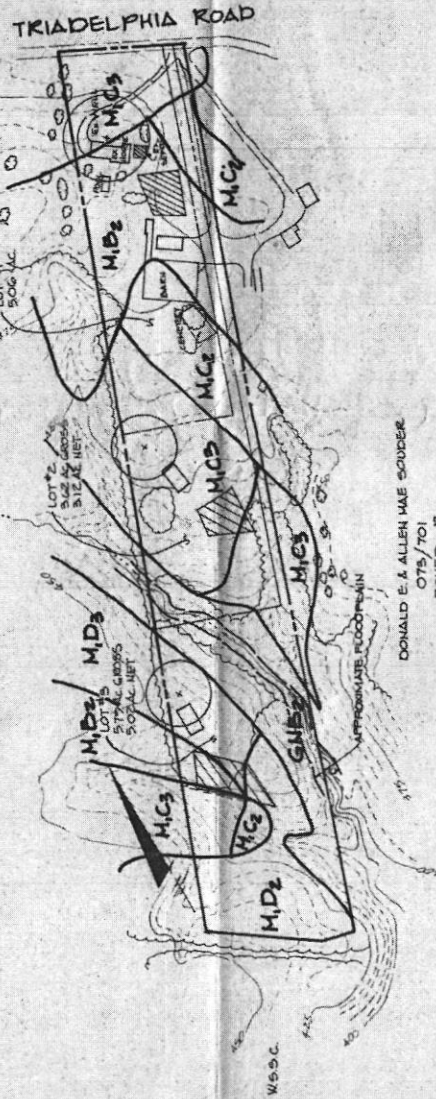

SOILS CLASSIFICATION

- QMB2 GLENVILLE SILT LOAM, 3 TO 8 PERCENT SLOPES, MODERATELY BROOD
- M1B2 MANOR LOAM, 3 TO 8 PERCENT SLOPES, MODERATELY BROOD
- M1C2 MANOR LOAM, 8 TO 15 PERCENT SLOPES, MODERATELY BROOD
- M1C3 MANOR LOAM, 8 TO 15 PERCENT SLOPES, SEVERELY BROOD
- M1B2 MANOR LOAM, 15 TO 25 PERCENT SLOPES, MODERATELY BROOD
- M1B3 MANOR LOAM, 15 TO 25 PERCENT SLOPES, SEVERELY BROOD

LEGEND

- PROPOSED 10,000 SQ FT SEPTIC AREA
- PROPOSED WELL
- PROPOSED HOUSE
- FLOOD PLAN

DATE	NO.	REVISION
OWNER / DEVELOPER		
AFFILIATE REAL ESTATE PARTNERSHIP APPROPRIATELY ZONED COLUMBIA, MARYLAND 21043		
PROJECT		
TRIADDELPHIA MILL ROAD		
AREA TAX MAP 27	5TH ELECTION DISTRICT	PARCEL 15
HOWARD COUNTY, MARYLAND		
TITLE		
SEPTIC PLAN		
THE RIEMER GROUP, INC.		
The Riemer Group, Inc. A Land Planning, Design & Civil Engineering Firm 3105 North Ridge Road, Ellensburg, WA 98921 (509) 467-2890		
DATE		DESIGNED BY J.J.D.
DATE		DRAWN BY K.J.B.
DATE		PROJECT NO. 91801
DATE		DATE MARCH 10, 1986
DATE		SCALE 1"=200'
DATE		DRAWING NO. 1 OF 1

DATE	NO	OWNER/DEVELOPER
		AFPLIFE REAL ESTATE PARTNERSHIP 10920 LITTLE PATRICK PKWY. COLUMBIA, MARYLAND 21045
PROJECT		
TRIADPHILIA MILL ROAD		
ARE A TAX MAP ET		
5TH ELECTION DISTRICT HOWARD COUNTY, MARYLAND		
TITLE		
SEPTIC PLAN		
THE RIEMER GROUP, INC.		
The Riemer Group, Inc., A Lead Planning Design & Civil Engineering Firm 3105 North Ridge Road, Ellicott City, Maryland 21043 (301) 461 2880		
DATE		
DESIGNED BY J.J.D.		
DRAWN BY K.J.B.		
PROJECT NO 5101		
DATE MARCH 15, 1988		
SCALE 1" = 200'		
DRAWING NO 1 OF 1		

