

Menu Save Reset Cancel Help

Record Detail *(This section is required.)*

Case

EH-PLANS-25-0

Type

EnvHealth/Environmental Health/Plan Check/Application

Status

In Review

Opened Date

09/18/2025

Single Entry Edit-View Record Form

Application Name

B25003482

Description

SFD/ CONSTRUCT 21' X 15' SECOND FLOOR ADDITION FOR WALK IN CLOSET, FIRST FLOOR ADDITION FOR BUTLERS PANTRY, BASEMENT CRAWL SPACE AND CONSTRUCT 26' X 35' SCREENED PORCH, LANDING, & STEPS, 2 STORY, Crawl Space, 1R, 0FB, 0HB, 1FP, OTHER STRUCTURE = N/A, 0BR, PORCH/DECK = Screen Porch, ENERGY METHOD = N/A,

Total Invoiced

0.00

Total Paid

0.00

Balance

0.00

Assigned to Department Current Department

Well and Septic Progre

Assigned to Staff Current User

Zack Silvast

Address *(This section is required.)*

New Search Delete Set Primary

Parcel *(This section is not required.)*

Search Delete Get Address & Owner Set Primary

☐ Primary Parcel # Book Page Parcel Parcel Area Land Value Improved Value Exemption Value Legal Description Tract

0 record(s) found.

Owner *(This section is not required.)*

Search Delete Set Primary

Applicant *(This section is required.)*

Search As Owner As Lic. Prof As Contact

Single Entry Applicant Form

Type *

Applicant

Primary

Yes

First Name *

Douglas

Middle Name

Last Name *

Wood

Home Phone (xxx)xxx-xxxx

Organization Name *

Castlewood Consulting LLC

Mobile Phone (xxx)xxx-xxxx

(301) 347-1627

E-mail

RACHEL@TODDWOOD.COM

Business Phone (xxx)xxx-xxxx

Preferred Channel

--Select--

Applicant Address

New Look Up Deactivate Remove

Online BP. 9/18/25

Approved Septic System Plan
Howard County Health Department
DBernard 9-29-25
Signature Date

Custom Fields

DATE TRACKING

Received Date

9/18/2025



Due Date

10/2/2025



Dates to Complete

14

(Number)

Received by Food



Food Review Type

--Select--

Equipment Specification Sheets Submitted



Equipment Specification Sheet

Received by Community Hygiene



Received by Well and Septic

9/18/2025



FACILITY INFORMATION

Name of Business (dba) *

n/a

(Text)

Associated Building Permit Number

(Text)

Owner Switch Date



Does the project include an Aquatic Facility such as a Public Pool? If Yes, forward to CH Program.

☐ Yes ☐ No

Does the project include Private Septic? If Yes, forward to WS Program.

☐ Yes ☐ No

Is this a Prototype Food Service Facility? If Yes, refer to State.

☐ Yes ☐ No

Facility Fax

(Text)

Days of Operation

(Text)

Does this project have a Building Permit?

☐ Yes ☐ No

Building Permit Issued Date

☐ Non-Profit

Does the project include Private Well? If Yes, forward to WS Program.

☐ Yes ☐ No

Does the project include Food Services? If Yes, forward to FP Program.

☐ Yes ☐ No

Facility Phone

(Text)

Facility Email

(Text)

PROPERTY INFORMATION

Water Source

--Select--

Sewage Disposal

--Select--

Design Wastewater Flow

(Number)

Permit Type

--Select--

DEVELOPMENT PLANS

Property Type

Residential



Signature Required

☐ Yes ☐ No

Number of paper copies

0

(Number)

Number of buildable lots created

0

(Number)

Total Number of Lots

0

(Number)

Plan Version

Initial



Engineer

0

(Text)

Number of mylar copies

0

(Number)

Number of non-buildable lots created

0

(Number)

Associated Plans

WELL AND SEPTIC INTERNAL

State Review Required

☐ Yes ☐ No

Coordinate State Review

☐ Yes ☐ No

Proposed Septic System Type

--Select--

FOOD ESTABLISHMENT FACILITY

Priority Assessment

--Select--

Licensed Type

--Select--

License Category

--Select--

FOOD ESTABLISHMENT INFORMATION

Hours of Operation

(Text)

☐ Operating Seasonally Only

If Operating Seasonally, What is the start month?

(Text)

Are pets allowed in a outdoor seating area?

☐ Yes ☐ No

Full Bar?

☐ Yes ☐ No**RESTAURANT AND FOOD SERVICE**

Food Service Facility Secondary Category

--Select--

Total Seating Capacity

(Number)

Number of Restrooms

Interior Restaurant Seating Capacity

(Number)

Bar Seating Capacity

(Number)

Outdoor Seating Capacity

(Text)

(Text)

Does the restaurant have outdoor seating

☐ Yes ☐ No**EQUIPMENT**

Evaluated non NSF, ANSI, CF or other standards

☐ Yes ☐ No

Description of Refrigeration Units

Number of Walk-In Refrigerator Units

(Number)

Description of Walk-In Freezer Units

(Text)

Is there a bulk ice machine available

☐ Yes ☐ No

Space Limitation

Number of Hand Sinks Available

(Number)

Hood System

(Text)

Ventless Equipment

(Text)

PLUMBING

Size and installation of the water heater?

(Text)

Is there a grease interceptor or grease trap?

--Select--

REFUSE AND RECYCLABLES

Dumpsters Located on a impervious surface?

--Select--

Will there be a grease receptacle?

--Select--

WAREWASHING DISHWASHING

Dishwashing Method

--Select--

HACCP

Plan Review Response Letter Received

☐ Yes ☐ No

Date HACCP Approved by the State

Date HACCP Plan Submitted

HACCP Plan Approved

HACCP Plan Review

Plan Review Letter Mailed

HACCP Plan Revision Submitted

HACCP Fee Type

--Select--

FINISHING SCHEDULE

Kitchen Floor / Bar Flooring

--Select--

Kitchen Cove Base

--Select--

Realm Title Agency



PROPERTY ADDRESS: 10304 CASTLEFIELD STREET, ELLICOTT CITY, MARYLAND 21042

SURVEY NUMBER: 2503.3041


2503.3041
LOCATION DRAWING
HOWARD COUNTY



GRAPHIC SCALE (In Feet)

1 inch = 100' ft.


ACCURACY=1'±

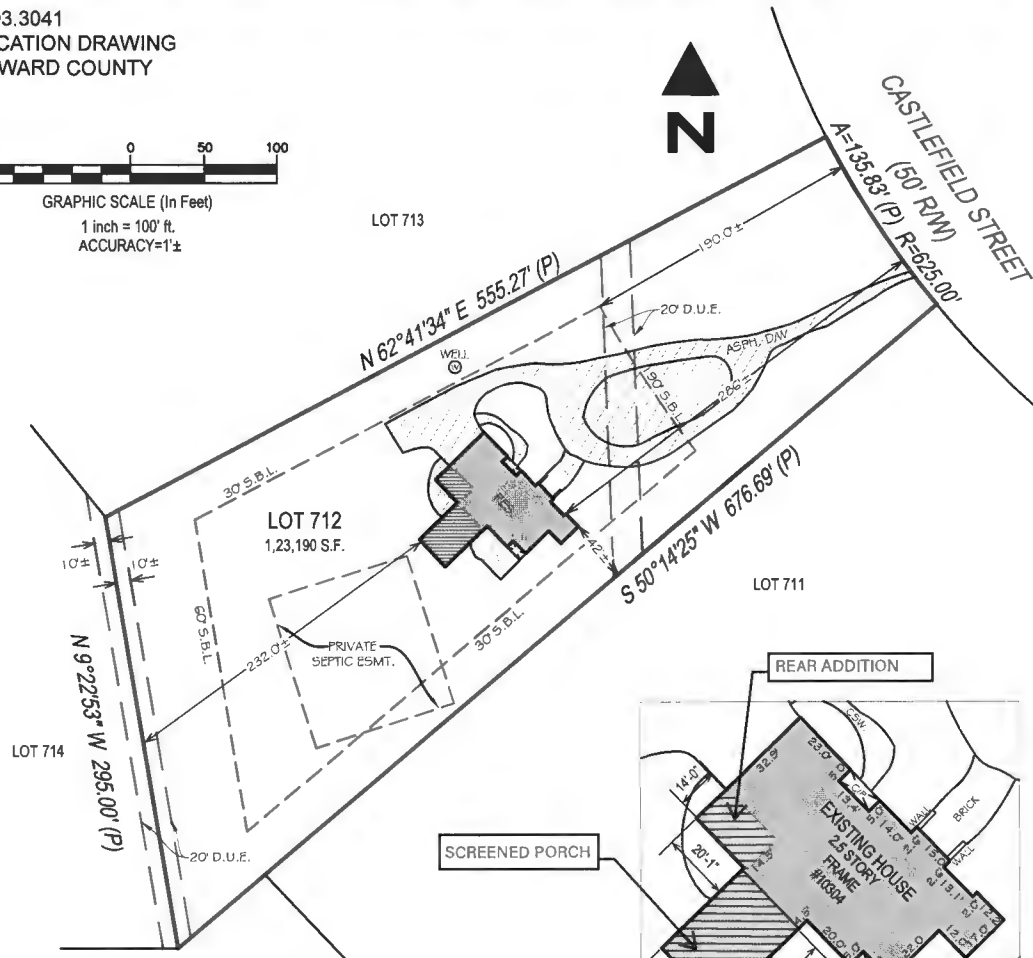

PLEASE NOTE

Per Maryland State Code, Sec. 09.13.06.05, this House Location Drawing is not to be relied upon to determine property boundaries or the establishment or location of existing or future improvements.

LOT 715

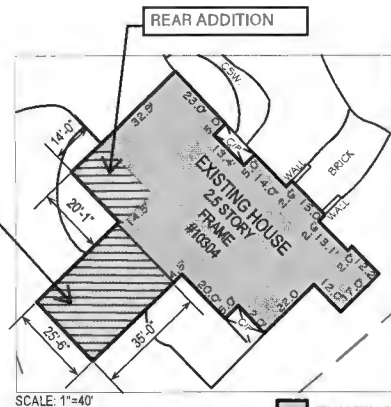

EXISTING
ADDITION



WILLIAM R. HEBERT

State of Maryland Property Line Surveyor
License Number 483 | Expires 3/14/2027

SURVEYORS CERTIFICATION:

THE INFORMATION SHOWN HEREON HAS BEEN BASED UPON THE RESULTS OF A FIELD INSPECTION PURSUANT TO THE DEED OR PLAT OF RECORD. THIS PLAT WAS PREPARED UNDER MY DIRECT SUPERVISION IN ACCORDANCE WITH C.O.M.A.R. SECTION 09.13.06.06 AS NOW ADOPTED BY THE MARYLAND BOARD FOR PROFESSIONAL LAND SURVEYORS AND IS OF BENEFIT TO A CONSUMER ONLY INsofar AS IT IS REQUIRED BY A LENDER OR A TITLE COMPANY IN CONNECTION WITH CONTEMPLATED TRANSFER, FINANCING OR REFINANCING THE PROPERTY DEPICTED HEREON.

POINTS OF INTEREST:

NONE VISIBLE



Exacta Land Surveyors, LLC
LB#21997
office: 443.819.3994
4424 Ventura Way, Apt L | Aberdeen, MD 2100



SurveySTAR

DATE SIGNED: 03/19/25

FIELD WORK DATE: 3/18/2025

REVISION DATE(S): (REV.1 3/19/2025)

SEE PAGE 2 OF 2 FOR LEGAL DESCRIPTION
PAGE 1 OF 2 - NOT VALID WITHOUT ALL PAGES