

\*\*\*\*\*  
 WATER WELL ABANDONMENT-SEALING REPORT FORM  
 \*\*\*\*\*

SUBMIT COPIES OF COMPLETED FORM TO:

- \* COUNTY ENVIRONMENT AGENCY (contact MDE, WMA if address needed)
- \* WELL OWNER
- \* MDE, WATER MANAGEMENT ADMINISTRATION, WELL PROGRAM

DATE WELL ABANDONED: 10/12/94 (month/day/year)

HD 73 2822

\* PERMIT NUMBER OF ABANDONED WELL (if any)

\* PERMIT NUMBER OF REPLACEMENT WELL


\* PERSON ABANDONING WELL: Don Collison, PERCO WELL DRILLERS LICENSE NUMBER: \_\_\_\_\_

\* OWNER'S NAME: PERCO (Formerly J. Kugler - Waterman Loomis Co.)

\* WELL LOCATION: 7625 Brown's Bridge Rd

COUNTY: Howard  
 NEAREST TOWN: Fulton  
 TAX MAP 40 BLOCK 24 PARCEL 250  
 SUBDIVISION: Waterman Estates  
 SECTION: \_\_\_\_\_ LOT: OLD 10  
NEW 22

MARYLAND GRID COORDINATES  
 BOX NUMBER E 815  
 N 481

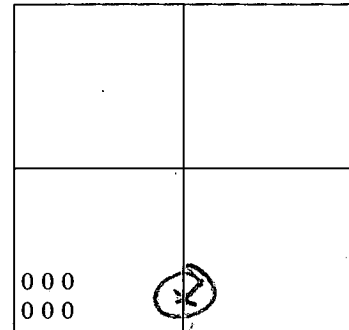

SHOW WELL LOCATION BY X WITHIN BOX

\* TYPE OF WELL BEING ABANDONED:

- DRILLED
- BORED/AUGURED
- OTHER (specify) \_\_\_\_\_
- JETTED
- HAND DUG

USE CODE:

- DOMESTIC
- IRRIGATION
- TEST/OBSERVATION
- MUNICIPAL/PUBLIC
- INDUSTRIAL

\* TYPE OF CASING:

- STEEL
- CONCRETE
- PLASTIC
- OTHER (specify) \_\_\_\_\_

\* SIZE OF CASING: 6 INCHES IN DIAMETER

\* DEPTH OF WELL: 200 FEET DEEP

\* WAS ANY CASING REMOVED?  YES \_\_\_\_\_ NO  
 if yes, length removed, in feet: 5

\* WAS CASING RIPPED OR PERFORATED? \_\_\_\_\_ YES  NO

LOG OF SEALING MATERIAL

MATERIAL	FEET	
	FROM	TO
2500 psi pea stone mix concrete back fill	200	3
	3	0

SIGNATURE - MASTER WELL DRILLER OR SUPERVISING SANITARIAN: Mark E. Riffin LICENSE # \_\_\_\_\_ DATE: 10/13/94