

Early PM
7/15/92
7/25/92

PERMIT

05-410-150

SEWAGE DISPOSAL SYSTEM

P 4P30R

A 38688

DEPARTMENT OF HEALTH AND MENTAL HYGIENE

INDEX - TIME EXPIRED

DISTRICT 5th

HOWARD COUNTY HEALTH DEPARTMENT

BUREAU OF ENVIRONMENTAL HEALTH

461-9933

FOR F.C.O.P. COMPLIANCE

DATE 4/30/92

DATE SYSTEM APPROVED 8/17/92

INDEXED

INSPECTOR C. Williams

Fogle's Septic Clean, Inc.

IS PERMITTED TO INSTALL X ALTER

ADDRESS 558R Obrecht Road, Sykesville, Maryland 21784

PHONE 795-5670

SUBDIVISION Fox Run Estates

LOT 2

ROAD 4507 Taraley Court

PROPERTY OWNER

Williamsburg Builders

Bill Davis

P. O. Box 1018

ADDRESS

Columbia, Maryland 21045

SEPTIC TANK CAPACITY 1500 GALLONS

BUILDING PERMIT SIGNED

AND RETURNED

NUMBER OF BEDROOMS 5

4/21/04 ROBERTS - FINISH BASEMENT

240 SQUARE FEET PER BEDROOM

LINEAR FEET OF TRENCH REQUIRED 400

TRENCHES - Trench to be 3 feet wide. Inlet 2 feet below original grade. Bottom maximum depth 4 feet below original grade. Effective area begins at 2 feet below original grade. 2 feet of stone below distribution pipe.

LOCATION - Place distribution box 120 feet from the right-front (315') lot line and 110 feet from right-rear lot line which borders Lot 4. Run trenches along contour toward Taraley Court. ok/cw

PLANS APPROVED BY C. Williams

REVISED DATE 5/06/92

COVER NO WORK UNTIL INSPECTED AND APPROVED

NEITHER THE HOWARD COUNTY COUNCIL NOR THE HEALTH DEPARTMENT IS RESPONSIBLE FOR THE SUCCESSFUL OPERATION OF ANY SYSTEM

NOTE: CLEANOUT REQUIRED EVERY 70 FEET OF SEWER LINE AND/OR AT 90° SWEEPS IN LINES FROM HOUSE TO DRAIN FIELDS, 90° ELBOWS NOT ACCEPTABLE.

NOTE: ALL PARTS OF SEPTIC SYSTEMS (I.E. TANK, DISTRIBUTION BOX TRENCHES) TO BE 100 FEET FROM WELL (UNLESS OTHERWISE SPECIFICALLY AUTHORIZED)

NOTE: IF DEEP TRENCH(ES) ARE USED CALL FOR INSPECTION BEFORE AND AFTER PLACING GRAVEL IN TRENCH(ES)

NOTE: NO DRY WELL SHALL EXCEED 15 FOOT IN DIAMETER NO ABSORPTION TRENCH TO EXCEED 100 FEET IN LENGTH

NOTE: ALL PIPE FROM HOUSE TO SEPTIC TANK MUST BE CAST IRON OR SCHEDULE 35/40 PVC OR ABS

BLDG. PERMIT SIGNED

AND RETURNED

PERMIT VOID AFTER TWO YEARS

Serial # 58638

NOTE: INSTALL STAND PIPE ON SEPTIC TANK AND DRY WELL STAND PIPES MUST BE 6 INCHES IN DIAMETER CAST IRON, CONCRETE OR TERRA COTTA OR PVA OR ABS ACCEPTED. IF TOP OF SEPTIC TANK IS DEEPER THAN 3 FEET, MANHOLE TO GRADE REQUIRED. Ground print


NOTE: DISTRIBUTION BOXES MUST HAVE BAFFLES

***INSTALLER IS RESPONSIBLE FOR OBTAINING FINAL APPROVAL ON THIS PERMIT**

HD-260(6-90)

*CALL 461-9933 FOR INSPECTION OF SEPTIC SYSTEM.

A
38688

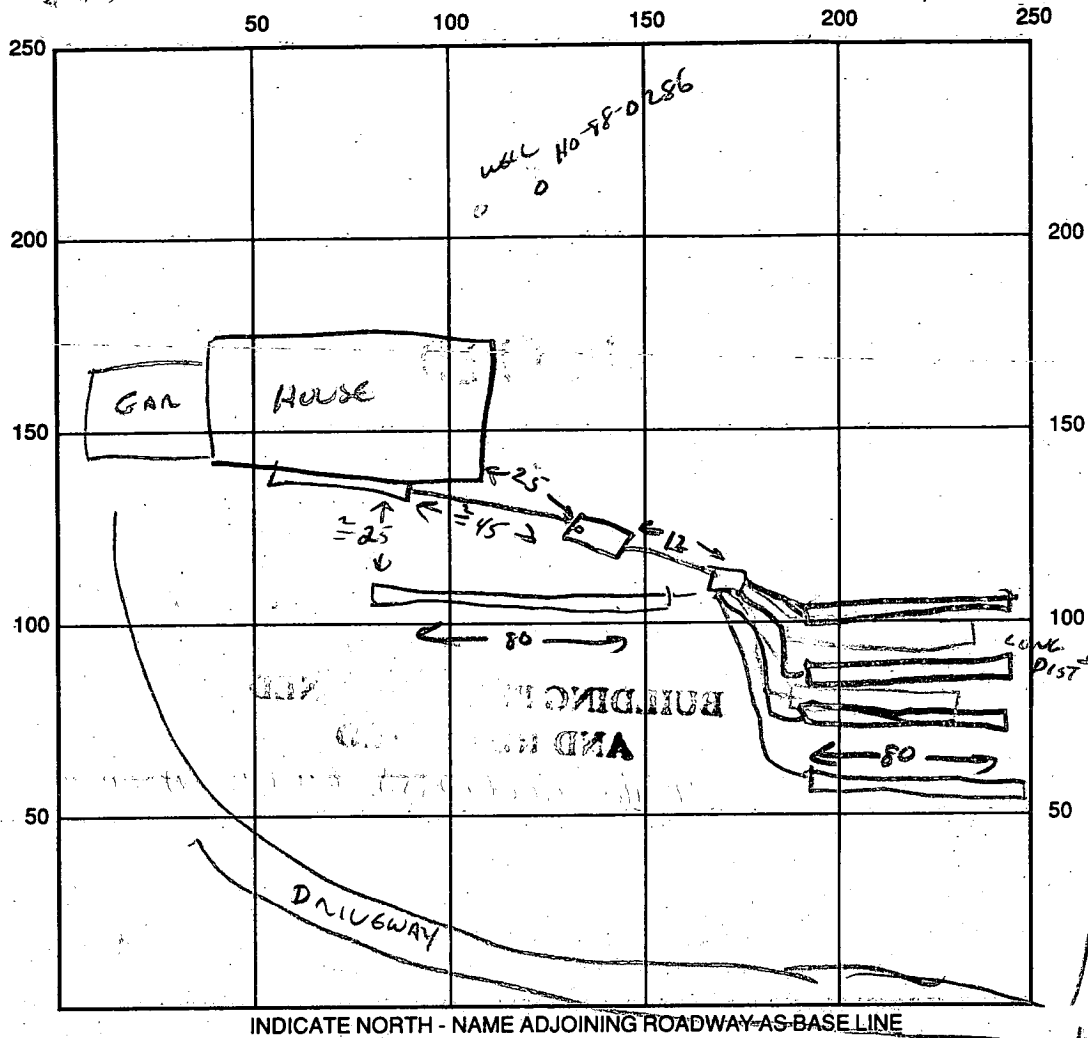

SEPTIC TANK LEVEL 1500 G ✓ CLEANOUTS 57 ✓

DISTRIBUTION BOX LEVEL ✓

DRAIN FIELD/TITLE DEPTH 4 FT. TRENCH WIDTH 3 FT. INLET DEPTH 2 FT.

EFFECTIVE GRAVEL DEPTH 2 FT. TOTAL LENGTH 400 FT.

NUMBER OF TRENCHES 5 (a) 80' ONE SIDEWALL/BOTTOM AREA 1200 SQ. FT.

DRYWALL INSIDE DIAMETER — FT. EFFECTIVE DEPTH BELOW INLET — FT.

ABSORBENT AREA — SQ. FT.

REMARKS: 7/15/92 33 TRENCHES INSTALLED, OK TO COMPLETE 4TH TRENCH & COVER CW,
FINAL TRENCH INSTALLED BY CONTRACTOR 7/25/92 (NOT INSPECTED)

DATE SYSTEM APPROVED 8/17/92 INSPECTOR C. Williams

APPLICATION

PERCOLATION TESTING

HOWARD COUNTY HEALTH DEPARTMENT
BUREAU OF ENVIRONMENTAL HEALTH
P.O. BOX 476 ELLICOTT CITY, MARYLAND 21043
TELEPHONE: 461-9933

A 38688

P _____

DISTRICT 5

DATE 2-10-87

TO: THE COUNTY HEALTH OFFICER
ELLICOTT CITY, MARYLAND

I, HEREBY, APPLY FOR THE NECESSARY TEST IN ORDER TO CONSTRUCT (OR RECONSTRUCT) A SEWAGE DISPOSAL SYSTEM.

PROPERTY OWNER Fox Run Estates Inc Williamsburg Builders
Miller Built Corporation

ADDRESS 4649 SHEPPARD LANE ELLICOTT CITY 21043 PHONE 596-2023
596-9730 997-8800

PROSPECTIVE BUYER N/A

ADDRESS _____ PHONE _____

PROPERTY LOCATION:

SUBDIVISION FOX RUN ESTATES LOT NO. 166 LOT 2
LOT 3

ROAD AND DESCRIPTION TARALEY COURT AT SHEPPARD LANE 4507 Taraley Court

TAX MAP 28 PARCEL # 51

SIZE OF LOT 3+ ACRES TYPE BLDG RESIDENTIAL
(SINGLE FAMILY DWELLING OR COMMERCIAL)

THE SYSTEM INSTALLED UNDER THIS APPLICATION IS ACCEPTABLE ONLY UNTIL PUBLIC FACILITIES BECOME AVAILABLE. I FULLY UNDERSTAND THE
FEE CONNECTED WITH THE FILING OF THIS PERC TEST APPLICATION IS NON-REFUNDABLE UNDER ANY CIRCUMSTANCES. I ALSO AGREE TO COMPLY
WITH ALL M.O.S.H.A. REQUIREMENTS IN TESTING THIS LOT.

(SIGNATURE OF APPLICANT)

APPROVED BY C. Wallin FOR SHALLON TROMMS DATE 11/23/88

REJECTED BY _____ FOR _____ DATE _____

HOLD PENDING FURTHER TESTS _____ DATE _____

REASONS FOR REJECTION OR HOLDING _____

BLDG. PERMIT SIGNED

AND RETURNED

Serial # 42017

SFD-5 Bums

BLDG. PERMIT SIGNED

AND RETURNED



Serial # 27937

SFD-4 Bums

THIS IS NOT A PERMIT

Holes 142

SOIL PROFILE

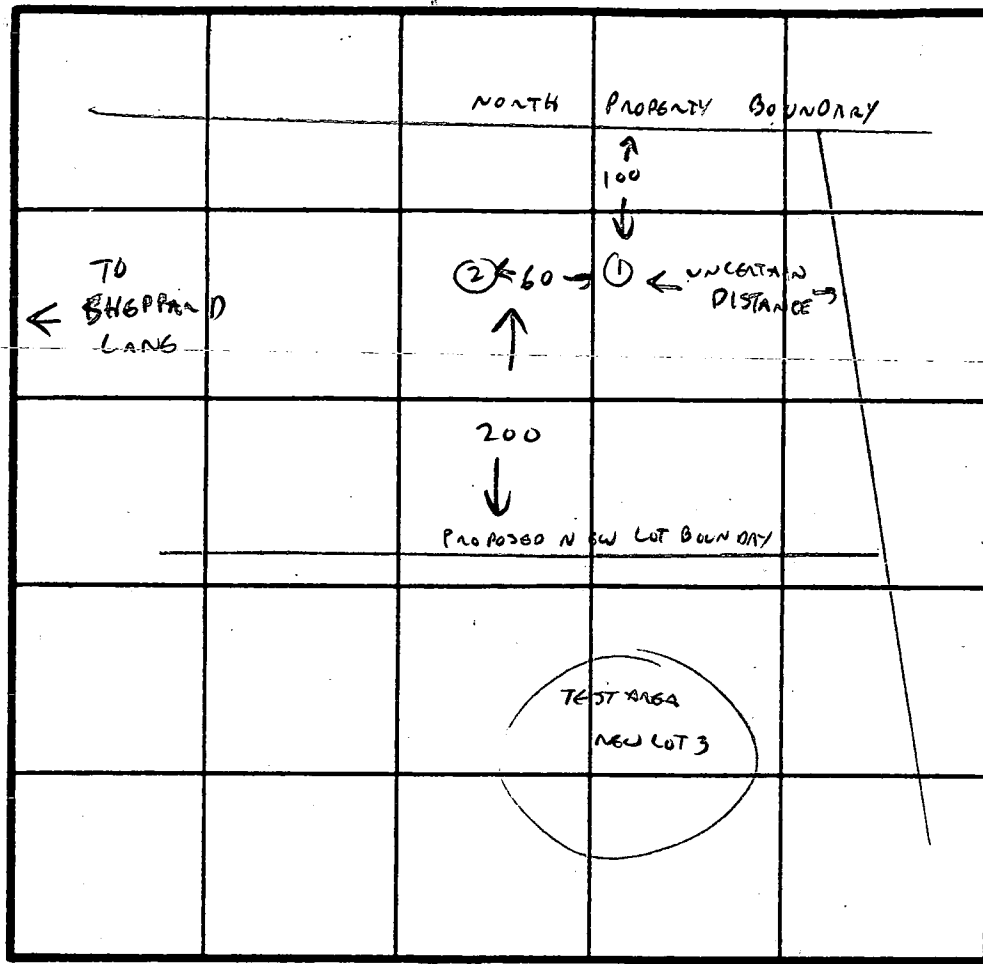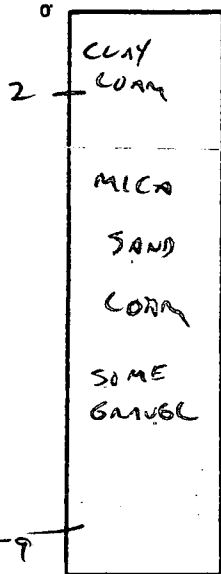

INDICATE NORTH - NAME ADJOINING ROADWAY AS BASE LINE.

DATE	TEST NO.	DEPTH	PRE-WET		TEST - 1" DROP		TIME
			START	STOP	START	STOP	
5/27/88	1	3 VIS OK	3-9'				VIS OK
		6 9					
	2	2 1/2	2:42	2:46	2:46	2:51	5 MIN
		6 8 VIS OK	2-9'				
	SEE	A 386 89	FOR TESTS NEAR COMMON LOT BOUNDARY.				

REMARKS

BACK HOG NO LONGER ON SITE - HOLES NOT EXCAVATED D66P

TYPE OF SOIL

MICA LOAM - OK FOR SHALLOW SYSTEM ONLY

TESTED BY

CW [Signature]

ALSO PRESENT

?

APPLICATION

PERCOLATION TESTING

A 46959

P _____

HOWARD COUNTY HEALTH DEPARTMENT
BUREAU OF ENVIRONMENTAL HEALTH
P.O. BOX 476 ELLICOTT CITY, MARYLAND 21043
TELEPHONE: 461-9933

PERMISSION OK.

PROPOSED ADJUSTMENT
MAY HAVE WATER TABLE
PROBLEMS.

DISTRICT _____

DATE 4/2/91

IF SO, TEST UPHILL TO

CONSIDER ALL DESIGN OPTIONS
EVEN IF WELL IS FORFEITED.

3/26/91 CWL

TO: THE COUNTY HEALTH OFFICER
ELLICOTT CITY, MARYLAND

I, HEREBY, APPLY FOR THE NECESSARY TEST IN ORDER TO CONSTRUCT (OR RECONSTRUCT) A SEWAGE DISPOSAL SYSTEM.

PROPERTY OWNER _____

ADDRESS _____ PHONE _____

PROSPECTIVE BUYER Richard & Thelma McPeters

ADDRESS 6526 Think Hollow Rd PHONE 301-596-9352

Nashland, Md 20777

PROPERTY LOCATION:

SUBDIVISION Soy Run Estates LOT NO. 2

ROAD AND DESCRIPTION Taralee Ct

TAX MAP _____ PARCEL # _____

SIZE OF LOT _____ TYPE BLDG. _____
(SINGLE FAMILY DWELLING OR COMMERCIAL)

THE SYSTEM INSTALLED UNDER THIS APPLICATION IS ACCEPTABLE ONLY UNTIL PUBLIC FACILITIES BECOME AVAILABLE. I FULLY UNDERSTAND THE
FEE CONNECTED WITH THE FILING OF THIS PERC TEST APPLICATION IS NON-REFUNDABLE UNDER ANY CIRCUMSTANCES. I ALSO AGREE TO COMPLY
WITH ALL M.O.S.H.A. REQUIREMENTS IN TESTING THIS LOT.

(SIGNATURE OF APPLICANT)

APPROVED BY _____ FOR _____ DATE _____





REJECTED BY CWL FOR ADJUSTMENT TO S.D.A DATE 4/1/91

HOLD PENDING FURTHER TESTS _____ DATE _____




REASONS FOR REJECTION OR HOLDING WATER TABLE AND/OR CLAY AT ALL LOCATIONS TESTED.

SEPTIC AREA TO REMAIN AS LEAST AS HIGH ON LOT AS ORIGINALLY PLATTED.

THIS IS NOT A PERMIT

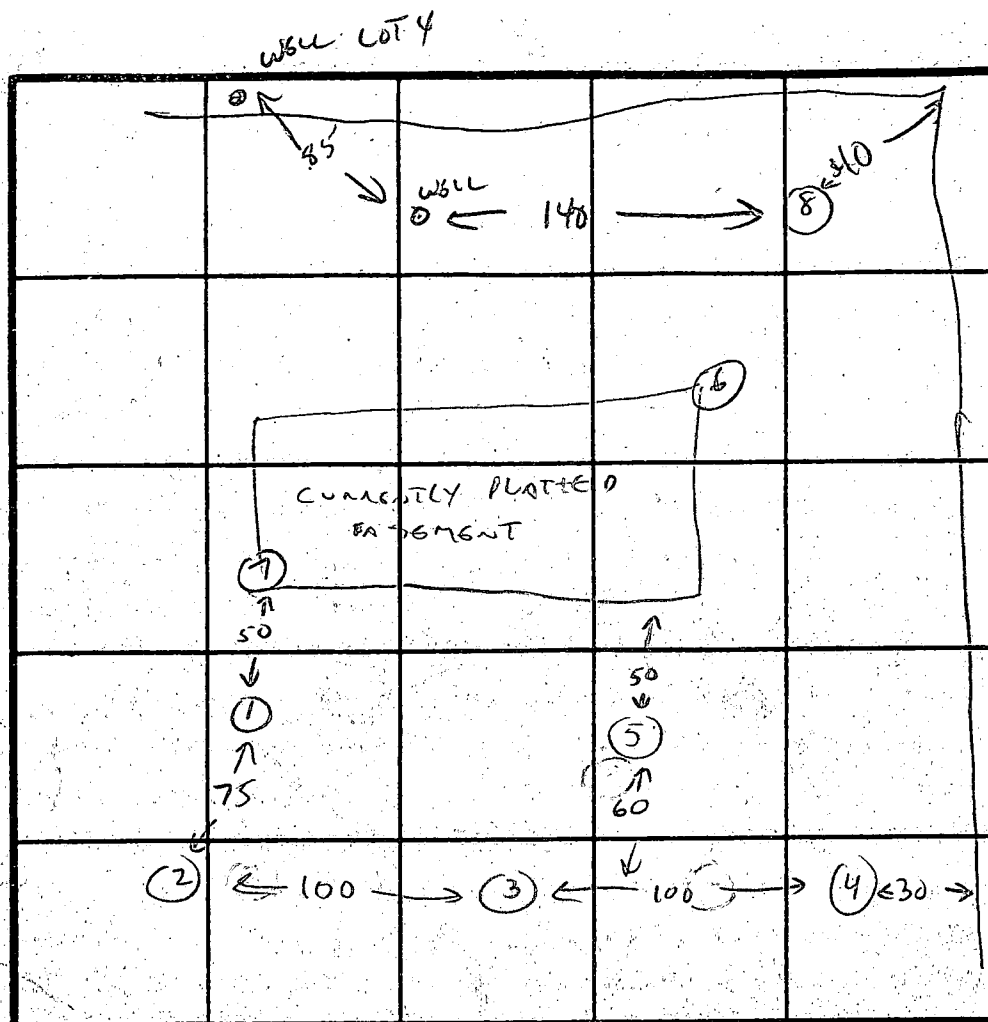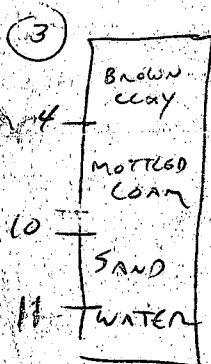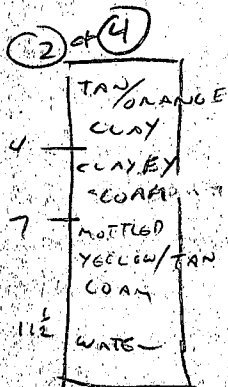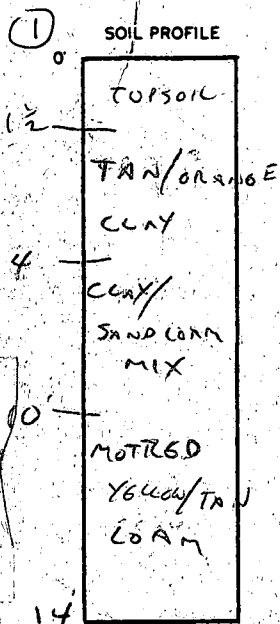

INDICATE NORTH - NAME ADJOINING ROADWAY AS BASE LINE.

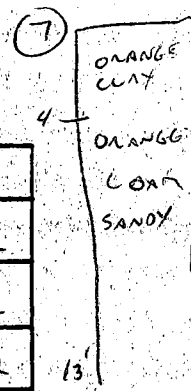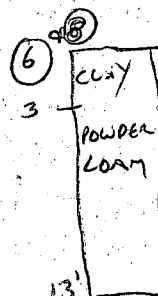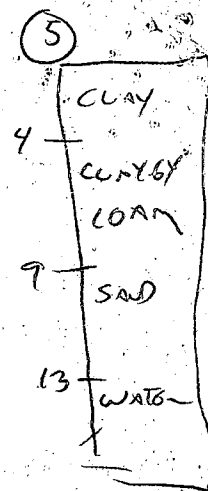



DATE	TEST NO.	DEPTH	PRE-WET		TEST - 1" DROP		TIME
			START	STOP	START	STOP	
4/11/91	1	CLAY TO 4', CLAYEY TO 10'			MOTTLES BELOW		FAIL
	2	CLAY TO 7'			MOTTLES + WATER BELOW		FAIL
	3	CLAY TO 4'			MOTTLES + WATER BELOW		FAIL
	4	SIMILAR TO #2					FAIL
	5	CLAY TO 4' CLAYEY TO 9'					FAIL
	6	OK 3-13'			PART OF ORIGINAL AREA		OK
	7	OK 4-13'			PART OF ORIGINAL AREA		OK
	8	SIMILAR TO #6					OK

REMARKS ALL AREA $\geq$ ELEVATION OF ORIGINAL TEST AREA OK,
ALL AREA $<$ ELEVATION OF ORIGINAL TEST AREA FAILS

TYPE OF SOIL APPLICANT TO CONSIDER DESIGN OPTIONS, SUBMIT PROPOSAL.

TESTED BY C. Williams ALSO PRESENT MS DIPIETRO



NOTE: Basement will not
sewer by gravity.

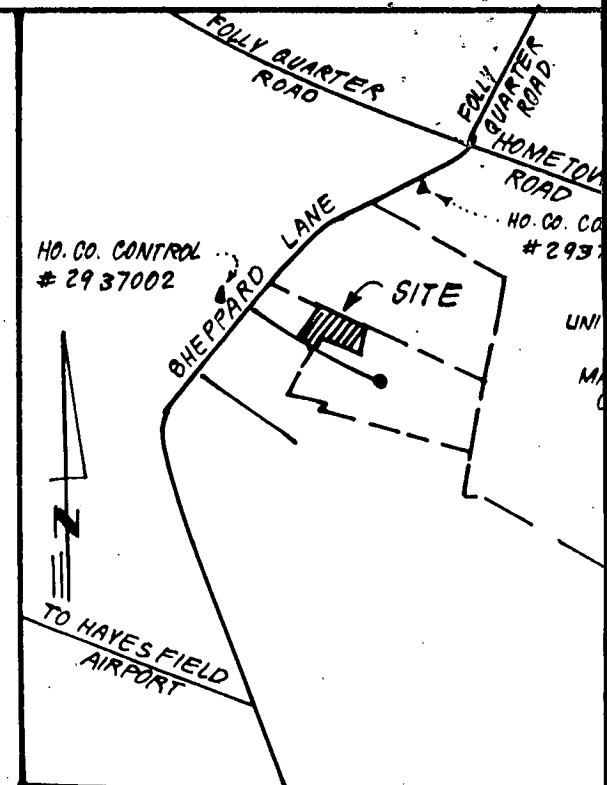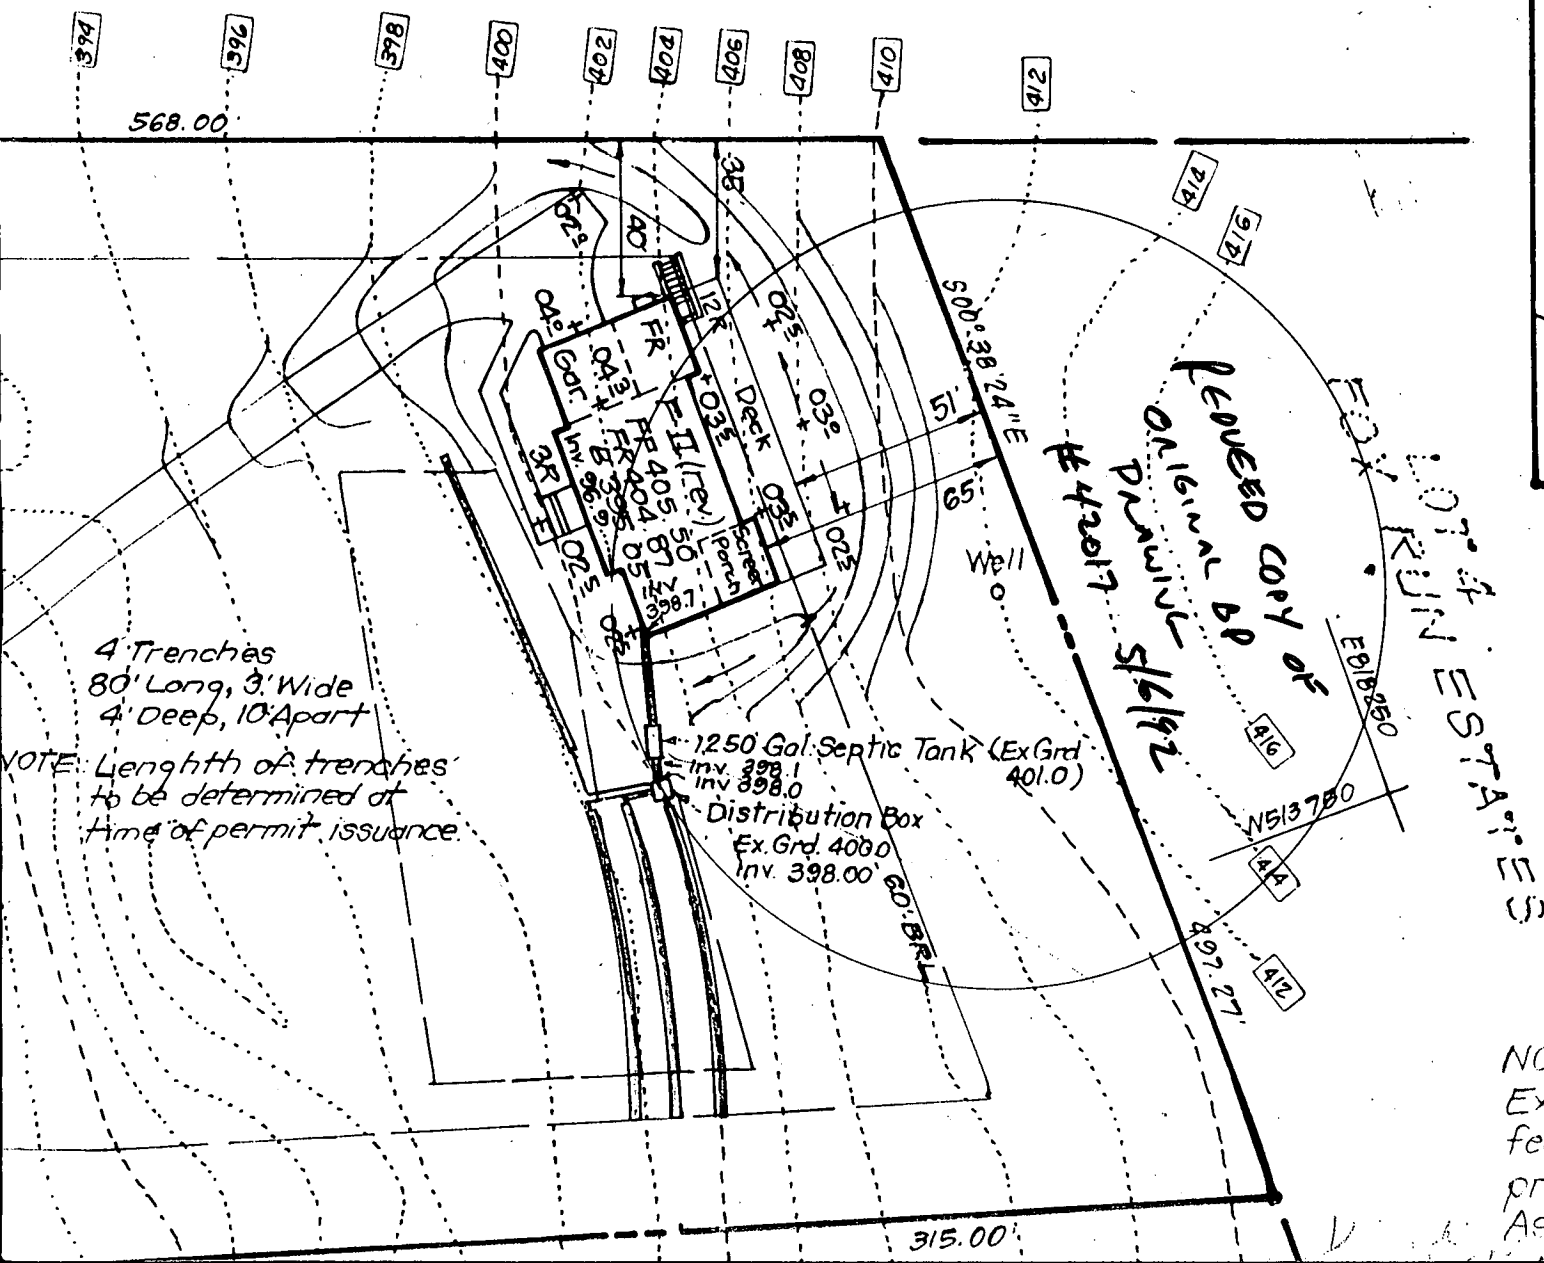

VICINITY MAP

SCALE: 1" = 2000'

NOTE:
Existing topography & other existing features were taken from plans prepared by Light, Elliott, & Associates Inc.

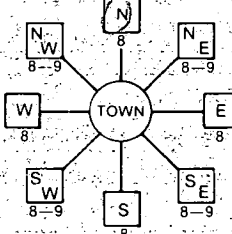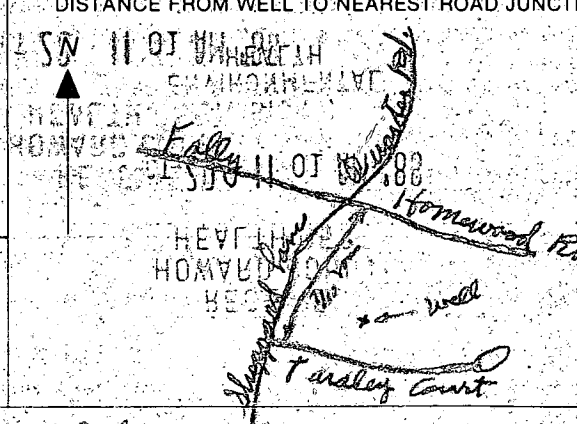B 1 7921 (THIS NUMBER IS TO BE PUNCHED IN COLS. 3-6 ON ALL CARDS)	SEQUENCE NO. (DP. USE ONLY)	STATE OF MARYLAND PERMIT TO DRILL WELL please print or type	STATE PERMIT NUMBER 40-88-0286 fill in this form completely
OWNER INFORMATION Date Received (APA) 102088 15 Last Name 13 First Name 34 J + S L M V E S F M E N T C O R P . 36 Street or RFD 55 E L L I C T F C L F Y M D 2 1 0 4 3 57 Town 70 State 72 Zip 76		LOCATION OF WELL B 3 1 2 H O W A R D 8 COUNTY 21 F O X R W E S T A T E S 23 SUBDIVISION 42 SECTION 44 46 LOT 48 50 C L A R K S V I L L E 52 NEAREST TOWN 71 MILES FROM TOWN (enter 0 if in town) 2 73 M 76 77 78	
DRILLER INFORMATION Driller's Name 77 License No. 80 Joseph L. Mayne 233 Firm Name Joseph L. Mayne Well Drilling Address 5512 Ridge Rd. Mt. Airy 21771 Signature 10/30/88 Date		DIRECTION OF WELL FROM TOWN (CIRCLE BOX)  NEAR WHAT ROAD H A R L E Y C O U R T 11 30 ON WHICH SIDE OF ROAD (CIRCLE APPROPRIATE BOX) NORTH ☒ WEST ☐ EAST ☐ SOUTH ☐ 34 360 37 DISTANCE FROM ROAD ENTER FT or MI FF 38 39	
WELL INFORMATION APPROX. PUMPING RATE (GAL. PER MIN.) 5 8 12 AVERAGE DAILY QUANTITY NEEDED (GAL. PER DAY) 500 14 20		USE FOR WATER (CIRCLE APPROPRIATE BOX) ☒ HOME (SINGLE OR DOUBLE HOUSEHOLD UNIT ONLY) ☐ FARMING (LIVESTOCK WATERING & AGRICULTURAL IRRIGATION) ☐ INDUSTRIAL, COMMERCIAL, STATE AND FEDERAL GOV. OTHER (REQUIRES APPROPRIATION PERMIT) ☐ PUBLIC OR PRIVATE WATER COMPANY (REQUIRES APPROPRIATION, PERMIT AND STATE HEALTH DEPARTMENT APPROVAL) ☐ TEST, OBSERVATION, MONITORING (MAY REQUIRE APPROPRIATION PERMIT)	
APPROXIMATE DEPTH OF WELL 300 24 28 FEET APPROXIMATE DIAMETER OF WELL 6 INCH METHOD OF DRILLING (circle one) BORED (or Augered) JETTED Jetted & DRIVEN 30 AIR-ROTARY 37 AIR-PERCussion ROTARY (Hydraulic Rotary) CABLE REVERSE-ROTARY DRIVE-POINT other		NOT TO BE FILLED IN BY DRILLER HEALTH DEPARTMENT APPROVAL COUNTY NAME Howard COUNTY NO. A38658 STATE SIGNATURE DATE ISSUED 11/14/88 CO SIGNATURE 5/11/89 NORTH GRID 514000 EAST GRID 0817000 43 48 55 57 63	
REPLACEMENT OR DEEPEMED WELLS (CIRCLE APPROPRIATE BOX) ☒ THIS WELL WILL NOT REPLACE AN EXISTING WELL ☐ THIS WELL WILL REPLACE A WELL THAT WILL BE ABANDONED AND SEALED 39 ☐ THIS WELL WILL REPLACE A WELL THAT WILL BE USED AS A STANDBY ☐ THIS WELL WILL DEEPEM AN EXISTING WELL PERMIT NUMBER OF WELL TO BE REPLACED OR DEEPEMED (IF AVAILABLE) 41 52		SHOW MAJOR FEATURES OF BOX & LOCATE WELL WITH AN X SOURCES OF DRILLING WATER 1. WELL 2. 3. WRITE THE BOX NUMBER FROM THE MAP HERE E 810 7 N 510 4 000 000 DRAW A SKETCH BELOW SHOWING LOCATION OF WELL IN RELATION TO NEARBY TOWNS AND ROADS AND GIVE DISTANCE FROM WELL TO NEAREST ROAD JUNCTION. 	
Not to be filled in by driller (OEP USE ONLY) APPROP. PERMIT NUMBER 54 GAP 63 FORCE C W WRITE INITIALS IN BOX PERMIT No. 40-88-0286 70 71 72 73 74 75 76 77 78 79 SPECIAL CONDITIONS COUNTY			

12/5/88

- ① 120 FT casing
- ② LOCATION OK
- ③ OVER 50 FT OPEN HOLE
MEASURED WITH A STRING
- ④ 16 Bags
- ⑤ Well OK

RECORDED
HOWARD COBB
HEALTH DEPT
JAN 10 1989

C1 6624 SEQUENCE NO. (DENV USE ONLY)
1-2 3 6
(THIS NUMBER IS TO BE PUNCHED
IN COLS. 3-6 ON ALL CARDS)

STATE OF MARYLAND
WELL COMPLETION REPORT
FILL IN THIS FORM COMPLETELY
PLEASE PRINT OR TYPE

THIS REPORT MUST BE SUBMITTED WITHIN
45 DAYS AFTER WELL IS COMPLETED.

COUNTY
NUMBER A 38688

DATE Received

DATE WELL COMPLETED

Depth of Well

PERMIT NO.
FROM "PERMIT TO DRILL WELL"

8 13

120588

22 400 26
(TO NEAREST FOOT)

28 29 30 31 32 33 34 35 36 37
H0-88-0286

OWNER JAS INVESTMENT last name first name TOWN CLARKVILLE
STREET OR RFD TALLEY COURT
SUBDIVISION Fox Run Estates SECTION LOT 2

WELL LOG

Not required for driven wells

STATE THE KIND OF FORMATIONS
PENETRATED, THEIR COLOR, DEPTH,
THICKNESS AND IF WATER BEARING

DESCRIPTION (Use additional sheets if needed) FEET Check if water bearing
FROM TO

SAND 0 114
GRAY MICH 114 400
ROCK

GROUTING RECORD

WELL HAS BEEN GROUTED

(Circle Appropriate Box)

TYPE OF GROUTING MATERIAL

CEMENT CM BENTONITE CLAY BC

NO. OF BAGS 16 NO. OF POUNDS 1504

GALLONS OF WATER 96

DEPTH OF GROUT SEAL (to nearest foot)

from 0 ft. to 50 ft.
(enter 0 if from surface)

CASING RECORD

casing types insert appropriate code below

ST CO
STEEL CONCRETE
PL OT
PLASTIC OTHER

MAIN CASING TYPE Nominal diameter top (main) casing (nearest inch) Total depth of main casing (nearest foot)

51 6 120

OTHER CASING (if used) diameter inch depth (feet) from to

SCREEN RECORD

screen type or open hole insert appropriate code below

ST BR HO
STEEL BRASS OPEN HOLE
PL OT
PLASTIC OTHER

C2 DEPTH (nearest ft.)
1 118 400
2 23 24 26 30 32 36
3 38 39 41 45 47 51

SLOT SIZE 1 2 3

DIAMETER OF SCREEN 56 60 (NEAREST INCH)

GRAVEL PACK from to
IF WELL DRILLED WAS FLOWING WELL INSERT F IN BOX 68

OEP USE ONLY (NOT TO BE FILLED IN BY DRILLER)

T (E.R.O.S.) WQ
70 72 74 75 76
TELESCOPE CASING LOG INDICATOR OTHER DATA

C 3

PUMPING TEST

HOURS PUMPED (nearest hour) 6

PUMPING RATE (gal. per min. to nearest gal.) 34

METHOD USED TO MEASURE PUMPING RATE Bucket

WATER LEVEL (distance from land surface)

BEFORE PUMPING 43

WHEN PUMPING 216

TYPE OF PUMP USED (for test)

A air P piston T turbine
C centrifugal R rotary O other (describe below)
J jet S submersible

PUMP INSTALLED

DRILLER WILL INSTALL PUMP YES NO
IF DRILLER INSTALLS PUMP, THIS SECTION MUST BE COMPLETED FOR ALL WELLS EXCEPT HOME USE
TYPE OF PUMP INSTALLED PLACE (A,C,J,P,R,S,T,O) IN BOX - SEE ABOVE:

CAPACITY: GALLONS PER MINUTE (to nearest gallon) 31 35

PUMP HORSE POWER 37 41

PUMP COLUMN LENGTH (nearest ft.) 43 47

CASING HEIGHT (circle appropriate box and enter casing height)

LAND SURFACE 2 (nearest foot)

LOCATION OF WELL ON LOT
SHOW PERMANENT STRUCTURE SUCH AS BUILDING, SEPTIC TANKS, AND/OR LANDMARKS AND INDICATE NOT LESS THAN TWO DISTANCES (MEASUREMENTS TO WELL)



CIRCLE APPROPRIATE LETTER
A A WELL WAS ABANDONED AND SEALED WHEN THIS WELL WAS COMPLETED

E ELECTRIC LOG OBTAINED

P TEST WELL CONVERTED TO PRODUCTION WELL

I HEREBY CERTIFY THAT THIS WELL HAS BEEN CONSTRUCTED IN ACCORDANCE WITH COMAR 10.17.13 "WELL CONSTRUCTION" AND IN CONFORMANCE WITH ALL CONDITIONS STATED IN THE ABOVE CAPTIONED PERMIT, AND THAT THE INFORMATION PRESENTED HEREIN IS ACCURATE AND COMPLETE TO THE BEST OF MY KNOWLEDGE.

DRILLERS' IDENT. NO. 228

DRILLERS SIGNATURE
(MUST MATCH SIGNATURE ON APPLICATION)

SITE SUPERVISOR (sign. of driller or journeyman responsible for sitework if different from permittee)

COUNTY

Page of
 Date 10/5/88

Review OK 12/15/88 CW

FIELD DATA SHEET
HOWARD COUNTY WELL YIELD TEST

Well Permit No. HO - 88-0286
 Location of property (road) TARALBY COURT
 Subdivision FOX RUN ESTATES Lot 2 Block Plat Sec.
 Well Driller JOE MAYNE Owner JTS INVESTMENTS

Depth of well 400'
 Distance of measuring point (M.P.) above ground 2'
 Static water level (S.W.L.) below M.P. 43'

I. High rate pumping -- reservoir drawdown

Time pump started 8:00 Pumping rate 15 gpm.
 Total time 45 min. to reach pumping water level 213 ft. below M.P.

II. Recovery pump test data - observations to be recorded every 15 minutes

TIME (in 15 minute intervals)	WATER LEVEL below M.P.	PUMPING RATE time to fill 5 gallon bucket	FLOW METER READING (if used)	CALCULATED FLOW (gallons per minute)
8:15	131	4		15
8:30	216	4		15
8:45	213	21		2.8
9:00	213	21		2.8
9:15	213	21		2.8
9:30	210	21		2.8
9:45	208	19		3 1/4
10:00	208	19		3 1/4
10:15	208	19		3 1/4
10:30	208	19		3 1/4
10:45	208	19		3 1/4
11:00	208	19		3 1/4
11:15	208	19		3 1/4
11:30	208	19		3 1/4
11:45	208	19		3 1/4
12:00	208	19		3 1/4
12:15	208	19		3 1/4
12:30	208	19		3 1/4
12:45	208	19		3 1/4
1:00	208	19		3 1/4
1:15	208	19		3 1/4
1:30	208	19		3 1/4
1:45	208	19		3 1/4
2:00	208	19		3 1/4
HD-224: 15	208	19		3 1/4
2:30	208	19		3 1/4

7/17/92 A.M.
Angeline

HOWARD COUNTY HEALTH DEPARTMENT
Bureau of Environmental Health
3525-H Ellicott Mills Drive
Ellicott City, MD 21043
461-9933

7/17/92
10:00 CBY
OK
Final

APPLICATION FOR PITLESS ADAPTER, WELL PUMP AND PRESSURE TANK INSTALLATION

New Installation _____
Replacement _____

Receipt # _____
Date _____

Name of Installer VAN SANT

Telephone _____

License Number _____

Certified Well Pump Installer _____ Well Driller _____ Registered Plumber _____

Name of Property Owner _____

Telephone _____

Subdivision FOX RUN Lot # 20 Well Tag # HO - 88 - 0286

Site Address 4507 TARALEY COURT

Pump

1. Type
 - a. Deep well jet _____
 - b. Shallow well jet _____
 - c. Submersible _____

Motor

1. Horsepower _____
2. RPM _____
3. Voltage _____
 - a. 110 _____
 - b. 220 _____

Pitless Adapter

1. Make _____
2. Model # _____
3. Depth _____

2. Make _____
3. Model # _____

4. Capacity _____ GPM

5. Pump exceeds well capacity Yes _____ No _____

6. If Yes, is low pressure cutoff switch installed? Yes _____ No _____

7. What methods are used to protect the pump and electrical wiring from vibrations? Torque arrestors _____ Cable guards _____ Other _____

Tank

1. Capacity _____
2. Pressure relief valve? _____

Piping

1. Type _____
2. Size _____
3. NSF and/or BOCA Code approved _____
4. Depth of supply line _____

Well data

1. Depth _____ ft.
2. Yield _____ GPM
3. Static water level _____ ft.
4. Will water supply be disinfected by installer? _____

I understand that it is my responsibility to notify the Howard County Health Department when the installation is ready for inspection (otherwise this permit is null and void).

All information given above is true to the best of my knowledge.

Signature of Applicant: _____


Date: _____

Note: A sticker indicating approval/status of the installation will be placed on the well casing at the time of the inspection.

① card
② original white copy

HD-215

7/17/92 W.P.I. only C.B.S.

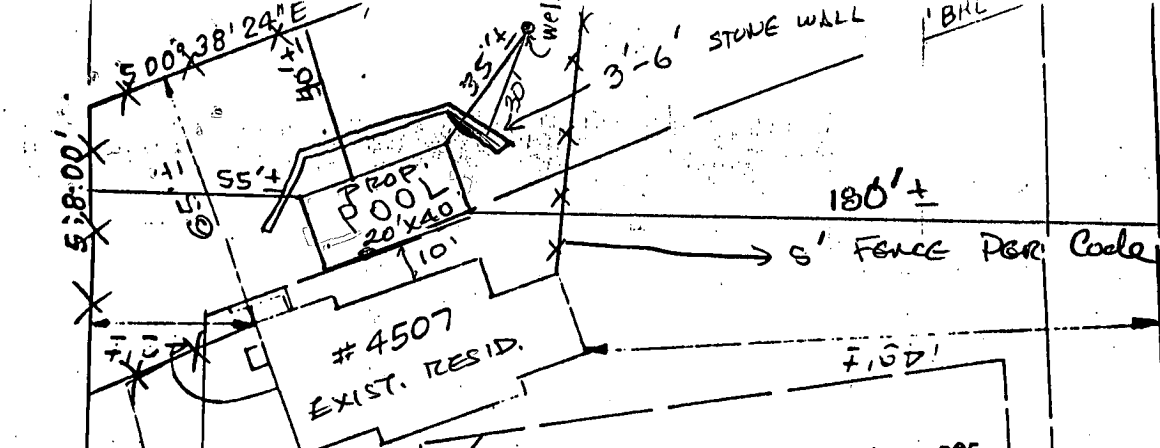

Private sewage Easement, as per Note No. 4 Plat No. 8357.

30' BRL

30' BRL

220.00' N 72° 50' 31" W

1" = 50'

LOT 3

E 817,750 N 51° 37' 50"

LOT 2
4.7515 Acres

3.23.95
Pool location
will have no impact
existing well and septic
OK to proceed
Amy McMullen

WILSON

N 69° 46' 15" W

227.93'

30' BRL

S 69° 46' 15" E

248.44'




195' BRL

187.67' N 35° 00' 38" E
E 817,500
N 14° 45' 15" E

TARALEY CRT.
100' ±

Drainage
No. 8359

LOT 1

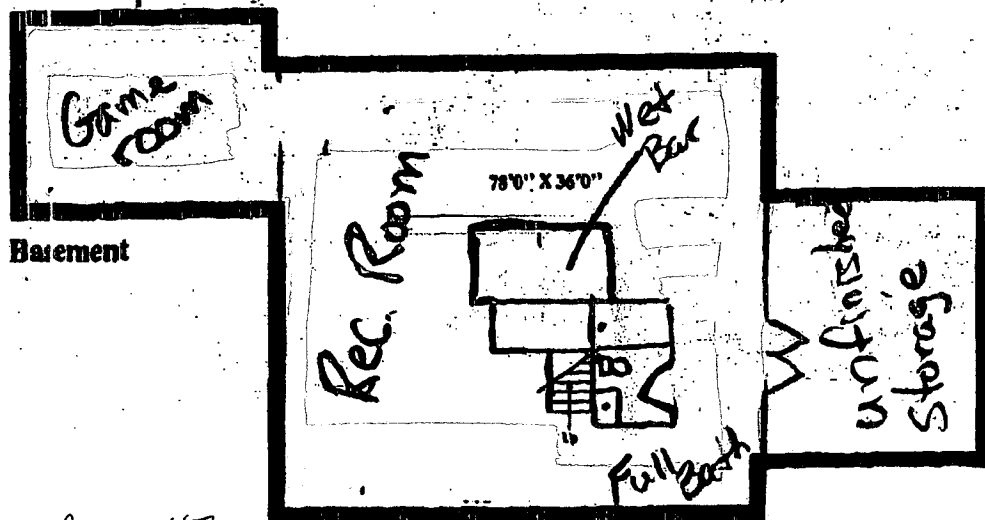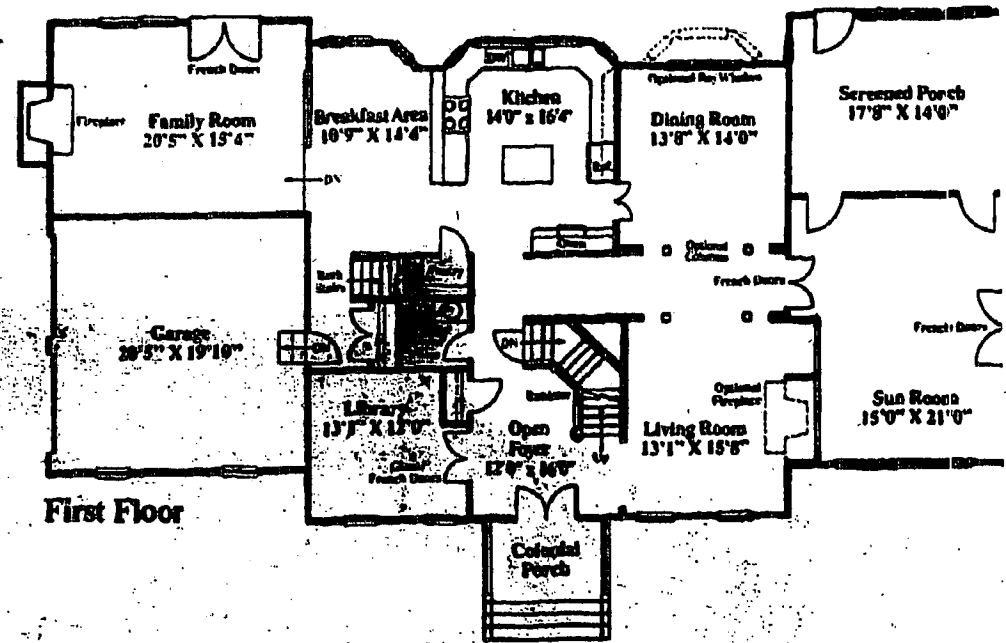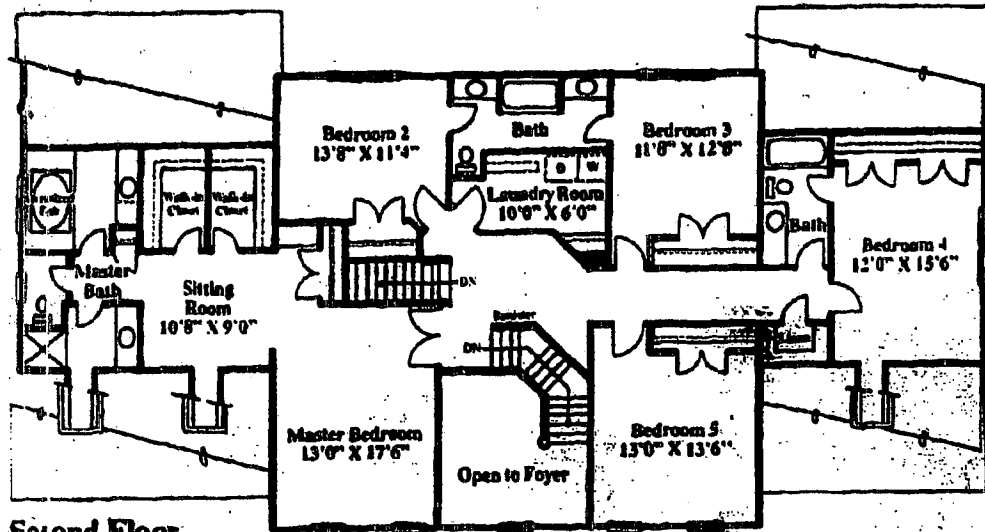

Mr. & Mrs. William Davis
 4507 Taralee Court
 Ellicott City MD 21042

Five-Bedroom, Two-Story Home Featuring Delightful Sun Room and Airy Screened Porch on First Floor. Elegant Living Room, Dining Room and Study. Formal Two-Story Entrance Hall, Gourmet Country Kitchen with Island Adjoining Breakfast Area with Bay Window, Family Room with Colonial Fireplace. Service Stairway to Second Floor off of Entry From Garage, Second Floor Laundry, Two-Car Garage, Full Basement, 3 1/2 Baths, 9' Ceilings on First Floor, Cedar Shake Roof and Colonial Porch.

All details and dimensions shown on these floor plans are approximate and subject to change. Illustrations are artist's concepts and may vary in details.

B00147558
APPROVED
 WALK-THRU BUILDING PERMIT
 BPAD Rights Reserved 1986 A# 38688
 APP. SAN MR. DATE: 4/21/04
 DESC. OF WORK: Bsm't
 alteration, no BL

The Henry Garrett II House

HOWARD COUNTY PERMIT APPLICATION

PERMIT NUMBER

000147558

Building Address 4507 Tarahay CT

Property Owner's Name WM. Davis

Address SAME

Suite/Apt. #: _____ SDP/WP/Petition #: _____

City _____ State _____ Zip Code _____

Census Tract _____ Subdivision Fox Run Est

Home Phone _____ Work Phone _____

Section _____ Area _____ Lot 2

Applicant's Name & Mailing Address, (if other than stated hereon):

Tax Map _____ Parcel _____ Grid _____

Zoning RC Map Coordinates _____ Lot size 4700

Phone _____ Fax _____

Existing Use _____

Contractor Company _____

Proposed Use _____

Contact Person _____

Estimated Construction Cost \$ 21000

Address _____

Description of Work Finish Bsmt

City _____ State _____ Zip Code _____

License No. _____

Phone _____ Fax _____

Occupant or Tenant _____

Engineer or Architect Company _____

Contact Name _____

Contact Person N/A

Address _____

Address _____

City _____ State _____ Zip Code _____

City _____ State _____ Zip Code _____

Phone _____ Fax _____

Phone _____ Fax _____

BUILDING DESCRIPTION - COMMERCIAL

BUILDING DESCRIPTION - RESIDENTIAL

Building Characteristics

Utilities

Height: _____
No. of stories: _____
Gross area, sq. ft. per floor: _____
Use group: _____
Construction type:
____ Reinforced Concrete
____ Structural Steel
____ Masonry
____ Wood Frame
____ State Certified Modular

Water Supply:
____ Public
____ Private
Sewage Disposal:
____ Public
____ Private
Electric Yes ☐ No ☐
Gas Yes ☐ No ☐
Heating System:
Electric ☐ Oil ☐
Natural Gas ☐
Propane Gas ☐
Sprinkler system: N/A ☐
____ Full
____ Partial
____ Other Suppression
____ # of Heads

Building Characteristics

Utilities

SF Dwelling ☒ SF Townhouse ☐
____ Depth ____ Width
1st floor: _____
2nd floor: _____
Basement: _____
Finished Basement ☐ Unfinished Basement ☐
Crawl space ☐ Slab on Grade ☐
No. of Bedrooms: _____
Multi-family dwellings:
No. of efficiency units: _____
No. of 1 BR units: _____
No. of 2 BR units: _____
No. of 3 BR units: _____
Other Structure: _____
Dimensions: _____
Footings: _____
Roof: _____
____ State Certified Modular
____ Manufactured Home

Water Supply:
____ Public
____ Private
Sewage Disposal:
____ Public
____ Private
Electric Yes ☐ No ☐
Gas Yes ☐ No ☐
Heating System:
Electric ☐ Oil ☐
Natural Gas ☐
Propane Gas ☐
Sprinkler system: N/A ☐
____ NFPA #13D
____ NFPA #13R
____ Other:

THE UNDERSIGNED HEREBY CERTIFIES AND AGREES AS FOLLOWS: (1) THAT HE/SHE IS AUTHORIZED TO MAKE THIS APPLICATION; (2) THAT THE INFORMATION IS CORRECT; (3) THAT HE/SHE WILL COMPLY WITH ALL REGULATIONS OF HOWARD COUNTY WHICH ARE APPLICABLE THERETO; (4) THAT HE/SHE WILL PERFORM NO WORK ON THE ABOVE REFERENCED PROPERTY NOT SPECIFICALLY DESCRIBED IN THIS APPLICATION; (5) THAT HE/SHE GRANTS COUNTY OFFICIALS THE RIGHT TO ENTER ONTO THIS PROPERTY FOR THE PURPOSE OF INSPECTING THE WORK PERMITTED AND POSTING NOTICES.

Applicant's Signature

Print Name

Title/Company

Date

Checks payable to: DIRECTOR OF FINANCE OF HOWARD COUNTY

** PLEASE WRITE NEATLY AND LEGIBLY. **

- FOR OFFICE USE ONLY -

AGENCY

DATE

SIGNATURE APPROVAL

DPZ SETBACK INFORMATION

PROPERTY ID#