

05-410177

PERMIT

SEWAGE DISPOSAL SYSTEM

MARYLAND STATE DEPARTMENT OF HEALTH

HOWARD COUNTY

BUREAU OF ENVIRONMENTAL HEALTH

461-9933

P 45648

A 38690

DISTRICT 5th

DATE 3/6/90

DATE SYSTEM APPROVED 3/2/90

INSPECTOR RH

INDEXED

Frall Septic Service

IS PERMITTED TO INSTALL X ALTER

ADDRESS P. O. Box 659, Mt. Airy, Maryland 21771 PHONE 795-5674

SUBDIVISION Fox Run Estates ROAD 4519 Taraley Court LOT 4

PROPERTY OWNER Millerbertt MARITA Salberg

ADDRESS Hugh Gregory

~~EXCESS GRAVEL IS USED TO INCREASE SEPTIC TANK CAPACITY BY 50% AND ABSORPTION AREA BY 25%~~

~~GARAGE GRINDER XXXXX YES XXXXXXXXXXXXXXXXXXXX~~

SEPTIC TANK CAPACITY 1250 GALLONS NUMBER OF BEDROOMS 4

TRENCHES - 210 sq. ft. per bedroom. Trench to be 2 feet wide. Inlet 3 feet below original grade. Bottom maximum depth 7 feet below original grade. Effective area begins at 3 feet below original grade. 4 feet of stone below distribution pipe.

LOCATION - Start the first trench 240 feet from the center of Taraley Court and 100 feet from the right lot line. Run trenches along contour toward front of lot.

NOTE - No trench to exceed 100 feet in length. Provide 6" - 8" diameter cleanout and cap to grade or above on septic tank. OK/W

PLANS APPROVED BY C. Williams DATE 11/14/88

COVER NO WORK UNTIL INSPECTED AND APPROVED

NEITHER THE HOWARD COUNTY COUNCIL NOR THE HEALTH DEPARTMENT IS RESPONSIBLE FOR THE SUCCESSFUL OPERATION OF ANY SYSTEM.

NOTE: CLEANOUT REQUIRED EVERY 70 FEET OF SEWER LINE AND/OR AT 90° SWEEPS IN LINES FROM HOUSE TO DRAIN FIELDS

NOTE: ALL PARTS OF SEPTIC SYSTEMS (I.E., TANK, DISTRIBUTION BOX, TRENCHES) TO BE 100 FEET FROM WELL (UNLESS OTHERWISE SPECIFICALLY AUTHORIZED)

NOTE: IF DEEP TRENCH(IES) ARE USED CALL FOR INSPECTION BEFORE AND AFTER PLACING GRAVEL IN TRENCH(IES)

NOTE: NO DRY WELL SHALL EXCEED 15 FOOT IN DIAMETER. NO ABSORPTION TRENCH TO EXCEED 100 FEET IN LENGTH.

NOTE: ALL PIPE FROM HOUSE TO SEPTIC TANK MUST BE CAST IRON OR SCHEDULE 40 PVC OR ABS

PERMIT VOID AFTER TWO YEARS

NOTE: INSTALL STAND PIPE ON SEPTIC TANK AND DRY WELL. STAND PIPES MUST BE 6 INCHES IN DIAMETER. CAST IRON, CONCRETE OR TERRA COTTA OR PVC OR ABS ACCEPTED. IF TOP OF SEPTIC TANK IS DEEPER THAN 3 FEET, MANHOLE TO GRADE REQUIRED


NOTE: DISTRIBUTION BOXES MUST HAVE BAFFLES

BLOG PERMITS SIGNED
AND RETURNED 5/5/00
B00123876 DECL

BLOG PERMITS SIGNED
AND RETURNED 6/13/00
B00124620 Undergound LP Tank

*INSTALLER IS RESPONSIBLE FOR OBTAINING FINAL APROVAL ON THIS PERMIT

*CALL 461-9933 FOR INSPECTION OF SEPTIC SYSTEMS.

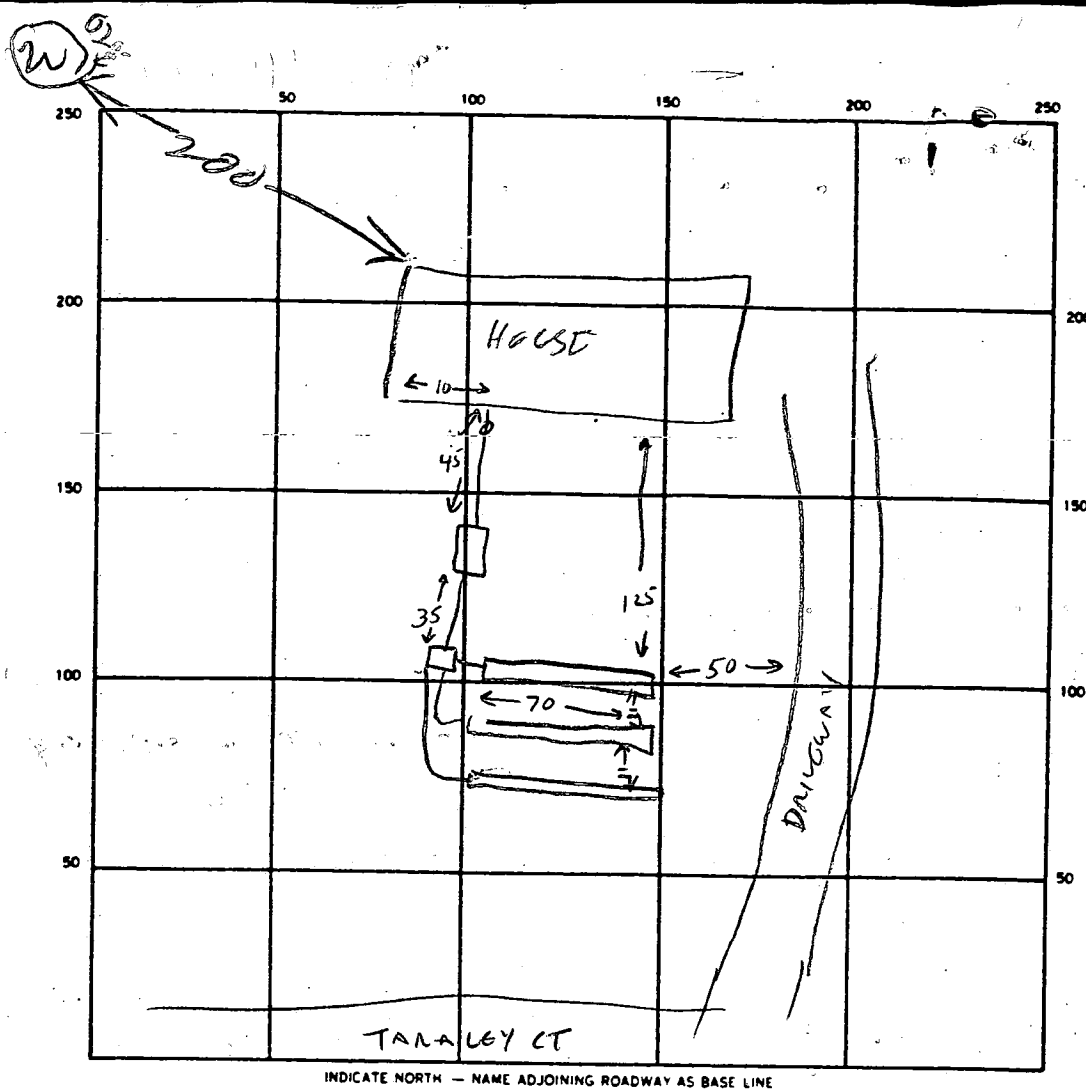

SEPTIC TANK. LEVEL

✓ 1250

CLEANOUTS

ST / HOUSE SOWER
OK / OK

DISTRIBUTION BOX. LEVEL

✓

DRAIN FIELD/TILE FIELD. DEPTH

1 1/4 FT.

TRENCH WIDTH

2 FT.

INLET DEPTH

4 1/4 FT.

EFFECTIVE GRAVEL DEPTH

3 | 3 | 3 FT.

FT.

TOTAL LENGTH

93 | 93 | 95 FT.

FT.

NUMBER OF TRENCHES

3

ONE SIDEWALL/BOTTOM AREA

84.3 SQ. FT.

SQ. FT.

DRYWELL INSIDE DIAMETER

FT.

EFFECTIVE DEPTH BELOW INLET

FT.

ABSORBENT AREA

SQ. FT.

REMARKS

3/7/90 2 TNG-CHGS OK TO ADD GRAVEL. C.W. 3/8/90 NOON

TRENCH #3 DOG-TOOTH LONG INLET TO DEEP (4FT)

MAKE EACH TRENCH 95 FT LONG & ADD STONE TO ALL

THREE 3/8/90 3:15 PM TRENCHES LENGTHENED DK TO
COVER RH

DATE SYSTEM APPROVED

3/8/90

INSPECTOR

Raymond Hodge

H. CLIFTON PEDDICORD, et ux
(L. 212 F. 340)

S 69° 46' 15" E

910.00'

465.00'

LOT 4
3.0383 AC.


LOT 5
5.0889 AC.

840' 100 YEAR FLOOD
PLAIN, STORM DRAINAGE,
UTILITIES EASEMENT

LOT 2

LOT 3

LOT 6

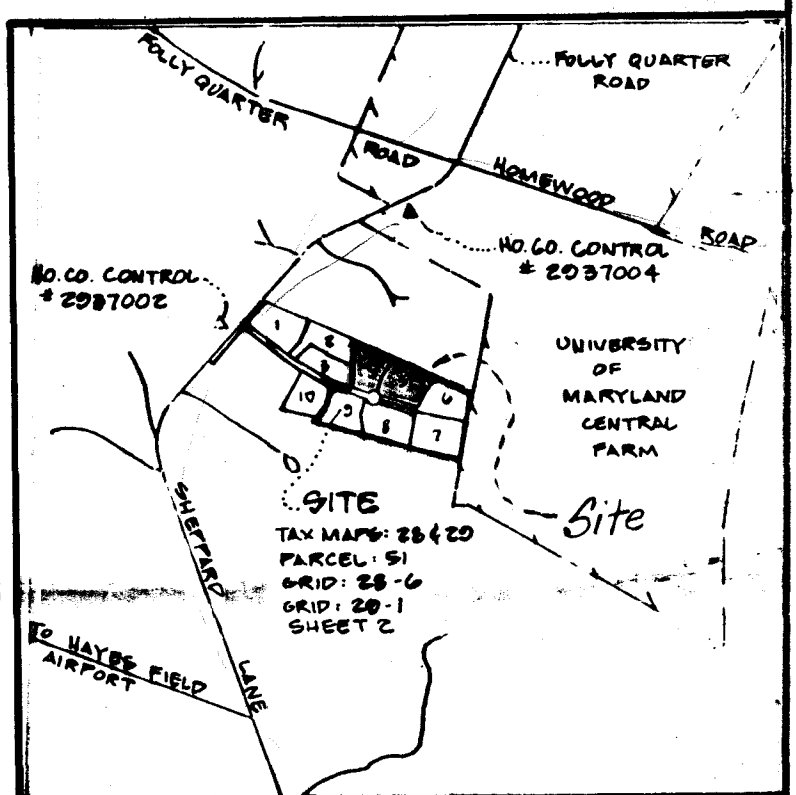

VICINITY MAP
SCALE: 1" = 2000'

LOT 4 SEPTIC SYSTEM DATA

Existing Elevation @ Septic Tank = 423.2
Existing Elevation @ Trench = 420.2
Existing Elevation @ Distribution Box = 420.2
Invert Elevation (into) Distribution Box = 419.33
Invert Elevation into Trench = 418.22
Invert into Septic Tank = 420.31
Invert out of Septic Tank = 420.22
Invert out of House = 421.22

First Floor = 431.54
Basement Elevation = 422.25

TARALEY COURT (50' R/W)


NOTE:
Length and Detail of Trenches
to be Determined by Howard
County Health Dept. Later,
for Lots 4 and 5.

Revised: 8-3-89, Note Added.

LOT 5 SEPTIC SYSTEM DATA

Existing Elevation @ Septic Tank = 425.2
Existing Elevation @ Trench = 424.2
Existing Elevation @ Distribution Box = 424.2
Invert Elevation (into) Distribution Box = 422.91
Invert Elevation into Trench = 421.51
Invert into Septic Tank = 422.2
Invert out of Septic Tank = 422.2
Invert out of House = 423.2

First Floor = 431.6
Basement Elevation = 422.21

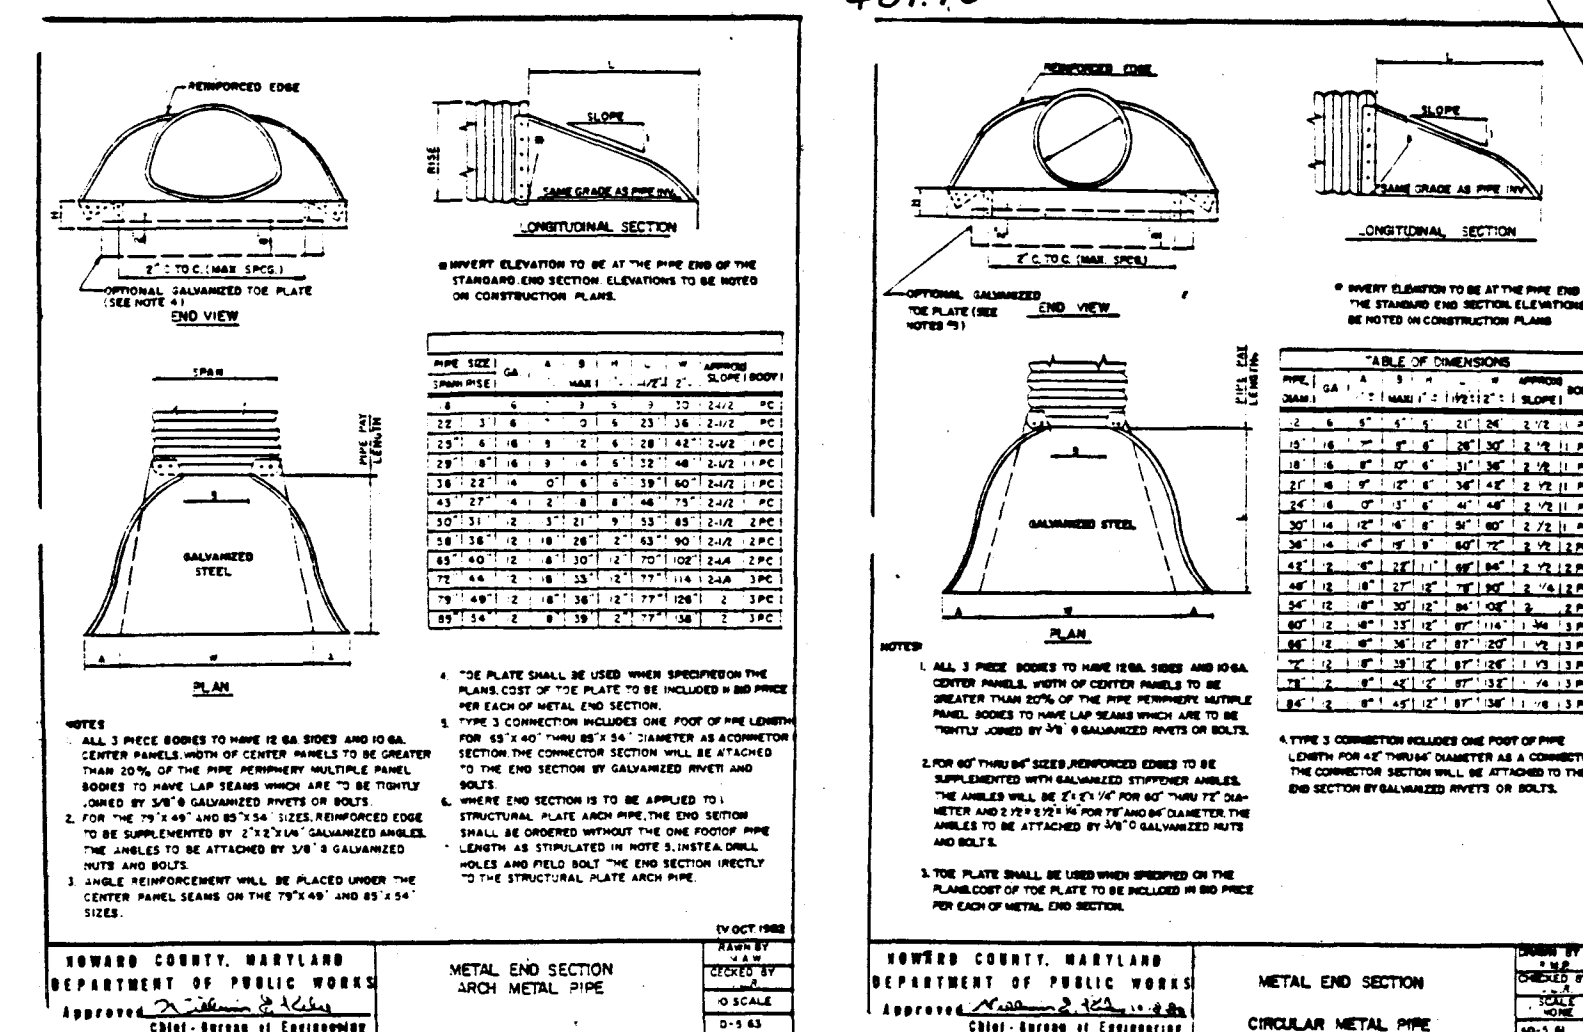

SITE DEVELOPMENT PLAN Taraley Court Lots 4 & 5

FOX RUN ESTATES

Clarksville (5th) Election District
Howard County, Maryland

DESIGNED BY: [Signature]
SCALE: 1" = 80'
DATE: 4-1-89
PHONE: 422-6080
APPROVED BY: [Signature]
8508 ADELPHI ROAD • ADELPHI, MARYLAND 20783-1799
Light, Elliott, & Associates Inc.
ENGINEERS • PLANNERS • SURVEYORS
JOB NO. 14-1226
Plat # 8359 SHEET 4 of 7
FILE NO. 49-224.7

APPLICATION

PERCOLATION TESTING

A 38690

P _____

HOWARD COUNTY HEALTH DEPARTMENT
BUREAU OF ENVIRONMENTAL HEALTH
P.O. BOX 476 ELLICOTT CITY, MARYLAND 21043
TELEPHONE: 461-9933

DISTRICT 5

DATE 2 - 10 - 87

TO: THE COUNTY HEALTH OFFICER
ELLICOTT CITY, MARYLAND

I, HEREBY, APPLY FOR THE NECESSARY TEST IN ORDER TO CONSTRUCT (OR RECONSTRUCT) A SEWAGE DISPOSAL SYSTEM.

PROPERTY OWNER Fox Run Estates Inc Miller Built Corp

ADDRESS 4649 Sheppard Lane, Ellicott City, MD 21043 PHONE 964-2023 (301)-596-9739

PROSPECTIVE BUYER N/A

ADDRESS _____ PHONE _____

PROPERTY LOCATION:

SUBDIVISION Fox Run Estates LOT NO. 54

ROAD AND DESCRIPTION Fronting on road "A" of Subdivision 4519 Taralee Court

TAX MAP #28 PARCEL # 51

SIZE OF LOT 3.03 Acres TYPE BLDG. Single Family Dwelling
(SINGLE FAMILY DWELLING OR COMMERCIAL)

THE SYSTEM INSTALLED UNDER THIS APPLICATION IS ACCEPTABLE ONLY UNTIL PUBLIC FACILITIES BECOME AVAILABLE. I FULLY UNDERSTAND THE FEE CONNECTED WITH THE FILING OF THIS PERC TEST APPLICATION IS NON-REFUNDABLE UNDER ANY CIRCUMSTANCES. I ALSO AGREE TO COMPLY WITH ALL M.O.S.H.A. REQUIREMENTS IN TESTING THIS LOT.

(SIGNATURE OF APPLICANT)

APPROVED BY _____ FOR _____ DATE _____

REJECTED BY _____ FOR _____ DATE _____

HOLD PENDING FURTHER TESTS _____ DATE _____

REASONS FOR REJECTION OR HOLDING _____

BUDG. PERMIT SIGNED

AND RETURNED 8/11/89


Seal # 27939

SFD - 4 Bedroom

THIS IS NOT A PERMIT

A 38690

475

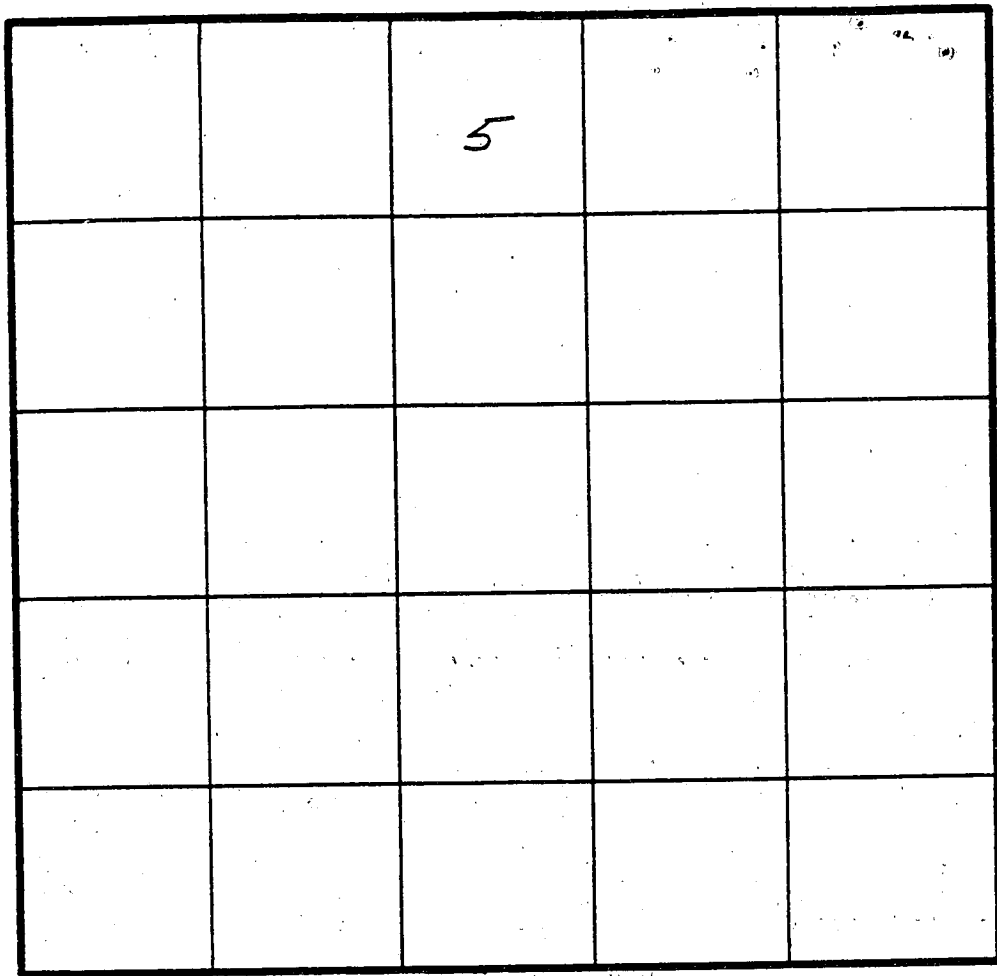

SOIL PROFILE

RED CLAY

PINK BROWN SAND LOAM

INDICATE NORTH - NAME ADJOINING ROADWAY AS BASE LINE.

DATE	TEST NO.	DEPTH	PRE-WET		TEST - 1" DROP		TIME
			START	STOP	START	STOP	
4/1/87	1S	5.5	1237	1239	1239	1142	2
	1V	12	OK				
	2S	5.5	128	133	133	135	2
	2D	8	129	130	130	133	3
	2V	13	OK				
	3S	5	138	139	139	141	3
	3V	12	OK				
	4S	5	149	206	206	230	24
	4V	12	OK				

RED BROWN CLAY

PINK BROWN SAND LOAM

BROWN CLAY

PINK BROWN SAND LOAM

RED CLAY

PINK BROWN SAND LOAM

REMARKS HOLES DUG PER SURVEYOR PLAT RH

TYPE OF SOIL

TESTED BY R. HODGES

ALSO PRESENT

JOE DY LEE & RICKY & BILL

40
6
9

B 1 7918 (THIS NUMBER IS TO BE PUNCHED IN COLS: 3-6 ON ALL CARDS)	SEQUENCE NO. (DP USE ONLY)	STATE OF MARYLAND PERMIT TO DRILL WELL please print or type	STATE PERMIT NUMBER H0-88-0288 fill in this form completely
Date Received (APA) 10/29/88		B 3 LOCATION OF WELL 8 COUNTY H0WARD 21 23 SUBDIVISION FOX RUN ESTATES 42 SECTION 44 46 LOT 4 50 52 NEAREST TOWN CLARKSVILLE 71 MILES FROM TOWN (enter 0 if in town) 2 73 MI 76 77 78	
OWNER INFORMATION 15 Last Name JOSEPH Owner First Name L. MAYNE 34 36 Street or RFD 5512 RING RD. MT. AIRY 55 57 Town CITY 70 State 72 MD Zip 21111 76		B 4 DIRECTION OF WELL FROM TOWN (CIRCLE BOX) 	
DRILLER INFORMATION Driller's Name Joseph L. Mayne 77 License No. 80 238 Firm Name L. Mayne Well Drilling Address 5512 Ring Rd. Mt. Airy Signature Joseph L. Mayne Date 10/26/88		11 FARLEY COURT 30 NEAR WHAT ROAD ON WHICH SIDE OF ROAD (CIRCLE APPROPRIATE BOX) NORTH ☒ WEST ☐ EAST ☐ SOUTH ☐ 34 325 37 DISTANCE FROM ROAD ENTER FT or MI FF 38 39	
B 2 WELL INFORMATION 1 APPROX. PUMPING RATE (GAL. PER MIN.) 3 8 12 AVERAGE DAILY QUANTITY NEEDED (GAL. PER DAY) 500 14 20		NOT TO BE FILLED IN BY DRILLER HEALTH DEPARTMENT APPROVAL Howard A38690 COUNTY NAME COUNTY NO. STATE SIGNATURE Cary William 41 DATE ISSUED 5/14/89 CO SIGNATURE NORTH GRID 513000 55 EAST GRID 0818000 63 50 51 52 53 54 55 56 57 58 59 60 61 62 63	
USE FOR WATER (CIRCLE APPROPRIATE BOX) ☒ HOME (SINGLE OR DOUBLE HOUSEHOLD UNIT ONLY) ☐ FARMING (LIVESTOCK WATERING & AGRICULTURAL IRRIGATION) ☐ INDUSTRIAL, COMMERCIAL, STATE AND FEDERAL GOV. OTHER (REQUIRES APPROPRIATION PERMIT) ☐ PUBLIC OR PRIVATE WATER COMPANY (REQUIRES APPROPRIATION PERMIT AND STATE HEALTH DEPARTMENT APPROVAL) ☐ TEST, OBSERVATION, MONITORING (MAY REQUIRE APPROPRIATION PERMIT)		SHOW MAJOR FEATURES OF BOX & LOCATE WELL WITH AN X SOURCES OF DRILLING WATER 1. Well 2. 3. WRITE THE BOX NUMBER FROM THE MAP HERE 	
APPROXIMATE DEPTH OF WELL 350 24 28 FEET APPROXIMATE DIAMETER OF WELL 6 NEAREST INCH		DRAW A SKETCH BELOW SHOWING LOCATION OF WELL IN RELATION TO NEARBY TOWNS AND ROADS AND GIVE DISTANCE FROM WELL TO NEAREST ROAD JUNCTION 	
METHOD OF DRILLING (circle one) BORED (or Augered) ☒ JETTED ☐ Jetted & DRIVEN ☐ 30 AIR-ROTary ☐ AIR-PERCussion ☐ ROTARY (Hydraulic Rotary) ☐ 37 CABLE ☐ REVERSE-ROTary ☐ DRIVE-POINT ☐ other _____		REPLACEMENT OR DEEPEMED WELLS (CIRCLE APPROPRIATE BOX) ☒ THIS WELL WILL NOT REPLACE AN EXISTING WELL ☐ THIS WELL WILL REPLACE A WELL THAT WILL BE ABANDONED AND SEALED 39 ☐ THIS WELL WILL REPLACE A WELL THAT WILL BE USED AS A STANDBY ☐ THIS WELL WILL DEEPEM AN EXISTING WELL PERMIT NUMBER OF WELL TO BE REPLACED OR DEEPEMED (IF AVAILABLE) 41 _____ 52	
Not to be filled in by driller (OEP USE ONLY) APPROP. PERMIT NUMBER 3 54 GAP 63 FORCE E 67 68 WRITE INITIALS IN BOX PERMIT No. H0-88-0288 70 71 72 73 74 75 76 77 78 79		SPECIAL CONDITIONS Barbarilla	

C1 6626 SEQUENCE NO. (DENV USE ONLY)

STATE OF MARYLAND
WELL COMPLETION REPORT
FILL IN THIS FORM COMPLETELY
PLEASE PRINT OR TYPETHIS REPORT MUST BE SUBMITTED WITHIN
45 DAYS AFTER WELL IS COMPLETED.COUNTY
NUMBER A 38690

DATE Received

DATE WELL COMPLETED

Depth of Well

PERMIT NO.
FROM "PERMIT TO DRILL WELL"

8	9	10	11	12	13
---	---	----	----	----	----

15	16	17	18	19	20
----	----	----	----	----	----

22	23	24	25	26
----	----	----	----	----

(TO NEAREST FOOT)

28	29	30	31	32	33	34	35	36	37
----	----	----	----	----	----	----	----	----	----

OWNER

JAS INVESTMENT

STREET OR RFD

last name

TOLLEY COURT

first name

TOWN CLARKSBURG

SUBDIVISION

FOX RUN ESTATES

SECTION

LOT 4

WELL LOG

Not required for driven wells

STATE THE KIND OF FORMATIONS
PENETRATED, THEIR COLOR, DEPTH,
THICKNESS AND IF WATER BEARINGDESCRIPTION (Use
additional sheets if needed)

FEET

FROM

TO

Check
if water
bearingSAND
GRAY MICHA
ROCK

0 140

140 185 ✓

GROUTING RECORD

WELL HAS BEEN GROUTED
(Circle Appropriate Box)yes
Yno
N

TYPE OF GROUTING MATERIAL

CEMENT CM

BENTONITE CLAY BC

NO. OF BAGS 9

NO. OF POUNDS 846

GALLONS OF WATER 54

DEPTH OF GROUT SEAL (to nearest foot)

from 0 ft. to 40 ft.
(enter 0 if from surface)casing
types
insert
appropriate
code
below

CASING RECORD

ST

CO

STEEL CONCRETE

PL

OT

PLASTIC OTHER

MAIN Casing TYPE Nominal diameter top (main) casing (nearest inch) Total depth of main casing (nearest foot)

5 1/2

1

148

EACH CASING

OTHER CASING (if used)

diameter depth (feet)
inch from toscreen type
or open hole
insert
appropriate
code
below

SCREEN RECORD

ST

BR

HO

STEEL

BRASS

OPEN

BRONZE

HOLE

PL

OT

PLASTIC OTHER

C2

EACH SCREEN

DEPTH (nearest ft.)

1	2	3	4	5	6	7	8	9	10	11	12	13	14	15	16	17	18	19	20	21
22	23	24	25	26	27	28	29	30	31	32	33	34	35	36	37	38	39	40	41	42
43	44	45	46	47	48	49	50	51	52	53	54	55	56	57	58	59	60	61	62	
63	64	65	66	67	68	69	70	71	72	73	74	75	76	77	78	79	80	81	82	

SLOT SIZE 1 2 3

DIAMETER OF SCREEN (NEAREST INCH)

from to

GRAVEL PACK

IF WELL DRILLED WAS
FLOWING WELL INSERT
F IN BOX 68OEP USE ONLY
(NOT TO BE FILLED IN BY DRILLER)

T

(E.R.O.S.)

WQ

70

72

74 75 76

TELESCOPE
CASINGLOG
INDICATOR

OTHER DATA

PUMPING TEST

HOURS PUMPED (nearest hour)

3

PUMPING RATE (gal. per min. to nearest gal.)

15

METHOD USED TO

MEASURE PUMPING RATE

WATER LEVEL (distance from land surface)

BEFORE PUMPING

50

WHEN PUMPING

114

TYPE OF PUMP USED (for test)

A air

P piston

T turbine

C centrifugal

R rotary

O other (describe below)

J jet

S submersible

PUMP INSTALLED

DRILLER WILL INSTALL PUMP YES NO

IF DRILLER INSTALLS PUMP, THIS SECTION
MUST BE COMPLETED FOR ALL WELLS
EXCEPT HOME USE

TYPE OF PUMP INSTALLED

PLACE (A,C,J,P,R,S,T,O)

IN BOX - SEE ABOVE:

CAPACITY:
GALLONS PER MINUTE
(to nearest gallon)

PUMP HORSE POWER

PUMP COLUMN LENGTH
(nearest ft.)CASING HEIGHT (circle appropriate box
and enter casing height)


+ above

LAND SURFACE

- below

(nearest foot)

LOCATION OF WELL ON LOT

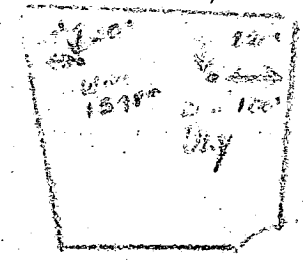SHOW PERMANENT STRUCTURE SUCH AS
BUILDING, SEPTIC TANKS, AND/OR
LANDMARKS AND INDICATE NOT LESS
THAN TWO DISTANCES
(MEASUREMENTS TO WELL)CIRCLE APPROPRIATE LETTER
A A WELL WAS ABANDONED AND SEALED
WHEN THIS WELL WAS COMPLETED

E ELECTRIC LOG OBTAINED

P TEST WELL CONVERTED TO PRODUCTION
WELLI HEREBY CERTIFY THAT THIS WELL HAS BEEN CONSTRUCTED IN
ACCORDANCE WITH COMAR 10.17.13 "WELL CONSTRUCTION"
AND IN CONFORMANCE WITH ALL CONDITIONS STATED IN THE
ABOVE CAPTIONED PERMIT; AND THAT THE INFORMATION
PRESENTED HEREIN IS ACCURATE AND COMPLETE TO THE BEST
OF MY KNOWLEDGE.

DRILLERS IDENT. NO. 238

DRILLERS SIGNATURE

(MUST MATCH SIGNATURE ON APPLICATION)

SITE SUPERVISOR (sign. of driller or journeyman
responsible for sitework if different from permittee)

COUNTY

FIELD DATA SHEET
HOWARD COUNTY WELL YIELD TEST

Well Permit No. HO - 88 - 0288

Location of property (road) TARALEY COUNTRY

Subdivision FOX RUN ESTATES

Lot 4

Block

Plat

Sec.

Well Driller JOE MAYNE

Owner J & S INVESTMENTS

Depth of well 185'

Distance of measuring point (M.P.) above ground 3

Static water level (S.W.L.) below M.P. 50'

I. High rate pumping -- reservoir drawdown

Time pump started 2:15

Pumping rate 15 gpm

Total time 15 min to reach pumping water level 114 ft. below M.P.

II. Recovery pump test data - observations to be recorded every 15 minutes

[illegible]

HOWARD COUNTY HEALTH DEPARTMENT
Bureau of Environmental Health
3525-H Ellicott Mills Drive
Ellicott City, MD 21043
461-9933

APPLICATION FOR PITLESS ADAPTER, WELL PUMP AND PRESSURE TANK INSTALLATION

New Installation X
Replacement _____

Receipt # 46108
Date 7/6/90

Name of Installer R.A. Kelley Plumbing + Heating Inc. Telephone (301) 975-9428

License Number 10757

Certified Well Pump Installer _____ Well Driller _____ Registered Plumber X

Name of Property Owner MILLERBUILT CORP.

Telephone (301) 964-2023

Subdivision Fox Run Estates Lot # 4

Well Tag # HO-88-0288

Site Address 4519 Tarahey Court

Pump

1. Type

- a. Deep well jet _____
b. Shallow well jet _____
c. Submersible X

2. Make QACUZZI

3. Model # _____

4. Capacity _____ GPM

5. Pump exceeds well capacity Yes _____ No X

6. If Yes, is low pressure cutoff switch installed? Yes X No _____

7. What methods are used to protect the pump and electrical wiring from vibrations? Torque arrestors X Cable guards X Other _____

Motor

1. Horsepower 1/2

2. RPM _____

3. Voltage _____

a. 110 _____

b. 220 ✓

Pitless Adapter

1. Make _____

2. Model # _____

3. Depth _____

Tank

1. Capacity _____

2. Pressure relief valve? _____

Piping

1. Type _____

2. Size _____

3. NSF and/or BOCA Code approved _____

4. Depth of supply line _____

Well data

1. Depth _____ ft.

2. Yield _____ GPM

3. Static water level _____ ft.

4. Will water supply be disinfected by installer? _____

I understand that it is my responsibility to notify the Howard County Health Department when the installation is ready for inspection (otherwise this permit is null and void).

All information given above is true to the best of my knowledge.



Signature of Applicant: [Signature]

Date: 5/30/90

Note: A sticker indicating approval/status of the installation will be placed on the well casing at the time of the inspection.



HOT TUB

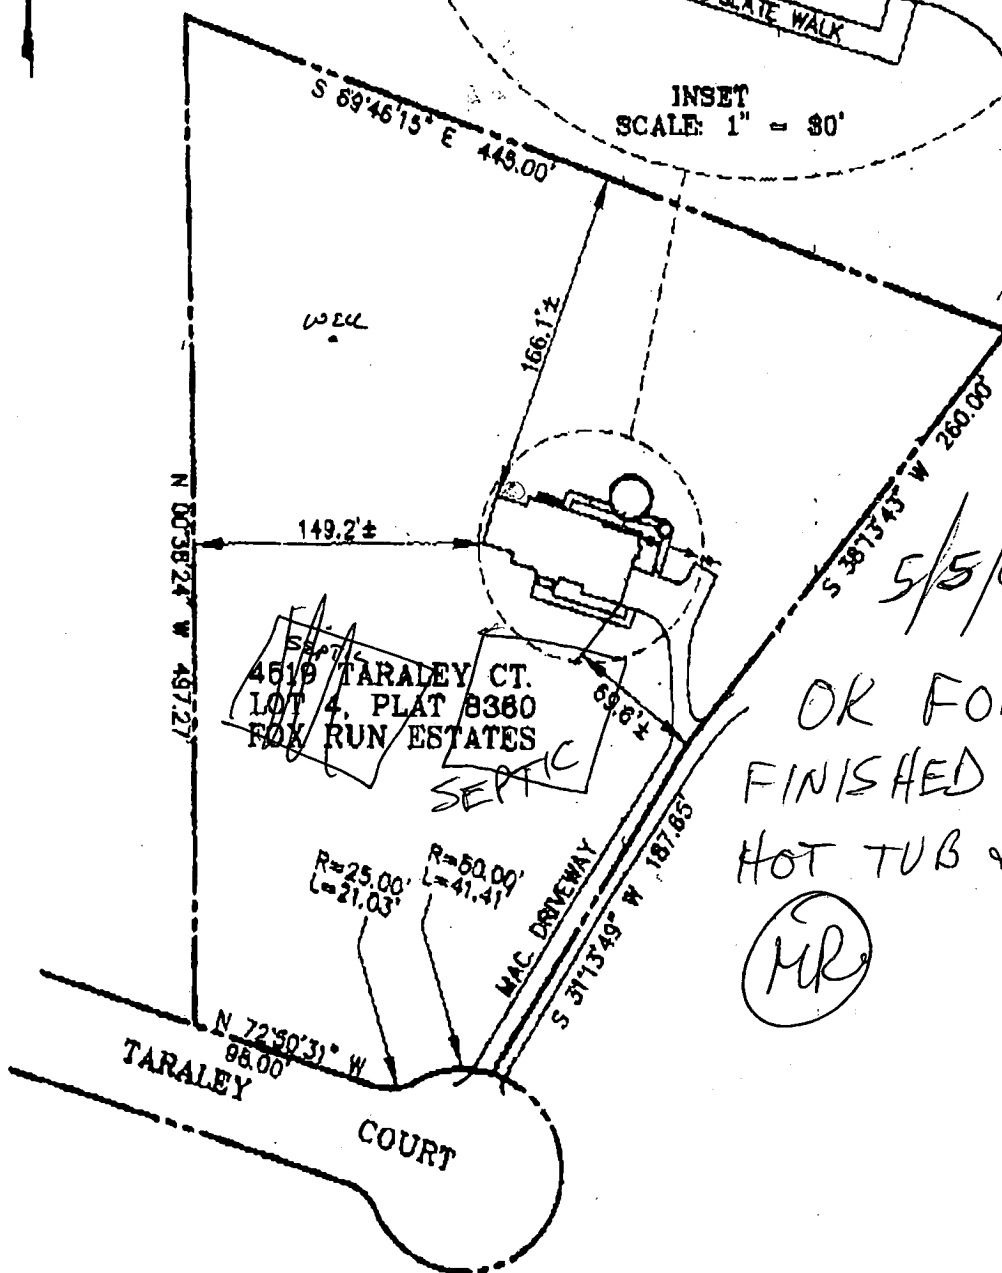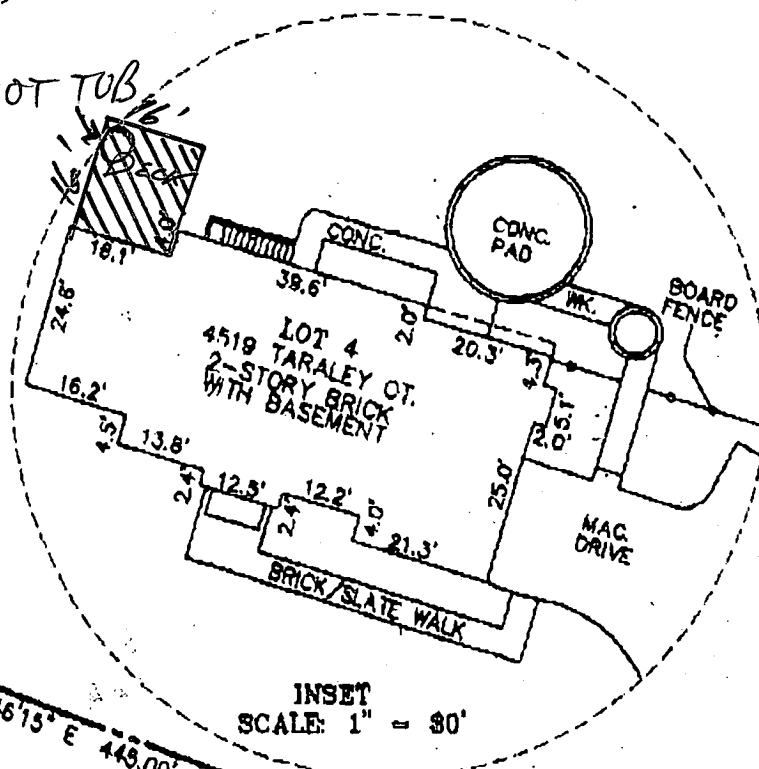

NOTES

1. THE LEVEL OF ACCURACY OF APPARENT SETBACK DISTANCES IS ONE FOOT, MORE OR LESS.
2. THIS PLAT WAS PREPARED WITHOUT BENEFIT OF A TITLE REPORT.

DEPARTMENT OF INSPECTIONS, LICENSES AND PERMITS 3430 COURT HOUSE DRIVE ELLCOTT CITY, MD 21043 PERMITS (410) 313-2456; INSPECTIONS (410) 313-1810 AUTOMATED INFORMATION (410) 313-3800	HOWARD COUNTY PERMIT APPLICATION	PERMIT NUMBER B 03 123 876
---	---	--------------------------------------

Building Address <u>4519 TARALEY COURT</u> <u>ELLCOTT CITY, MD 21042</u>	Property Owner's Name <u>HUGH & LINDA ANNIE GREGORY</u>
Suite/Apt. # <u>N/A</u> SDP/WP/Petition # <u>N/A</u>	Address <u>4519 TARALEY COURT</u>
Census Tract <u>6051.01</u> Subdivision <u>FOX RUN ESTATES</u>	City <u>ELLCOTT CITY</u> State <u>MD</u> Zip Code <u>21042</u>
Section <u>N/A</u> Area <u>N/A</u> Lot <u>4</u>	Home Phone <u>410-52-2210</u> Work Phone <u>410-215-5004</u>
Tax Map <u>29</u> Parcel <u>51</u> Grid <u>12 I</u>	Applicant's Name & Mailing Address, (if other than stated hereon): <u>TAZ GREGORY</u> <u>301-924-9500</u>
Zoning <u>RR-100</u> Map Coordinates <u>1.1.1.1</u> Lot size <u>3.03 AC</u>	Phone _____ Fax _____

Existing Use <u>RESIDENTIAL - SFD</u>	Contractor Company <u>HOMEWORKER</u>
Proposed Use <u>RESIDENTIAL</u>	Contact Person _____
Estimated Construction Cost \$ <u>5000</u>	Address _____
Description of Work <u>FINISH BASEMENT AND</u> <u>16'x16' BUILD DECK W/ HOT TUB</u> <u>REC. RM AND FULL BATH UNF. UTILITIES</u>	City _____ State _____ Zip Code _____
	License No. _____ Phone _____ Fax _____

Occupant or Tenant <u>SAME AS OWNER</u>	Engineer or Architect Company _____
Contact Name _____	Contact Person _____
Address _____	Address _____
City _____ State _____ Zip Code _____	City _____ State _____ Zip Code _____
Phone _____ Fax _____	Phone _____ Fax _____

BUILDING DESCRIPTION - <u>COMMERCIAL</u>		BUILDING DESCRIPTION - <u>RESIDENTIAL</u>	
Building Characteristics	Utilities	Building Characteristics	Utilities
Height: _____	Water Supply: _____ Public _____ Private _____	SF Dwelling ☒ SF Townhouse ☐ Depth _____ Width _____	Water Supply: _____ Public _____ Private ☒
No. of stories: _____	Sewage Disposal: _____ Public _____ Private _____	1st floor: _____	Sewage Disposal: _____ Public _____ Private ☒
Gross area, sq. ft. per floor: _____	Electric Yes ☐ No ☐	2nd floor: _____	Electric Yes ☒ No ☐
Use group: _____	Gas Yes ☐ No ☐	Basement: <u>28' x 40'</u>	Gas Yes ☒ No ☐
Construction type: _____ Reinforced Concrete _____ Structural Steel _____ Masonry _____ Wood Frame _____ State Certified Modular _____	Heating System: _____ Electric ☐ Oil ☐ Natural Gas ☐ Propane Gas ☐	Finished Basement ☒ Unfinished Basement ☐ Crawl space ☐ Slab on Grade ☐ No. of Bedrooms _____	Heating System: _____ Electric ☐ Oil ☐ Natural Gas ☐ Propane Gas ☒
	Sprinkler system: N/A ☐ Full _____ Partial _____ Other Suppression _____ # of Heads _____	Multi-family dwellings: No. of efficiency units: _____ No. of 1 BR units: _____ No. of 2 BR units: _____ No. of 3 BR units: _____	Sprinkler system: N/A ☒ NFPA #13D _____ NFPA #13R _____ Other: _____
		Other Structure: _____ Dimensions: _____ Footings: _____ Roof: _____ State Certified Modular _____ Manufactured Home _____	


THE UNDERSIGNED HEREBY CERTIFIES AND AGREES AS FOLLOWS: (1) THAT HE/SHE IS AUTHORIZED TO MAKE THIS APPLICATION; (2) THAT THE INFORMATION IS CORRECT; (3) THAT HE/SHE WILL COMPLY WITH ALL REGULATIONS OF HOWARD COUNTY WHICH ARE APPLICABLE THERETO; (4) THAT HE/SHE WILL PERFORM NO WORK ON THE ABOVE REFERENCED PROPERTY NOT SPECIFICALLY DESCRIBED IN THIS APPLICATION; (5) THAT HE/SHE GRANTS COUNTY OFFICIALS THE RIGHT TO ENTER ONTO THIS PROPERTY FOR THE PURPOSE OF INSPECTING THE WORK PERMITTED AND POSTING NOTICES.

<u>HUGH GREGORY</u> Applicant's Signature	<u>HUGH GREGORY BY HANNAH FEELT (AGENT)</u> Print Name
<u>TAZ GREGORY</u> Title/Company	<u>4/15/00</u> Date

Checks payable to: DIRECTOR OF FINANCE OF HOWARD COUNTY
** PLEASE WRITE NEATLY AND LEGIBLY **
- FOR OFFICE USE ONLY -

AGENCY	DATE	SIGNATURE APPROVAL	DPZ SETBACK INFORMATION	PROPERTY ID#
Land Development DPZ			Front: _____	15988
State Highways			Rear: _____	
Building Official			Side: _____	
Dev. Engineering DPZ			Side St. _____	
Health	5/5/00	Mark E. Ripken	All minimum setbacks met? YES ☐ NO ☐	Filing fee \$ _____
Fire Protection			Is Entrance Permit required? YES ☐ NO ☐	Permit fee \$ _____
Is Sediment Control approval required prior to issuance? YES ☐ NO ☐			Historic District? YES ☐ NO ☐	Excise tax \$ _____
			Lot Coverage for NewTown Zone _____	Sub-total paid \$ _____
			SDP/Red-line approval date _____	Add'l permit fee \$ _____
				TOTAL FEES \$ _____
				Balance due \$ _____
				Check # _____
				Validation # _____

Distribution of Copies	White: Building Official	Green: LDD, DPZ	Yellow: DED, DPZ	Pink: Health	Gold: SHA
------------------------	--------------------------	-----------------	------------------	--------------	-----------

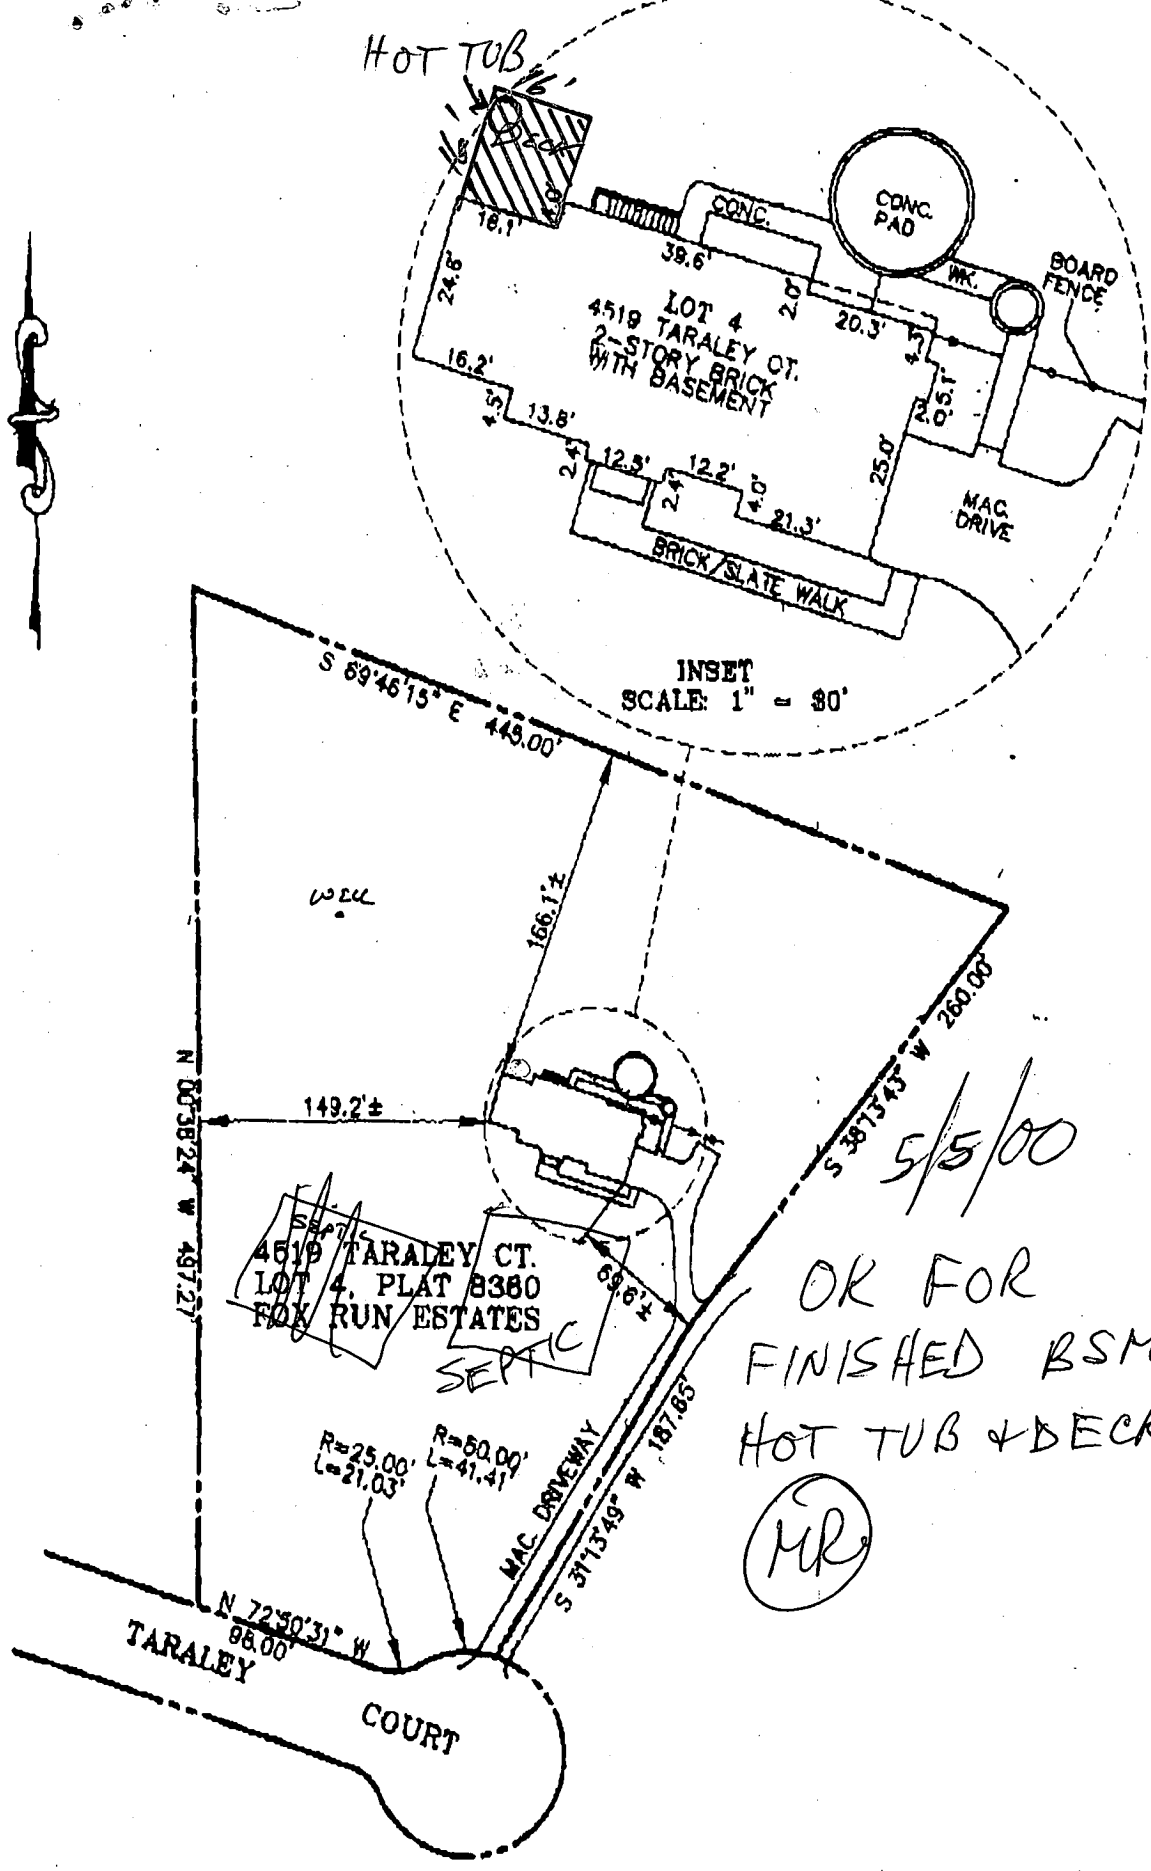

NOTES

1. THE LEVEL OF ACCURACY OF APPARENT SETBACK DISTANCES IS ONE FOOT, MORE OR LESS.
2. THIS PLAT WAS PREPARED WITHOUT BENEFIT OF A TITLE REPORT.
3. THIS PROPERTY IS NOT LOCATED WITHIN 100 YEARS FLOOD ZONE.

I HEREBY CERTIFY THAT IMPROVEMENTS ARE LOCATED AS SHOWN HEREON AND TO THE BEST OF MY INFORMATION, PROFESSIONAL KNOWLEDGE AND BELIEF, THERE ARE NO ENCROACHMENTS EXCEPT AS SHOWN.



M.N. Roshan
M.N. ROSHAN
L.S. NO. 11049

04/27/00
DATE

LOCATION SURVEY

FOX RUN ESTATES
LOT 4, PLAT 8380
FIFTH ELECTION DISTRICT
HOWARD COUNTY, MARYLAND
SCALE: 1" = 100'

DATE: APRIL 27, 2000



TOTAL ENGINEERING SERVICES
PLANNERS, ENGINEERS, SURVEYORS
P.O. BOX 10123
SILVER SPRING, MD 20914
TEL : (301) 515 1514
FAX : (301) 515 5589

4519 TARALEY CT.

DEPARTMENT OF INSPECTIONS, LICENSES AND PERMITS 2490 COURT HOUSE DRIVE ELICOTT CITY, MD 21043 PERMITS (410)313-2455 INSPECTIONS (410)313-1810 AUTOMATED INFORMATION (410) 313-3800	HOWARD COUNTY PERMIT APPLICATION	PERMIT NUMBER 300124620
--	---	-----------------------------------

Building Address <u>4519 TARALEY CT</u> <u>ELICOTT CITY, MD 21043</u>	Property Owner's Name <u>GREGORY, Hugh - RICH</u>
Suite/Apt. #: _____ SDP/WP/Petition #: _____	Address <u>4519 TARALEY CT</u>
Census Tract <u>635101</u> Subdivision <u>FOX RUN ESTATES</u>	City <u>ELICOTT CITY</u> State <u>MD</u> Zip Code <u>21043</u>
Section _____ Area _____ Lot <u>4</u>	Home Phone <u>410-561-2320</u> Work Phone _____
Tax Map <u>29</u> Parcel <u>51</u> Grid <u>2</u>	Applicant's Name & Mailing Address, (if other than stated hereon): _____
Zoning <u>R2300</u> Map Coordinates <u>1471</u> Lot size _____	Phone _____ Fax _____

Existing Use <u>Single Family Dwelling</u>	Contractor Company <u>American</u>
Proposed Use <u>Same with 20 TANK</u>	Contact Person <u>Tom McLaughlin</u>
Estimated Construction Cost \$ <u>20,000</u>	Address <u>10047 BIRCHMOUNT DRIVE</u>
Description of Work <u>INSTALL 500 GAL UNDERGROUND LP TANK</u>	City <u>ELICOTT CITY</u> State <u>MD</u> Zip Code <u>21043</u>
	License No. _____ Phone <u>410-561-2320</u> Fax _____

Occupant or Tenant _____	Engineer or Architect Company _____
Contact Name _____	Contact Person _____
Address _____	Address _____
City _____ State _____ Zip Code _____	City _____ State _____ Zip Code _____
Phone _____ Fax _____	Phone _____ Fax _____

BUILDING DESCRIPTION - <u>COMMERCIAL</u>		BUILDING DESCRIPTION - <u>RESIDENTIAL</u>	
Building Characteristics	Utilities	Building Characteristics	Utilities
Height: _____	Water Supply: _____ Public _____ Private _____	SF Dwelling ☐ SF Townhouse ☐ <u>Depth</u> <u>Width</u>	Water Supply: _____ Public _____ Private _____
No. of stories: _____	Sewage Disposal: _____ Public _____ Private _____	1st floor: _____	Sewage Disposal: _____ Public _____ Private _____
Gross area, sq. ft. per floor: _____	Electric Yes ☐ No ☐	2nd floor: _____	Electric Yes ☐ No ☐
Use group: _____	Gas Yes ☐ No ☐	Basement: _____	Gas Yes ☐ No ☐
Construction type: _____ Reinforced Concrete _____ Structural Steel _____ Masonry _____ Wood Frame _____	Heating System: _____ Electric ☐ Oil ☐ Natural Gas ☐ Propane Gas ☐	Finished Basement ☐ Unfinished Basement ☐ Crawl space ☐ Slab on Grade ☐ No. of Bedrooms _____	Heating System: _____ Electric ☐ Oil ☐ Natural Gas ☐ Propane Gas ☐
State Certified Modular _____	Sprinkler system: N/A ☐ Full _____ Partial _____ Other Suppression _____ # of Heads _____	Multi-family dwellings: No. of efficiency units: _____ No. of 1 BR units: _____ No. of 2 BR units: _____ No. of 3 BR units: _____	Sprinkler system: N/A ☐ NFPA #13D _____ NFPA #13R _____ Other: _____
		Other Structure: _____ Dimensions: _____ Footings: _____ Roof: _____ State Certified Modular _____ Manufactured Home _____	

THE UNDERSIGNED HEREBY CERTIFIES AND AGREES AS FOLLOWS: (1) THAT HE/SHE IS AUTHORIZED TO MAKE THIS APPLICATION; (2) THAT THIS INFORMATION IS CORRECT; (3) THAT HE/SHE WILL COMPLY WITH ALL REGULATIONS OF HOWARD COUNTY WHICH ARE APPLICABLE THEREIN; (4) THAT HE/SHE WILL PERFORM NO WORK ON THE ABOVE REFERENCED PROPERTY NOT SPECIFICALLY DESCRIBED IN THIS APPLICATION; (5) THAT HE/SHE GRANTS COUNTY OFFICIALS THE RIGHT TO ENTER ONTO THE PROPERTY FOR THE PURPOSE OF INSPECTING THE WORK PERMITTED AND POSTING NOTICES.

Applicant's Signature <u>Thomas R. McLaughlin</u>	Print Name <u>Thomas R. McLaughlin</u>
Title/Company _____	Date _____

Checks payable to: DIRECTOR OF FINANCE OF HOWARD COUNTY

** PLEASE WRITE NEATLY AND LEGIBLY. **

- FOR OFFICE USE ONLY -

AGENCY	DATE	SIGNATURE APPROVAL	DPZ SETBACK INFORMATION	PROPERTY ID#
Land Development, DPZ			Front: _____	7-57988
State Highways			Rear: _____	Filing fee \$ <u>1.00</u>
Building Official			Side: _____	Permit fee \$ _____
Dev. Engineering, DPZ			Side St: _____	Excise tax \$ _____
Health	<u>6/13/00</u>	<u>Mark R. P. R.</u>	All minimum setbacks met? YES ☐ NO ☐	Sub-total paid \$ _____
Fire Protection			Is Entrance Permit required? YES ☐ NO ☐	Add'l permit fee \$ _____
Is Sediment Control approval required prior to issuance? YES ☐ NO ☐			Historic District? YES ☐ NO ☐	TOTAL FEES \$ _____
CONTINGENCY CONSTRUCTION START: ☐			Lot Coverage for New Town Zone _____	Balance due \$ _____
ONE STOP SHOP: ☐			SDP/Red-line approval date _____	Check # <u>113051701</u>
			Accepted by _____	Validation # _____

Distribution of Copies: White: Building Official Green: LDD, DPZ Yellow: DED, DPZ Pink: Health Gold: SHA