

3/23/89

3/27/89

ADAP + LATER

04-347595

2 P.C.O. - 3/23
C.B.S.

PERMIT

SEWAGE DISPOSAL SYSTEM

MARYLAND STATE DEPARTMENT OF HEALTH

HOWARD COUNTY
BUREAU OF ENVIRONMENTAL HEALTH
461-9933

INDEXED

P 43760

A 38712

DISTRICT 4th

DATE 3/10/89

DATE SYSTEM APPROVED 3/27/89

INSPECTOR M. R. F. K. in

South Carroll Backhoe, Inc.

IS PERMITTED TO INSTALL ☒ ALTER

ADDRESS 4410 Salem Bottom Road, Westminster, Maryland PHONE 875-4197

SUBDIVISION Morgan Station ROAD 865 The Old Station Ct LOT 22

PROPERTY OWNER S. F. Contractors

ADDRESS

IF GARBAGE GRINDER IS USED INCREASE SEPTIC TANK CAPACITY BY 50% AND ABSORPTION AREA BY 22%.

GARBAGE GRINDER? YES NO ☒

SEPTIC TANK CAPACITY 1250 GALLONS NUMBER OF BEDROOMS 4

TRENCHES - 210 sq. ft. per bedroom. Trench to be 2 feet wide. Inlet 3 feet below original grade. Bottom maximum depth 7 feet below original grade. Effective area begins at 3 feet below original grade. 4 feet of stone below distribution pipe.

LOCATION - Start the first trench 170 feet from the front lot line and 50 feet from the left lot line. Run trenches along contour toward left side and right side of property.

NOTE - No trench to exceed 100 feet in length. Provide 6" - 8" diameter cleanout and cap to grade or above on septic tank. ok/cw

PLANS APPROVED BY Sid Abel

DATE 11/04/88

COVER NO WORK UNTIL INSPECTED AND APPROVED

NEITHER THE HOWARD COUNTY COUNCIL NOR THE HEALTH DEPARTMENT IS RESPONSIBLE FOR THE SUCCESSFUL OPERATION OF ANY SYSTEM.

NOTE: CLEANOUT REQUIRED EVERY 70 FEET OF SEWER LINE AND/OR AT 90° SWEEPS IN LINES FROM HOUSE TO DRAIN FIELDS

NOTE: ALL PARTS OF SEPTIC SYSTEMS (I.E. TANK, DISTRIBUTION BOX, TRENCHES) TO BE 100 FEET FROM WELL (UNLESS OTHERWISE SPECIFICALLY AUTHORIZED)

NOTE: IF DEEP TRENCHES ARE USED CALL FOR INSPECTION BEFORE AND AFTER PLACING GRAVEL IN TRENCHES

NOTE: NO DRY WELL SHALL EXCEED 15 FOOT IN DIAMETER NO ABSORPTION TRENCH TO EXCEED 100 FEET IN LENGTH.

NOTE: ALL PIPE FROM HOUSE TO SEPTIC TANK MUST BE CAST IRON OR SCHEDULE 40 PVC OR ABS

PERMIT VOID AFTER TWO YEARS

NOTE: INSTALL STAND PIPE ON SEPTIC TANK AND DRY WELL. STAND PIPES MUST BE 6 INCHES IN DIAMETER. CAST IRON, CONCRETE OR TERRA COTTA OR PVC OR ABS ACCEPTED. IF TOP OF SEPTIC TANK IS DEEPER THAN 3 FEET, MANHOLE TO GRADE REQUIRED

NOTE: DISTRIBUTION BOXES MUST HAVE BAFFLES

BLDG. PERMIT SIGNED

AND RETURNED 12-2-98


Sevinth B. H. 115279

Intervin Alterations

L. B. M. M.

*INSTALLER IS RESPONSIBLE FOR OBTAINING FINAL APPROVAL ON THIS PERMIT

*CALL 461-9933 FOR INSPECTION OF SEPTIC SYSTEMS.

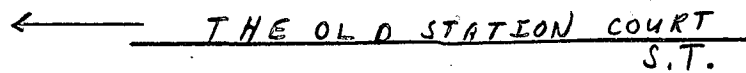

3/23 NOTE: PITLESS ADAPTER OK AND WATER LINE FROM WELL TO
HOUSE OK. (NOTE - CASING DENTED - NOT CRACKED.) C.B. PARTIAL OK TO COVER
DATE SYSTEM APPROVED 3/24/89 INSPECTOR M. RISKIN

APPLICATION

PERCOLATION TESTING

HOWARD COUNTY HEALTH DEPARTMENT
BUREAU OF ENVIRONMENTAL HEALTH
P.O. BOX 476 ELLICOTT CITY, MARYLAND 21043
TELEPHONE: 461-9933

A 38712

P _____

DISTRICT 4

DATE 12/17/86

TO: THE COUNTY HEALTH OFFICER
ELLICOTT CITY, MARYLAND

I HEREBY APPLY FOR THE NECESSARY TEST IN ORDER TO CONSTRUCT (OR RECONSTRUCT) A SEWAGE DISPOSAL SYSTEM.

PROPERTY OWNER Roy W. Cruth + Wife S.F. CONTRACTORS

ADDRESS 791 Morgan Station Rd PHONE 489-4995

PROSPECTIVE BUYER Hemphill Partnership

ADDRESS 10176 Baltimore National Pike Suite 210 PHONE 465-5855

PROPERTY LOCATION:

SUBDIVISION Morgan Station (~~Common Property~~) LOT NO. X

ROAD AND DESCRIPTION E/S Morgan Station Rd north of Old Frederick Rd

865 The Old Station Ct.

LOT 6 Prelim. 10/21/87

TAX MAP 3 PARCEL # 9

SIZE OF LOT 3 acres TYPE BLDG SFD
(SINGLE FAMILY DWELLING OR COMMERCIAL)

THE SYSTEM INSTALLED UNDER THIS APPLICATION IS ACCEPTABLE ONLY UNTIL PUBLIC FACILITIES BECOME AVAILABLE. I FULLY UNDERSTAND THE

FEE CONNECTED WITH THE FILING OF THIS PERC TEST APPLICATION IS NON-REFUNDABLE UNDER ANY CIRCUMSTANCES. I ALSO AGREE TO COMPLY

WITH ALL M.O.S.H.A. REQUIREMENTS IN TESTING THIS LOT. Mal A. Rein
(SIGNATURE OF APPLICANT)

APPROVED BY Ed Abel FOR Deep trenches DATE 11/4/88

REJECTED BY _____ FOR _____ DATE _____

HOLD PENDING FURTHER TESTS _____

REG. PERMIT SIGNED

AND RETURNED 11/4/88 DATE BP-22259

REASONS FOR REJECTION OR HOLDING 4/29/87 - DIG MORE SLOW R/H SA

5/1/87 DIG MORE SLOW R/H Lot liner

to be changed R/H 5/8/87 GOOD ARE FOUND IF

LOT LINES CHANGED


THIS IS NOT A PERMIT

①
SOIL PROFILE

0
TOP SOIL
SAND
LOAM

4
SAND
SILT
LOAM

9 1/2

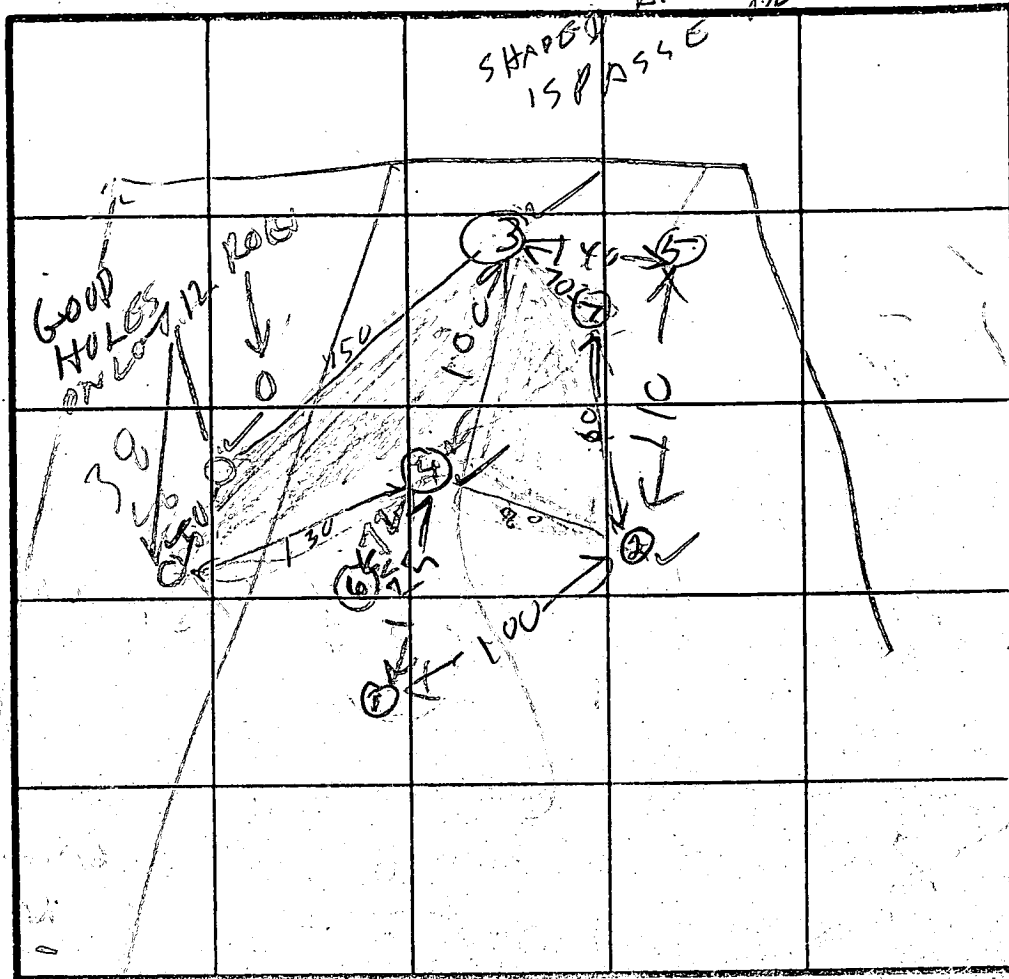

⑤

3
BROWN
CLAY

GRAY
BROWN
SAND
LOAM

9 1/2
9 APPROX.

②

3
TOP SOIL
SAND LOAM

BROWN
SAND
LOAM

③

3
TOP SOIL
SAND LOAM

BROWN
SAND
LOAM

④

2
CLAY
TOP SOIL

BROWN
SAND
LOAM

TOP SOIL
SAND LOAM

DATE	TEST NO.	DEPTH	PRE-WET		TEST - 1" DROP		TIME
			START	STOP	START	STOP	
4/19/87	1S	3	418	421	421	426	5
	1D	6.5	419	440	440	500	520
	IV	9.5	SLOW				
	2S	3	423	431	431	445	14
	2V	10	OK				
	3S	4	426	429	429	437	8
	3V	10.5	OK				
4/19/87	4V	10.5	OK				
	5V	7	ROCK HOLE		covered		
5/1/87	6S	3.5	226	250	little more slow		
	6V	9	OK				
5/1/87	6ES	3.5	243	250	little more slow		
	7S	4	315	319	319	323	8
5/8/87	7V	12	OK				

⑦

3
CLAY

6
DINK
BROWN
SANDY

GREEN
BROWN
SANDY

12
X Per

12min

Inlet 4

Bottom 7

1904 per

REMARKS: Holes (3) (5) per Surveyor Plot per (6) (4) differ

LOT LINES TO BE CHANGED

TYPE OF SOIL: FROM SURVEYOR PLOT

TESTED BY: RHODGES

ALSO PRESENT: OKETTERMAN MARK SURVEYOR MILLON REAL ESTATE

C 1		0545		SEQUENCE NO. (DENV USE ONLY)		STATE OF MARYLAND WELL COMPLETION REPORT		THIS REPORT MUST BE SUBMITTED WITHIN 45 DAYS AFTER WELL IS COMPLETED.	
1 2 3 (THIS NUMBER IS TO BE PUNCHED IN COLS. 3-6 ON ALL CARDS)						FILL IN THIS FORM COMPLETELY PLEASE PRINT OR TYPE		COUNTY NUMBER A # 38712	
DATE RECEIVED 8 13		DATE WELL COMPLETED 15 10/18/88 20		Depth of Well 22 225 26 (TO NEAREST FOOT)		PERMIT NO. FROM "PERMIT TO DRILL WELL" H0-88-0222 28 29 30 31 32 33 34 35 36 37			
OWNER S.F. CONTRACTORS, INC.		last name THE first name OLD STATION COURT		TOWN LISBON		SUBDIVISION MORGAN STATION SECTION - LOT 22			
WELL LOG Not required for driven wells		STATE THE KIND OF FORMATIONS PENETRATED, THEIR COLOR, DEPTH, THICKNESS AND IF WATER BEARING		GROUTING RECORD WELL HAS BEEN GROUTED (Circle Appropriate Box)		PUMPING TEST			
DESCRIPTION (Use additional sheets if needed)		FEET FROM TO		Check if water bearing		CEMENT CM BENTONITE CLAY BC		HOURS PUMPED (nearest hour) 3	
Brownstone 0 58						NO. OF BAGS 9 NO. OF POUNDS 846		PUMPING RATE (gal. per min. 15 to nearest gal.)	
Blue rock 58 225 ✓						GALLONS OF WATER 54		METHOD USED TO MEASURE PUMPING RATE Bucket	
						DEPTH OF GROUT SEAL (to nearest foot) from 0 ft. to 35 ft. (enter 0 if from surface)		WATER LEVEL (distance from land surface) BEFORE PUMPING 40 WHEN PUMPING 47	
						CASING RECORD casing types insert appropriate code below		TYPE OF PUMP USED (for test) A air P piston T turbine C centrifugal R rotary O other (describe below) J jet S submersible	
						MAIN CASING TYPE ST Nominal diameter 6 Total depth of main casing (nearest foot) 65		PUMP INSTALLED DRILLER WILL INSTALL PUMP YES NO IF DRILLER INSTALLS PUMP, THIS SECTION MUST BE COMPLETED FOR ALL WELLS EXCEPT HOME USE	
						OTHER CASING (if used) diameter inch depth (feet) from to		TYPE OF PUMP INSTALLED PLACE (A,C,J,P,R,S,T,O) IN BOX - SEE ABOVE: 29	
						SCREEN RECORD screen type or open hole insert appropriate code below		CAPACITY: GALLONS PER MINUTE (to nearest gallon) 31 35	
						C 2 DEPTH (nearest ft.)		PUMP HORSE POWER 37 41	
						EACH SCREEN 1 40 63 225		PUMP COLUMN LENGTH (nearest ft.) 43 47	
						SLOT SIZE 1 2 3		CASING HEIGHT (circle appropriate box and enter casing height) + above - below } LAND SURFACE 2 (nearest foot)	
						DIAMETER OF SCREEN 56 60 (NEAREST INCH)		LOCATION OF WELL ON LOT SHOW PERMANENT STRUCTURE SUCH AS BUILDING, SEPTIC TANKS, AND/OR LANDMARKS AND INDICATE NOT LESS THAN TWO DISTANCES (MEASUREMENTS TO WELL)	
						GRAVEL PACK IF WELL DRILLED WAS FLOWING WELL INSERT F IN BOX 68		A N D D R Y W E L L 15' W 20' W 20' W 20' W the OLD Station	
CIRCLE APPROPRIATE LETTER A A WELL WAS ABANDONED AND SEALED WHEN THIS WELL WAS COMPLETED E ELECTRIC LOG OBTAINED P TEST WELL CONVERTED TO PRODUCTION WELL						OEP USE ONLY (NOT TO BE FILLED IN BY DRILLER) T (E.R.O.S.) W Q 70 ☐ 72 ☐ 74 75 76			
I HEREBY CERTIFY THAT THIS WELL HAS BEEN CONSTRUCTED IN ACCORDANCE WITH COMAR 10.17.13 "WELL CONSTRUCTION" AND IN CONFORMANCE WITH ALL CONDITIONS STATED IN THE ABOVE CAPTIONED PERMIT, AND THAT THE INFORMATION PRESENTED HEREIN IS ACCURATE AND COMPLETE TO THE BEST OF MY KNOWLEDGE.						TELESCOPE CASING LOG INDICATOR OTHER DATA			
DRILLERS IDENT. NO. 238									
DRILLERS SIGNATURE (MUST MATCH SIGNATURE ON APPLICATION)									
SITE SUPERVISOR (sign. of driller or journeyman responsible for sitework if different from permittee)									

04-347595

HOWARD COUNTY HEALTH DEPARTMENT
Bureau of Environmental Health
3525-H Ellicott Mills Drive
Ellicott City, MD 21043
461-9933

APPLICATION FOR PITLESS ADAPTER, WELL PUMP AND PRESSURE TANK INSTALLATION

New Installation ☒
Replacement ☐

Receipt # 43907
Date 3/30/89

Name of Installer CLARICE P & H INCTelephone 489-4029License Number 3808Certified Well Pump Installer _____ Well Driller _____ Registered Plumber 3808Name of Property Owner S.F. Contractor Inc Telephone 442-1133Subdivision MORGAN STATION Lot # 22 Well Tag # _____Site Address 865 The Old Station Ct

Pump

1. Type
 - a. Deep well jet _____
 - b. Shallow well jet _____
 - c. Submersible ☒
2. Make Goulds
3. Model # _____
4. Capacity _____ GPM

Motor

1. Horsepower _____
2. RPM _____
3. Voltage _____
 - a. 110 _____
 - b. 220 ☒

Pitless Adapter

1. Make _____
2. Model # PT 800
3. Depth _____

5. Pump exceeds well capacity Yes _____ No _____
6. If Yes, is low pressure cutoff switch installed? Yes _____ No _____
7. What methods are used to protect the pump and electrical wiring from vibrations? Torque arrestors _____ Cable guards ☒ Other _____

Tank

1. Capacity 669A1
2. Pressure relief valve? 7516

Piping

1. Type PLASTIC
2. Size 1"
3. NSF and/or BOCA Code approved _____
4. Depth of supply line 42"

Well data

1. Depth _____ ft.
2. Yield _____ GPM
3. Static water level _____ ft.
4. Will water supply be disinfected by installer? NO

I understand that it is my responsibility to notify the Howard County Health Department when the installation is ready for inspection (otherwise this permit is null and void).

All information given above is true to the best of my knowledge.

Signature of Applicant: Kenneth C. ClarkeDate: 3-27-89


Note: A sticker indicating approval/status of the installation will be placed on the well casing at the time of the inspection.


Lot 11

Lot 11, 12, 14, 15, 16, 18, 19, 21, 22, 25, 26

MORGAN STATION
Lot 15, 16, 17

S 66 1/2° E 2846.25'

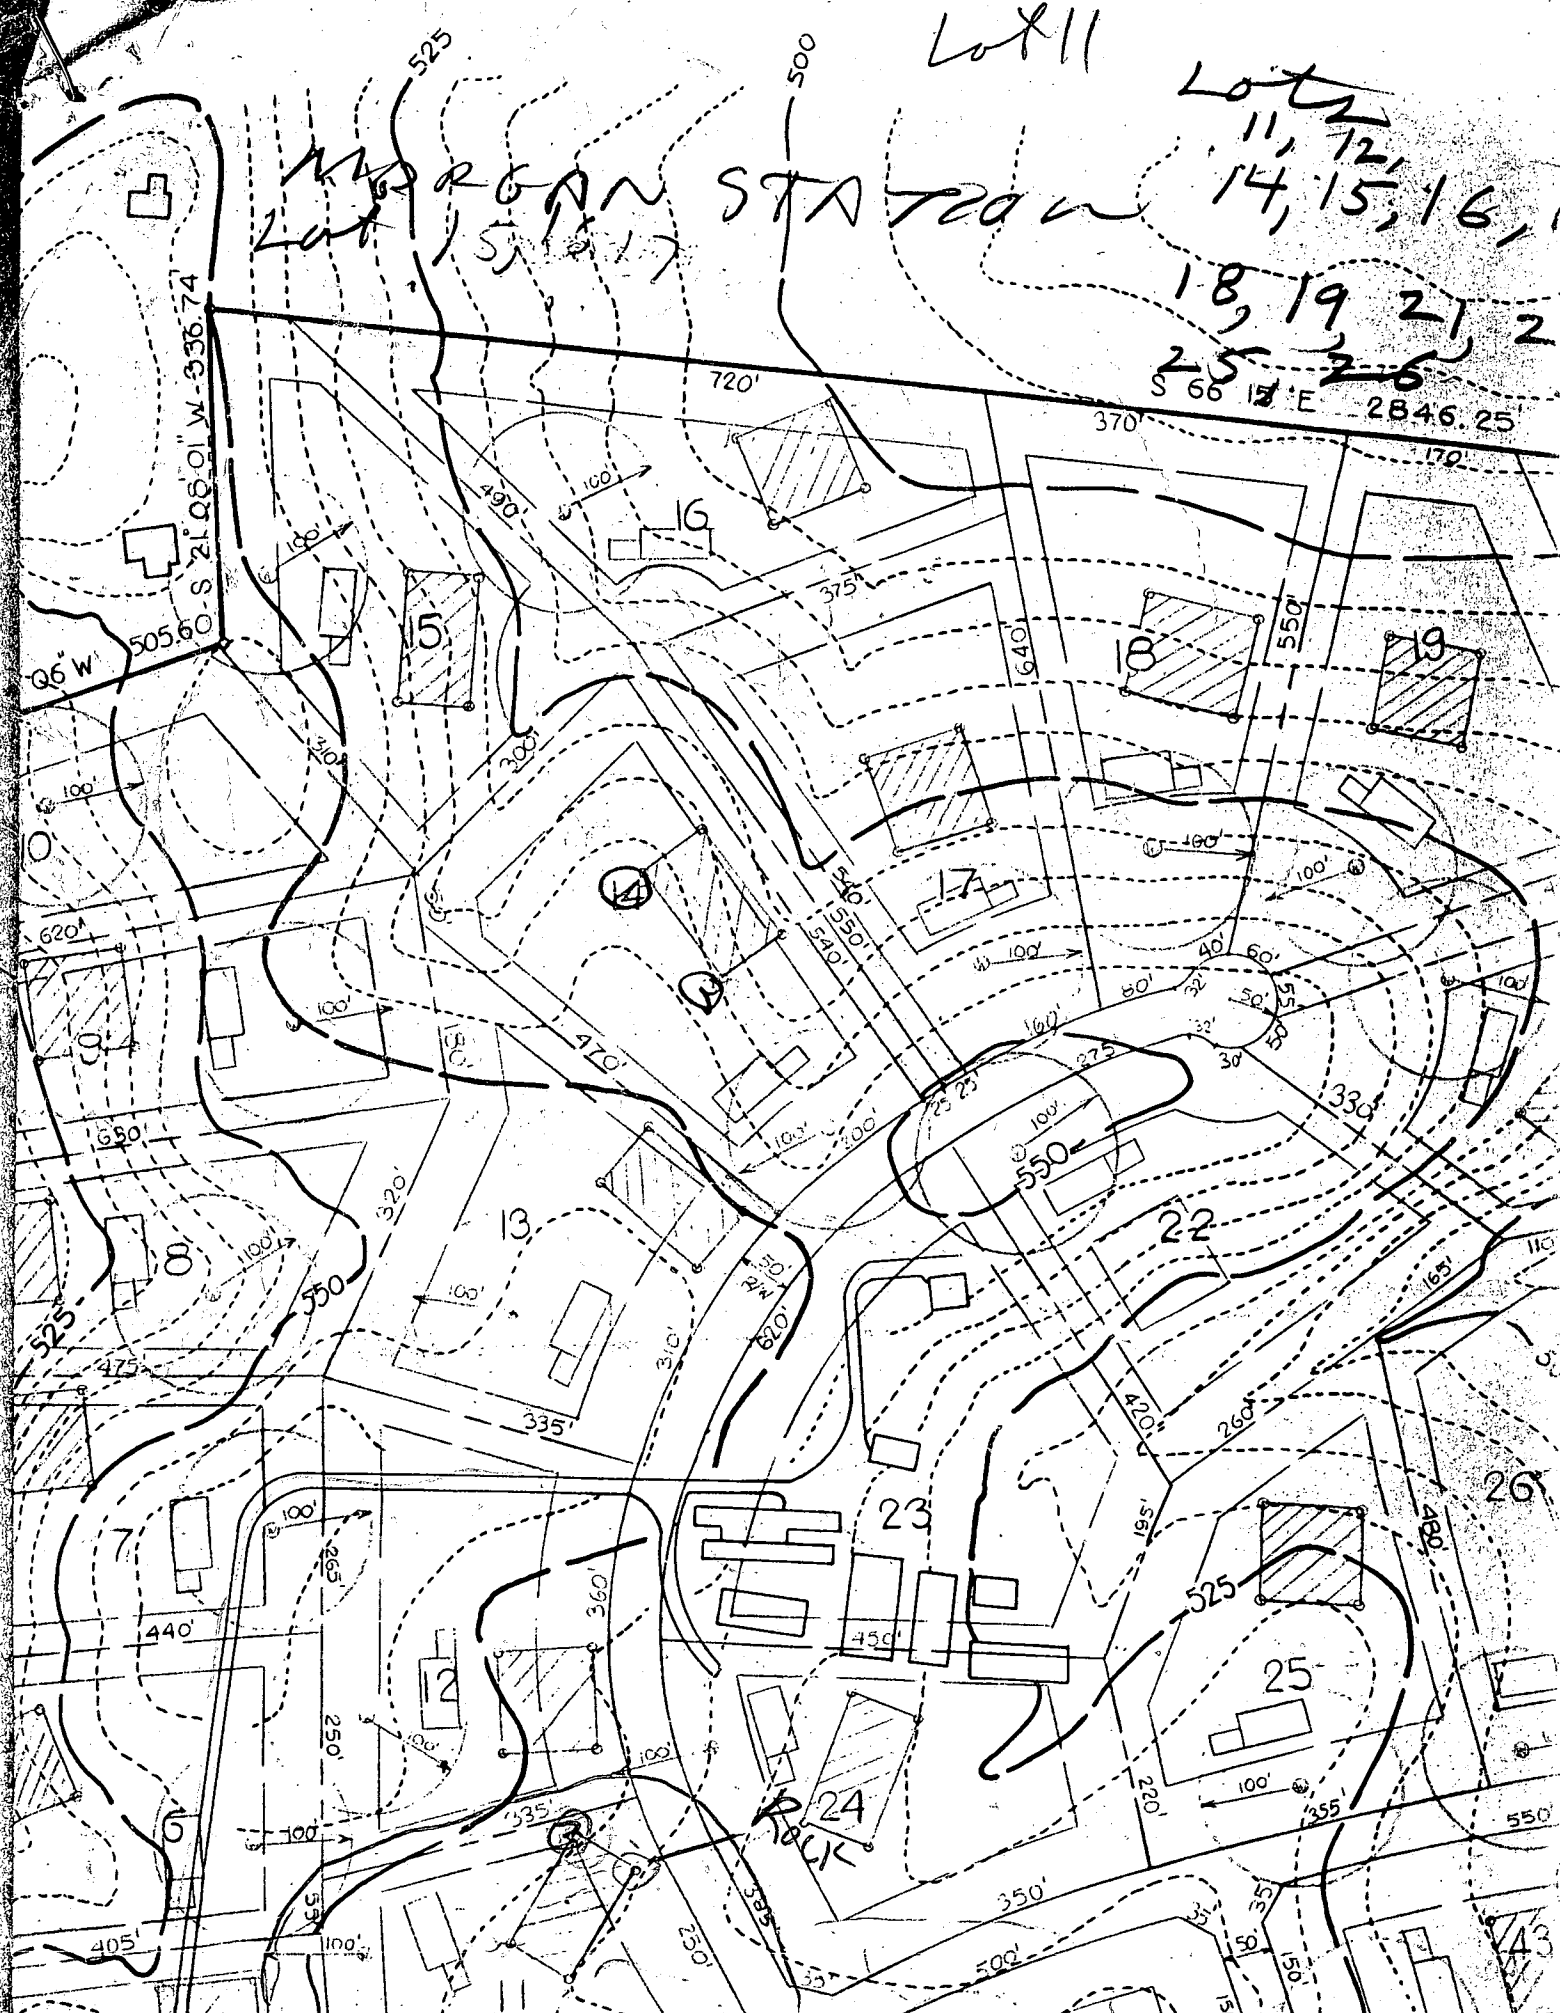

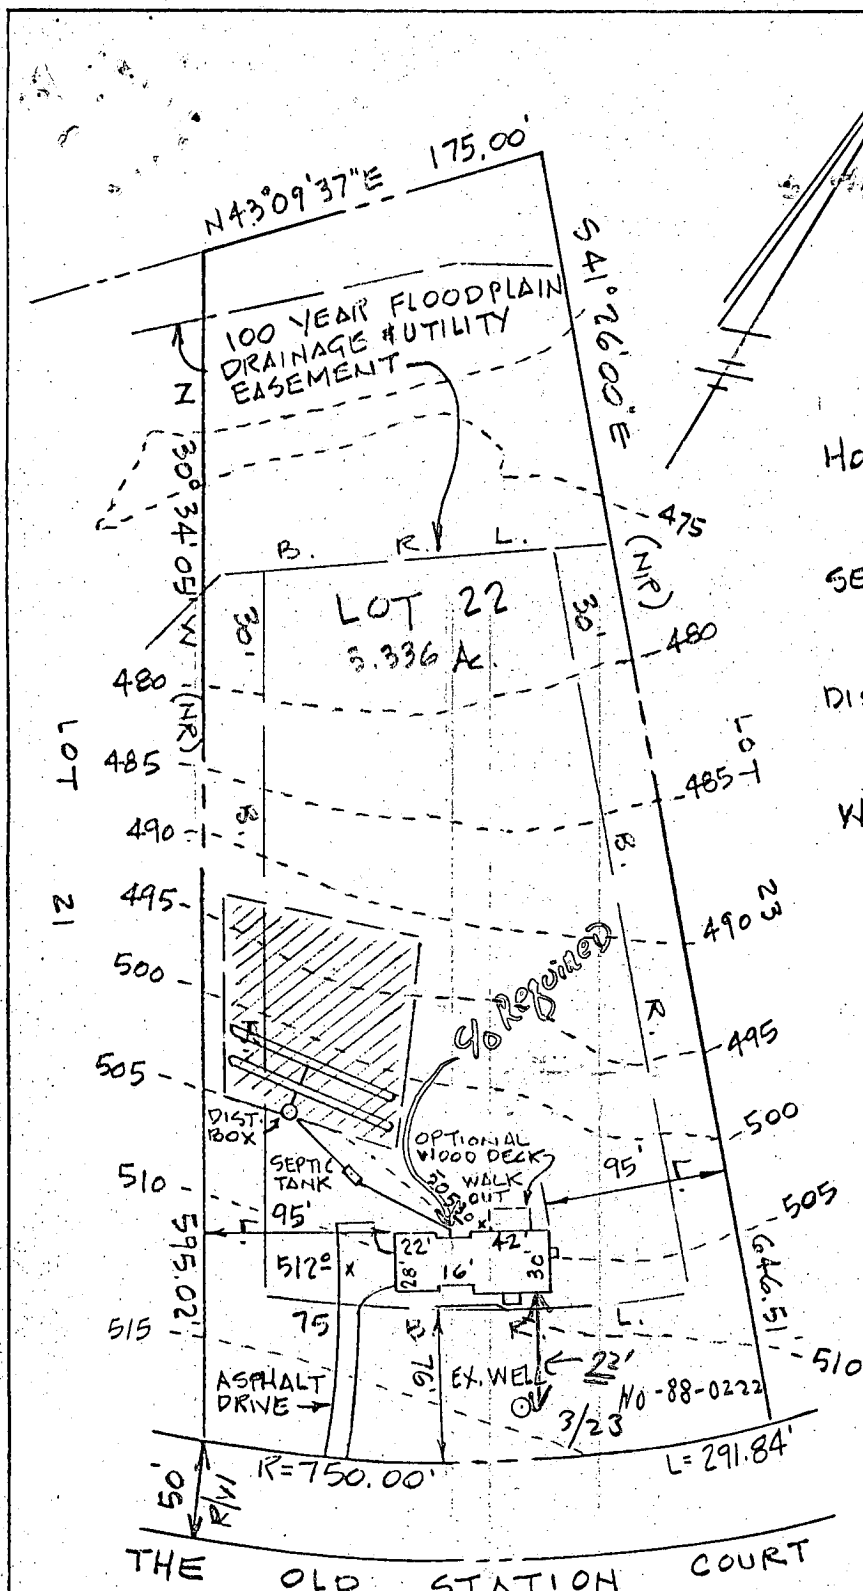

SEPTIC DATA

HOUSE FIN. FL.	515.00V
" BSM'T FL.	506.00V
" SEWER INV.	504.10V
SEPTIC TANK INV. IN.	503.00V
" INV. OUT.	502.70V
" FIN. GR.	507.00V
DIST. BOX INV. IN.	502.00V
" INV. OUT.	499.00 500.50
" FIN. GR.	505.00V
WELL EX. GR.	514.00V
" FIN. GR.	"

NOTE:
HOUSE IS REVERSIBLE TO MEET FIELD CONDITIONS AND BUYER PREFERENCE.

Elevations of
J. Alar

BDDG. PERMIT SIGNED
AND RETURNED 11/4/88

BP22259

ENGINEER

J. Alar John L. Schneider P.E.

100 N. Rolling Road

Catonsville, Md. 21228

744-1945

RECORD PLAT NO 7826 RECORDED 5/13/88

588-06

P88-25

F88-132

GRADING

STUDY

LOT 22 "MORGAN STATION"

4th ELECTION DISTRICT

HOWARD COUNTY - MD.

SCALE 1"=100'

OCT. 20, 1988



APPLICATION

PERCOLATION TESTING

HOWARD COUNTY HEALTH DEPARTMENT
BUREAU OF ENVIRONMENTAL HEALTH
P.O. BOX 476 ELLICOTT CITY, MARYLAND 21043
TELEPHONE: 461-9933

A 08730

P. _____

DISTRICT 4

DATE 12/17/86

TO: THE COUNTY HEALTH OFFICER
ELLICOTT CITY, MARYLAND

I HEREBY APPLY FOR THE NECESSARY TEST IN ORDER TO CONSTRUCT (OR RECONSTRUCT) A SEWAGE DISPOSAL SYSTEM.

PROPERTY OWNER Roy W. Crum + Wife

ADDRESS 791 Morgan Station Rd PHONE 489-4995

PROSPECTIVE BUYER Hemphill Partnership

ADDRESS 10176 Baltimore National Pike Suite 210 PHONE 465-5855

PROPERTY LOCATION:

SUBDIVISION Morgan Station (~~Crum Property~~) LOT NO. 24

ROAD AND DESCRIPTION E/S Morgan Station Rd north of Old Frederick Rd

TAX MAP 3 PARCEL # 9

SIZE OF LOT 3 acres TYPE BLDG SFD

(SINGLE FAMILY DWELLING OR COMMERCIAL)

THE SYSTEM INSTALLED UNDER THIS APPLICATION IS ACCEPTABLE ONLY UNTIL PUBLIC FACILITIES BECOME AVAILABLE. I FULLY UNDERSTAND THE

FEE CONNECTED WITH THE FILING OF THIS PERC TEST APPLICATION IS NON-REFUNDABLE UNDER ANY CIRCUMSTANCES. I ALSO AGREE TO COMPLY

WITH ALL M.O.S.H.A. REQUIREMENTS IN TESTING THIS LOT.

Paul S. Keim
(SIGNATURE OF APPLICANT)

APPROVED BY _____ FOR _____ DATE _____


REJECTED BY _____ FOR _____ DATE _____

HOLD PENDING FURTHER TESTS _____ DATE _____

REASONS FOR REJECTION OR HOLDING 4/30/87 PERC OK HOLD

FOR PLAT BH

THIS IS NOT A PERMIT

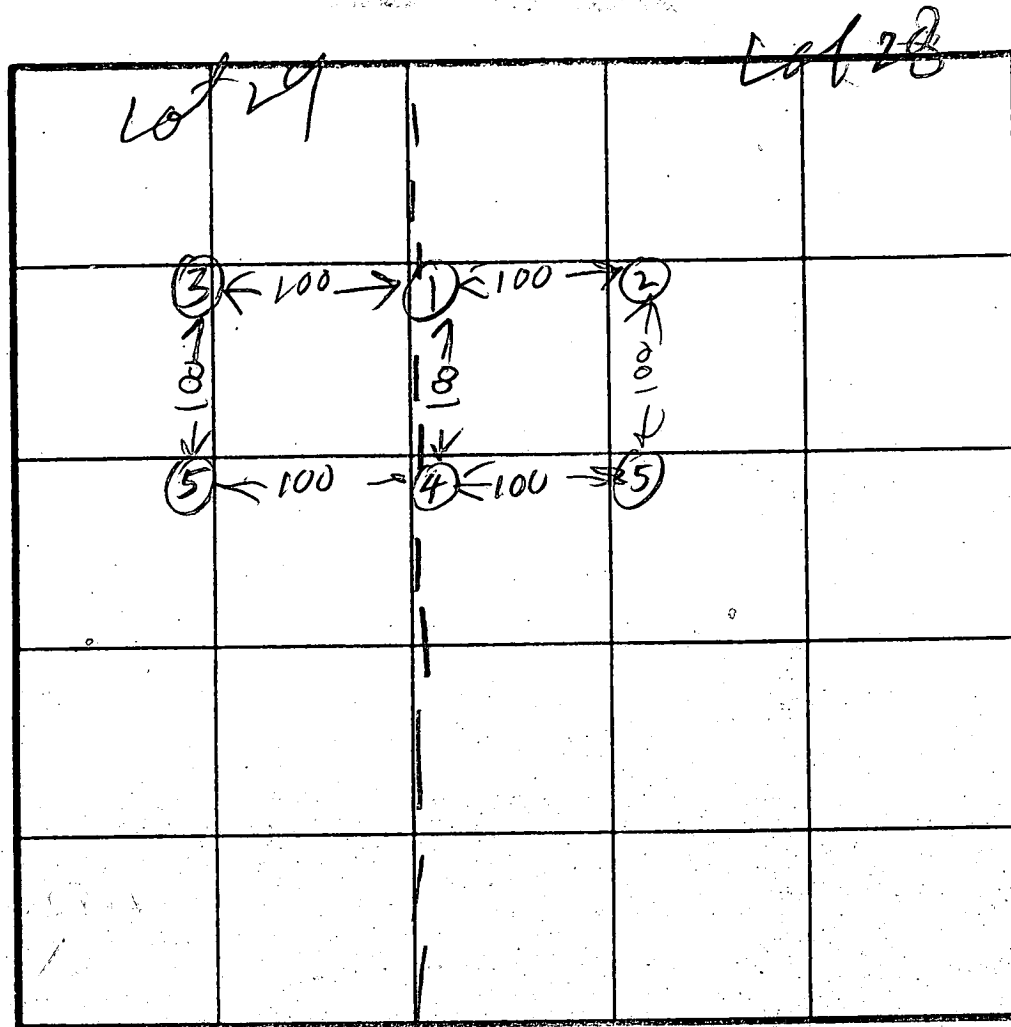

INDICATE NORTH - NAME ADJOINING ROADWAY AS BASE LINE.

DATE	TEST NO.	DEPTH	PRE-WET		TEST - 1" DROP		TIME
			START	STOP	START	STOP	
4/30/27	1S	3	3 26	3 30	3 30	3 33	3
	1D	6	3 26				
	1V	10	OK Start ROCK BOTTOM				
	2V	11	OK				
	3V	10	OK Start ROCK BOTTOM				
	4S	3.5	3 45	3 49	3 49	3 55	6
	4V	11	OK				
	5S	3	3 49	3 52	3 52	3 55	3
	5V	11	OK				
	6S	4.5	4 26	4 31	4 31	4 50	19
	6V	11					

av
time
5 min

max
depth
3 ft

BOTTOM
5"

180 #/cu

REMARKS

Lot lines different from original
Test Plot

TYPE OF SOIL

TESTED BY

ALSO PRESENT

SOIL PROFILE

CLAY

Brown
Green
Pink
Sand
Loam

(4)

CLAY

Gray
Brown
Sand
Loam
100% Sphulph

(5)

CLAY

Brown
Sand
Loam


(3)

CLAY

Brown
Sand
Loam


100% Sphulph
ROCK

LINE 5000
STATION
MATCH SHEET 5 OF 6

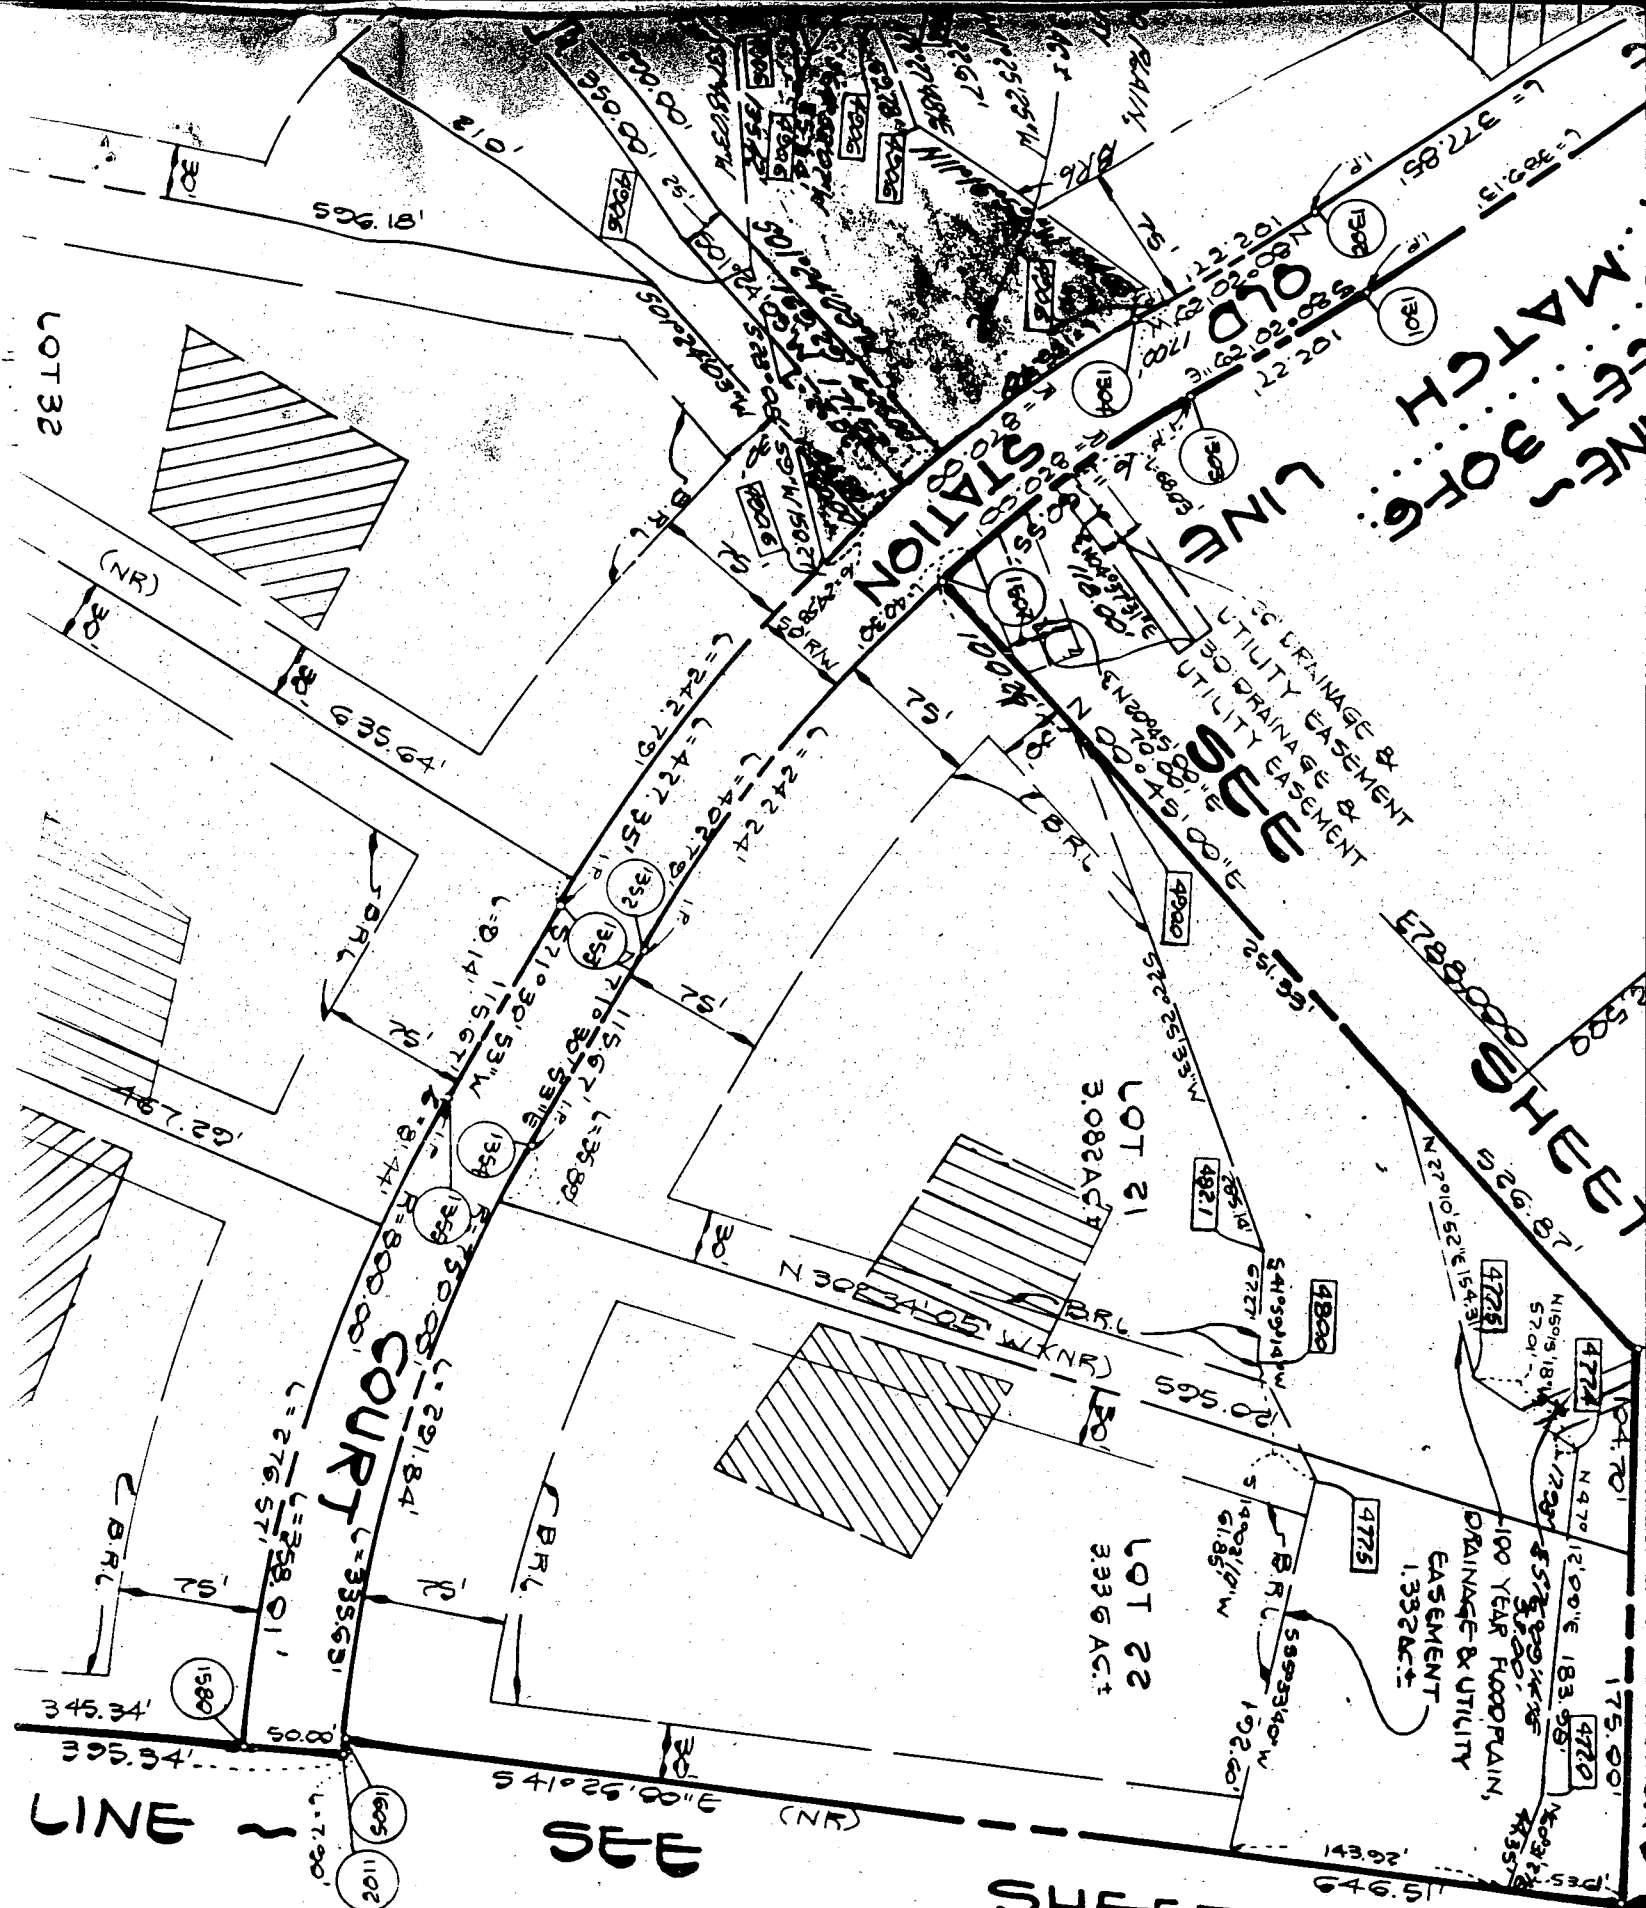

3- 88 1826 Signed Final

SHEET 5 OF 6

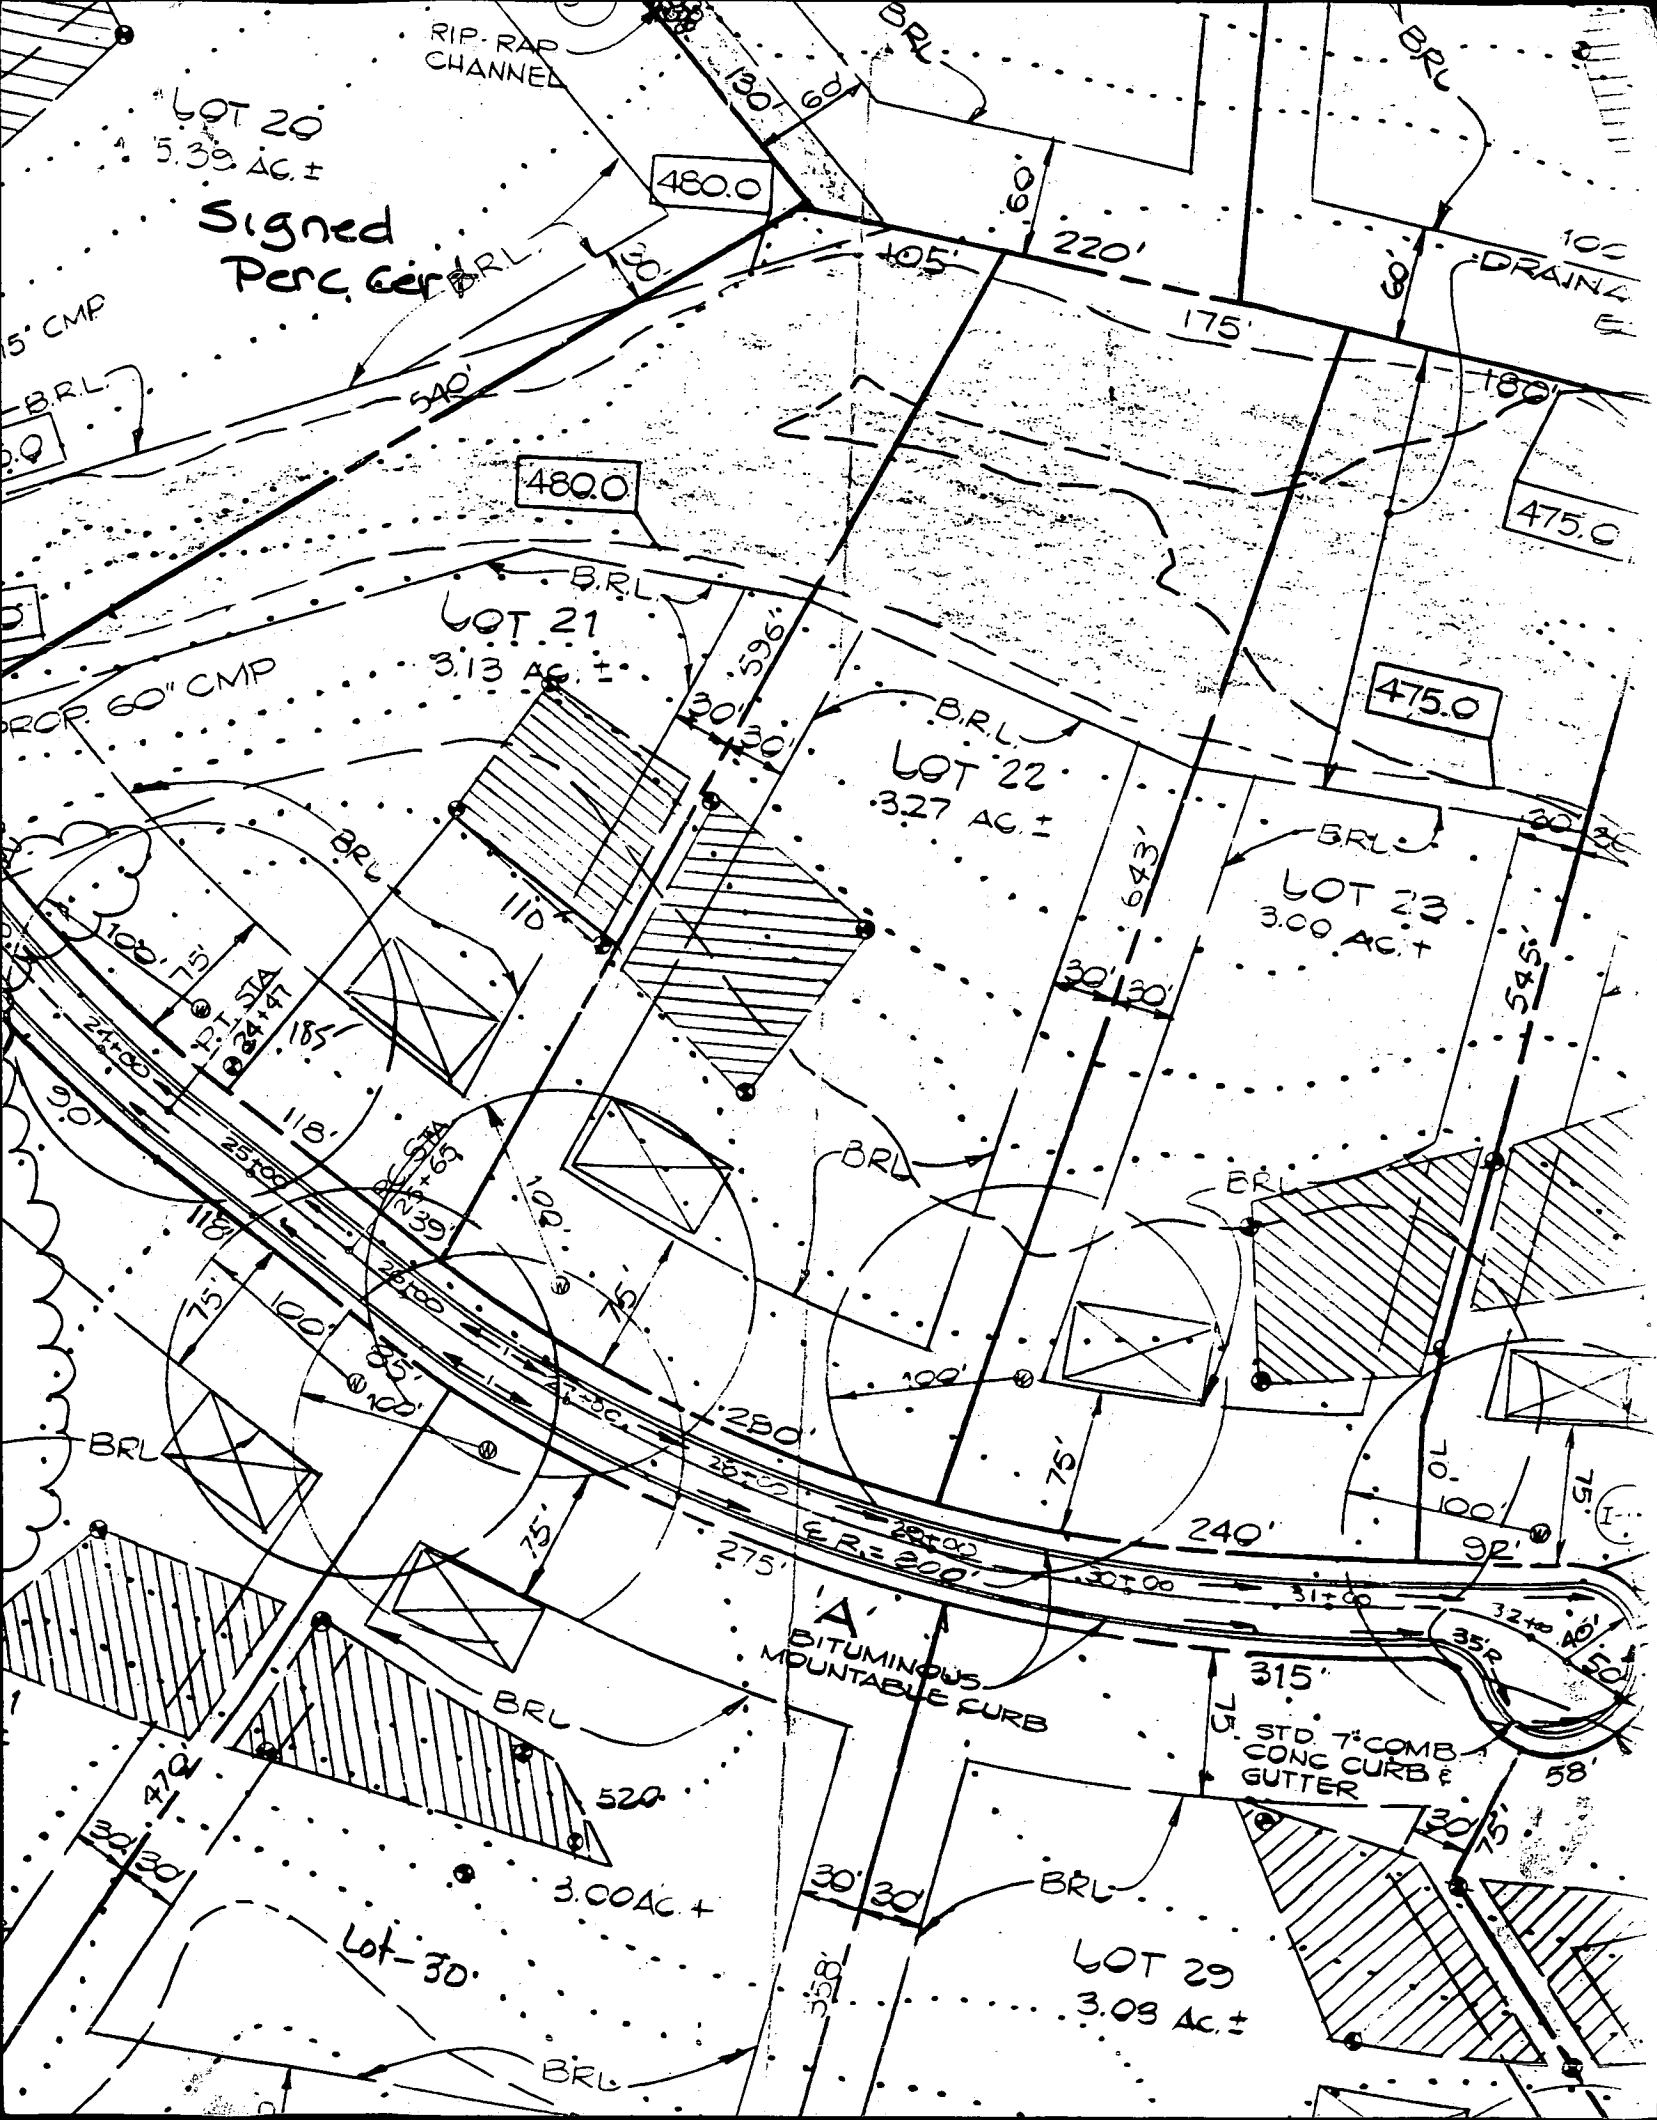

DEPARTMENT OF INSPECTIONS, LICENSES AND PERMITS 3430 COURT HOUSE DRIVE ELLCOTT CITY, MD 21043 PERMITS (410)313-2455, INSPECTIONS (410)313-1810 AUTOMATED INFORMATION (410) 313-3800	HOWARD COUNTY PERMIT APPLICATION	PERMIT NUMBER <u>B00115279</u>
---	---	--

Building Address <u>865 The Old Station Ct.</u> <u>Woodbine, MD 21719 21797</u>	Owner's Name <u>John & Janine Faulent</u>
Suite/Apt. #: _____ SDP/WP/Petition #: _____	Address <u>865 The Old Station Ct</u>
Census Tract _____ Subdivision <u>Morgan Station</u>	City <u>Woodbine</u> State <u>MD</u> Zip Code <u>21797</u>
Section _____ Area _____ Lot <u>222</u>	Home Phone <u>410-489-2913</u> Work Phone _____
Tax Map _____ Parcel _____ Grid _____	Applicant's Name & Mailing Address, (if other than stated hereon): _____
Zoning _____ Map Coordinates _____ Lot size <u>3.336 acs</u>	Phone _____ Fax _____
Existing Use <u>SFD</u>	Contractor Company <u>Residential Const. Svc.</u>
Proposed Use <u>SFD</u>	Contact Person <u>Marty Niessner Jr.</u>
Estimated Construction Cost \$ <u>15,000.00</u>	Address <u>5705 Landing Rd.</u>
Description of Work <u>Finish 1/2 of existing</u> <u>Unfinished basement</u> <u>1 BR - 1 family r.m.</u>	City <u>Elkridge</u> State <u>MD</u> Zip Code <u>21075</u>
Occupant or Tenant <u>John & Janine Faulent</u>	License No. <u>33225</u> Phone <u>410-379-5133</u> Fax _____
Contact Name <u>John</u>	Engineer or Architect Company _____
Address <u>865 The Old Station Ct.</u>	Contact Person _____
City <u>Woodbine</u> State <u>MD</u> Zip Code <u>21719</u>	Address _____
Phone <u>410-489-2913</u> Fax _____	City _____ State _____ Zip Code _____
	Phone _____ Fax _____

BUILDING DESCRIPTION - <u>COMMERCIAL</u>		BUILDING DESCRIPTION - <u>RESIDENTIAL</u>	
Building Characteristics	Utilities	Building Characteristics	Utilities
Height: <u>20' ±</u>	Water Supply: _____ Public _____ Private _____	SF Dwelling ☒ SF Townhouse ☐	Water Supply: _____ Public _____ Private _____
No. of stories: <u>2</u>	Sewage Disposal: _____ Public _____ Private _____	1st floor: Depth <u>30'</u> Width <u>42'</u>	Sewage Disposal: _____ Public _____ Private _____
Gross area, sq. ft. per floor: <u>1400</u>	Electric Yes ☒ No ☐	2nd floor: <u>Same</u>	Electric Yes ☒ No ☐
Use group: _____	Gas Yes ☒ No ☐	Basement: <u>Same</u>	Gas Yes ☒ No ☐
Construction type: Reinforced Concrete _____ Structural Steel _____ Masonry _____ ☒ Wood Frame _____ State Certified Modular _____	Heating System: Electric ☒ Oil ☐ Natural Gas ☐ Propane Gas ☐	Finished Basement ☐ Unfinished Basement ☒	Heating System: Electric ☒ Oil ☐ Natural Gas ☐ Propane Gas ☐
	Sprinkler system: N/A ☐ NFPA #13 _____ Full _____ Partial _____ Other Suppression _____	Crawl space ☐ Slab on Grade ☐	Sprinkler system: N/A ☐ NFPA #13D _____ NFPA #13R _____ Other: _____
		No. of Bedrooms <u>4</u>	Dimensions: _____
		Multi-family dwellings: No. of efficiency units: _____ No. of 1 BR units: _____ No. of 2 BR units: _____ No. of 3 BR units: _____	Footings: _____
		Other: _____	Roof: _____
		State Certified Modular _____	State Certified Modular _____
		Manufactured Home _____	Manufactured Home _____

THE UNDERSIGNED HEREBY CERTIFIES AND AGREES AS FOLLOWS: (1) THAT HE/SHE IS AUTHORIZED TO MAKE THIS APPLICATION; (2) THAT THE INFORMATION IS CORRECT; (3) THAT HE/SHE WILL COMPLY WITH ALL REGULATIONS OF HOWARD COUNTY WHICH ARE APPLICABLE THERETO; (4) THAT HE/SHE WILL PERFORM NO WORK ON THE ABOVE REFERENCED PROPERTY NOT SPECIFICALLY DESCRIBED IN THIS APPLICATION; (5) THAT HE/SHE GRANTS COUNTY OFFICIALS THE RIGHT TO ENTER ONTO THIS PROPERTY FOR THE PURPOSE OF INSPECTING THE WORK PERMITTED AND POSTING NOTICES.

Marty Niessner Jr. Marty Niessner Jr.
Applicant's Signature Print Name
Residential Const. Svc. 12/12/98
Title/Company Date

Checks payable to: **DIRECTOR OF FINANCE OF HOWARD COUNTY**

**** PLEASE WRITE NEATLY AND LEGIBLY ****

- FOR OFFICE USE ONLY -

AGENCY <u>Land Development, DPZ</u> <u>State Highways</u> <u>Building Official</u> <u>Dev. Engineering, DPZ</u> <u>Health</u> <u>Fire Protection</u>	DATE <u>12/2/98</u>	SIGNATURE APPROVAL <u>A. McMiller</u>	DPZ SETBACK INFORMATION Front: _____ Rear: _____ Side: _____ Side St.: _____ All minimum setbacks met? YES ☐ NO ☐ Is Entrance Permit required? YES ☐ NO ☐ Is Historic District? YES ☐ NO ☐ Lot Coverage for NewTown Zone _____ SDP/Red-line approval date _____	PROPERTY ID# <u>38778</u> Filing Fee \$ _____ Permit Fee \$ <u>98</u> (.10 sq. ft. ☐ (.15 sq. ft. ☐ Excise Tax \$ _____ (.40 sq. ft. ☐ (.80 sq. ft. ☐ TOTAL FEES <u>118</u> Check # <u>2906</u> Validation # <u>14131</u> Accepted by: <u>a</u>
Is Sediment Control approval required prior to issuance? YES ☐ NO ☐			CONTINGENCY CONSTRUCTION START: ☐ ONE STOP SHOP: ☐	