

12/2/86
9:30 AM
4-11-86
3-13-87
AM
ASAP
15P

03-280861

approved
3/13/87
RH
P 38220
A REPAIR

PERMIT

SEWAGE DISPOSAL SYSTEM

MARYLAND STATE DEPARTMENT OF HEALTH

HOWARD COUNTY

BUREAU OF ENVIRONMENTAL HEALTH

XX9922330
461-9933

ELLICOTT CITY

DISTRICT

DATE 12/04/86

RECEIVED

Jenkins Brothers

IS PERMITTED TO INSTALL ☒ ALTER

ADDRESS 10439 Frederick Road, Ellicott City, MD 21043 PHONE 465-6646

SUBDIVISION ROAD 13016 Triadelphia Road LOT

PROPERTY OWNER Donald Miles

ADDRESS

IF GARBAGE GRINDER IS USED INCREASE SEPTIC TANK CAPACITY BY 50% AND ABSORPTION AREA BY 22%.

GARBAGE GRINDER? YES NO

4BR 500

SEPTIC TANK CAPACITY 1250 GALLONS NUMBER OF BEDROOMS 4

REPAIR - CALL FOR INSPECTION WHEN GROUND IS OPENED UP SO SANITARIAN CAN RECOMMEND REPAIR.

Install 480' of system $\swarrow$ VENT-VISUAL HOLE DUG
TRENCH TO BE NO DEEPER THAN 9' 480 SFT SIDEWALL AREA
12FT DEEP INLET 6FT 6FT STORM
RUN TRENCH OFF OLD DRY WELL
TOWARD BACK OF LOT 80FT LONG

PLANS APPROVED BY C. Williams

DATE 12/04/86

COVER NO WORK UNTIL INSPECTED AND APPROVED.

NEITHER THE HOWARD COUNTY COUNCIL NOR THE HEALTH DEPARTMENT IS RESPONSIBLE FOR THE SUCCESSFUL OPERATION OF ANY SYSTEM.

NOTE: IF TRENCH IS USED CALL FOR INSPECTION BEFORE AND AFTER PLACING GRAVEL IN TRENCH.

NOTE: NO DRY WELL SHALL EXCEED 15 FOOT IN DIAMETER. NO ABSORPTION TRENCH TO EXCEED 100 FEET IN LENGTH.

NOTE: ALL PIPE FROM HOUSE TO SEPTIC TANK MUST BE CAST IRON OR SCHEDULE 40 PVC OR ABS.

PERMIT VOID AFTER THREE YEARS.


NOTE: INSTALL STAND PIPE ON SEPTIC TANK AND DRY WELL. STAND PIPES MUST BE 6 INCHES IN DIAMETER. CAST IRON, CONCRETE OR TERRA COTTA, OR PVC OR ABS ACCEPTED. IF TOP OF SEPTIC TANK IS DEEPER THAN 3 FEET MANHOLE TO GRADE REQUIRED.

*INSTALLER IS RESPONSIBLE FOR OBTAINING FINAL APROVAL ON THIS PERMIT

*CALL 992-2330 FOR INSPECTION OF SEPTIC SYSTEMS.

EH - 2-1082

P 38220

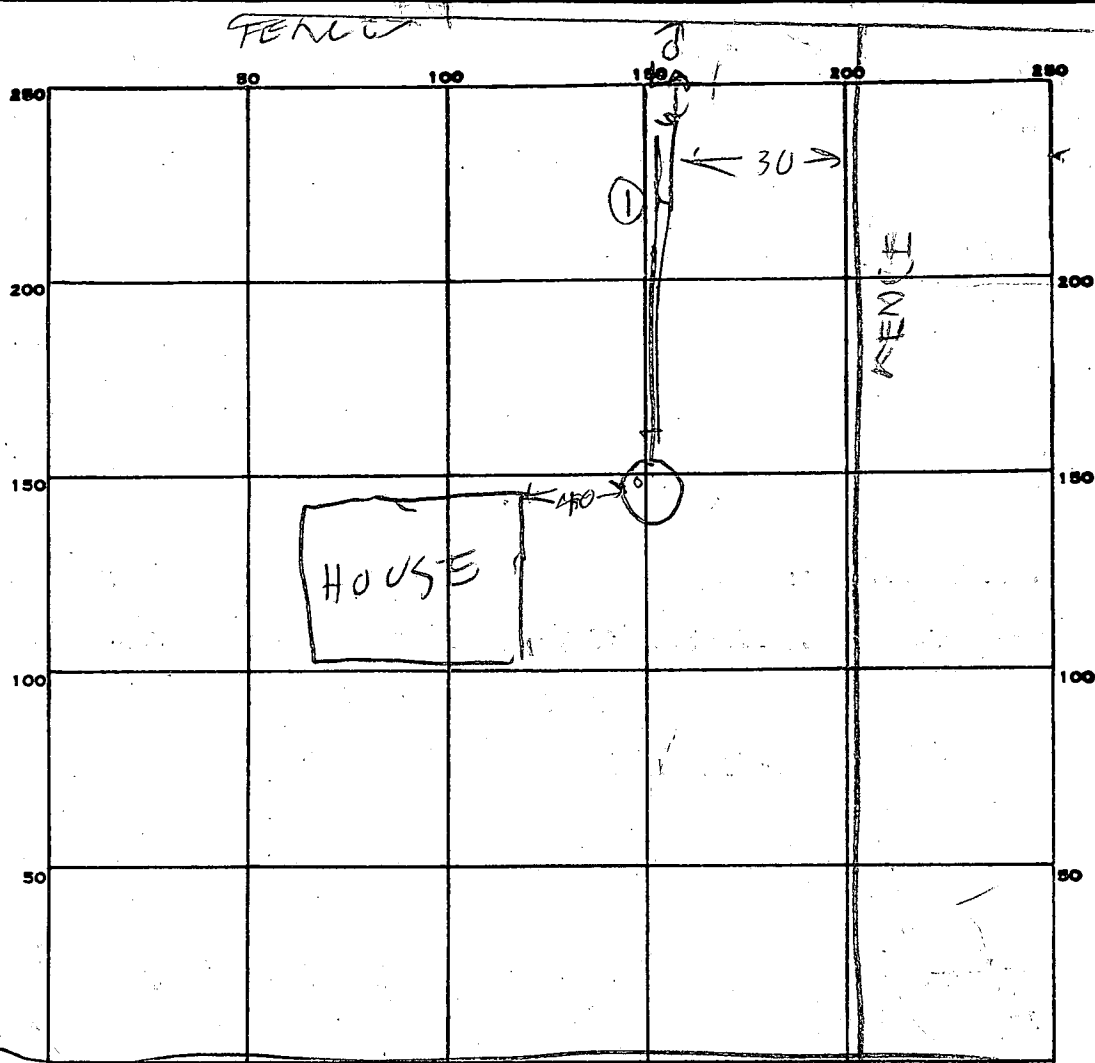

INDICATE NORTH. - NAME ADJOINING ROADWAY AS BASE LINE.

TRIDELPHIA RD

PERMIT CARD _____

SEPTIC TANK, LEVEL _____

CLEANOUTS _____

DISTRIBUTION BOX, LEVEL _____

TILE FIELD, DEPTH 12 FT. TRENCH WIDTH 2 FT.

GRAVEL DEPTH 6 IN. TOTAL LENGTH 80 FT.

NUMBER OF TRENCHES 1 TOTAL BOTTOM AREA 480


SEEPAGE PITS, INSIDE DIAMETER _____ FT. DEPTH BELOW INLET _____ FT.

ABSORBENT AREA _____ SQ. FT.


REMARKS 3/13/87 - SOIL OK TRENCH PARTLY DUG

FINISH DIGGING TRENCH & ADD STONE


DATE SYSTEM APPROVED 3/15/87 INSPECTOR Raymond Hodges

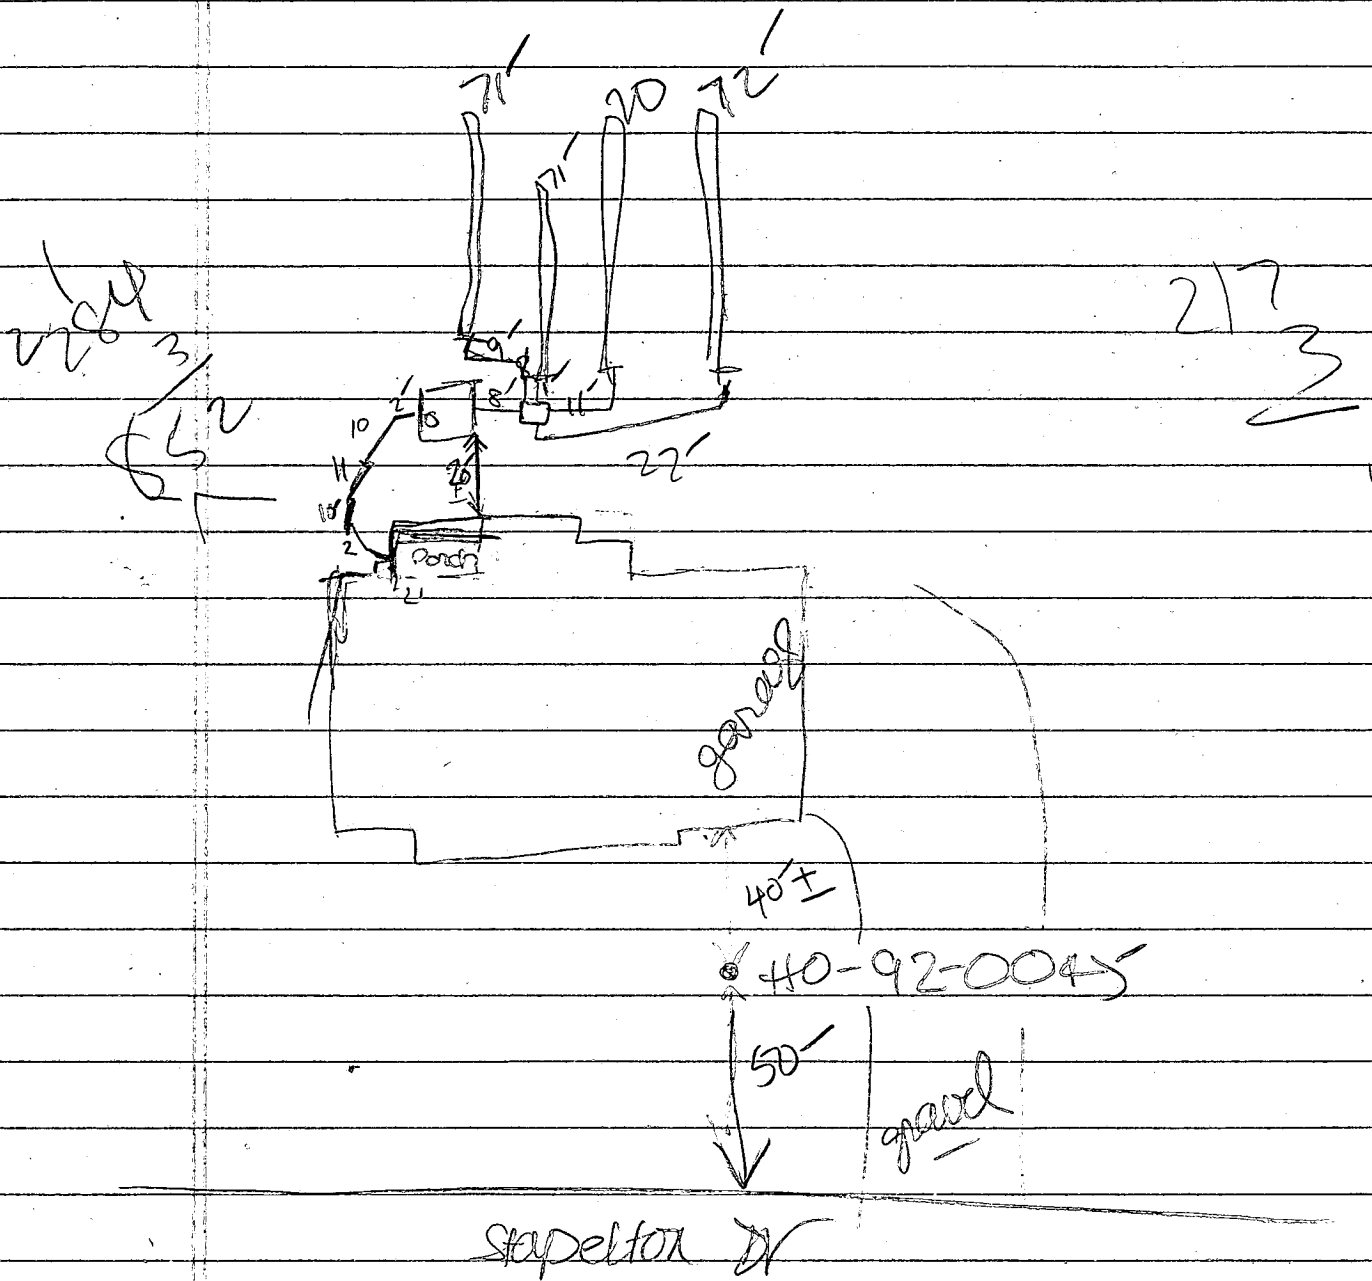

1301 (Philadelphia Rd)

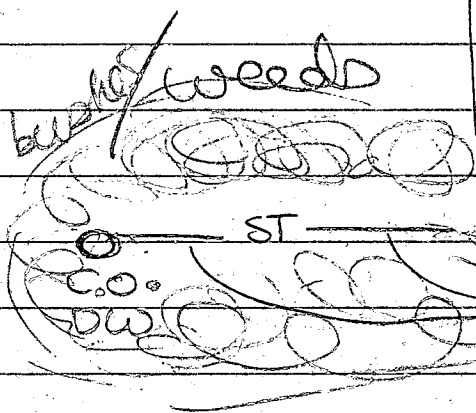

problems

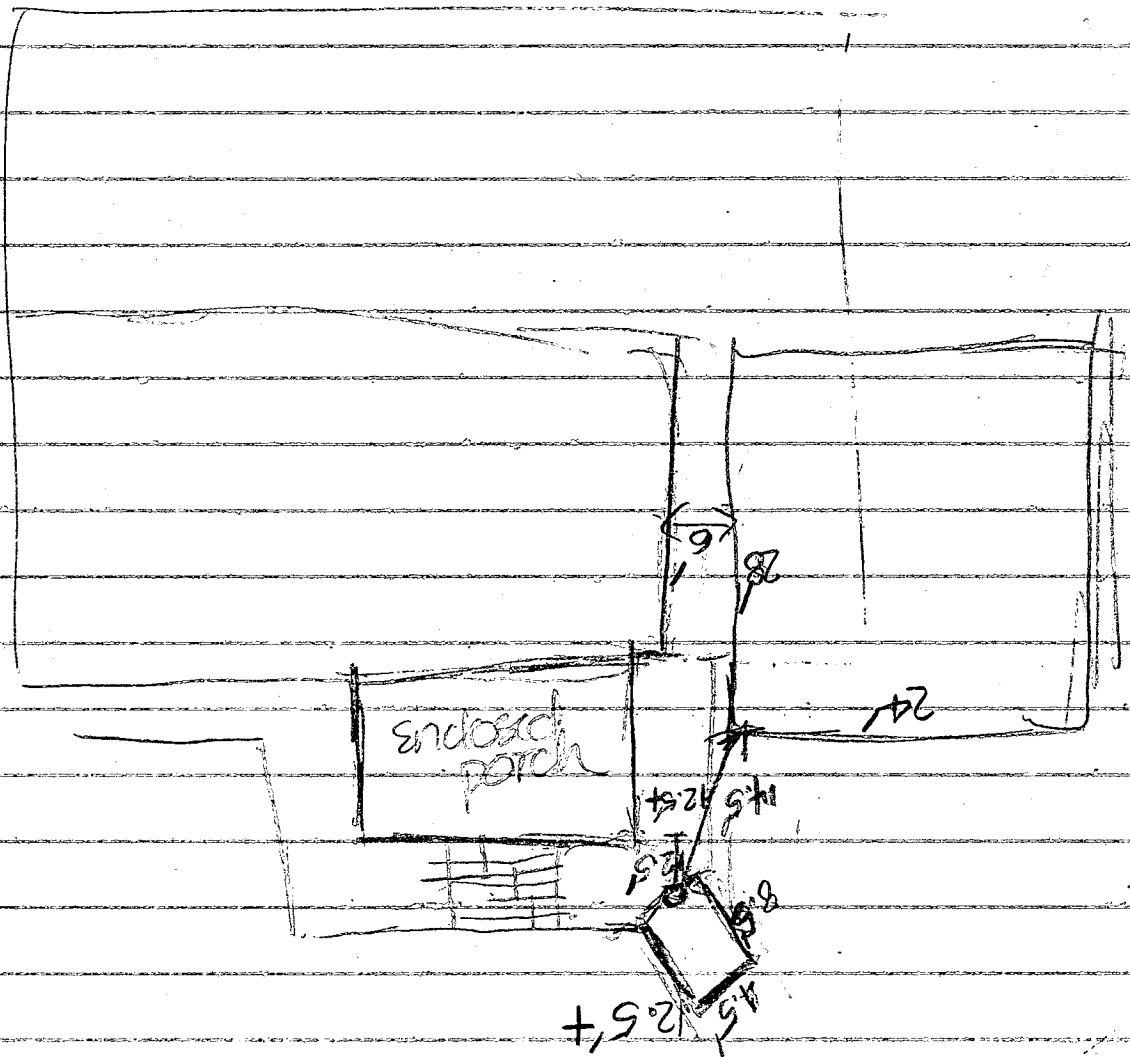

2.0' → to garage