

05 - ~~30~~ 353718

## PERMIT

P 38758A REPAIR

SEWAGE DISPOSAL SYSTEM

MARYLAND STATE DEPARTMENT OF HEALTH

DISTRICT \_\_\_\_\_

HOWARD COUNTY

DATE 2/19/87

BUREAU OF ENVIRONMENTAL HEALTH

461-9933

INDEXED

DATE SYSTEM APPROVED 2-19-87INSPECTOR S. AlulJack FyockIS PERMITTED TO INSTALL \_\_\_\_\_ ALTER XADDRESS \_\_\_\_\_ PHONE 988-9270SUBDIVISION \_\_\_\_\_ ROAD 14021 Triadelphia Road LOT \_\_\_\_\_PROPERTY OWNER Don Ridgley, Jr. / Calvin R. Kinna14021 Triadelphia Road

ADDRESS \_\_\_\_\_

IF GARBAGE GRINDER IS USED INCREASE SEPTIC TANK CAPACITY BY 50% AND ABSORPTION AREA BY 22%.

GARBAGE GRINDER? YES \_\_\_\_\_ NO \_\_\_\_\_

SEPTIC TANK CAPACITY \_\_\_\_\_ GALLONS NUMBER OF BEDROOMS \_\_\_\_\_

REPAIR - CALL FOR INSPECTION WHEN GROUND IS OPENED UP SO SANITARIAN CAN RECOMMEND REPAIR.

REPAIR. LEACH BED 7' WIDE INLET 3.5 BOTTOM 5.5 LENGTH 50' MINMAINTAIN 50' FROM OWNERS WELL 75' FROM NEIGHBORING WELLS, REQUIREMONITORING PORT. WATER SAMPLE TAKEN FROM HOUSE TO DETERMINE QUALITY.Soil Profile - 0-6" A 1.3 6" - 36" Yellow Br. CLAY LOAM < 10% FRAGS;36" TO 8' Yellow Br Silty SAND LOAM Tight BOTTOM VERY Tight SANDY SOIL.PLANS APPROVED BY C. Williams DATE 2/18/87 S. Alul

COVER NO WORK UNTIL INSPECTED AND APPROVED.

NEITHER THE HOWARD COUNTY COUNCIL NOR THE HEALTH DEPARTMENT IS RESPONSIBLE FOR THE SUCCESSFUL OPERATION OF ANY SYSTEM.

NOTE: CLEANOUT REQUIRED EVERY 70 FEET OF SEWER LINE AND/OR AT 90° SWEEPS IN LINES FROM HOUSE TO DRAIN FIELDS.

NOTE: ALL PARTS OF SEPTIC SYSTEMS (I.E., TANK, DISTRIBUTION BOX, TRENCHES) TO BE 100 FEET FROM WELL (UNLESS OTHERWISE SPECIFICALLY AUTHORIZED)

NOTE: IF DEEP TRENCH(ES) ARE USED CALL FOR INSPECTION BEFORE AND AFTER PLACING GRAVEL IN TRENCH(ES).

NOTE: NO DRY WELL SHALL EXCEED 15 FOOT IN DIAMETER. NO ABSORPTION TRENCH TO EXCEED 100 FEET IN LENGTH.

NOTE: ALL PIPE FROM HOUSE TO SEPTIC TANK MUST BE CAST IRON OR SCHEDULE 40 PVC OR ABS.

PERMIT VOID AFTER TWO YEARS.

NOTE: INSTALL STAND PIPE ON SEPTIC TANK AND DRY WELL. STAND PIPES MUST BE 6 INCHES IN DIAMETER. CAST IRON, CONCRETE OR TERRA COTTA OR PVC OR ABS ACCEPTED. IF TOP OF SEPTIC TANK IS DEEPER THAN 3 FEET, MANHOLE TO GRADE REQUIRED.

NOTE: DISTRIBUTION BOXES MUST HAVE BAFFLES.

BLOG. PERMIT SIGN'D

AND RETURNED 3-25-88Serial # BM110565Shirley Kram


\*INSTALLER IS RESPONSIBLE FOR OBTAINING FINAL APPROVAL ON THIS PERMIT

\*CALL 461-9933 FOR INSPECTION OF SEPTIC SYSTEMS.

EH - 2-1186

P 38758

$$\begin{array}{r}
 85.5 \\
 27.5 \\
 \hline
 113.0 \\
 28.5 \\
 \hline
 141.5
 \end{array}$$

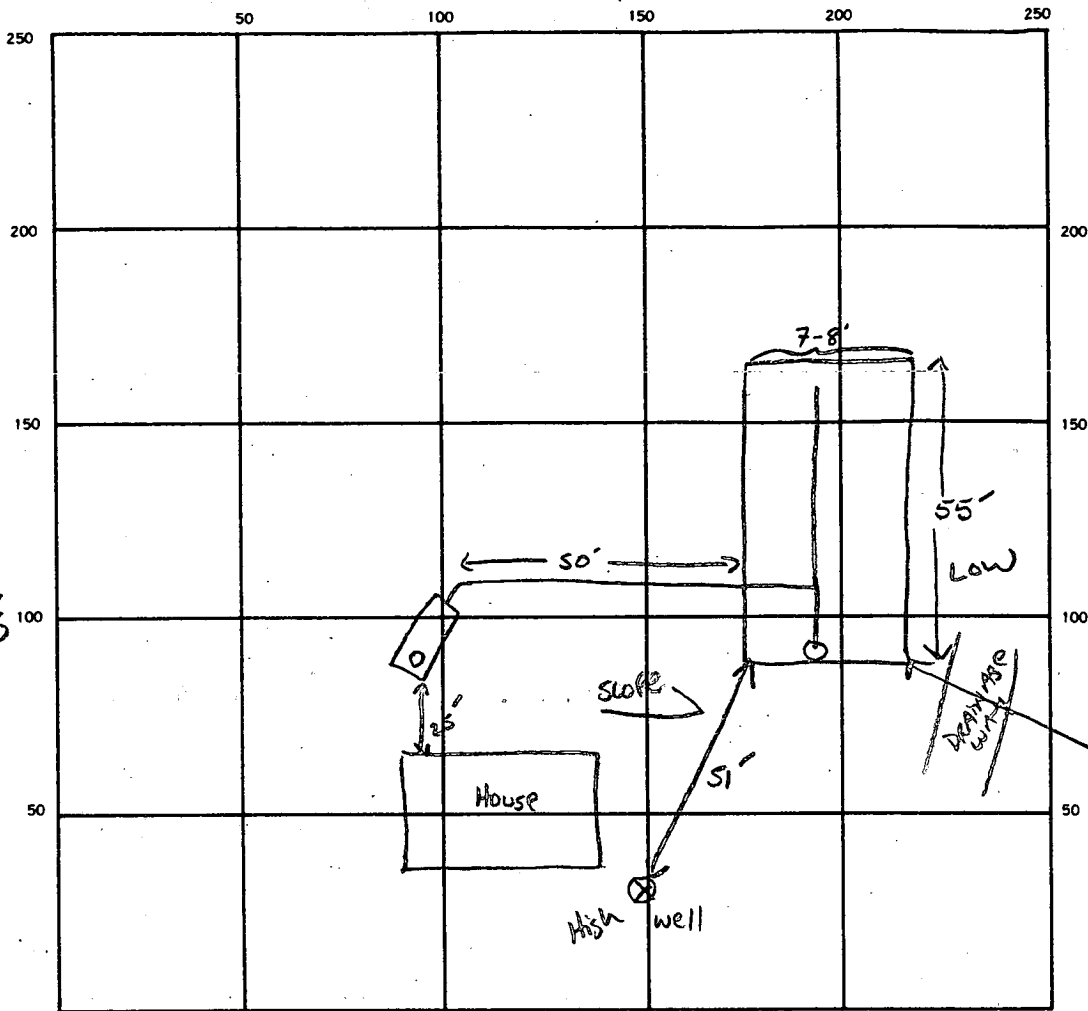

INDICATE NORTH. — NAME ADJOINING ROADWAY AS BASE LINE.


Triadelphia Rd.

SEPTIC TANK LEVEL EXISTING CLEANOUTS ST / OBSERVATION PORT END OF TRENCH  
 DISTRIBUTION BOX LEVEL N/A  
 DRAIN FIELD/TILE FIELD DEPTH 5.5' FT. TRENCH WIDTH 7.5' FT. INLET DEPTH 3.5 FT.  
 EFFECTIVE GRAVEL DEPTH 210' FT. TOTAL LENGTH 55' FT.  
 NUMBER OF TRENCHES 1 ONE SIDEWALL/BOTTOM AREA 412.5 SQ. FT.  
 DRYWELL INSIDE DIAMETER — FT. EFFECTIVE DEPTH BELOW INLET — FT.  
 ABSORBENT AREA 412.5 SQ. FT.

REMARKS LEACHING BED OK TO COVER / S. AWP

DATE SYSTEM APPROVED 2-19-87 INSPECTOR S. AWP

**BALTIMORE 876-1226**

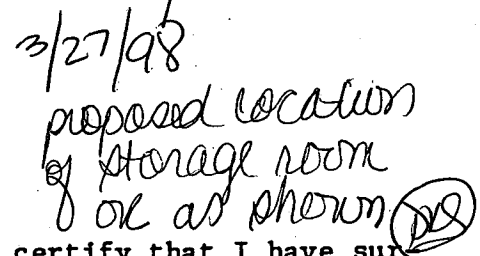

Westminster, this 31-st day of  
December, 1986.



See. or J. 10. 10. 2

Department of Planning and Zoning  
Howard County, Maryland  
Recommendations/Comments

Date: 4/23/98

Planning Board \_\_\_\_\_ Board of Appeals 6/2/978 Zoning Board \_\_\_\_\_

Petition No. BA98-18V Map No. 21 Block 18 Parcel 54 Lot \_\_\_\_\_

Return comments by 5/15/98 to Comprehensive Planning and Zoning Administration.

Location of Property: South side of Triadelphia Rd & approx. 1700' N of Sharp Rd.

Applicant: Calvin R. and Cecelia M. Kinna


Applicant's Address: 14021 Triadelphia Road, Glenelg, MD 21737

Owner: (if other than applicant) \_\_\_\_\_

Owner's Address: \_\_\_\_\_

Petition: a variance to reduce the 75' s/b requirement on a minor collector  
Route for an addition on the rear side of an existing single family home b  
32' approx. to 43'. Existing structure is grand-fathered  
\*\*\*\*\*

TO:

 ☒ Department of Education  
☒ Bureau of Environmental Health  
☒ Development Engineering Division  
☒ Department of Inspections, Licenses and Permits  
☒ Department of Recreation and Parks  
☒ Department of Fire and Rescue Services  
☒ State Highway Administration  
Sgt. Karen Shinham, Howard Cty. Police Dept.  
James Irvin, Department of Public Works  
MD Depart. of Human Resources, Fran Sterner (child day care)  
Office on Aging, Barbara Harris (Senior Asst. Living)  
Police Department, Animal Control, Brenda Purvis (kennels)

COMMENTS: No objections; Building permit B00110565 was signed March 27, 1998

Mark E. Rifkin 5/14/98  
(Signature)