

05-363322

PERMIT

SEWAGE DISPOSAL SYSTEM
HOWARD COUNTY HEALTH DEPARTMENT
 BUREAU OF ENVIRONMENTAL HEALTH
 410-313-2640

P. 38892

A 17308

ISSUE DATE _____

APPROVAL DATE _____

_____ IS PERMITTED TO INSTALL _____ ALTER _____

ADDRESS _____ PHONE _____

SUBDIVISION Hawkes Property LOT NUMBER 103 ^{Parcel} ADDRESS 14945 Triadelphia RoadPROPERTY OWNER Hawkes PROPERTY OWNER'S ADDRESS _____

SEPTIC TANK CAPACITY _____ GALLONS

PUMP CHAMBER CAPACITY _____ GALLONS

NUMBER OF BEDROOMS _____

SQUARE FEET PER BEDROOM _____

LINEAR FEET OF TRENCH REQUIRED _____

TRENCHES: Trenches to be _____ feet wide. Inlet _____ feet below original grade. Bottom maximum depth
 _____ feet below original grade. _____ feet of stone below distribution box.

LOCATION: _____

PLANS APPROVED _____ DATE _____

PERMIT VOID AFTER 2 YEARS

NOTE: CONTRACTOR RESPONSIBLE FOR SCHEDULING A PRE-CONSTRUCTION INSPECTION FOR ALL INSTALLATIONS

NOTE: TOP OF SEPTIC TANKS ARE TO BE NO DEEPER THAN 3.0 FEET BELOW FINISH GRADE

NOTE: WATERTIGHT SEPTIC TANKS REQUIRED

NOTE: CLEANOUT REQUIRED EVERY 70 FEET OF SEWER LINE AND/OR AT 90° SWEEPS IN LINES FROM HOUSE TO DRAIN FIELDS, 90° ELBOWS ARE NOT ACCEPTABLE

NOTE: ALL PARTS OF SEPTIC SYSTEMS (I.E. TANK, DISTRIBUTION BOX, DRAINFIELDS) TO BE 100 FEET FROM ANY WATER WELL UNLESS OTHERWISE SPECIFICALLY AUTHORIZED

NOTE: NO ABSORPTION TRENCH TO EXCEED 100 FEET IN LENGTH UNLESS SPECIFICALLY AUTHORIZED

NOTE: ALL PIPE FROM HOUSE TO SEPTIC TANK MUST BE CAST IRON OR SCHEDULE 35/40 PVC OR ABS

NOTE: MANHOLE RISERS REQUIRED ON ALL SEPTIC TANKS AND PUMP CHAMBERS

NOTE: DISTRIBUTION BOXES MUST HAVE BAFFLES

NOTE: IF PUMPED SEPTIC SYSTEM REQUIRED, (1) SEPTIC PUMP DETAIL TO BE PROVIDED BY INSTALLER PRIOR TO ISSUANCE OF SEPTIC PERMIT (2) PUMP PERFORMANCE TEST IS NECESSARY PRIOR TO HEALTH DEPARTMENT APPROVAL OF SEPTIC PERMIT

NEITHER THE HOWARD COUNTY COUNCIL NOR THE HEALTH DEPARTMENT IS RESPONSIBLE FOR THE
 SUCCESSFUL OPERATION OF ANY SYSTEM

PERMITTEE RESPONSIBLE FOR OBTAINING FINAL APPROVAL ON THIS PERMIT
 CALL 410-313-2640 FOR INSPECTION OF SEPTIC SYSTEM

BLDG. PERMIT SIGNED
 NO RETURNED 5/16/01
 1300130219
 port: 23

38892

NOT TO SCALE

TRENCH DATA

TRENCH WIDTH _____

TRENCH INLET DEPTH _____

TRENCH BOTTOM DEPTH _____

DEPTH OF STONE _____

NUMBER OF TRENCHES _____

TOTAL TRENCH LENGTH _____

ABSORBENT AREA _____

DISTRIBUTION BOX LEVEL _____

BAFFLE IN DISTRIBUTION BOX _____

SEPTIC TANK DATA

SEPTIC TANK _____ GALLONS

MANHOLE RISER _____

6 INCH INSPECTION PORT _____

PUMP CHAMBER DATA

PUMP CHAMBER
GALLONS _____

MANHOLE RISER _____

ALARM _____

PUMP PERFORMANCE TEST _____

PRE-CONSTRUCTION INSPECTION: _____

INSPECTION COMMENTS: _____

INSPECTOR _____ DATE SYSTEM APPROVED _____

PERMIT

SEWAGE DISPOSAL SYSTEM

MARYLAND STATE DEPARTMENT OF HEALTH DISTRICT 4th

HOWARD COUNTY
BUREAU OF ENVIRONMENTAL HEALTH
481-9933

INDEXED

DATE 3/10/87

DATE SYSTEM APPROVED 7-7-87

INSPECTOR JEN

Whitworth Excavating

IS PERMITTED TO INSTALL X ALTER

ADDRESS 12680 Clarksville Pike, Clarksville, MD 21029 PHONE 854-2513

SUBDIVISION ROAD 14945 Trindelpia Road OT Tax Map 25 Parcel 103

PROPERTY OWNER Ken & Donna Hawkes

ADDRESS

IF GARBAGE GRINDER IS USED INCREASE SEPTIC TANK CAPACITY BY 50% AND ABSORPTION AREA BY 22%.

GARBAGE GRINDER? YES NO X

SEPTIC TANK CAPACITY 1250 GALLONS NUMBER OF BEDROOMS 4

TRENCHES - 200 sq. ft. per bedroom. Trench to be 2 feet wide. Inlet 4 feet below original grade. Bottom maximum depth 8 feet below original grade. Effective area begins at 4 feet below original grade. 4 feet of stone below distribution pipe.

LOCATION - Beginning from right front lot corner, place 1st trench 290 feet down the right (739.60') and 80 feet off the right line as seen when facing property from Trindelpia Road. Run trenches along contour towards the left (899.00') lot line. NOTE: MAINTAIN MINIMUM 100 FEET DISTANCE FROM WELL TO SEPTIC.

NOTE - No trench to exceed 100 feet in length. Provide 6" - 8" diameter cleanout and cap to grade or above on septic tank. ok

PLANS APPROVED BY Bert Nixon

DATE 1/13/87

COVER NO WORK UNTIL INSPECTED AND APPROVED

NEITHER THE HOWARD COUNTY COUNCIL NOR THE HEALTH DEPARTMENT IS RESPONSIBLE FOR THE SUCCESSFUL OPERATION OF ANY SYSTEM

NOTE CLEANOUT REQUIRED EVERY 70 FEET OF SEWER LINE AND/OR AT 90° SWEEPS IN LINES FROM HOUSE TO DRAIN FIELDS

NOTE ALL PARTS OF SEPTIC SYSTEMS (I.E. TANK, DISTRIBUTION BOX, TRENCHES) TO BE 100 FEET FROM WELL (UNLESS OTHERWISE SPECIFICALLY AUTHORIZED)

NOTE IF DEEP TRENCHES ARE USED CALL FOR INSPECTION BEFORE AND AFTER PLACING GRAVEL IN TRENCHES

NOTE NO DRY WELL SHALL EXCEED 15 FOOT IN DIAMETER NO ABSORPTION TRENCH TO EXCEED 100 FEET IN LENGTH

NOTE ALL PIPE FROM HOUSE TO SEPTIC TANK MUST BE CAST IRON OR SCHEDULE 40 PVC OR ABS

PERMIT VOID AFTER TWO YEARS

NOTE INSTALL STAND PIPE ON SEPTIC TANK AND DRY WELL STAND PIPES MUST BE 6 INCHES IN DIAMETER CAST IRON, CONCRETE OR TERRA COTTA OR PVC OR ABS ACCEPTED IF TOP OF SEPTIC TANK IS DEEPER THAN 3 FEET MANHOLE TO GRADE REQUIRED

NOTE DISTRIBUTION BOXES MUST HAVE BAFFLES

*INSTALLER IS RESPONSIBLE FOR OBTAINING FINAL APPROVAL ON THIS PERMIT

*CALL 481-9933 FOR INSPECTION OF SEPTIC SYSTEMS.

EH - 2-1105

A 17301

3811 (THIS NUMBER IS TO BE PUNCHED IN COLUMNS 34 ON ALL CARDS)		SECURITY NO. (DEP USE ONLY)		STATE OF OHIO WELL COMPLETION REPORT FILL IN THIS FORM COMPLETELY PLEASE PRINT OR TYPE		COUNTY NUMBER A-17308	
DATE RECEIVED 		DATE WELL COMPLETED 30282		DEPTH OF WELL 200 (TO NEAREST FOOT)		PERMIT NO. 10-11-134	
OWNER WATERBURY		STREET OR RD WATERBURY ROAD		TOWN DAYTON		LOT 1	
SUBDIVISION MAP 21 Q5 P133		SECTION 1		LOT 1			

WELL LOG Not required for driven wells STATE THE KIND OF FORMATIONS PENETRATED, THEIR COLOR, DEPTH, THICKNESS AND IF WATER BEARING			GRouting RECORD WELL HAS BEEN GROUTED (Circle Appropriate Box) TYPE OF GROUTING MATERIAL CEMENT ☒ BENTONITE CLAY ☐ NO. OF BAGS 2 NO. OF POUNDS 200 GALLONS OF WATER 4 DEPTH OF GROUT SEAL (to nearest foot) from ft. to 200 ft. (enter 0 if from surface)			PUMPING TEST HOURS PUMPED (nearest hour) PUMPING RATE (gal. per min. to nearest gal.) METHOD USED TO MEASURE PUMPING RATE Direct WATER LEVEL (distance from land surface) BEFORE PUMPING WHEN PUMPING TYPE OF PUMP USED (for test) ☒ A ☐ P ☐ T ☐ C ☐ R ☐ O ☐ J ☒ S																													
<table border="1" style="width:100%; border-collapse: collapse;"> <thead> <tr> <th rowspan="2">DESCRIPTION (Use additional sheets if needed)</th> <th colspan="2">FEET</th> <th rowspan="2">Check if water bearing</th> </tr> <tr> <th>FROM</th> <th>TO</th> </tr> </thead> <tbody> <tr> <td>Ty. Soil</td> <td>0</td> <td>2</td> <td></td> </tr> <tr> <td>Sandy</td> <td>2</td> <td>25</td> <td></td> </tr> <tr> <td>Clay</td> <td>25</td> <td>35</td> <td></td> </tr> <tr> <td>Gravel</td> <td>35</td> <td>40</td> <td></td> </tr> <tr> <td>Gravel & Sand</td> <td>40</td> <td>55</td> <td></td> </tr> <tr> <td>Gravel</td> <td>55</td> <td>200</td> <td></td> </tr> </tbody> </table>			DESCRIPTION (Use additional sheets if needed)	FEET		Check if water bearing	FROM	TO	Ty. Soil	0	2		Sandy	2	25		Clay	25	35		Gravel	35	40		Gravel & Sand	40	55		Gravel	55	200		CASING RECORD casing types insert appropriate code below ST CO STEEL CONCRETE PL OT PLASTIC OTHER MAIN CASING TYPE Nominal diameter top (main) casing (nearest inch) 6 Total depth of main casing (nearest foot) 200 OTHER CASING (if used) diameter inch depth (feet) from to		
DESCRIPTION (Use additional sheets if needed)	FEET			Check if water bearing																															
	FROM	TO																																	
Ty. Soil	0	2																																	
Sandy	2	25																																	
Clay	25	35																																	
Gravel	35	40																																	
Gravel & Sand	40	55																																	
Gravel	55	200																																	
screen type or open hole insert appropriate code below ST BR HO STEEL BRASS OPEN HOLE PL OT PLASTIC OTHER			SCREEN RECORD SLOT SIZE 1 2 3 DIAMETER OF SCREEN 6 (NEAREST INCH)																																

CIRCLE APPROPRIATE LETTER A WELL WAS ABANDONED AND SEALED WHEN THIS WELL WAS COMPLETED E ELECTRIC LOG OBTAINED P TEST WELL CONVERTED TO PRODUCTION WELL		I HEREBY CERTIFY THAT THIS WELL HAS BEEN CONSTRUCTED IN ACCORDANCE WITH COMAR 10.17.13 "WELL CONSTRUCTION" AND IN CONFORMANCE WITH ALL CONDITIONS STATED IN THE ABOVE CAPTIONED PERMIT, AND THAT THE INFORMATION PRESENTED HEREIN IS ACCURATE AND COMPLETE TO THE BEST OF MY KNOWLEDGE	
DRILLER'S IDENT. NO. 101		GRAVEL PACK 10 IF WELL DRILLED WAS FLOWING WELL INSERT F IN BOX 68 ☐	
DRILLER'S SIGNATURE (MUST MATCH SIGNATURE ON APPLICATION) 		DEP USE ONLY (NOT TO BE FILLED IN BY DRILLER) T ☐ (E.R.O.S.) ☐ WO ☐ TELESCOPE CASING ☐ LOG INDICATOR ☐ OTHER DATA ☐	
SITE SUPERVISOR (sign. of driller or journeyman responsible for sitework if different from permittee) 		LOCATION OF WELL ON LOT SHOW PERMANENT STRUCTURE SUCH AS BUILDING, SEPTIC TANKS, AND/OR LANDMARKS AND INDICATE NOT LESS THAN TWO DISTANCES (MEASUREMENTS TO WELL) 	

4-517305

HOWARD COUNTY HEALTH DEPARTMENT

JAYCE H. BOYD, M.D., M.P.H.
COUNTY HEALTH OFFICER



Bureau of Environmental Health
3525 Elliott Mills Drive
Elliott City, Maryland 21043

Director - 481-8858
Water & Sewerage, Permits - 481-8833
Community Environmental Health - 481-8844
Technical Services - 481-8888

July 5, 1989

Mr. & Mrs. Ken Hawkes
14945 Triadelphia Road
Glenelg, Maryland 21737

Re: 14945 Triadelphia Road
Well Permit No. HO-81-1864

Dear Mr. & Mrs. Hawkes:

This is to advise you that the septic system was installed, inspected and approved on July 7, 1987.

The water sample recently submitted for testing was free of coliform and fecal coliform bacteria at the time of sampling and bacteriologically safe for drinking.

FINAL CERTIFICATION OF POTABILITY

This certifies that all sampling requirements of COMAR 26.04.04 "Well Regulations" have been met for the water supply system installed under permit(s) HO-81-1864.

June 27, 1989 DHMMH
Date of Final Sampling

July 5, 1989
Date of Acceptance

NITRATE 30


Charles Streaker
Charles Streaker, Sanitarian
Water and Sewerage Program

Water Sample Dates:
September 23, 1987
June 27, 1989


CBS/cm

NOTE:


Property shown is from deed of record (738/551). This plat is not intended to be used for establishing property lines.

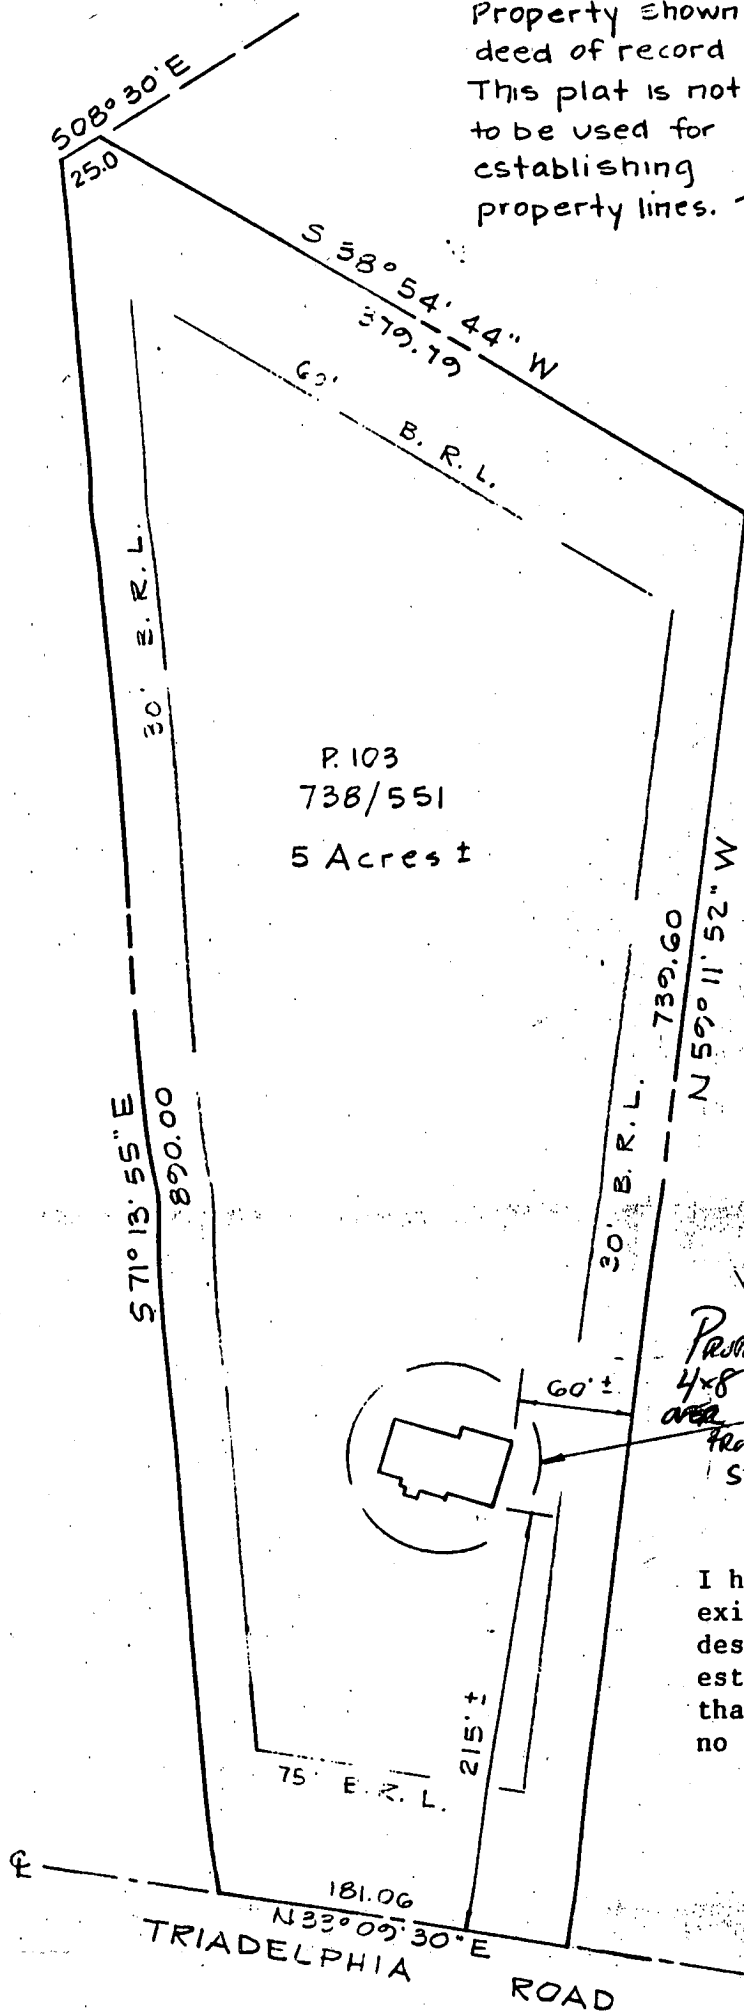

ON SRN
5/16/01

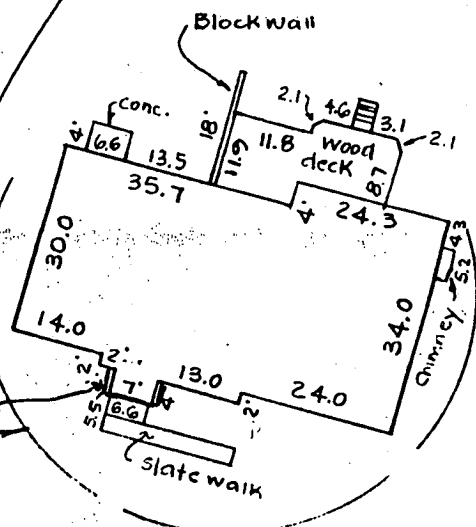

I hereby certify that the position of all existing improvements on the above described property have been carefully established by a transit-tape survey and that unless otherwise shown there are no encroachments.

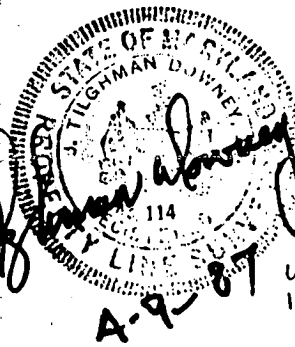

UPDATE
10-1-87

LOCATION SURVEY
14945 TRIADDELPHIA ROAD
P. 103 Tax Map 27

5th Election District
Scale: 1" = 100'

Howard County, Md.
Date: 4-9, 1987
UPDATE 10-1-87



ENGINEERS-ARCHITECTS-PLANNERS

5485 HARPER'S FARM ROAD
SUITE 200
COLUMBIA, MARYLAND 21044

9026
0006