

3/1/90
3/2/90

#

PERMIT

SEWAGE DISPOSAL SYSTEM

MARYLAND STATE DEPARTMENT OF HEALTH

HOWARD COUNTY
BUREAU OF ENVIRONMENTAL HEALTH
461-9933

P 46287
A 40044
DISTRICT 5th
DATE 8/28/90
DATE SYSTEM APPROVED 3/2/90
INSPECTOR R11

INDEXED

Jack Fyock _____ IS PERMITTED TO INSTALL X ALTER _____
ADDRESS 13775 Triadelphia Road, Glenelg, Md. 21737 PHONE 988-9270
SUBDIVISION Eagle Point Landing ROAD 5413 Talon Court LOT 11
PROPERTY OWNER Mr. Anthony Capitano
ADDRESS _____

~~IF CAPACITY INCREASED SEPTIC TANK CAPACITY BY 50% AND ABSORPTION AREA BY 25%~~

~~CAPACITY INCREASED BY 50% AND ABSORPTION AREA BY 25%~~

SEPTIC TANK CAPACITY 1250 GALLONS NUMBER OF BEDROOMS 4

TRENCHES - 180 sq.ft. per bedroom. Trench to be 2 feet wide. Inlet 4 feet below original grade. Bottom maximum depth 8 feet below original grade. Effective area begins at 4 feet below original grade. 4 feet of stone below distribution pipe.

LOCATION - Place distribution box 110' of lot line between lots 10 & 11 (372.57') and 265' off right lot line (230.53'), as seen when facing lot from Talon Ct. Run trenches toward rear of lot.

NOTE - No trench to exceed 100 feet in length. Provide 6" - 8" diameter cleanout and cap to grade or above on septic. DO 2-21-90

PLANS APPROVED BY Mark Rifken cm DATE 11/23/88

COVER NO WORK UNTIL INSPECTED AND APPROVED

NEITHER THE HOWARD COUNTY COUNCIL NOR THE HEALTH DEPARTMENT IS RESPONSIBLE FOR THE SUCCESSFUL OPERATION OF ANY SYSTEM

NOTE: CLEANOUT REQUIRED EVERY 70 FEET OF SEWER LINE AND/OR AT 90° SWEEPS IN LINES FROM HOUSE TO DRAIN FIELDS

NOTE: ALL PARTS OF SEPTIC SYSTEMS (I.E. TANK, DISTRIBUTION BOX, TRENCHES) TO BE 100 FEET FROM WELL (UNLESS OTHERWISE SPECIFICALLY AUTHORIZED)

NOTE: IF DEEP TRENCHES ARE USED CALL FOR INSPECTION BEFORE AND AFTER PLACING GRAVEL IN TRENCHES

NOTE: NO DRY WELL SHALL EXCEED 15 FOOT IN DIAMETER NO ABSORPTION TRENCH TO EXCEED 100 FEET IN LENGTH.

NOTE: ALL PIPE FROM HOUSE TO SEPTIC TANK MUST BE CAST IRON OR SCHEDULE 40 PVC OR ABS

PERMIT VOID AFTER TWO YEARS


NOTE: INSTALL STAND PIPE ON SEPTIC TANK AND DRY WELL. STAND PIPES MUST BE 6 INCHES IN DIAMETER. CAST IRON, CONCRETE OR TERRA COTTA OR PVC OR ABS ACCEPTED. IF TOP OF SEPTIC TANK IS DEEPER THAN 3 FEET, MANHOLE TO GRADE REQUIRED

NOTE: DISTRIBUTION BOXES MUST HAVE BAFFLES

*INSTALLER IS RESPONSIBLE FOR OBTAINING FINAL APROVAL ON THIS PERMIT

*CALL 461-9933 FOR INSPECTION OF SEPTIC SYSTEMS.

A 40044

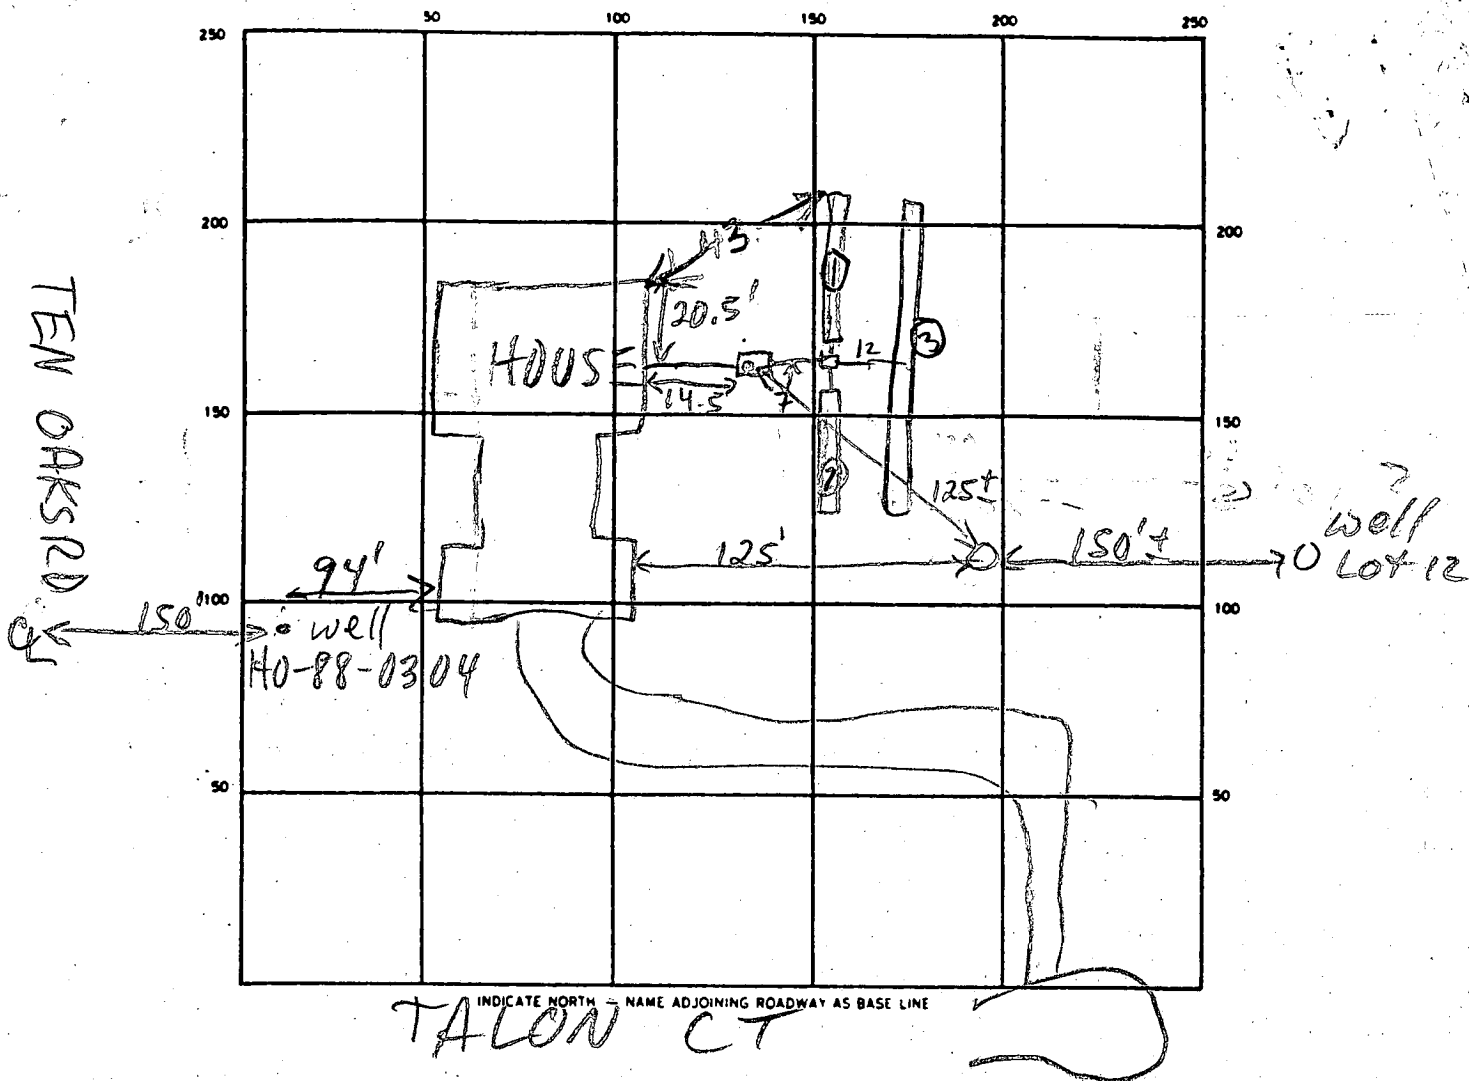

SEPTIC TANK. LEVEL 1250 GAL-OK CLEANOUTS OK
 DISTRIBUTION BOX. LEVEL OK - BAFFLE IN
 DRAIN FIELD/TILE FIELD. DEPTH 8 FT. TRENCH WIDTH 2 FT. INLET DEPTH 4 FT.
 EFFECTIVE GRAVEL DEPTH 4 FT. TOTAL LENGTH 045 394 FT.
 NUMBER OF TRENCHES 4 ONE SIDEWALL/BOTTOM AREA 720 SQ. FT.
 DRYWELL INSIDE DIAMETER — FT. EFFECTIVE DEPTH BELOW INLET — FT.
 ABSORBENT AREA — SQ. FT.

REMARKS 3/1/90 OK TO COVER TRENCHES 1 & 2 & HOUSE TO DB MR

3/2/90^{AM} TRENCH #3 OK ADDRESS OF STONE & COVER
3/2/90^{PM} TRENCH # FINISHED R/L

DATE SYSTEM APPROVED 3/2/90 INSPECTOR Raymond Hodges

APPLICATION

PERCOLATION TESTING

A 40044

P _____

HOWARD COUNTY HEALTH DEPARTMENT
BUREAU OF ENVIRONMENTAL HEALTH
P.O. BOX 476 ELLICOTT CITY, MARYLAND 21043
TELEPHONE: 461-9933

DISTRICT 5D

DATE 9-1-87

TO: THE COUNTY HEALTH OFFICER
ELLICOTT CITY, MARYLAND

I, HEREBY, APPLY FOR THE NECESSARY TEST IN ORDER TO CONSTRUCT (OR RECONSTRUCT) A SEWAGE DISPOSAL SYSTEM.

PROPERTY OWNER ~~Smith Roberts & Assoc.~~ ANTHONY CAPITANO

ADDRESS 8307 Main St Ellicott City, PHONE 465-5855

PROSPECTIVE BUYER N/A

ADDRESS _____ PHONE _____

PROPERTY LOCATION:

SUBDIVISION ~~Falbot Property~~ Eagle Point Landing LOT NO. 11

ROAD AND DESCRIPTION ~~Ten Oaks Rd~~ 5413 Talon Ct.

TAX MAP 28 PARCEL # 46-A

SIZE OF LOT 3 acres TYPE BLDG. SFD
(SINGLE FAMILY DWELLING OR COMMERCIAL)

THE SYSTEM INSTALLED UNDER THIS APPLICATION IS ACCEPTABLE ONLY UNTIL PUBLIC FACILITIES BECOME AVAILABLE. I FULLY UNDERSTAND THE

FEE CONNECTED WITH THE FILING OF THIS PERC TEST APPLICATION IS NON-REFUNDABLE UNDER ANY CIRCUMSTANCES. I ALSO AGREE TO COMPLY

WITH ALL M.O.S.H.A. REQUIREMENTS IN TESTING THIS LOT. Mark D. Rein
(SIGNATURE OF APPLICANT)

APPROVED BY Sidney Adel FOR Deep trenches DATE 6-19-89

REJECTED BY _____ FOR _____ DATE _____

HOLD PENDING FURTHER TESTS _____ DATE _____

REASONS FOR REJECTION OR HOLDING 10/7/87 Perc OK Hold for Plat B/H

11/19/89 Rein Per 22 MD
BLOG. PERMIT SIGNED
AND RETURNED 6-19-89

THIS IS NOT A PERMIT

Left

SOIL PROFILE

TOPSOIL
CLAY


PINK
BROWN
SAND
LOAM

CLAY
TUBSOIL

PINK
BROWN
SAND
MILD
LOAM

BROWN
CLAY

LIGHT
BROWN
SAND
LOAM

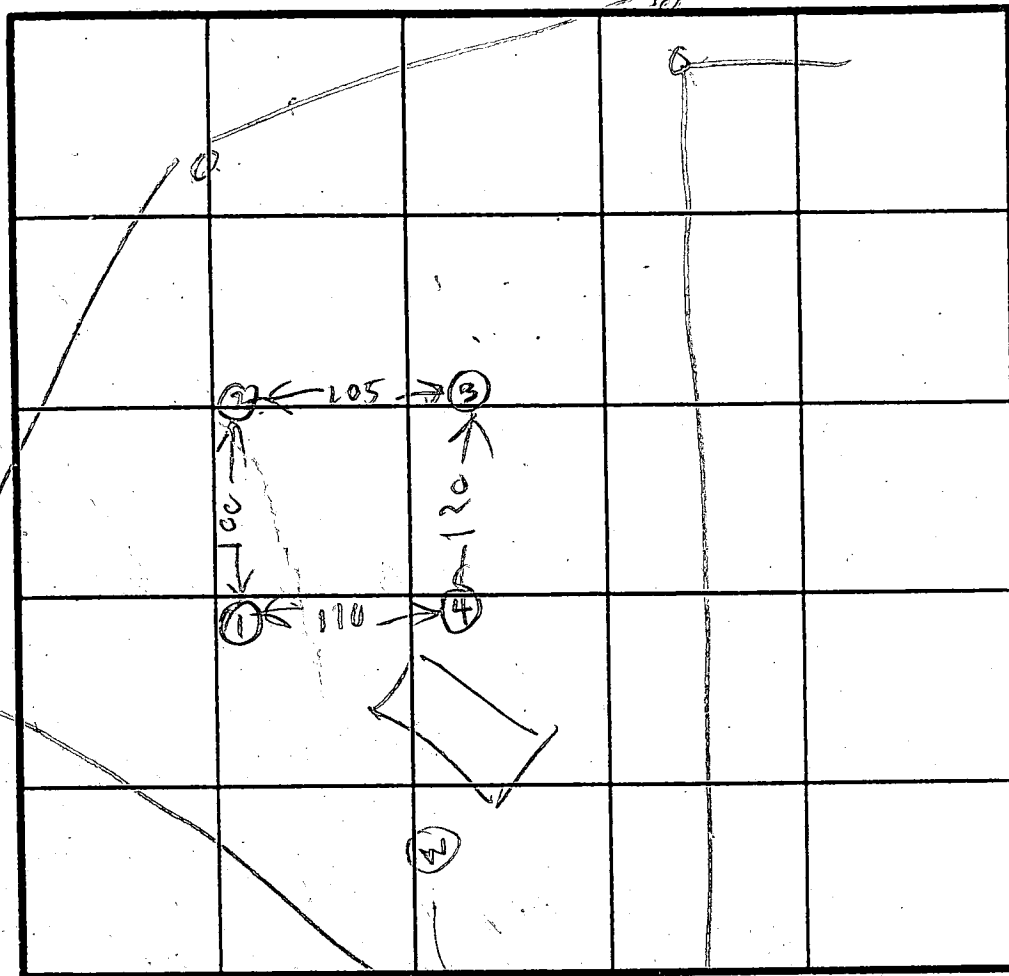

INDICATE NORTH NAME ADJOINING ROADWAY AS BASE LINE.

X REC
SMIN

160 # 132

Inlet 4"

BOTTOM 8"

Note
Elevation

(1) High

(2) Low

DATE	TEST NO.	DEPTH	PRE-WET		TEST - 1" DROP		TIME
			START	STOP	START	STOP	
10/1/67	1 S	4.5	219	222	222	230	8
10/1/67	1 D	9	219	222	222	225	3
10/1/67	1 V	12.5	OK				
	2 S	4.5	231	240	240	244	4
	2 D	13					
	3 S	4.5	235	236	236	238	2
	3 V	11.5	OK				
	4 V	12.5	OK				

REMARKS Hole dug Per Surveyor Plat

TYPE OF SOIL
TESTED BY B. H. HOGGE

ALSO PRESENT POB
O. K. KRAMER
MARK

EH-12-1079

B 1	6811	SEQUENCE NO. (DP USE ONLY)	STATE OF MARYLAND PERMIT TO DRILL WELL please print or type	STATE PERMIT NUMBER <div style="border: 1px solid black; padding: 2px; display: inline-block;"> H0-88-0304 </div> <div style="font-size: 8pt;">fill in this form completely</div>
Date Received (APA) <div style="border: 1px solid black; padding: 2px; display: inline-block;"> 11-10-88 </div>		OWNER INFORMATION <div style="display: flex; justify-content: space-between;"> <div style="width: 45%;"> <div style="border: 1px solid black; padding: 2px; display: inline-block;"> CAPITANO ANTHONY </div> <div style="width: 40%; border: 1px solid black; padding: 2px; display: inline-block;"> 4280 TEN OAKS ROAD </div> </div> <div style="width: 10%; text-align: center;"> DAYTON </div> <div style="width: 45%;"> <div style="border: 1px solid black; padding: 2px; display: inline-block;"> MD21036 </div> </div> </div>		
DRILLER INFORMATION <div style="display: flex; justify-content: space-between;"> <div style="width: 45%;"> Driller's Name <u>Frank Delph</u> Firm Name <u>Frank-Delph Well Drilling Inc.</u> Address <u>18234 Penn Shop Rd, Mt Airy Md.</u> Signature <u>Frank Delph</u> Date <u>11-10-88</u> </div> <div style="width: 10%; text-align: center;"> 453 </div> <div style="width: 45%;"> 77 License No. 80 </div> </div>				
WELL INFORMATION <div style="display: flex; justify-content: space-between;"> <div style="width: 45%;"> APPROX. PUMPING RATE (GAL. PER MIN.) <u>5</u> AVERAGE DAILY QUANTITY NEEDED (GAL. PER DAY) <u>500</u> </div> <div style="width: 10%; text-align: center;"> 500 </div> <div style="width: 45%;"> 73 </div> </div>				
USE FOR WATER (CIRCLE APPROPRIATE BOX) <div style="display: flex; justify-content: space-between;"> <div style="width: 45%;"> <input checked="" type="checkbox"/> HOME (SINGLE OR DOUBLE HOUSEHOLD UNIT ONLY) <input type="checkbox"/> FARMING (LIVESTOCK WATERING & AGRICULTURAL IRRIGATION) <input type="checkbox"/> INDUSTRIAL, COMMERCIAL, STATE AND FEDERAL GOV. OTHER (REQUIRES APPROPRIATION PERMIT) <input type="checkbox"/> PUBLIC OR PRIVATE WATER COMPANY (REQUIRES APPROPRIATION PERMIT AND STATE HEALTH DEPARTMENT APPROVAL) <input type="checkbox"/> TEST, OBSERVATION, MONITORING (MAY REQUIRE APPROPRIATION PERMIT) </div> <div style="width: 10%; text-align: center;"> 22 </div> <div style="width: 45%;"> TOWN </div> </div>				
APPROXIMATE DEPTH OF WELL <u>200</u> FEET APPROXIMATE DIAMETER OF WELL <u>6</u> INCH				
METHOD OF DRILLING (circle one) <div style="display: flex; justify-content: space-between;"> <div style="width: 45%;"> BORED (or Augered) <u>JETTED</u> <u>Jettied & DRIVEN</u> AIR-ROTary <u>AIR-PERCussion</u> <u>ROTARY (Hydraulic Rotary)</u> CABLE <u>REverse-ROTary</u> <u>Drive-POINT</u> other _____ </div> <div style="width: 10%; text-align: center;"> 30 37 </div> <div style="width: 45%;"> 54 63 </div> </div>				
REPLACEMENT OR DEEPEINED WELLS (CIRCLE APPROPRIATE BOX) <div style="display: flex; justify-content: space-between;"> <div style="width: 45%;"> <input checked="" type="checkbox"/> THIS WELL WILL NOT REPLACE AN EXISTING WELL <input type="checkbox"/> THIS WELL WILL REPLACE A WELL THAT WILL BE ABANDONED AND SEALED <input type="checkbox"/> THIS WELL WILL REPLACE A WELL THAT WILL BE USED AS A STANDBY <input type="checkbox"/> THIS WELL WILL DEEPEIN AN EXISTING WELL </div> <div style="width: 10%; text-align: center;"> 39 </div> <div style="width: 45%;"> PERMIT NUMBER OF WELL TO BE REPLACED OR DEEPEINED (IF AVAILABLE) _____ </div> </div>				
Not to be filled in by driller (OEP USE ONLY) APPROP. PERMIT NUMBER _____ FORCE <u>CU</u> WRITE INITIALS IN BOX PERMIT No. <u>H0-88-0304</u> SPECIAL CONDITIONS <u>988-9178</u>				

LOCATION OF WELL

COUNTY HOWARD
 SUBDIVISION EAGLE POINT
 SECTION 11 LOT 11
 NEAREST TOWN DAYTON
 MILES FROM TOWN (enter 0 if in town) 1 MI

8
23
44
46
48
50
52
71

NEAR WHAT ROAD Talon Ct
 ON WHICH SIDE OF ROAD (CIRCLE APPROPRIATE BOX)
 NORTH ☒ WEST ☐ EAST ☐ SOUTH ☐
 DISTANCE FROM ROAD 500 FT or MI FT

NOT TO BE FILLED IN BY DRILLER HEALTH DEPARTMENT APPROVAL
 COUNTY NAME Howard COUNTY NO. A40044
 STATE SIGNATURE _____ DATE ISSUED 11/17/88 CO SIGNATURE C. Williams EXP. DATE 5/17/89
 NORTH GRID 807000 EAST GRID 0505000

SHOW MAJOR FEATURES OF BOX & LOCATE WELL WITH AN X
 SOURCES OF DRILLING WATER
 1. well water
 2. _____
 3. _____
 WRITE THE BOX NUMBER FROM THE MAP HERE

500 5
800 7

000
000

 DRAW A SKETCH BELOW SHOWING LOCATION OF WELL IN RELATION TO NEARBY TOWNS AND ROADS AND GIVE DISTANCE FROM WELL TO NEAREST ROAD JUNCTION

Sketch showing location of well in relation to nearby towns and roads. The well is located 500 feet from Talon Ct. and 800 feet from Ten Oaks Rd. The well is located near the intersection of Talon Ct. and Linden Church Rd.

BUDG. PERMIT SIGNED
AND RETURNED 6-19-89

BP 2721
SAC

TEN

OAKS ROAD

R=420.00 L=186.37
S15°47'29"E 203.43'

TRANSCONTINENTAL

LOT 9

N58°27'40"E

384.66'

LOT 11
3.505 AC

LOT 12

GAS PIPE LINE

ESM'T

LOT 10

LOT 13

TALON COURT

HOUSE:

FIRST FLOOR
BASEMENT
INVERT

598.0 ✓
589.0 ✓
591.27 ✓

BSMT

SEPTIC TANK:

5'
EXISTING GRADE
PROPOSED GRADE
INVERT IN
INVERT OUT

596.0 ✓
596.0 ✓
591.02 ✓
590.77 ✓

DISTRIBUTION BOX:

EXISTING GRADE
PROPOSED GRADE
INVERT IN
INVERT OUT

593.0 ✓
593.0 ✓
590.2 ✓
590.1 ✓

TRENCHES:

EXISTING GRADE
INVERT
BOTTOM
STONE
WIDTH
LENGTH

	#1	#2
EXISTING GRADE	593.0 ✓	592.0 ✓
INVERT	590.0 ✓	589.0 ✓
BOTTOM	585.0 ✓	584.0 ✓
STONE	4 500	1 500
WIDTH	2 ✓	2 ✓
LENGTH	90'	90'

1' shallow/OK
SA

I certify the above measurements and
elevations to be actual and true for this
property.


J. Carl Hudgins
J. Carl Hudgins

PLOT PLAN

LOT 11

EAGLE POINT LANDING
TAX MAP 28 PARCEL 46
ZONE "R"

5th ELECTION DISTRICT
HOWARD COUNTY, MD.
DATE 09JUNE89
SCALE 1"=100'

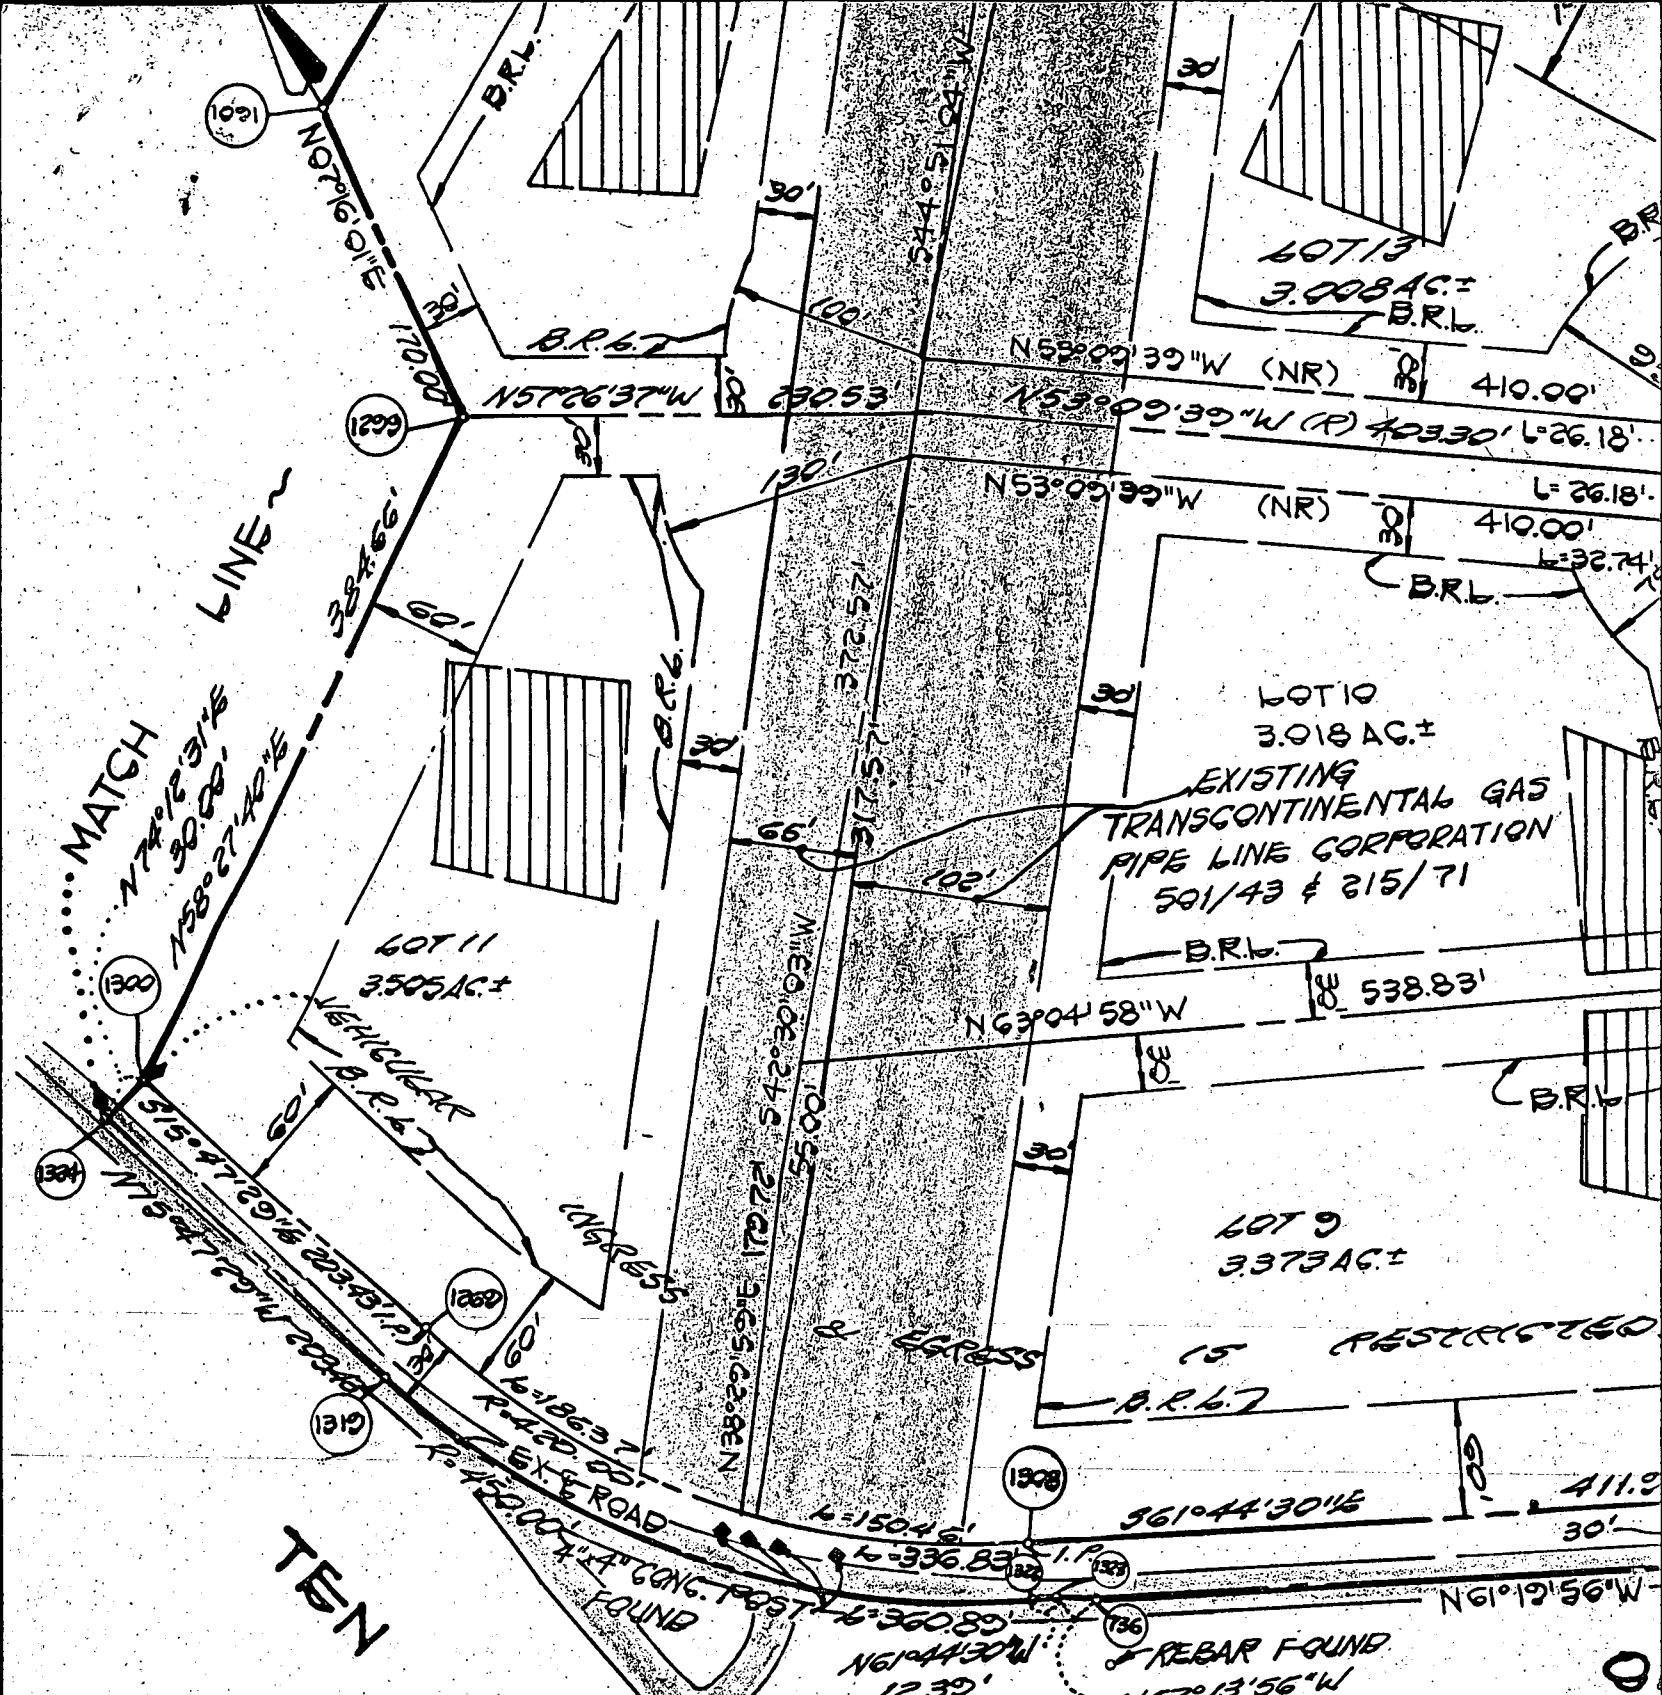

T 2 OF 2

8 LOTS TO BE RECORDED.....	8
BE RECORDED.....	8
LOTS TO BE RECORDED.....	25.636AC.±
BE RECORDED.....	2.033AC.±
D.....	27.669AC.±

AND PRIVATE SEWERAGE
COUNTY HEALTH DEPART-

OWNER'S CERTIFICATE

WE, EAGLE POINT LANDING PARTNERSHIP, A MARYLAND GENERAL PARTNERSHIP BY CAPITANO, PARTNER OF THE PROPERTY SHOWN AND DESCRIBED HEREON, HEREBY ADD SUBDIVISION, AND IN CONSIDERATION OF THE APPROVAL OF THIS FINAL PLAT B PLANNING AND ZONING, ESTABLISH THE MINIMUM BUILDING RESTRICTION LINES AND G ITS SUCCESSORS AND ASSIGNS, (1) THE RIGHT TO LAY, CONSTR

C16653

SEQUENCE NO.
(DENV USE ONLY)

STATE OF MARYLAND
WELL COMPLETION REPORT
FILL IN THIS FORM COMPLETELY
PLEASE PRINT OR TYPE

THIS REPORT MUST BE SUBMITTED WITHIN
45 DAYS AFTER WELL IS COMPLETED.

1236
(THIS NUMBER IS TO BE PUNCHED
IN COLS. 3-6 ON ALL CARDS)

COUNTY
NUMBER A40044

DATE Received
813

DATE WELL COMPLETED
050689

Depth of Well
2220526
(TO NEAREST FOOT)

PERMIT NO.
FROM "PERMIT TO DRILL WELL"
40-88-0304

OWNER
STREET OR RFD
SUBDIVISION

last name
TALON COURT

first name
DAVID

TOWN
DAYTON

SECTION
LOT 11

WELL LOG
Not required for driven wells

STATE THE KIND OF FORMATIONS
PENETRATED, THEIR COLOR, DEPTH,
THICKNESS AND IF WATER BEARING

DESCRIPTION (Use additional sheets if needed)	FEET		Check if water bearing
	FROM	TO	
Top Soil	0	2	
Shale	2	15	
Mika	15	35	
Sandstone	35	45	
Mika	45	70	
Sandstone	70	75	
Mika	75	205	

GROUTING RECORD

WELL HAS BEEN GROUTED
(Circle Appropriate Box)

TYPE OF GROUTING MATERIAL

CEMENT CM BENTONITE CLAY BC

NO. OF BAGS 8 NO. OF POUNDS 461

GALLONS OF WATER

DEPTH OF GROUT SEAL (to nearest foot)

from 6 ft. to 25 ft.

CASING RECORD

casing types insert appropriate code below

STEEL CONCRETE PLASTIC OTHER

MAIN CASING TYPE

Nominal diameter top (main) casing (nearest inch)

Total depth of main casing (nearest foot)

PL 4 28

OTHER CASING (if used)

diameter inch

depth (feet) from to

SCREEN RECORD

screen type or open hole insert appropriate code below

STEEL BRASS OPEN HOLE PLASTIC OTHER

DEPTH (nearest ft.)

180

DEPTHS

1 2 3 1000

CIRCLE APPROPRIATE LETTER

A A WELL WAS ABANDONED AND SEALED WHEN THIS WELL WAS COMPLETED

E ELECTRIC LOG OBTAINED

P TEST WELL CONVERTED TO PRODUCTION WELL

I HEREBY CERTIFY THAT THIS WELL HAS BEEN CONSTRUCTED IN ACCORDANCE WITH COMAR 10.17.13 "WELL CONSTRUCTION" AND IN CONFORMANCE WITH ALL CONDITIONS STATED IN THE ABOVE CAPTIONED PERMIT, AND THAT THE INFORMATION PRESENTED HEREIN IS ACCURATE AND COMPLETE TO THE BEST OF MY KNOWLEDGE.

DRILLERS IDENT. NO. 453

DRILLERS SIGNATURE

SITE SUPERVISOR (Sign. of driller or journeyman responsible for sitework if different from permittee)

GRAVEL PACK

IF WELL DRILLED WAS FLOWING WELL INSERT F IN BOX 68

OEP USE ONLY (NOT TO BE FILLED IN BY DRILLER)

T (E.R.O.S.)

WQ

TELESCOPE CASING

LOG INDICATOR

OTHER DATA

PUMPING TEST

HOURS PUMPED (nearest hour) 3

PUMPING RATE (gal. per min. to nearest gal.) 4

METHOD USED TO MEASURE PUMPING RATE

WATER LEVEL (distance from land surface) BEFORE PUMPING 43

WHEN PUMPING 170

TYPE OF PUMP USED (for test) A air P piston T turbine C centrifugal R rotary O other (describe below) J jet S submersible

PUMP INSTALLED

DRILLER WILL INSTALL PUMP YES NO

IF DRILLER INSTALLS PUMP, THIS SECTION MUST BE COMPLETED FOR ALL WELLS EXCEPT HOME USE

TYPE OF PUMP INSTALLED

PLACE (A,C,J,P,R,S,T,O) IN BOX - SEE ABOVE:

CAPACITY: GALLONS PER MINUTE (to nearest gallon)

PUMP HORSE POWER

PUMP COLUMN LENGTH (nearest ft.)

CASING HEIGHT (circle appropriate box and enter casing height)

LAND SURFACE (nearest foot)

LOCATION OF WELL ON LOT

SHOW PERMANENT STRUCTURE SUCH AS BUILDING, SEPTIC TANKS, AND/OR LANDMARKS AND INDICATE NOT LESS THAN TWO DISTANCES (MEASUREMENTS TO WELL)

102'

300'

TALON CT