


$$\begin{array}{r} A \\ \hline 40053 \end{array}$$

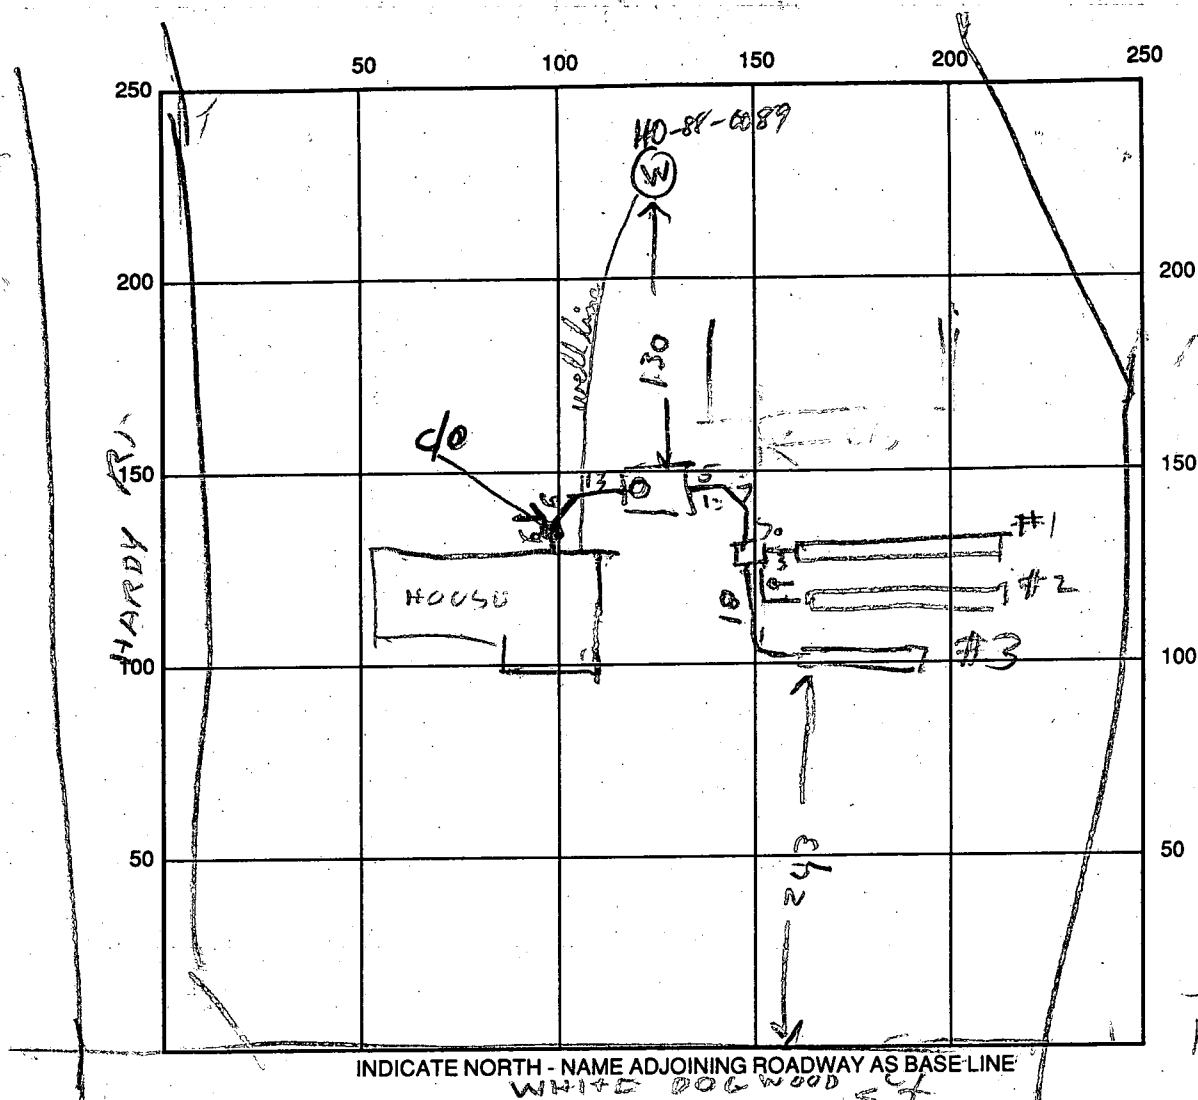

SEPTIC TANK LEVEL OK 1250 CLEANOUTS _____

DISTRIBUTION BOX LEVEL _____

DRAIN FIELD/TITLE DEPTH 8 FT. TRENCH WIDTH 2 FT. INLET DEPTH 3.5 FT.

EFFECTIVE GRAVEL DEPTH 4.5 FT. TOTAL LENGTH 602 FT. 1070

NUMBER OF TRENCHES 3 ONE SIDEWALL/BOTTOM AREA 733 SQ. FT.

DRYWALL INSIDE DIAMETER _____ FT. EFFECTIVE DEPTH BELOW INLET _____ FT.

ABSORBENT AREA _____ SQ. FT.

REMARKS: 10/30/91 AM - ADD STONE TO TRENCHES RH

10/30/91 - STONE ADDED TO TRENCHES #2 & #3. A LITTLE
STONE ADDED TO TRENCH #1.

10/30/91 - COVER TRENCHES #2 & #3 & TANK. PUT
CLEANOUT ON TANK. FILL TRENCH #1 WITH STONE
COVER MIDDLE & CALL RH. 10/31/91 TRENCH #1 OK CLEANOUT OK RH

DATE SYSTEM APPROVED 10/31/91 INSPECTOR Raymond Hodges

APPLICATION

PERCOLATION TESTING

HOWARD COUNTY HEALTH DEPARTMENT
BUREAU OF ENVIRONMENTAL HEALTH
P.O. BOX 476 ELLICOTT CITY, MARYLAND 21043
TELEPHONE: 461-9933

10/30/84
perc test pending
approved plat

A 40053

P _____

DISTRICT 4TH

DATE 9-8-87

TO: THE COUNTY HEALTH OFFICER
ELLICOTT CITY, MARYLAND

I HEREBY APPLY FOR THE NECESSARY TEST IN ORDER TO CONSTRUCT (OR RECONSTRUCT) A SEWAGE DISPOSAL SYSTEM.

PROPERTY OWNER ~~Kennard Warfield Jr~~ Tom + Marylou Grimm

ADDRESS 14663 Tridelphia Rd Glenely 21737 PHONE 442-5570
442-2337

PROSPECTIVE BUYER N/A

ADDRESS _____ PHONE _____

PROPERTY LOCATION:

SUBDIVISION White Property LOT NO. 1

ROAD AND DESCRIPTION South side of Balto National Pike (Rt 144) north
side of Hardy Rd 17401 White Dogwood Ct.

TAX MAP 7 PARCEL # 1

SIZE OF LOT 3 ± acres TYPE BLDG. SFD
(SINGLE FAMILY DWELLING OR COMMERCIAL)

THE SYSTEM INSTALLED UNDER THIS APPLICATION IS ACCEPTABLE ONLY UNTIL PUBLIC FACILITIES BECOME AVAILABLE. I FULLY UNDERSTAND THE
FEE CONNECTED WITH THE FILING OF THIS PERC TEST APPLICATION IS NON-REFUNDABLE UNDER ANY CIRCUMSTANCES. I ALSO AGREE TO COMPLY
WITH ALL M.O.S.H.A. REQUIREMENTS IN TESTING THIS LOT.

Mal D. Klein
(SIGNATURE OF APPLICANT)

APPROVED BY Fidmy Abel FOR Dep trucks DATE 8-12-88

REJECTED BY _____ FOR _____ DATE _____

HOLD PENDING FURTHER TESTS _____ DATE _____

REASONS FOR REJECTION OR HOLDING for field located holes & sub-plat

BLDG. PERMIT SIGNED

AND RETURNED 9/15/87

Serial # 59600 - SFD

3 Bedroom

BLDG. PERMIT SIGNED

AND RETURNED 6-21-89

BP 27305
8/8

THIS IS NOT A PERMIT

$\bar{x} = 4 \text{ MIN}$
 INLET 3
 MAX D 8'
 160 $\frac{\text{lb}}{\text{ft}^3}$ BEDROCK


① + ② + ③
 SOIL PROFILE

0'
 chunky brown
 gritty yellow
 clay/sand
 2 1/2'
 to mostly
 yellow orange
 silty loam
 w/ small white + white
 (chalk-like)
 weathered
 frags (10%)
 ↓ 4 1/2'

12' D

④

TO ↑
 LOT 2 ↑

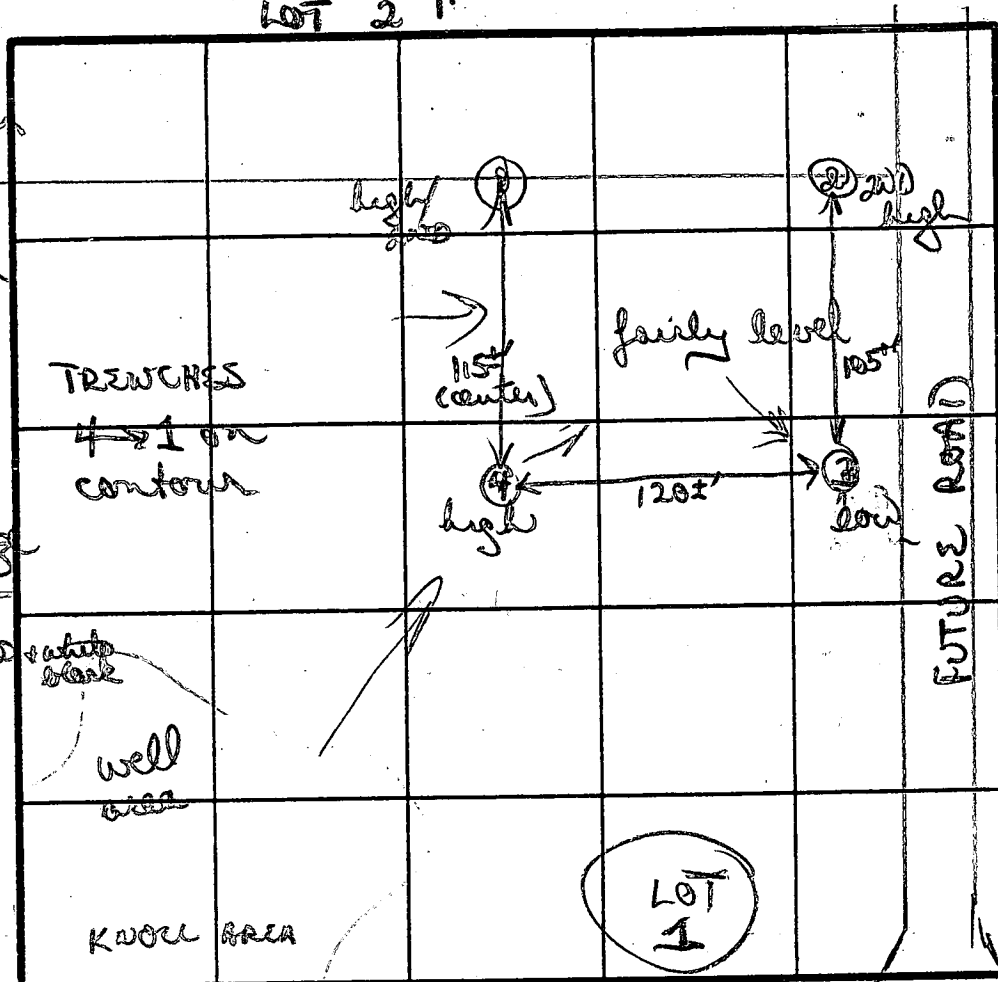

INDICATE NORTH - NAME ADJOINING ROADWAY AS BASE LINE

HARDY ROAD

Brown/orange
 clay / clay
 silty loam
 3'
 to orange /
 brown w/
 patches white / black
 weathered
 frags 10%
 from ↓ 3 1/2 - 4'

12' D

DATE	TEST NO.	DEPTH	PRE-WET		TEST - 1" DROP		TIME
			START	STOP	START	STOP	
	①	3' S	1100	1102	1102	1105	3 MIN
		7' M	1100	1102	1102	1105	3 MIN
		12' D	bottom (see profile)				
black	②	3 1/2' S	1124	1126	1126	1129	3 MIN
		12' D	bottom (see profile)				
	③	3 1/2' S	1111	1115	1115	1122	7 MIN
		12' D	bottom (see profile)				
	④	VISUAL only		good soils ~4' ↓			
		12' D	bottom (see profile)				

Holes 1 + 2 common w/ lot # 2. Dig + tested as
 staked

REMARKS

TYPE OF SOIL

TESTED BY

B Wyler

ALSO PRESENT

Kettner, Marc

orange/yellow/brown clay loams 3-4'; orange yellow
 silty loams w/ 10-15% small-med frags

B 1	3628	SEQUENCE NO. (DP USE ONLY)	STATE OF MARYLAND PERMIT TO DRILL WELL please print or type	STATE PERMIT NUMBER 40-88-0089 ✓ on 9/3
(THIS NUMBER IS TO BE PUNCHED IN COLS. 3-6 ON ALL CARDS)				
Date Received (APA) 080Y88		LOCATION OF WELL HOWARD COUNTY WHITE WOODS EST SUBDIVISION SECTION 44 LOT 1 POPULAR SPRINGS NEAREST TOWN MILES FROM TOWN (enter 0 if in town) 1 M 1		
OWNER INFORMATION WARFIELD KEN 14663 TRINDELPHIA RD GLENELE Town MD21232 Zip		DRILLER INFORMATION Ralph Mayne Ralph Mayne well drilling 9120 Brown Church Rd. N.H. Ding Ralph Mayne 7/30/88		
WELL INFORMATION APPROX. PUMPING RATE (GAL. PER MIN.) 5 AVERAGE DAILY QUANTITY NEEDED (GAL. PER DAY) 500		DIRECTION OF WELL FROM TOWN (CIRCLE BOX) NEAR WHAT ROAD WHITE Oak wood Ct. ON WHICH SIDE OF ROAD (CIRCLE APPROPRIATE BOX) DISTANCE FROM ROAD 400 FT or MI FL		
USE FOR WATER (CIRCLE APPROPRIATE BOX) ☒ HOME (SINGLE OR DOUBLE HOUSEHOLD UNIT ONLY) ☐ FARMING (LIVESTOCK WATERING & AGRICULTURAL IRRIGATION) ☐ INDUSTRIAL, COMMERCIAL, STATE AND FEDERAL GOV. OTHER (REQUIRES APPROPRIATION PERMIT) ☐ PUBLIC OR PRIVATE WATER COMPANY (REQUIRES APPROPRIATION PERMIT AND STATE HEALTH DEPARTMENT APPROVAL) ☐ TEST, OBSERVATION, MONITORING (MAY REQUIRE APPROPRIATION PERMIT)		NOT TO BE FILLED IN BY DRILLER HEALTH DEPARTMENT APPROVAL Howard COUNTY NAME A-40053 COUNTY NO. STATE SIGNATURE _____ INSERT S _____ DATE ISSUED 081788 Jul 11th 02-16-89 NORTH GRID 549000 EAST GRID 0765000		
APPROXIMATE DEPTH OF WELL 150 FEET APPROXIMATE DIAMETER OF WELL 6" INCH		SHOW MAJOR FEATURES OF BOX & LOCATE WELL WITH AN X SOURCES OF DRILLING WATER 1. well 2. 3. WRITE THE BOX NUMBER FROM THE MAP HERE: 7685 5189		
METHOD OF DRILLING (circle one) ☒ BORED (or Augered) ☐ JETTED ☐ Jetted & DRIVEN ☒ AIR-ROTARY ☐ AIR-PERCussion ☐ ROTARY (Hydraulic Rotary) ☐ CABLE ☐ REVERSE-ROTARY ☐ DRIVE-POINT other _____		DRAW A SKETCH BELOW SHOWING LOCATION OF WELL IN RELATION TO NEARBY TOWNS AND ROADS AND GIVE DISTANCE FROM WELL TO NEAREST ROAD JUNCTION 		
REPLACEMENT OR DEEPEMED WELLS (CIRCLE APPROPRIATE BOX) ☒ THIS WELL WILL NOT REPLACE AN EXISTING WELL ☐ THIS WELL WILL REPLACE A WELL THAT WILL BE ABANDONED AND SEALED ☐ THIS WELL WILL REPLACE A WELL THAT WILL BE USED AS A STANDBY ☐ THIS WELL WILL DEEPEMED AN EXISTING WELL PERMIT NUMBER OF WELL TO BE REPLACED OR DEEPEMED (IF AVAILABLE) _____		Not to be filled in by driller (OEP USE ONLY) APPROP. PERMIT NUMBER _____ GAP _____ FORCE CA WRITE INITIALS IN BOX PERMIT NO. 40-88-0089		
SPECIAL CONDITIONS				

C1 0579	SEQUENCE NO. (DENY USE ONLY)	STATE OF MARYLAND WELL COMPLETION REPORT FILL IN THIS FORM COMPLETELY PLEASE PRINT OR TYPE		THIS REPORT MUST BE SUBMITTED WITHIN 45 DAYS AFTER WELL IS COMPLETED.	
(THIS NUMBER IS TO BE PUNCHED IN SCLS. 3-6 ON ALL CARDS)				COUNTY NUMBER	A-40053
DATE Received	DATE WELL COMPLETED	Depth of Well		PERMIT NO.	
8 13	15 20	22 26		FROM "PERMIT TO DRILL WELL"	
	090288	185		40-88-0089	
		(TO NEAREST FOOT)		28 29 30 31 32 33 34 35 36 37	

OWNER	WARFIELD KEN		
STREET OR RFD	last name	first name	TOWN
	WHITE DOG WOOD CT.		POPEAR SPRINGS
SUBDIVISION	WHITE WOOD EST.	SECTION	LOT
			1

WELL LOG Not required for driven wells		
STATE THE KIND OF FORMATIONS PENETRATED, THEIR COLOR, DEPTH, THICKNESS AND IF WATER BEARING		
DESCRIPTION (Use additional sheets if needed)	FEET FROM TO	Check if water bearing
Top Soil	0 2	
Brown Shale	2 35	
Green Shale	35 45	✓
Blue Shale	45 65	
Green Shale	65 70	✓
Blue Shale	70 185	

GROUTING RECORD	
WELL HAS BEEN GROUTED (Circle Appropriate Box)	
yes ☒ no ☐	
TYPE OF GROUTING MATERIAL	
CEMENT ☒	BENTONITE CLAY ☐
NO. OF BAGS 8	NO. OF POUNDS 800
GALLONS OF WATER 48	
DEPTH OF GROUT SEAL (to nearest foot)	
from 48 ft. to 40 ft.	
(enter 0 if from surface)	

CASING RECORD	
casing types insert appropriate code below	
STEEL CONCRETE	
PLASTIC OTHER	
MAIN CASING TYPE	
Nominal diameter top (main) casing (nearest inch)	
Total depth of main casing (nearest foot)	
8 1 6 4 4 8 70	

OTHER CASING (if used)	
diameter inch	
depth (feet) from to	
EACH CASING	

SCREEN RECORD	
screen type or open hole	
insert appropriate code below	
STEEL BRASS BRONZE PLASTIC	
HOLE OTHER	

C2	
DEPTH (nearest ft.)	
1 2 3 100	

CIRCLE APPROPRIATE LETTER	
A WELL WAS ABANDONED AND SEALED WHEN THIS WELL WAS COMPLETED	
E ELECTRIC LOG OBTAINED	
P TEST WELL CONVERTED TO PRODUCTION WELL	

HEREBY CERTIFY THAT THIS WELL HAS BEEN CONSTRUCTED IN ACCORDANCE WITH COMAR 10.17.13 "WELL CONSTRUCTION" AND IN CONFORMANCE WITH ALL CONDITIONS STATED IN THE ABOVE CAPTIONED PERMIT, AND THAT THE INFORMATION PRESENTED HEREIN IS ACCURATE AND COMPLETE TO THE BEST OF MY KNOWLEDGE.	
--	--

DRILLERS IDENT. NO.	273
DRILLERS SIGNATURE	Mark Wayne
(MUST MATCH SIGNATURE ON APPLICATION)	

SITE SUPERVISOR (sign. of driller or journeyman responsible for sitework if different from permittee)	
--	--

SLOT SIZE 1 2 3	
DIAMETER OF SCREEN (NEAREST INCH)	
56 60	
GRAVEL PACK	
IF WELL DRILLED WAS FLOWING WELL INSERT F IN BOX 68	



OEP USE ONLY (NOT TO BE FILLED IN BY DRILLER)	
T (E.R.O.S.) WQ	
70 72 74 75 76	
TELESCOPE CASING LOG INDICATOR OTHER DATA	

C3	
PUMPING TEST	
HOURS PUMPED (nearest hour)	
PUMPING RATE (gal. per min. to nearest gal.)	
METHOD USED TO MEASURE PUMPING RATE	
WATER LEVEL (distance from land surface)	
BEFORE PUMPING	
WHEN PUMPING	
TYPE OF PUMP USED (for test)	
A air P piston T turbine	
C centrifugal R rotary O other (describe below)	
J jet S submersible	

PUMP INSTALLED	
DRILLER WILL INSTALL PUMP YES NO	
IF DRILLER INSTALLS PUMP, THIS SECTION MUST BE COMPLETED FOR ALL WELLS EXCEPT HOME USE	
TYPE OF PUMP INSTALLED	
PLACE (A,C,J,P,R,S,T,O) IN BOX-SEE ABOVE:	
CAPACITY: GALLONS PER MINUTE (to nearest gallon)	
PUMP HORSE POWER	
PUMP COLUMN LENGTH (nearest ft.)	
CASING HEIGHT (circle appropriate box and enter casing height)	
LAND SURFACE (nearest foot)	

LOCATION OF WELL ON LOT	
SHOW PERMANENT STRUCTURE SUCH AS BUILDING, SEPTIC TANKS, AND/OR LANDMARKS AND INDICATE NOT LESS THAN TWO DISTANCES (MEASUREMENTS TO WELL)	
Diagram showing well location on lot with distances to structures.	

COUNTY

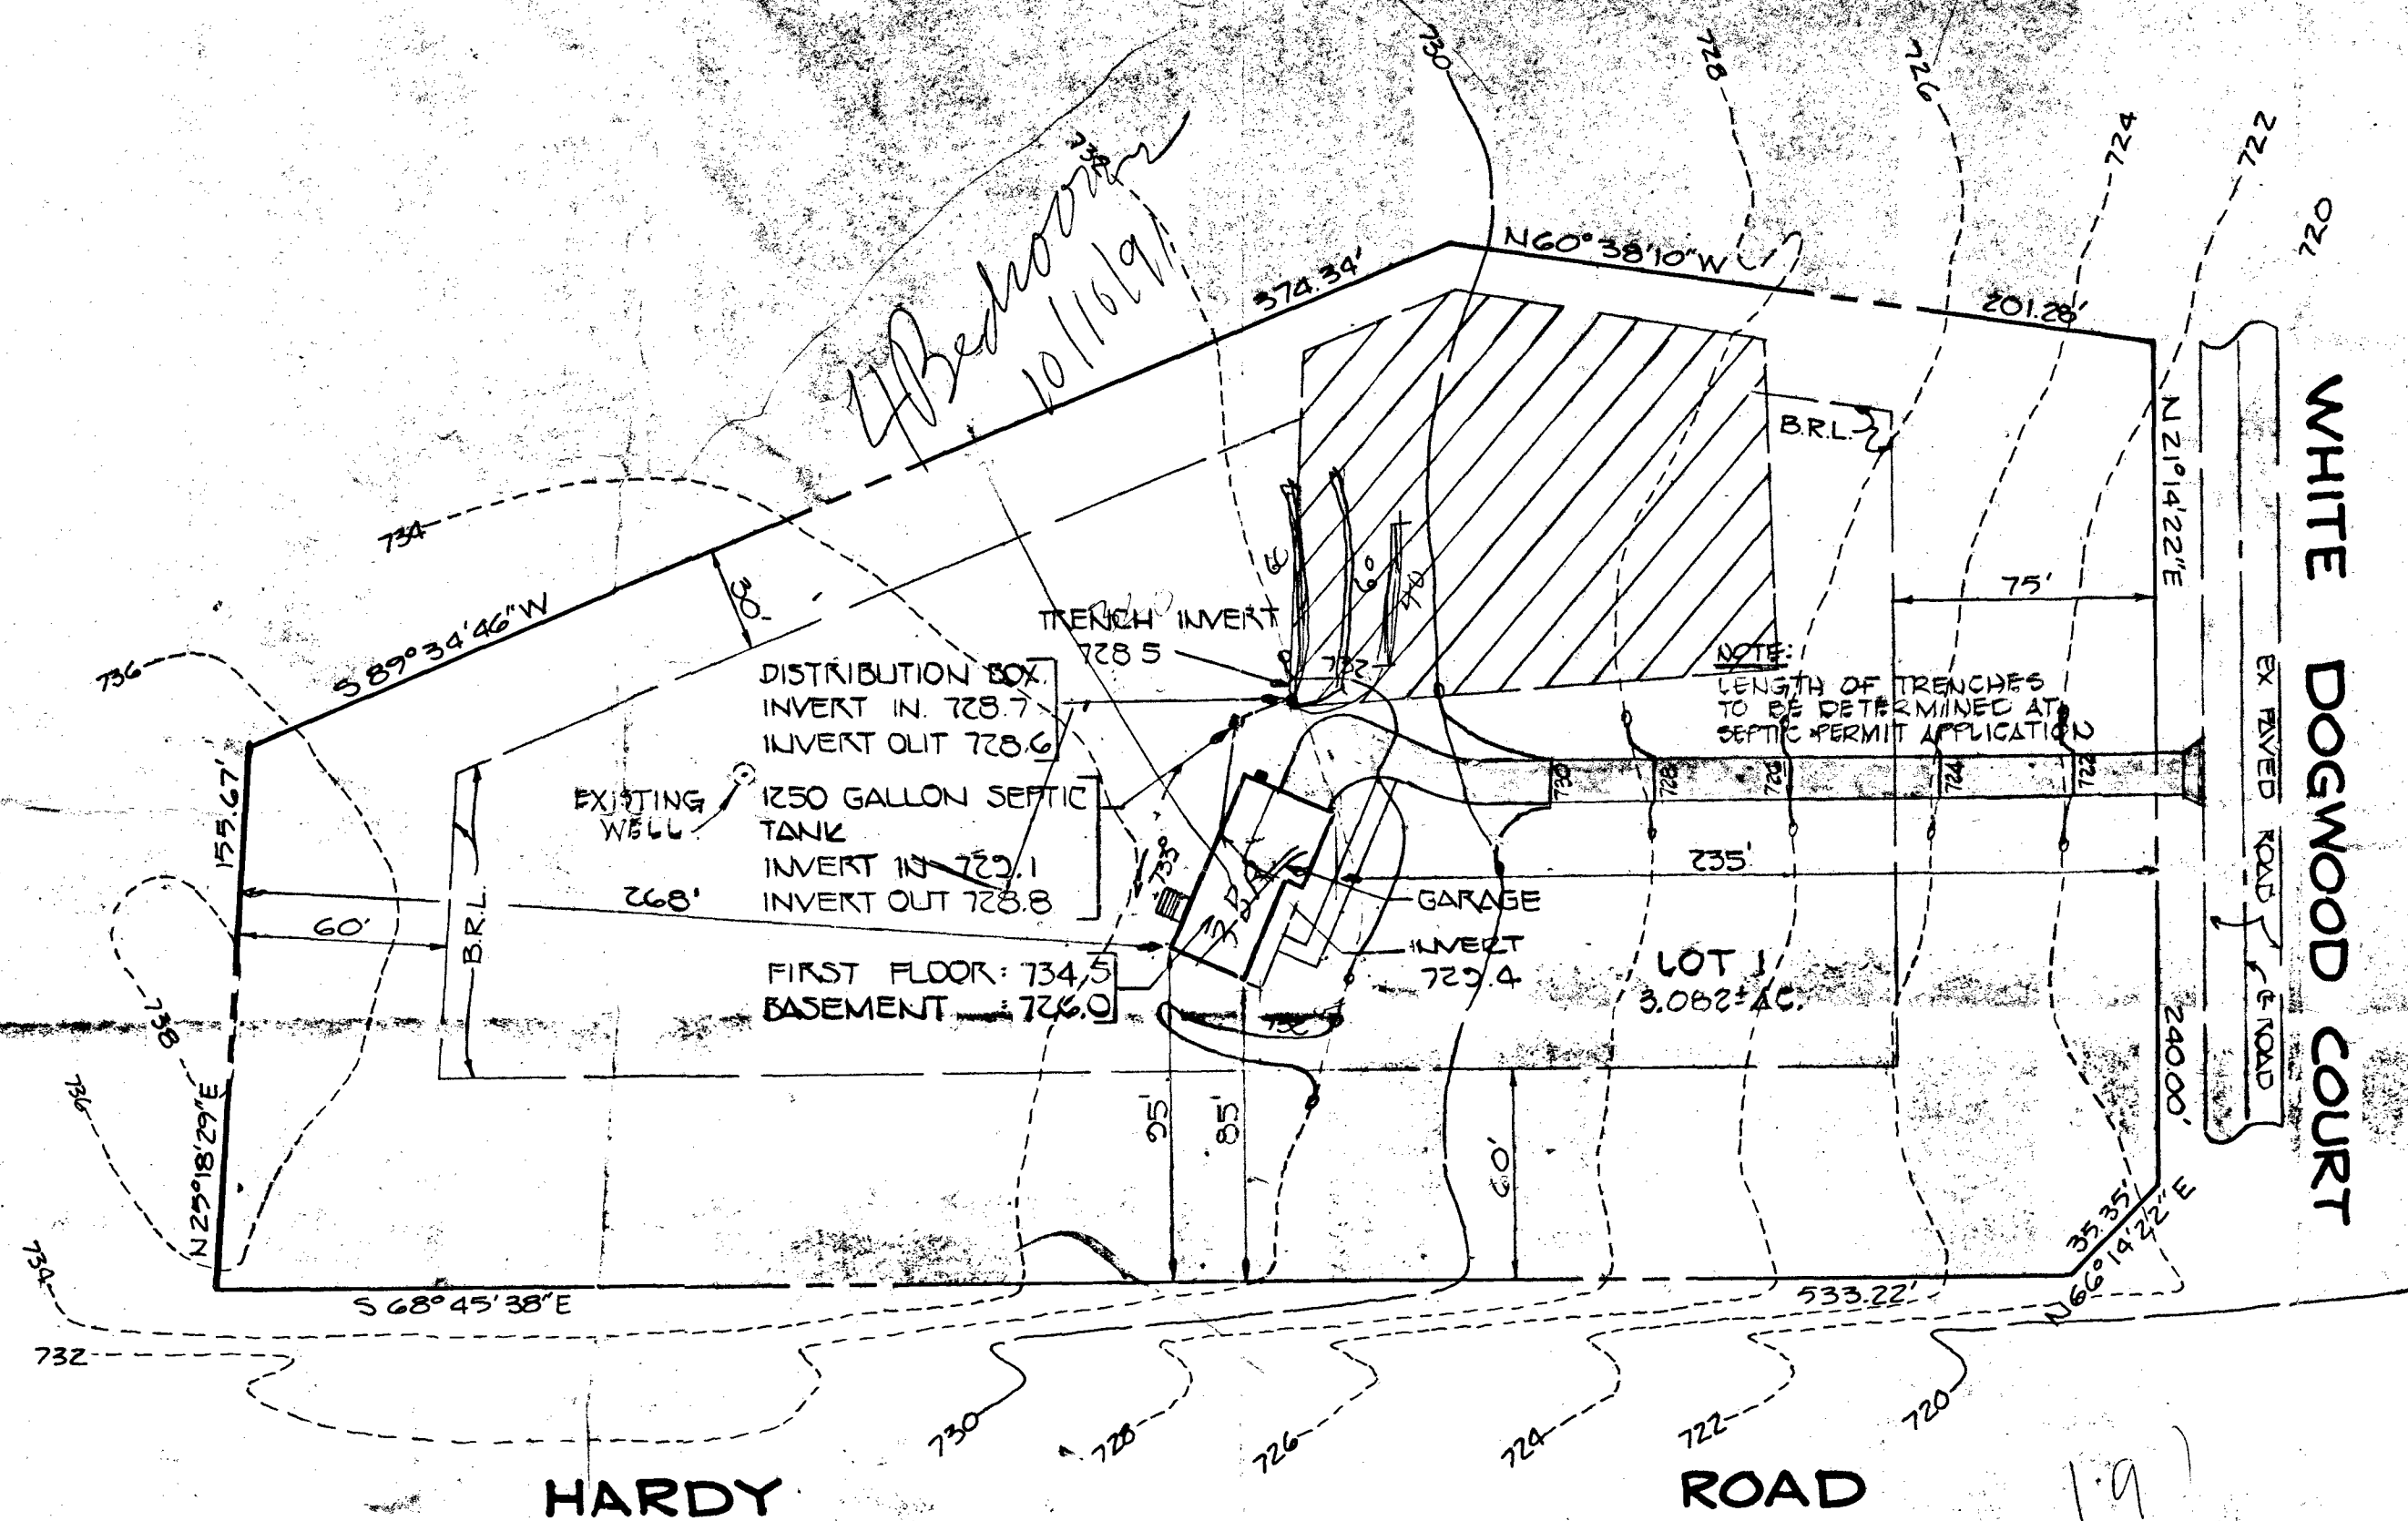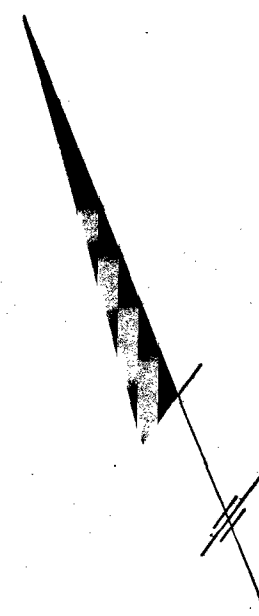

WHITE DOGWOOD COURT

HARDY

ROAD

10/16/91
change to
4 bedrooms

PLANS OK AFTER
MINOR REDLINE
ADDITIONS MADE
OVER PHONE

9/13/91
R. Hodges

FISHER, COLLINS & CARTER, INC.

CIVIL ENGINEERING CONSULTANTS & LAND SURVEYORS

9171 BALTIMORE NATIONAL PIKE, SUITE 100

ELLICOTT CITY, MARYLAND 21042

(301) 461-2855

PLAN TO ACCOMPANY APPLICATION
FOR BUILDING PERMIT
LOT 1 PLAT 8244

WHITE WOOD ESTATES

FOURTH ELECTION DISTRICT

HOWARD COUNTY, MD.

SCALE: 1" = 50'

SEPTEMBER 5, 1991



C. BRYAN STREAKER

SANTARIAN

WATER AND SEWERAGE PROGRAM

BUREAU OF ENVIRONMENTAL HEALTH

3525-H ELLICOTT MILLS DRIVE

ELLICOTT CITY, MD 21043

 DEPARTMENT OF HUMAN RESOURCES
 OFFICE OF CHILD CARE LICENSING AND REGULATION
 ENVIRONMENTAL HEALTH SURVEY

For file

by applicant:

Provider/Center: MARYLOU GRIMM
 Provider/Center: 17401 White Dogwood Ct.
mt. Airy, md. 21771

 Family Day Care Home: 5 (includes adults)
 provider's children under 6: ok

 City: 8 (maximum number of children
 at any time including
 provider's own children
 under 6 years)

 WATER SUPPLY: ☐ Public ☒ Private

 SEWAGE DISPOSAL: ☐ Public ☒ Private

To be completed by local Health Department:

Findings:	WATER SUPPLY	SEWAGE DISPOSAL
☒ In compliance	☒ In compliance	
☐ Not in compliance	☐ Not in compliance	

Recommendation:

☒ License/ Register	☐ License/Register with plan to correct	☐ Emergency suspension because of imminent risk to children
☐ Do not License/Register		

RECEIVED
 Comments: 6/5/92 Pets - 2 cats current - owners. APR 29 1992

 OFFICE OF CHILD CARE
 LICENSING & REGULATIONS
 REGION #6

 Signature/Date Charles Bryan Streaker 6/5/92
 Health Department Inspector

 Signature/Date Charles Bryan Streaker 6/5/92
 Health Officer Representative
D.H.R.**CHILD CARE ADMINISTRATION**
 10178 Baltimore National Pike, #115
 Ellicott City, Maryland 21042
Return completed form to by ASAP:


Eloise Sainchcomb, Lic Spec.

THIS PLAT CAN NOT BE USED TO ESTABLISH PROPERTY
LINES OR CORNERS.

WHITE WOOD ESTATES
LOTS 1-25 · BOATING R.
Rt 8244 · SHEET 2 OF 5
ELECTION DISTRICT 4
HENRIAD COUNTY, MARYLAND

Trule L 18' x 28' x 43'
Left Side 100'
Right Side 30'

TO House 50'
Pears 120'
TO Septer 35'
Well 30'

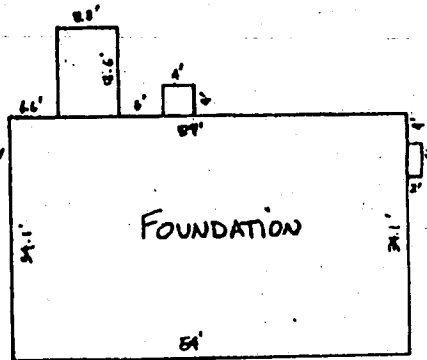


SCALE: 1"=20'

Top Wall:
2' OUT OF
NATURAL GROUND

10/3/96
Shown pool
location will
have no impact
to the existing
well & septic..
OK to proceed.

A. McMeel

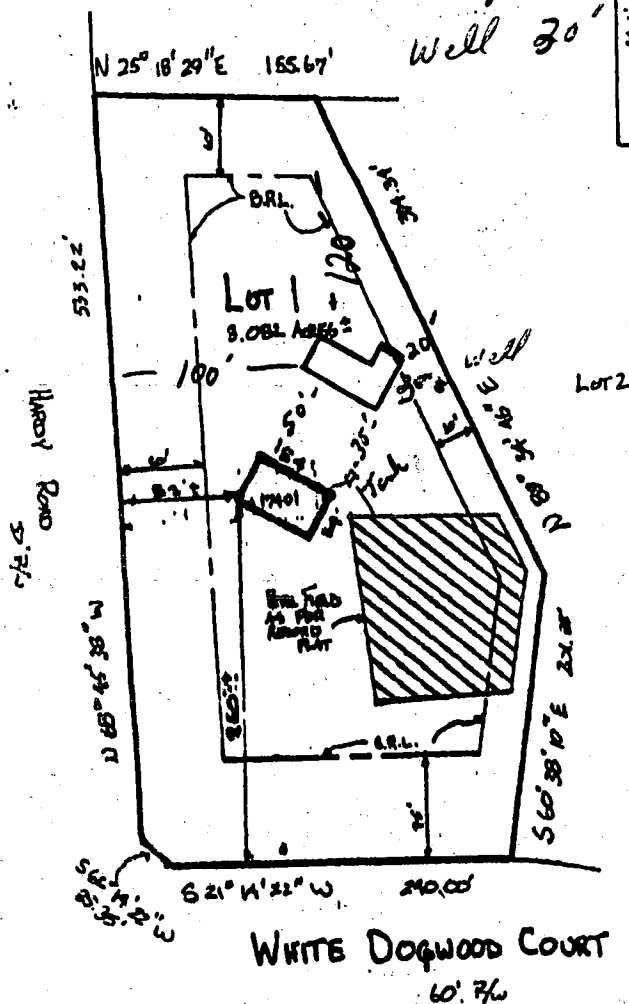

MHIC # 34414-01

TRI-COUNTY POOLS, INC.
13410 Moser Rd.
Thurmont, MD 21788
301-898-3030

LOCATION SURVEY PLAT
SUBJECT PROPERTY NOT LOCATED IN A FLOOD PLAIN AREA UNLESS OTHERWISE NOTED E&U. 10-24-1979

CERTIFICATION

This is to certify that I have surveyed
the property known as: 1791 Santa Monica Blvd

for the purpose of locating the improvements therein, and the improvements are located as shown.



LAND DESIGN ENGINEERING, INC.
SUITE 210 10620 QUILFORD ROAD
JEESUP, MARYLAND 20704

887-8833 (BAXT) 804-8804 (WAD)

