

05-413273

P 58584A

A 40775

DISTRICT 5th

DATE 7-24-97

DATE SYSTEM APPROVED 7-29-97

~~XXXXXX~~ 313-2640

INSPECTOR KM

Jack Fyock Septic Services IS PERMITTED TO INSTALL X ALTER

ADDRESS 13775 Triadelphia Road, Glenelg, Maryland 21737 PHONE 410-988-9270

SUBDIVISION The Warfields LOT 11 ROAD 14837 View Way Court

PROPERTY OWNER William and Cynthia Tack

ADDRESS _____

SEPTIC TANK CAPACITY 1250 GALLONS

NUMBER OF BEDROOMS 4

210 SQUARE FEET PER BEDROOM

LINEAR FEET OF TRENCH REQUIRED 280

TRENCHES - Trench to be 3 feet wide. Inlet 3½ feet below original grade. Bottom maximum depth 5 feet below original grade. Effective area begins at 3½ feet below original grade. 1½ feet of stone below distribution pipe.

LOCATION - Place the distribution box 140 feet down the right (463.86') lot line and 120 feet off this same lot line. Run trenches on contour to right side of lot.

NOTES - No trench to exceed 100 feet in length. Provide 6" - 8" diameter cleanout and cap to grade or above on septic tank.

OK Km 5-21-97

PLANS APPROVED BY Mark Rifkin/Donna K. Soe DATE 5/14/97

COVER NO WORK UNTIL INSPECTED AND APPROVED

NEITHER THE HOWARD COUNTY COUNCIL NOR THE HEALTH DEPARTMENT IS RESPONSIBLE FOR THE SUCCESSFUL OPERATION OF ANY SYSTEM

NOTE: CLEANOUT REQUIRED EVERY 70 FEET OF SEWER LINE AND/OR AT 90° SWEEPS IN LINES FROM HOUSE TO DRAIN FIELDS, 90° ELBOWS NOT ACCEPTABLE.

NOTE: ALL PARTS OF SEPTIC SYSTEMS (I.E. TANK, DISTRIBUTION BOX TRENCHES) TO BE 100 FEET FROM WELL (UNLESS OTHERWISE SPECIFICALLY AUTHORIZED)

NOTE: IF DEEP TRENCH(ES) ARE USED CALL FOR INSPECTION BEFORE AND AFTER PLACING GRAVEL IN TRENCH(ES)

NOTE: NO DRY WELL SHALL EXCEED 15 FOOT IN DIAMETER NO ABSORPTION TRENCH TO EXCEED 100 FEET IN LENGTH

NOTE: ALL PIPE FROM HOUSE TO SEPTIC TANK MUST BE CAST IRON OR SCHEDULE 35/40 PVC OR ABS

PERMIT VOID AFTER TWO YEARS

NOTE: INSTALL STAND PIPE ON SEPTIC TANK AND DRY WELL STAND PIPES MUST BE 6 INCHES IN DIAMETER CAST IRON. CONCRETE OR TERRA COTTA OR PVA OR ABS ACCEPTED. IF TOP OF SEPTIC TANK IS DEEPER THAN 3 FEET. MANHOLE TO GRADE REQUIRED.

NOTE: DISTRIBUTION BOXES MUST HAVE BAFFLES

***INSTALLER IS RESPONSIBLE FOR OBTAINING FINAL APPROVAL ON THIS PERMIT**

HD-260(6-90)

*CALL 461-9933 FOR INSPECTION OF SEPTIC SYSTEM.


ELDC. PERMIT SIGNED

AND RETURNED 3-18-99

AND RETURNED 3-18-79
Serial # 260116201

ST IRON. CON
1. *check*

A 40775

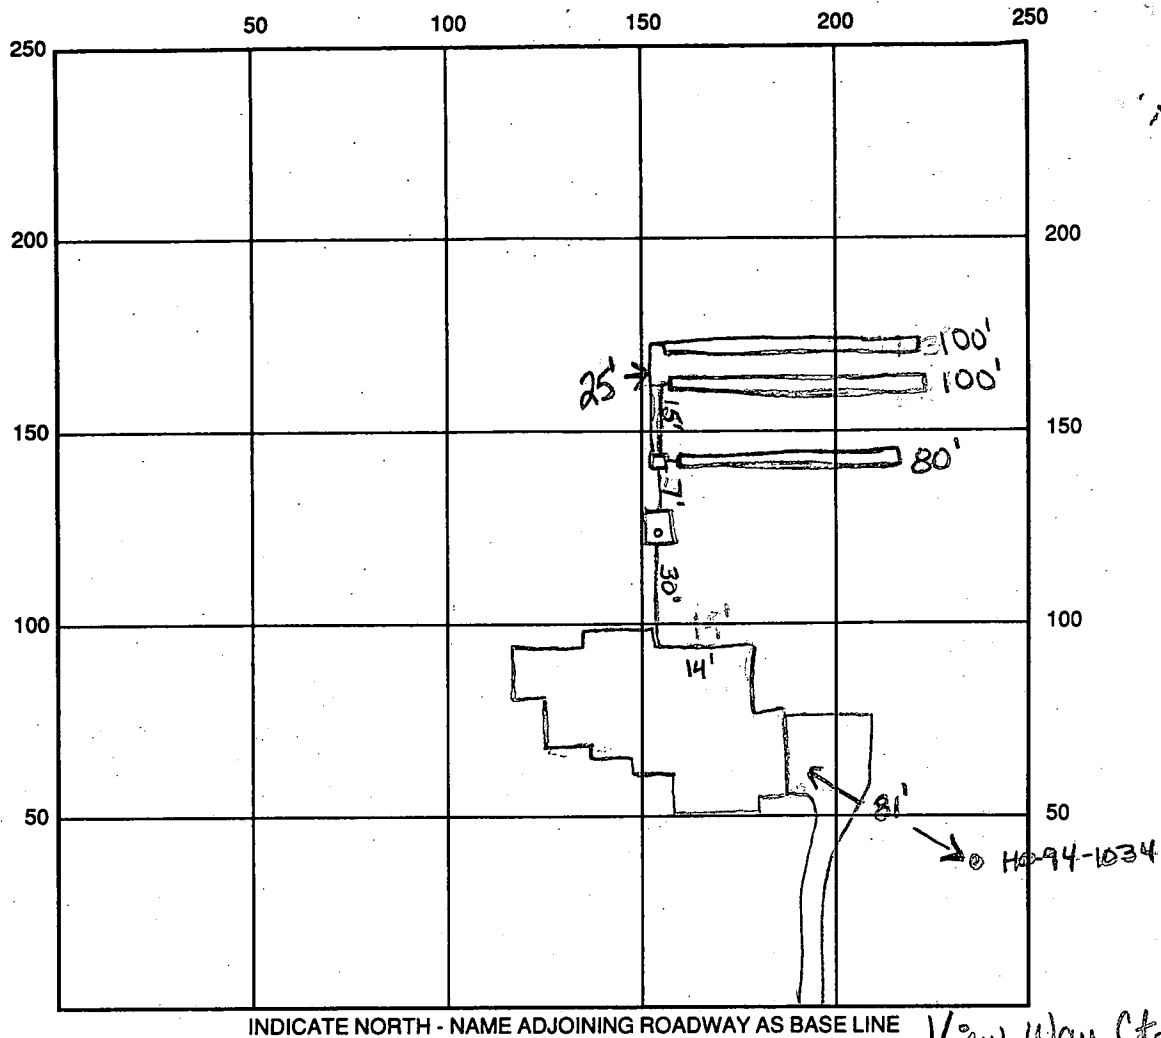

INDICATE NORTH - NAME ADJOINING ROADWAY AS BASE LINE

View Way Ct.

SEPTIC TANK LEVEL OK 1250 gal CLEANOUTS 1 on tank

DISTRIBUTION BOX LEVEL OK - preformed baffel

DRAIN FIELD/TITLE DEPTH 5.0 FT. TRENCH WIDTH 3.0 FT. INLET DEPTH 3.5 FT.

EFFECTIVE GRAVEL DEPTH 2.0 FT. TOTAL LENGTH 2x100 1x80 FT. → 280'

NUMBER OF TRENCHES 3 ONE SIDEWALL/BOTTOM AREA 840 SQ. FT.

DRYWALL INSIDE DIAMETER — FT. EFFECTIVE DEPTH BELOW INLET — FT.

ABSORBENT AREA — SQ. FT.

REMARKS: 7/28/97 OK to continue ALM

7-29-97 has house connection, OK to cover all work (KM)

7-29-97 P.A. 3.0' below grade, casing 1.5' above grade, has 2 piece cap
needs conduit pipe, WPI ok to cover well line

DATE SYSTEM APPROVED 7-29-97 INSPECTOR Kimberly Maiste

APPLICATION

PERCOLATION TESTING

A 40775

P _____

HOWARD COUNTY HEALTH DEPARTMENT
BUREAU OF ENVIRONMENTAL HEALTH

P.O. BOX 476 ELLICOTT CITY, MARYLAND 21043
TELEPHONE: 461-9933

DISTRICT 5th

DATE 12/1/87

TO: THE COUNTY HEALTH OFFICER
ELLICOTT CITY, MARYLAND

I, HEREBY, APPLY FOR THE NECESSARY TEST IN ORDER TO CONSTRUCT (OR RECONSTRUCT) A SEWAGE DISPOSAL SYSTEM.

PROPERTY OWNER Kennard Warfield Jr. William and Cynthia Tack

ADDRESS 14663 Triadelphia Rd PHONE 442-2337

PROSPECTIVE BUYER N/A

ADDRESS View Way Court PHONE _____

PROPERTY LOCATION:

SUBDIVISION THE WARFIELDS LOT NO. Lot 11 Preliminary 10
Sapling Range

ROAD AND DESCRIPTION 14600 Triadelphia Rd just west of Howard Rd
(14837 View Way Court)

TAX MAP 27 PARCEL # 56

SIZE OF LOT 3 acres TYPE BLDG. SFD - 4 Bm
(SINGLE FAMILY DWELLING OR COMMERCIAL)

BLDG. PERMIT SIGNED

AND RETURNED 5/14/92

Serial # BR105339

THE SYSTEM INSTALLED UNDER THIS APPLICATION IS ACCEPTABLE ONLY UNTIL PUBLIC FACILITIES BECOME AVAILABLE. I FULLY UNDERSTAND THE

FEE CONNECTED WITH THE FILING OF THIS PERC TEST APPLICATION IS NON-REFUNDABLE UNDER ANY CIRCUMSTANCES. I ALSO AGREE TO COMPLY

WITH ALL M.O.S.H.A. REQUIREMENTS IN TESTING THIS LOT. Myrdal Reil
(SIGNATURE OF APPLICANT)

APPROVED BY _____ FOR _____ DATE _____

REJECTED BY _____ FOR _____ DATE _____

HOLD PENDING FURTHER TESTS _____ DATE _____

REASONS FOR REJECTION OR HOLDING 2-1-88 PERC SATISFACTORY - HOLD FOR Subdivision PLAT S.A.


THIS IS NOT A PERMIT

③ SOIL PROFILE

0'
4" A1-3
Yellow Br
Silt Clay
Loam
2-10% Frags

4"
4.5" Yellow Br,
Silt Loam
Highly
interstices
20-25%
Frags

13"

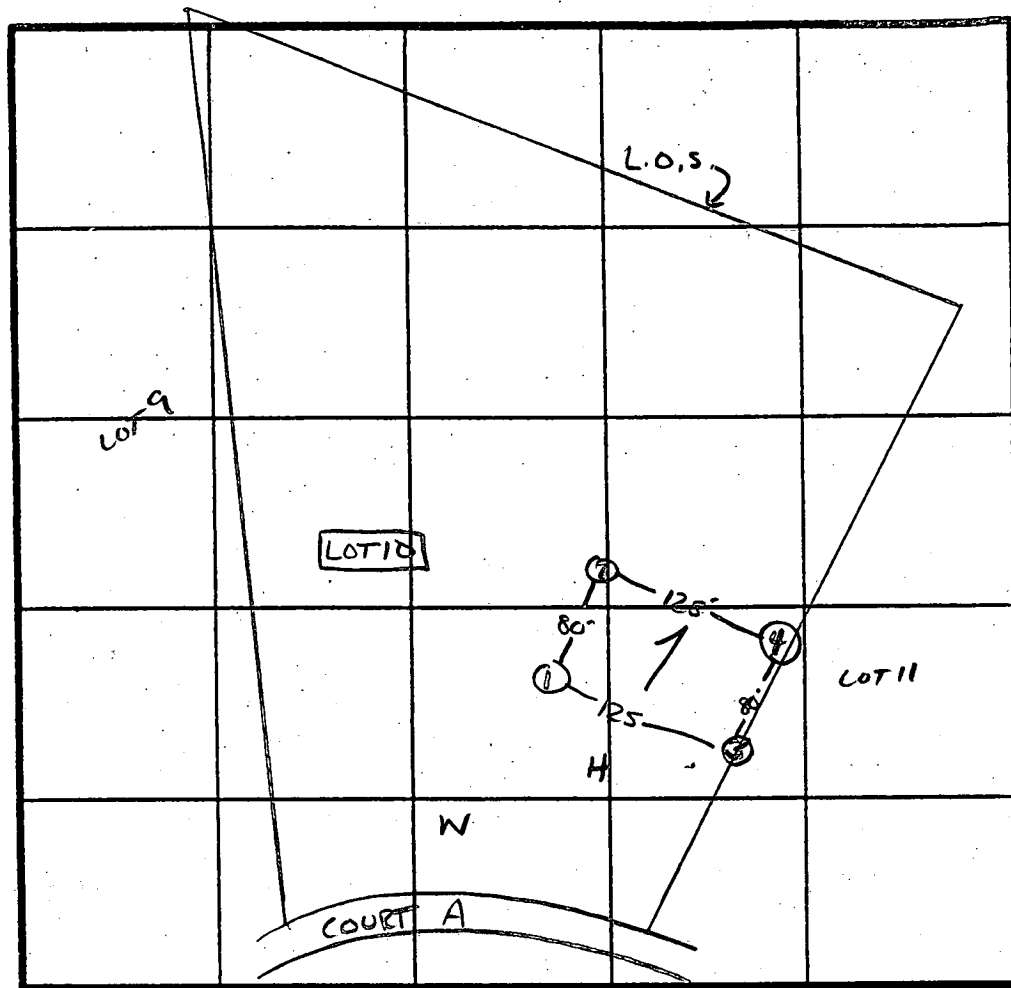

x Perc 9 min
210 P/BN
INLET 3.5'
BOTTOM 5.0'

INDICATE NORTH - NAME ADJOINING ROADWAY AS BASE LINE

TO TRIADAPLHIA Rd.

DATE	TEST NO.	DEPTH	PRE-WET		TEST - 1" DROP		TIME
			START	STOP	START	STOP	
2/11/88	1 ✓	12"	UNIFORM	soil below 4.5"			
	2 S ✓	5.5"	3:15	3:16	3:16	3:20	4 min
	2 V ✓	12.5"	UNIFORM	soil below 4.5-5.0"			
	3 S	4.0	2:58	3:04	3:04	3:28	22 min
	3 M	9.0	2:54	2:59	2:59	3:10	11 min
	3 V	13"	UNIFORM	soil below 4"			
	4 S	5"	3:04	3:08	3:08	3:15	7 min
	4 V	12.5"	UNIFORM	soil below 4.0"-4.5"			

REMARKS Holes APPROX PLAT

TYPE OF SOIL Gravelly

TESTED BY S. Mui

ALSO PRESENT O-KETER map
Randy R.

Lot 11
F 89-231
VIEW WAY CT

LOT 10

LOT 16

N 514250
F 796000

MATCH LINE SEE SHEET 4 OF 9
S65°58'56"E 536.54' (NR)

LOT 11
8.100 AC±

C.M.C. CONSTRUCTION INC.
432/551
P. 13

OF 9

2°20'E 454.23'

B.R.L.

332
334
Recess
L-21.00'

82.04'
50'
S25°45'00"W 262.35'
COURT
WAY
N25°45'00"E 262.35'
217.15'

337
335
Recess
L-21.00'

B.R.L.

S51°02'18"E 463.86'

349.80'

BEARING
20°00'W
100' E

EMERGENCY/TEMP NO. IF ANY

B 1 8250		SEQUENCE NO. (MDE USE ONLY)		STATE OF MARYLAND PERMIT TO DRILL WELL please print or type		STATE PERMIT NUMBER 40-94-1034 <small>70 fill in this form completely 79</small>	
<small>THIS NUMBER IS TO BE PUNCHED IN COLS. 3-6, ON ALL CARDS</small>							
OWNER INFORMATION Date Received (APA) 123196 WARFIELD KERNARD 14663 TRINDELPHIA RD GLENELG MD 21737 <small>15 Last Name 34 First Name 36 Street or RFD 55 Town 70 State 72 Zip 76</small>				LOCATION OF WELL B 3 HOWARD 8 COUNTY THE WARFIELDS 23 SUBDIVISION SECTION 44 46 LOT 11 GLENELG 52 NEAREST TOWN MILES FROM TOWN (enter 0 if in town) 2 MI <small>73 76 77 78</small>			
DRILLER INFORMATION CIRCLE MSD/ MGD/ MWD Ralph MAYNE Ralph MAYNE Well Drilling 9120 Brown Church Rd. Mt. Airy Ralph Mayne 12/23/96 <small>Driller's Name 77 License No. 80 Firm Name Address Signature Date</small>				VIEW WAY CT. NEAR WHAT ROAD ON WHICH SIDE OF ROAD (CIRCLE APPROPRIATE BOX) 34 SO 37 DISTANCE FROM ROAD ENTER FT OR MI 4 <small>38 39</small>			
WELL INFORMATION B 2 APPROX. PUMPING RATE (GAL. PER MIN.) 5 AVERAGE DAILY QUANTITY NEEDED (GAL. PER DAY) 500 <small>8 12 14 20</small>				DIRECTION OF WELL FROM TOWN (CIRCLE BOX) USE FOR WATER (CIRCLE APPROPRIATE BOX) <input checked="" type="checkbox"/> D HOME (SINGLE OR DOUBLE HOUSEHOLD UNIT ONLY) <input type="checkbox"/> F FARMING (LIVESTOCK WATERING & AGRICULTURAL IRRIGATION) <input type="checkbox"/> I INDUSTRIAL, COMMERCIAL, STATE AND FEDERAL GOV. OTHER (REQUIRES APPROPRIATION PERMIT) <input type="checkbox"/> P PUBLIC OR PRIVATE WATER COMPANY (REQUIRES APPROPRIATION PERMIT AND STATE HEALTH DEPARTMENT APPROVAL) <input type="checkbox"/> T TEST, OBSERVATION, MONITORING (MAY REQUIRE APPROPRIATION PERMIT)			
APPROXIMATE DEPTH OF WELL 150 FEET <small>24 28</small>				NOT TO BE FILLED IN BY DRILLER HEALTH DEPARTMENT APPROVAL Howard A-40775 COUNTY NAME COUNTY NO. STATE SIGNATURE DATE ISSUED 010397 CO SIGNATURE EXP. DATE 1/3/98 NORTH GRID 514000 EAST GRID 796000 <small>50 55 57 63</small>			
APPROXIMATE DIAMETER OF WELL 6" INCH <small>NEAREST INCH</small>				SHOW MAJOR FEATURES OF BOX & LOCATE WELL WITH AN X SOURCES OF DRILLING WATER 1. well 2. 3. WRITE THE BOX NUMBER FROM THE MAP HERE E 2906 N 5104 <small>000 000</small>			
METHOD OF DRILLING (circle one) BORED (or Augered) JETTED Jetted & DRIVEN AIR-ROTARY AIR-PERCussion ROTARY (Hydraulic Rotary) CABLE REVERSE-ROTARY DRIVE-POINT other				DRAW A SKETCH BELOW SHOWING LOCATION OF WELL IN RELATION TO NEARBY TOWNS AND ROADS AND GIVE DISTANCE FROM WELL TO NEAREST ROAD JUNCTION Trin Delphia Rd Sapling way Michele Dr 50' well			
REPLACEMENT OR DEEPEMED WELLS (CIRCLE APPROPRIATE BOX) <input checked="" type="checkbox"/> N THIS WELL WILL NOT REPLACE AN EXISTING WELL <input type="checkbox"/> S THIS WELL WILL REPLACE A WELL THAT WILL BE ABANDONED AND SEALED <input type="checkbox"/> S THIS WELL WILL REPLACE A WELL THAT WILL BE USED AS A STANDBY-CONTACT-LOCAL APPROVING AUTHORITY FOR POLICY ON STANDBY WELLS <input type="checkbox"/> D THIS WELL WILL DEEPEN AN EXISTING WELL PERMIT NUMBER OF WELL TO BE REPLACED OR DEEPEMED (IF AVAILABLE) 41							
Not to be filled in by driller (MDE OR COUNTY USE ONLY) APPROX. PERMIT NUMBER 54 GAP 63 FORCE 45 WRITE INITIALS IN BOX PERMIT No. 40-94-1034 <small>67 68 70 71 72 73 74 75 76 77 78 79</small>							
SPECIAL CONDITIONS NOTE - APPROVING AUTHORITIES SHOULD USE SEPARATE SHEET IF NEEDED -							

COUNTY

C 1		6566		SEQUENCE NO. (MDE USE ONLY)		STATE OF MARYLAND WELL COMPLETION REPORT				THIS REPORT MUST BE SUBMITTED WITHIN 45 DAYS AFTER WELL IS COMPLETED.			
1 2 3 6 (THIS NUMBER IS TO BE PUNCHED IN COLS. 3-6 ON ALL CARDS)						FILL IN THIS FORM COMPLETELY PLEASE PRINT OR TYPE				COUNTY NUMBER A-40775			
ST/CO/USE ONLY DATE Received MM DD YY 8 13		DATE WELL COMPLETED MM DD YY 2 3 97				Depth of Well 22 245 26 (TO NEAREST FOOT)				PERMIT NO. FROM "PERMIT TO DRILL WELL" HO 94-1034 28 29 30 31 32 33 34 35 36 37			
OWNER Warfield		Kennard											
STREET OR RFD View Way Ct.		TOWN Glenelg											
SUBDIVISION The Warfields		SECTION D		LOT 11									
WELL LOG				GROUTING RECORD				C 3					
Not required for driven wells				WELL HAS BEEN GROUTED (Circle Appropriate Box)				PUMPING TEST					
STATE THE KIND OF FORMATIONS PENETRATED, THEIR COLOR, DEPTH, THICKNESS AND IF WATER BEARING				TYPE OF GROUTING MATERIAL (Circle one)				HOURS PUMPED (nearest hour)					
DESCRIPTION (Use additional sheets if needed)				CEMENT (CM) BENTONITE CLAY (BC)				10					
FEET FROM TO				NO. OF BAGS 45 46 20 NO. OF POUNDS 45 46 2000				PUMPING RATE (gal. per min.) 10					
Top Soil 0 2				GALLONS OF WATER 120				METHOD USED TO MEASURE PUMPING RATE Bucket					
Sandy 2 50				DEPTH OF GROUT SEAL (to nearest foot)				WATER LEVEL (distance from land surface)					
Sand Stone 50 55				from 48 TOP 52 54 BOTTOM 58 ft. (enter 0 if from surface)				BEFORE PUMPING 42 ft.					
MICKA 55 75				Casing types: insert appropriate code below				WHEN PUMPING 75 ft.					
Sand Stone 75 80				Casing RECORD				TYPE OF PUMP USED (for test)					
MICKA 80 245				MAIN Casing TYPE PL 6 65				A air P piston T turbine					
				OTHER Casing (if used)				C centrifugal R rotary O other (describe below)					
				screen type or open hole				J jet S submersible					
				SCREEN RECORD				PUMP INSTALLED					
				DEPTH (nearest ft.)				DRILLER WILL INSTALL PUMP (YES NO)					
				63 245				IF DRILLER INSTALLS PUMP, THIS SECTION MUST BE COMPLETED FOR ALL WELLS.					
				WELL HYDROFRACTURED				TYPE OF PUMP INSTALLED					
				C 2				PLACE (A,C,J,P,R,S,T,O) IN BOX 29					
				CIRCLE APPROPRIATE LETTER				CAPACITY: GALLONS PER MINUTE (to nearest gallon)					
				A A WELL WAS ABANDONED AND SEALED WHEN THIS WELL WAS COMPLETED				PUMP HORSEPOWER					
				E ELECTRIC LOG OBTAINED				PUMP COLUMN LENGTH (nearest ft.)					
				P TEST WELL CONVERTED TO PRODUCTION WELL				CASING HEIGHT (circle appropriate box and enter casing height)					
				I HEREBY CERTIFY THAT THIS WELL HAS BEEN CONSTRUCTED IN ACCORDANCE WITH COMAR 26.04.04 "WELL CONSTRUCTION" AND IN CONFORMANCE WITH ALL CONDITIONS STATED IN THE ABOVE CAPTIONED PERMIT; AND THAT THE INFORMATION PRESENTED HEREIN IS ACCURATE AND COMPLETE TO THE BEST OF MY KNOWLEDGE.				LAND SURFACE					
				DRILLERS LIC. NO. 1 MSD 116				LOCATION OF WELL ON LOT					
				DRILLERS SIGNATURE				SHOW PERMANENT STRUCTURE SUCH AS BUILDING, SEPTIC TANKS, AND /OR LANDMARKS AND INDICATE NOT LESS THAN TWO DISTANCES (MEASUREMENTS TO WELL)					
				LIC. NO. 1 MSD 117				65' well					
				SITE SUPERVISOR (sign. of driller or journeyman responsible for sitework if different from permittee)				25'					
				TELESCOPE CAGING				PROP LINE					
				LOG INDICATOR									
				OTHER DATA									
				COUNTY									



HOWARD COUNTY HEALTH DEPARTMENT

Joyce M. Boyd, M.D., County Health Officer

September 12, 1991

Reply to:

To: Frank Delph

From: Mark Rifkin, Sanitarian *MR*

Re: Well Permit HO-88-1666 thru HO-88-1671, The Warfields, Lots 1-6
HO-88-1465 thru HO-88-1473, The Warfields, Lots 7-15


A review of our records indicates that the above referenced well drilling permits have expired. The first set of permits expired on February 6, 1991. The second set of permits expired on August 19, 1991.

Please return the permits and well tags to this office.



MR:cm

B 1 5930 <small>(THIS NUMBER IS TO BE PUNCHED IN COLS. 3-6 ON ALL CARDS)</small>	SEQUENCE NO. (DP USE ONLY)	STATE OF MARYLAND PERMIT TO DRILL WELL please print or type	STATE PERMIT NUMBER HO-88-1469 <small>fill in this form completely</small>
Date Received (APA) 062289 OWNER INFORMATION LAND DESIGN AND DEVL 8307 MAIN STREET ELLICOTT CITY MD 21043 Town State Zip		LOCATION OF WELL HOWARD 8 COUNTY The Harford STEELING RANGE 23 SUBDIVISION SECTION 44 LOT 11 52 NEAREST TOWN MILES FROM TOWN (enter 0 if in town) 4 MI View Way Court NEAR WHAT ROAD ON WHICH SIDE OF ROAD (CIRCLE APPROPRIATE BOX) NORTH WEST SOUTH EAST 34 75 37 DISTANCE FROM ROAD ENTER FT or MI FT	
DRILLER INFORMATION Frank Delph Driller's Name Frank Delph Well Drillers Inc. Firm Name 18234 Penn Shop Rd Mt. Airy, Md. Address Frank Delph Signature 4/19/89 Date		WELL INFORMATION APPROX. PUMPING RATE (GAL. PER MIN.) 5 AVERAGE DAILY QUANTITY NEEDED (GAL. PER DAY) 500 USE FOR WATER (CIRCLE APPROPRIATE BOX) <input checked="" type="checkbox"/> HOME (SINGLE OR DOUBLE HOUSEHOLD UNIT ONLY) <input type="checkbox"/> FARMING (LIVESTOCK WATERING & AGRICULTURAL IRRIGATION) <input type="checkbox"/> INDUSTRIAL, COMMERCIAL, STATE AND FEDERAL GOV. OTHER (REQUIRES APPROPRIATION PERMIT) <input type="checkbox"/> PUBLIC OR PRIVATE WATER COMPANY (REQUIRES APPROPRIATION PERMIT AND STATE HEALTH DEPARTMENT APPROVAL) <input type="checkbox"/> TEST, OBSERVATION, MONITORING (MAY REQUIRE APPROPRIATION PERMIT)	
APPROXIMATE DEPTH OF WELL 200 FEET APPROXIMATE DIAMETER OF WELL 6 INCH METHOD OF DRILLING (circle one) BORED (or Augered) JETTED Jetted & DRIVEN AIR-ROTary AIR-PERCussion ROTARY (Hydraulic Rotary) CABLE REVERSE-ROTary Drive-POINT other		NOT TO BE FILLED IN BY DRILLER HEALTH DEPARTMENT APPROVAL Howard COUNTY NAME COUNTY NO. A-40775 STATE SIGNATURE DATE ISSUED 080690 CO-SIGNATURE Mark E. Reikin 2/6/91 NORTH GRID 514000 EAST GRID 079600 SHOW MAJOR FEATURES OF BOX & LOCATE WELL WITH AN X SOURCES OF DRILLING WATER 1. Well WRITE THE BOX NUMBER FROM THE MAP HERE 7986 5134 DRAW A SKETCH BELOW SHOWING LOCATION OF WELL IN RELATION TO NEARBY TOWNS AND ROADS AND GIVE DISTANCE FROM WELL TO NEAREST ROAD JUNCTION Philadelphia Rd Road A 75' X WAY TRIdelphia Mill Rd	
REPLACEMENT OR DEEPEMED WELLS (CIRCLE APPROPRIATE BOX) <input checked="" type="checkbox"/> THIS WELL WILL NOT REPLACE AN EXISTING WELL <input type="checkbox"/> THIS WELL WILL REPLACE A WELL THAT WILL BE ABANDONED AND SEALED <input type="checkbox"/> THIS WELL WILL REPLACE A WELL THAT WILL BE USED AS A STANDBY <input type="checkbox"/> THIS WELL WILL DEEPEMED AN EXISTING WELL PERMIT NUMBER OF WELL TO BE REPLACED OR DEEPEMED (IF AVAILABLE) Not to be filled in by driller (OEP USE ONLY) APPROP. PERMIT NUMBER FORCE MR WRITE INITIALS IN BOX PERMIT No. HO-88-1469 SPECIAL CONDITIONS		COUNTY	

800116701
 Septic Tank is far enough
 From Deck as stated on
 OK to release Building Permit
 3/18/99

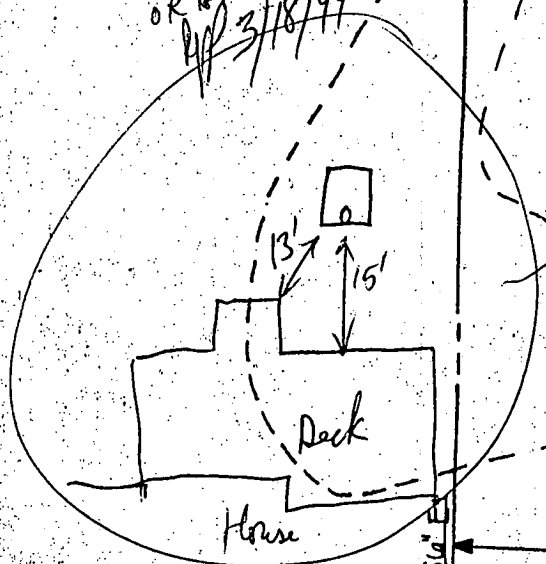

280' OF TRENCH
3' WIDE

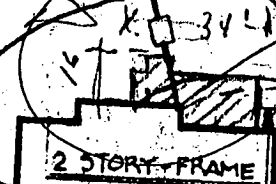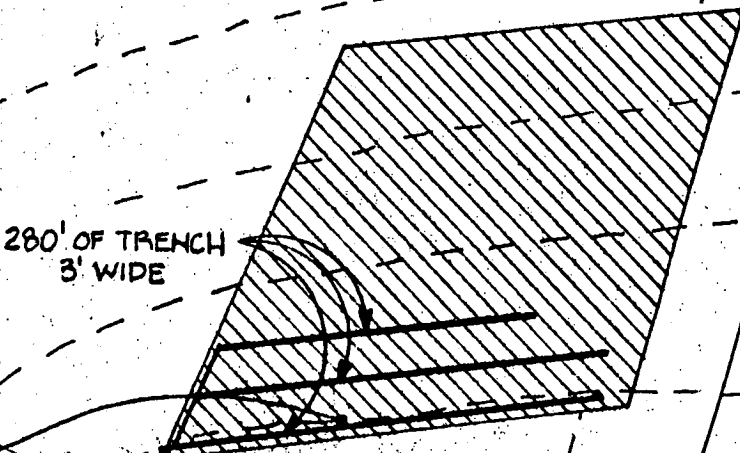

The Warfield's
 Lot 11

- WELL & SEPTIC
- 492.50
- 502.16
- 493.00
- 482.55

N 25° 45' 00" E

14837 VIEW WAY COURT

S 51° 02' 18" E 113.41'

100'

217.15'

75' BRL

68'

60'±

76'±

91'±

108'±

48'

4'

4'

495

500


490

485


30' BRL

SITE PLAN

SCALE: 1" = 40'

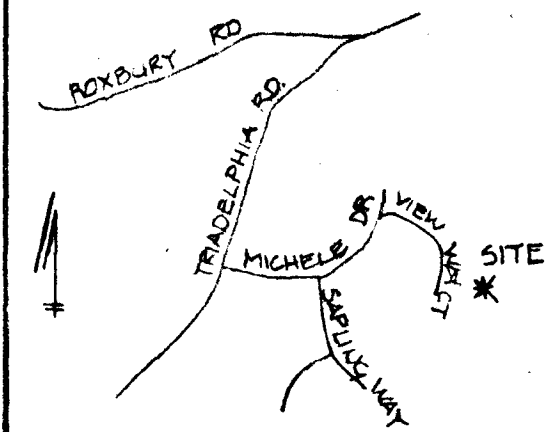

VICINITY MAP

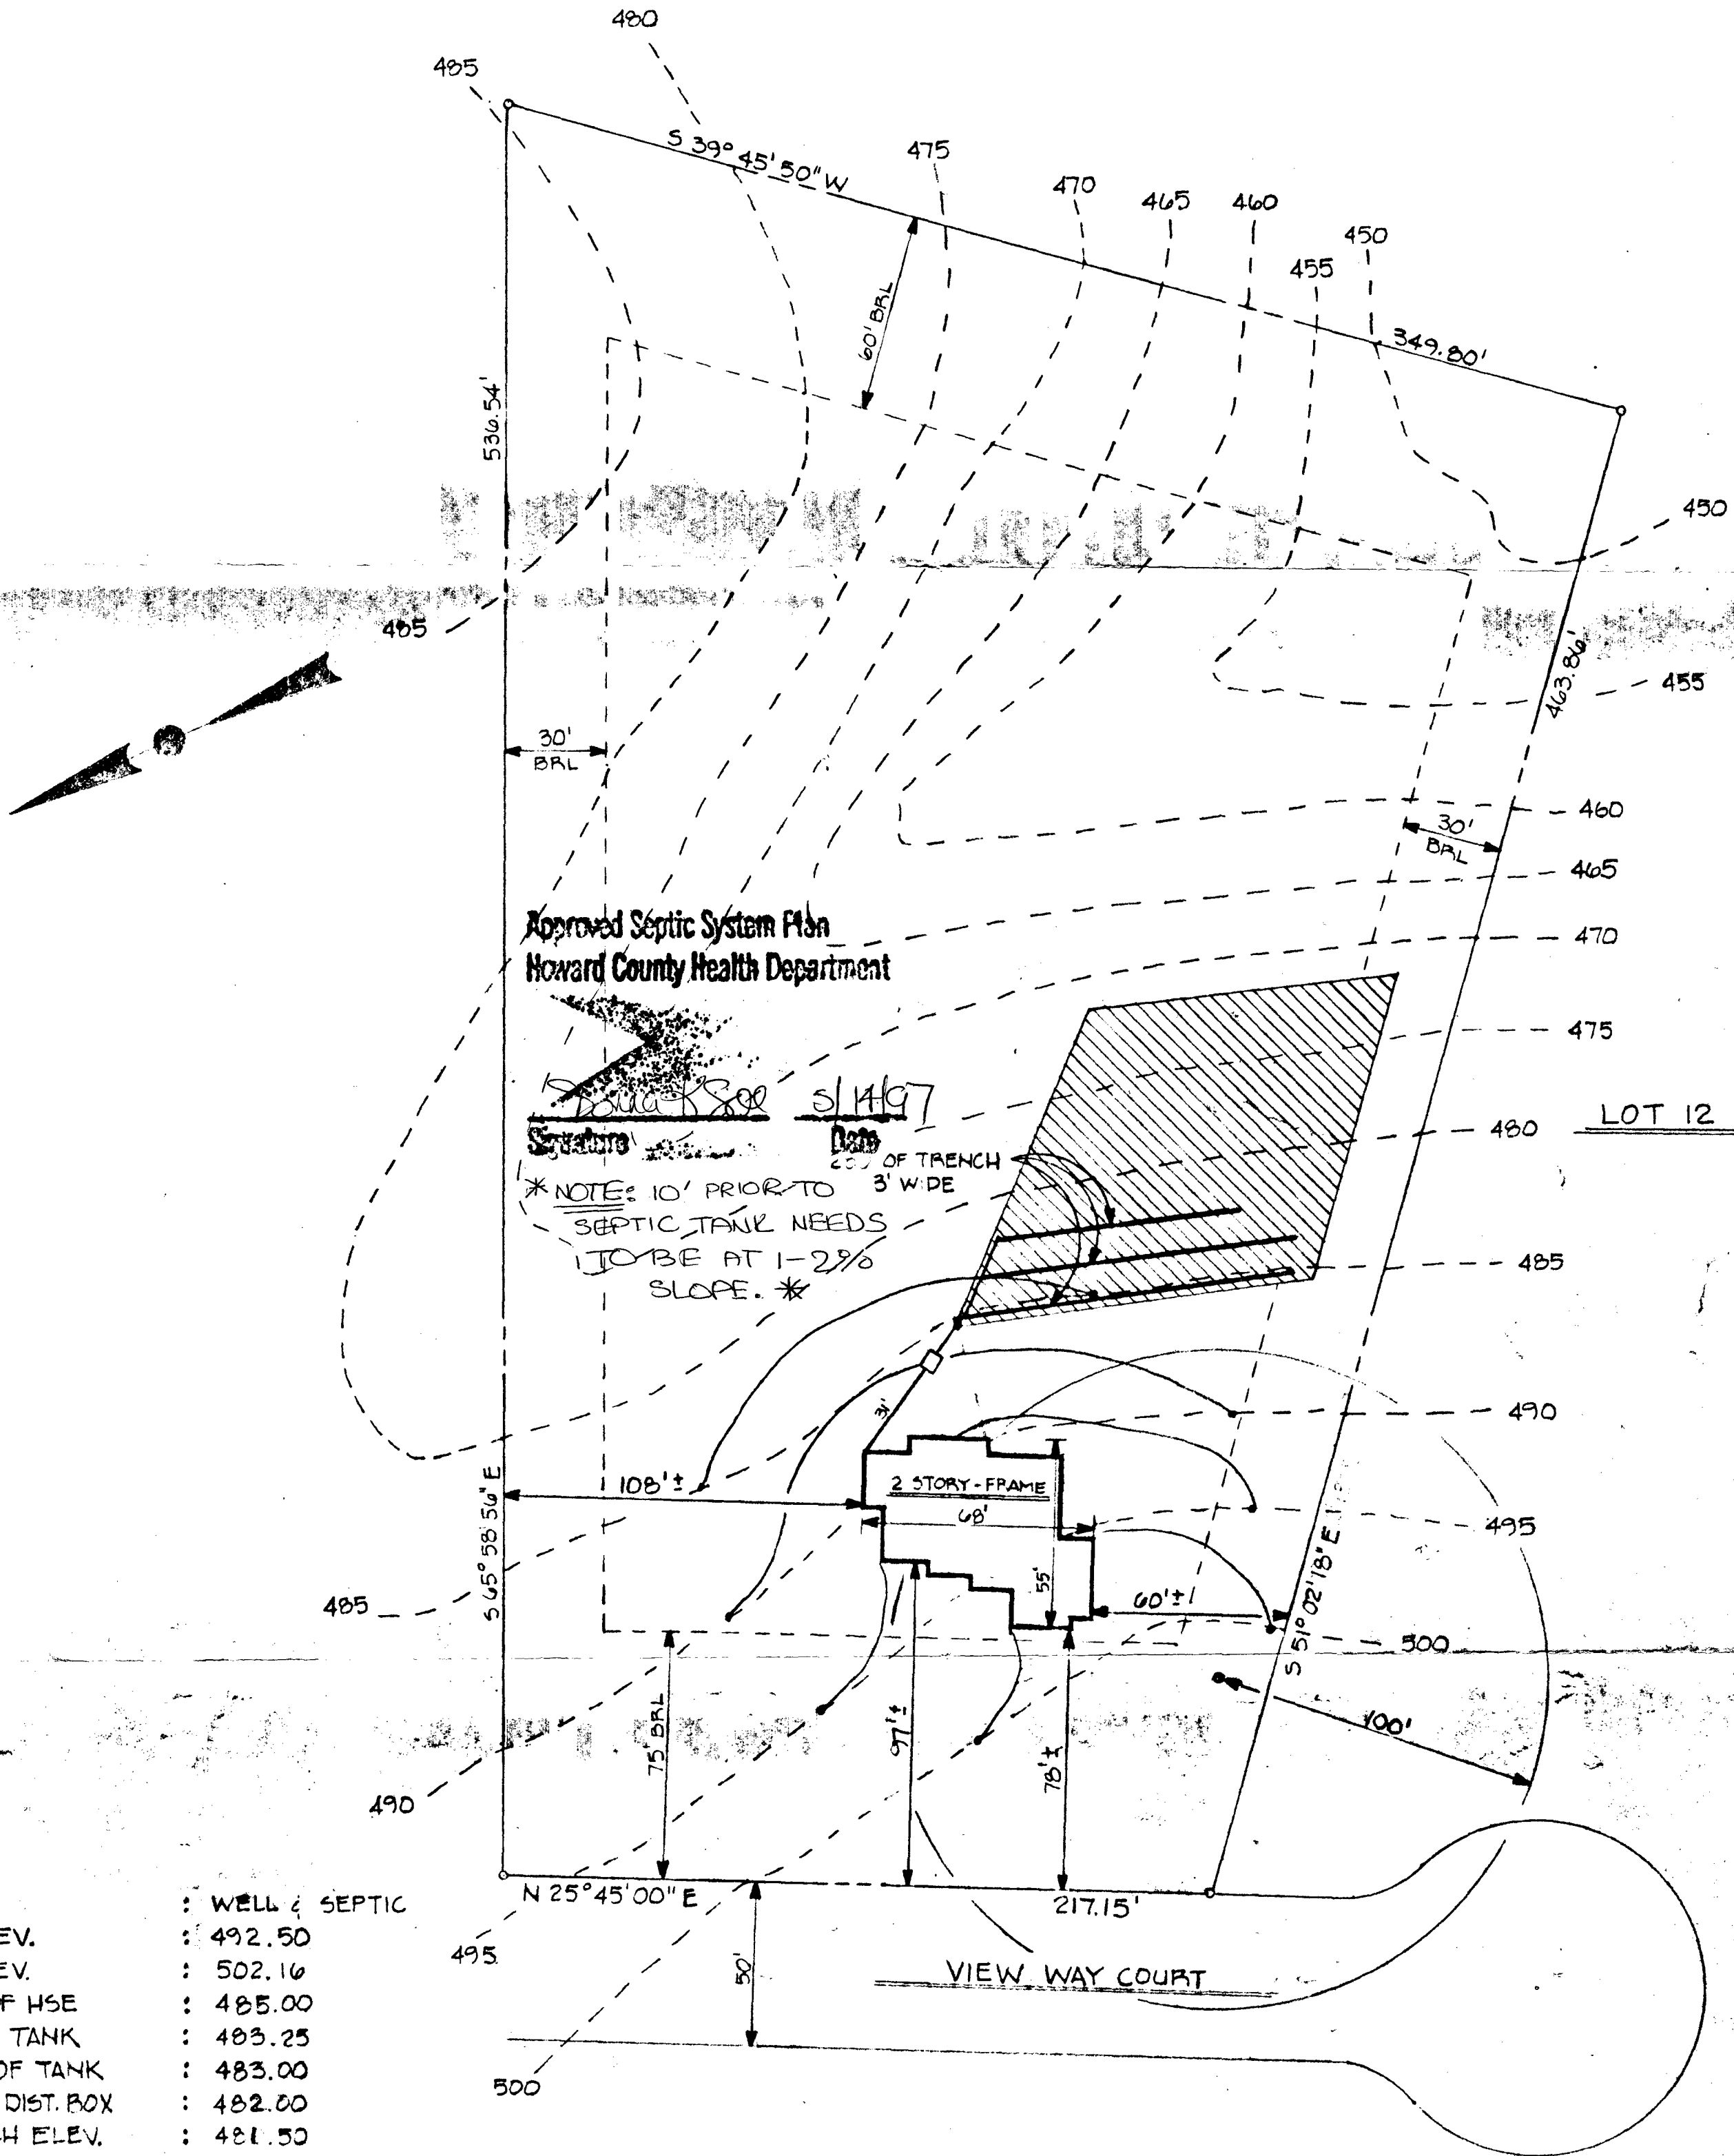

UTILITIES	: WELL & SEPTIC
BSMT. ELEV.	: 492.50
1 ST FL. ELEV.	: 502.16
INV. OUT OF HSE	: 485.00
INV. INTO TANK	: 483.25
INV. OUT OF TANK	: 483.00
INV. INTO DIST. BOX	: 482.00
1 ST TRENCH ELEV.	: 481.50
EX. GRADE @ S.T.	: 486.00
EX. GRADE @ D.B.	: 483.50
EX. GRADE @ TRENCH	: 485.00
ELEV. @ WELL	: 501.00

SINGLE FAMILY RESIDENCE

LOT 11
THE WARFIELDS
PLAT C.M.P. NO. 9586
5TH ELECTION DISTRICT
TAX MAP 27
PARCEL 56 & 114
APRIL 2, 1997

CONTACT: TRADITION HOMES
(410) 531-9203