

INDICATE NORTH - NAME ADJOINING ROADWAY AS BASE LINE

Woodsdale Road

SEPTIC TANK LEVEL OK - 1250 gal CLEANOUTS one in line, one on st.

DISTRIBUTION BOX LEVEL OK

DRAIN FIELD/TITLE DEPTH

1	2	3-4
8	8.5	9

 FT.

TRENCH WIDTH 3 FT.

INLET DEPTH

1	2	3-4
6	6.5	7

 FT.

EFFECTIVE GRAVEL DEPTH 2 FT.

TOTAL LENGTH

① 70	② 60
③ 60	④ 50

 FT. → 240' total

NUMBER OF TRENCHES 4

~~CONCRETE~~ BOTTOM AREA 720 SQ. FT.

DRYWALL INSIDE DIAMETER — FT.

EFFECTIVE DEPTH BELOW INLET — FT.

ABSORBENT AREA 720 SQ. FT.

REMARKS: 8/6/96 Final - OK to cover all work. JKS

DATE SYSTEM APPROVED 8/6/96

INSPECTOR Donna K. Sore

APPLICATION

SEWAGE DISPOSAL TESTING

STATE OF MARYLAND - DEPARTMENT OF HEALTH AND MENTAL HYGIENE

HOWARD COUNTY HEALTH DEPARTMENT
ENVIRONMENTAL HEALTH SERVICES
P. O. BOX 476 ELLICOTT CITY, MARYLAND 21043
TELEPHONE 992-2330

A 41132
P _____

DISTRICT 4TH

DATE ~~December 18, 1987~~
FEB 26 1988

*5/11/88
perc OK'd
perm approved*

TO: THE COUNTY HEALTH OFFICER
ELLICOTT CITY, MARYLAND

I HEREBY APPLY FOR THE NECESSARY TEST IN ORDER TO CONSTRUCT (OR RECONSTRUCT) A SEWAGE DISPOSAL SYSTEM.

PROPERTY OWNER C. Oliver Goldsmith, et ux Richard M. Hoffmann

ADDRESS Route 27, Longwood Farm, Glenwood, MD 21737 PHONE 301-442-2121

PROPERTY LOCATION: Wellington Sect 1 Area 1 LOT 26 Preliminary
SUBDIVISION Longwood Farm LOT NO. 23 Sec. 1

ROAD AND DESCRIPTION Southwest Quadrant of intersection of Roxbury Mills Rd. (Rt. 97) and
Union Chapel Road 2813 Woodside Road **BLDG. PERMIT SIGNED**
AND RETURNED 4-22-96

SIZE OF LOT 3+ Acres TYPE BLDG. SFD Residential - 4 BRMS
(NUMBER OF BEDROOMS) *
* Undetermined at this time

THE SYSTEM INSTALLED UNDER THIS APPLICATION IS ACCEPTABLE ONLY UNTIL PUBLIC FACILITIES BECOME AVAILABLE. I FULLY UNDERSTAND THE

FEE CONNECTED WITH THE FILING OF THIS PERC TEST APPLICATION IS NON-REFUNDABLE UNDER ANY CIRCUMSTANCES. I ALSO AGREE TO COMPLY

WITH ALL MOSMA REQUIREMENTS IN TESTING THIS LOT. SECURITY DEVELOPMENT CORP
Boyd St to Bush V.P.
(SIGNATURE OF APPLICANT)

APPROVED BY _____ FOR _____ DATE _____

REJECTED BY _____ FOR _____ DATE _____

HOLD PENDING FURTHER TESTS _____ DATE _____

REASONS FOR REJECTION OR HOLDING for field located holes SFD plan

THIS IS NOT A PERMIT

C1 7696

SEQUENCE NO. (DENV USE ONLY)

STATE OF MARYLAND WELL COMPLETION REPORT

FILL IN THIS FORM COMPLETELY PLEASE PRINT OR TYPE

THIS REPORT MUST BE SUBMITTED WITHIN 45 DAYS AFTER WELL IS COMPLETED.

COUNTY NUMBER A 41132

ST/CO USE ONLY DATE RECEIVED

DATE WELL COMPLETED

Depth of Well

PERMIT NO. FROM "PERMIT TO DRILL WELL"

DATE RECEIVED grid

DATE WELL COMPLETED grid: 05/31/93

Depth of Well grid: 22 005 26 (TO NEAREST FOOT)

PERMIT NO. grid: 40-92-0321

OWNER: HOFFMAN RICHARD; STREET OR RFD: last name first name; TOWN: Glenwood; SUBDIVISION: WELLINGTON; SECTION; LOT 26

WELL LOG

Not required for driven wells STATE THE KIND OF FORMATIONS PENETRATED, THEIR COLOR, DEPTH, THICKNESS AND IF WATER BEARING

Table with columns: DESCRIPTION (Use additional sheets if needed), FEET (FROM, TO), Check if water bearing. Includes handwritten entries: SANDSTONE 0-15, GRAY MICR ROCK 15-205.

GROUTING RECORD

WELL HAS BEEN GROUTED (yes Y, no N); TYPE OF GROUTING MATERIAL: CEMENT CM, BENTONITE CLAY BC; NO. OF BAGS 5, NO. OF POUNDS 470; GALLONS OF WATER 30; DEPTH OF GROUT SEAL (to nearest foot) from 0 to 14 ft.

CASING RECORD

MAIN CASING TYPE: SF; Nominal diameter top (main) casing (nearest inch): 6; Total depth of main casing (nearest foot): 22.

OTHER CASING (if used) diameter: inch, depth: (feet) from to

SCREEN RECORD

screen type or open hole: HO; insert appropriate code below: HO (OPEN HOLE); SLOT SIZE 1, 2, 3; DIAMETER OF SCREEN (NEAREST INCH) grid: 56 to 60

C2

DEPTH (nearest ft.) grid: 1 HO 21 205 21

- A A WELL WAS ABANDONED AND SEALED WHEN THIS WELL WAS COMPLETED
E ELECTRIC LOG OBTAINED
P TEST WELL CONVERTED TO PRODUCTION WELL

I HEREBY CERTIFY THAT THIS WELL HAS BEEN CONSTRUCTED IN ACCORDANCE WITH COMAR 26.04.04 "WELL CONSTRUCTION" AND IN CONFORMANCE WITH ALL CONDITIONS STATED IN THE ABOVE CAPTIONED PERMIT...

DRILLERS IDENT. NO. 238; DRILLERS SIGNATURE (MUST MATCH SIGNATURE ON APPLICATION)

SITE SUPERVISOR (sign. of driller or journeyman responsible for sitework if different from permittee)

GRAVEL PACK IF WELL DRILLED WAS FLOWING WELL INSERT F IN BOX 68

OEP USE ONLY (NOT TO BE FILLED IN BY DRILLER) T (E.R.O.S.), WQ (74, 75, 76); TELESCOPE CASING, LOG INDICATOR, OTHER DATA


C3

PUMPING TEST; HOURS PUMPED (nearest hour) 3; PUMPING RATE (gal. per min. to nearest gal.) 845; METHOD USED TO MEASURE PUMPING RATE Bucket; WATER LEVEL (distance from land surface) BEFORE PUMPING 36; WHEN PUMPING 43; TYPE OF PUMP USED (for test) S submersible


PUMP INSTALLED

DRILLER WILL INSTALL PUMP (CIRCLE) (YES or NO) YES; IF DRILLER INSTALLS PUMP, THIS SECTION MUST BE COMPLETED FOR ALL WELLS EXCEPT HOME USE; TYPE OF PUMP INSTALLED PLACE (A,C,J,P,R,S,T,O) IN BOX - SEE ABOVE: S; CAPACITY: GALLONS PER MINUTE (to nearest gallon) grid: 31 to 35; PUMP HORSE POWER grid: 37 to 41; PUMP COLUMN LENGTH (nearest ft.) grid: 43 to 47; CASING HEIGHT (circle appropriate box and enter casing height) (+) above, (-) below; LAND SURFACE (nearest foot) grid: 50 to 51


LOCATION OF WELL ON LOT: SHOW PERMANENT STRUCTURE SUCH AS BUILDING, SEPTIC TANKS, AND/OR LANDMARKS AND INDICATE NOT LESS THAN TWO DISTANCES (MEASUREMENTS TO WELL)

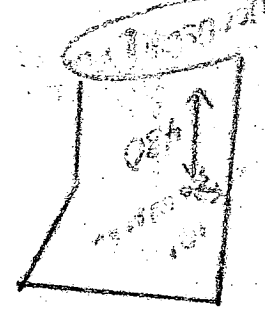

THIS LOCATION DRAWING IS OF BENEFIT TO A CONSUMER ONLY INsofar AS IT IS REQUIRED BY A LENDER OR TITLE INSURANCE COMPANY, OR ITS AGENTS, IN CONNECTION WITH FINANCING THE PROPERTY SHOWN HEREON. THIS DRAWING IS NOT TO BE RELIED UPON FOR THE ESTABLISHMENT OF PROPERTY LINES OR THE CONSTRUCTION OF IMPROVEMENTS SUCH AS FENCES, GARAGES, OR BUILDING ADDITIONS. THIS DRAWING SHOWS THE LOT CONFIGURATION AS CURRENTLY RECORDED, BEING SUFFICIENT FOR SETTLEMENT PURPOSES, BUT BEING INSUFFICIENT FOR THE SETTING OF PROPERTY CORNER PINS ON THE GROUND.

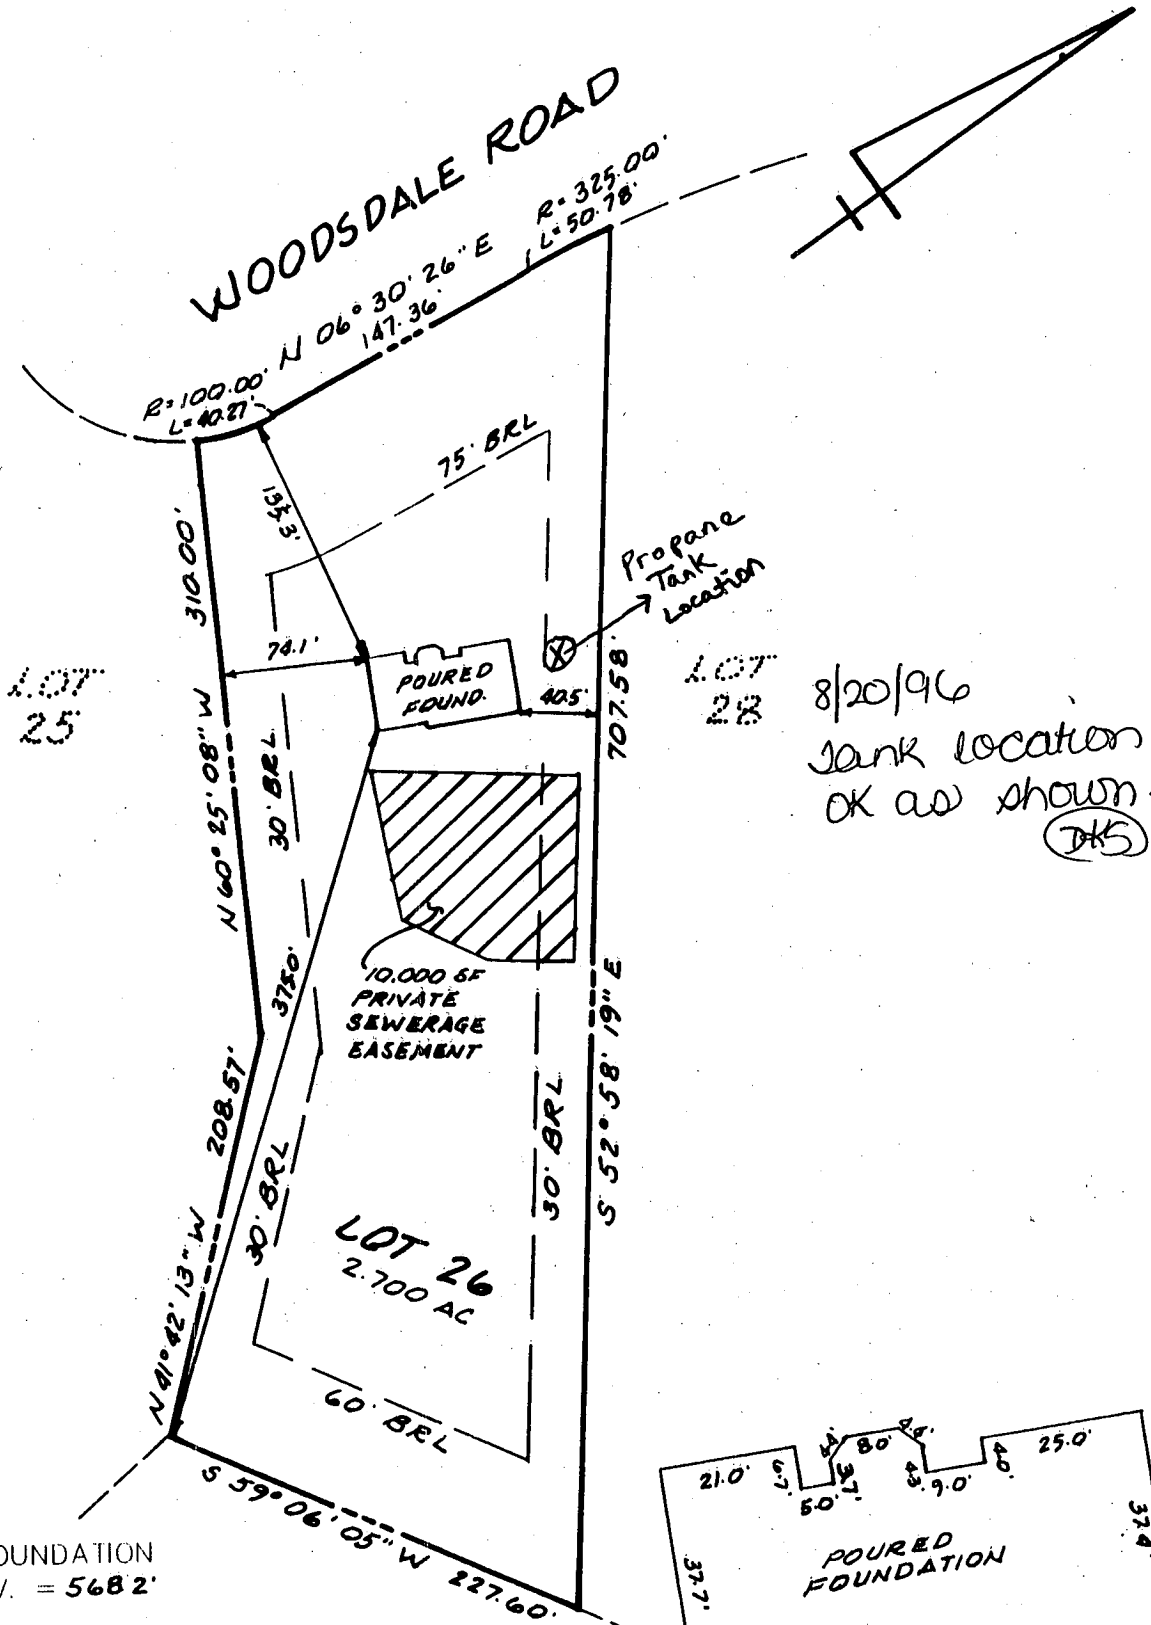

8/20/96
Tank location
OK as shown.
DKS

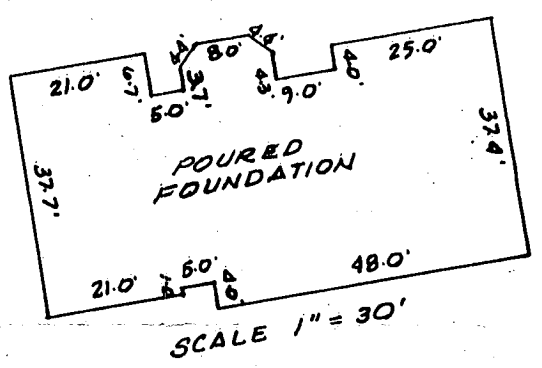

TOP OF FOUNDATION
WALL ELEV. = 568.2'

SURVEYOR'S CERTIFICATE

I HEREBY CERTIFY THAT THE LOCATION DRAWING SHOWN HEREON IS CORRECT TO THE BEST OF MY KNOWLEDGE AND BELIEF; THAT THE IMPROVEMENTS HAVE BEEN LOCATED AS THE RESULT OF A FIELD SURVEY, AND THAT THERE ARE NO VISIBLE ENCROACHMENTS UNLESS SHOWN. THE PROPERTY DOES NOT LIE WITHIN A FLOOD HAZARD AREA ON THE FEMA F.I.R.M. IDENTIFIED BELOW. AT THE WRITTEN REQUEST OF THE PURCHASER, NO PROPERTY CORNER MARKERS HAVE BEEN SET.

[Signature]
PETER J. DARE
MD. PROPERTY LINE SURVEYOR #224



**LOCATION DRAWING
WELLINGTON
SECTION ONE
AREA ONE
LOT 26**


2813 WOODSDALE ROAD

RECORD PLAT No. 8947
FEMA FIRM No. 240044 0014 B
DATED DECEMBER 4, 1986


TSA GROUP, INC.
planning • architecture • engineering • surveying
8480 BALTIMORE NATIONAL PIKE SUITE 418
ELLCOTT CITY, MARYLAND 21043
(410) 465-6105

4TH ELECTION DISTRICT
HOWARD COUNTY, MARYLAND
SCALE: 1" = 100' DATE: 6-4-96

SS 11/18 - 3 P. 11/2: 05

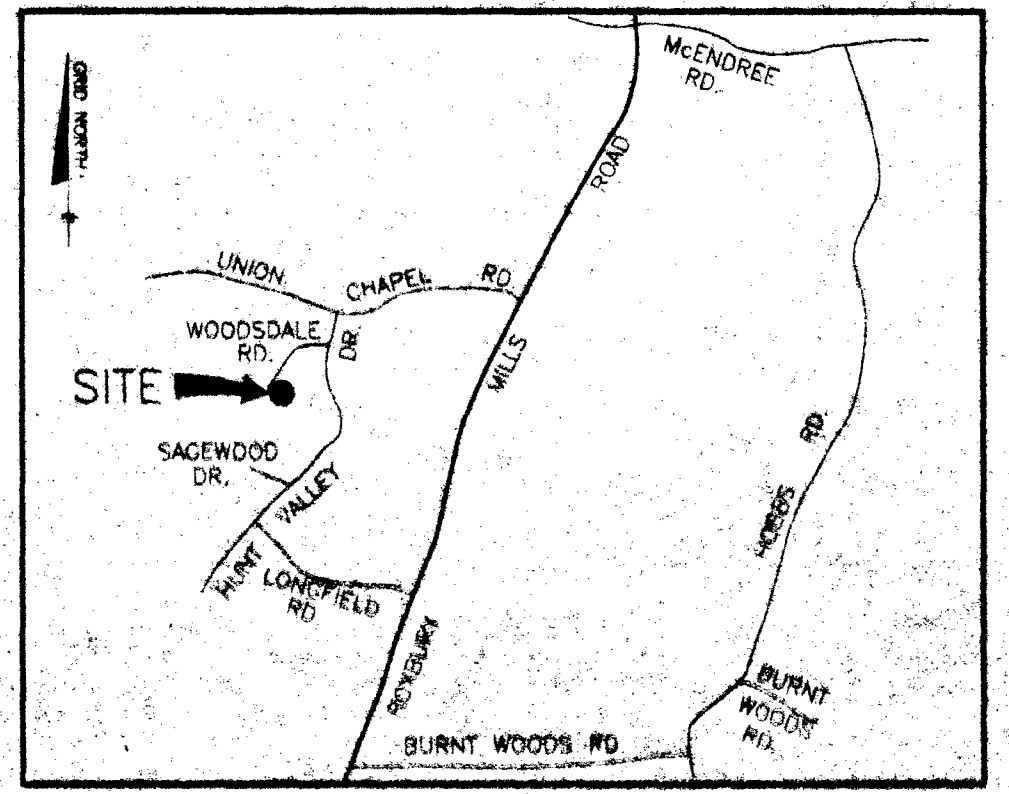

VICINITY MAP
SCALE: 1" = 2000'

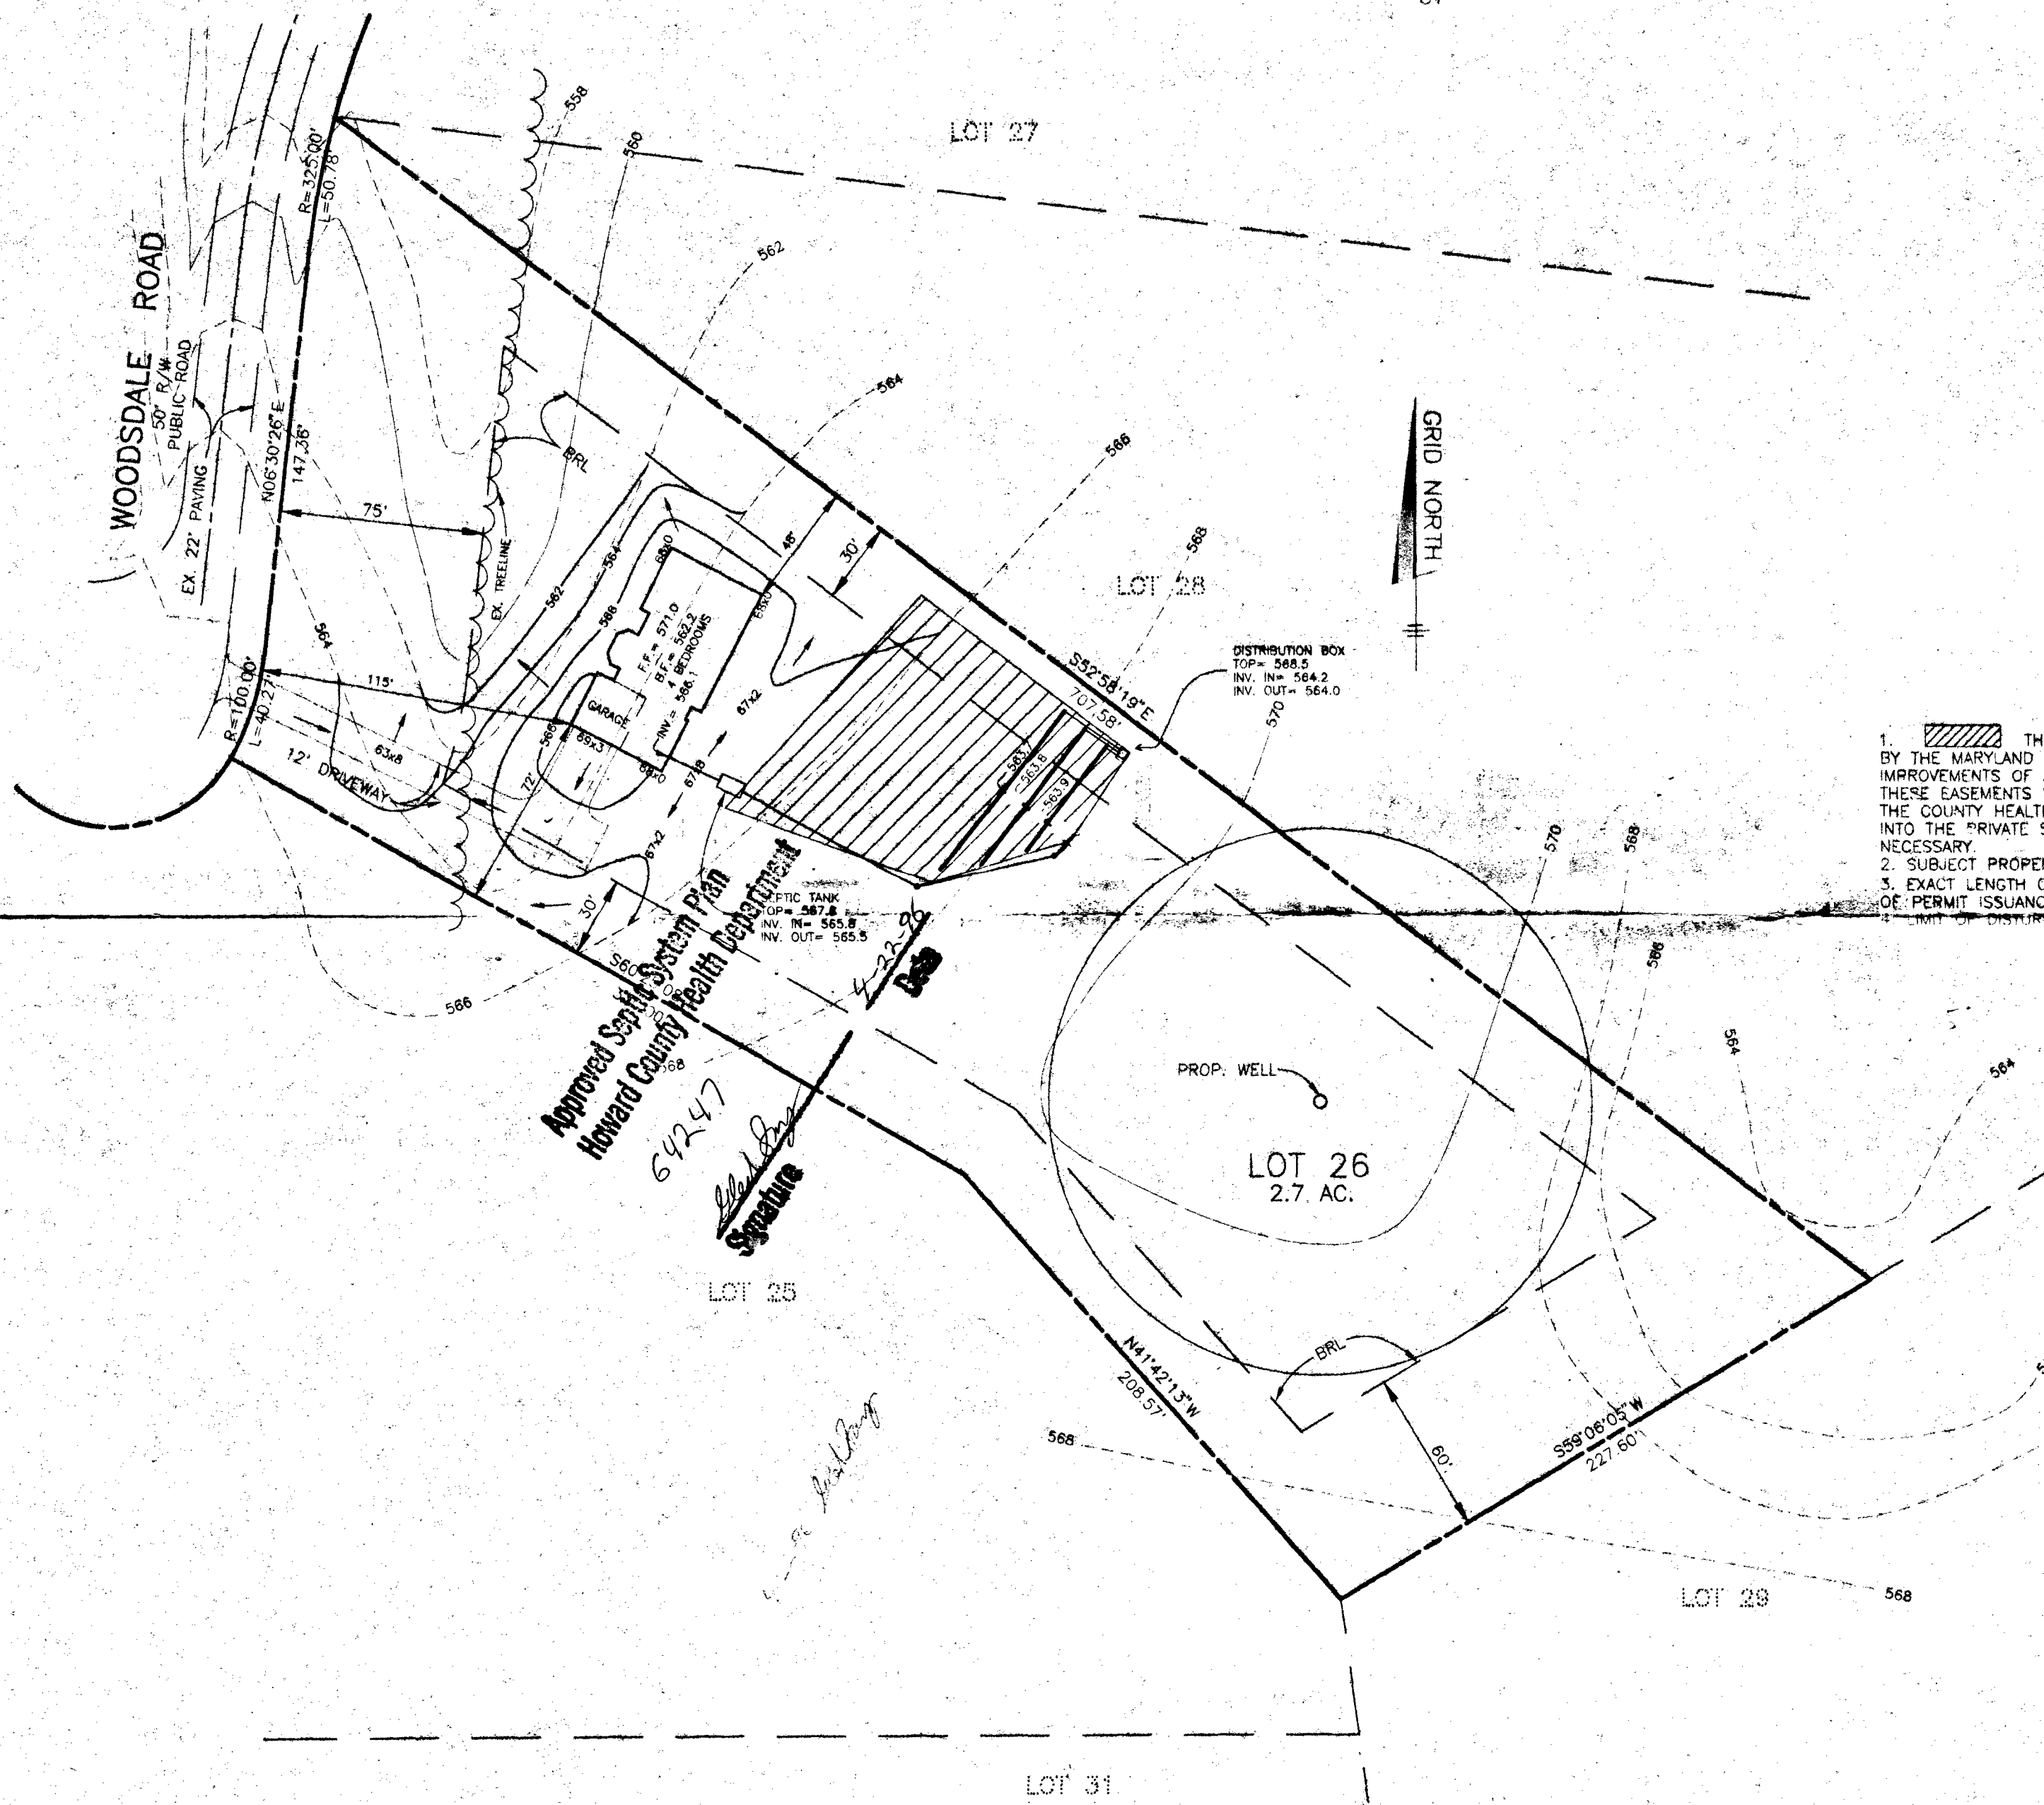

GRID NORTH

GENERAL NOTES

1. THIS AREA DESIGNATES A PRIVATE SEWAGE EASEMENT OF 10,000 SF± AS REQUIRED BY THE MARYLAND STATE DEPARTMENT OF THE ENVIRONMENT FOR INDIVIDUAL SEWAGE DISPOSAL. IMPROVEMENTS OF ANY NATURE IN THIS AREA ARE RESTRICTED UNTIL PUBLIC SEWER IS AVAILABLE. THESE EASEMENTS SHALL BECOME NULL AND VOID UPON CONNECTION TO A PUBLIC SEWER SYSTEM. THE COUNTY HEALTH OFFICER SHALL HAVE THE AUTHORITY TO GRANT VARIANCES FOR ENCROACHMENTS INTO THE PRIVATE SEWAGE EASEMENT. RECORDATION OF A MODIFIED SEWAGE EASEMENT SHALL NOT BE NECESSARY.
2. SUBJECT PROPERTY IS ZONED: R
3. EXACT LENGTH OF SEPTIC TRENCHES TO BE DETERMINED BY THE HEALTH DEPARTMENT AT THE TIME OF PERMIT ISSUANCE.

Approved Septic System Plan
 Howard County Health Department
 64247
[Signature]

[Handwritten signature]

PLOT PLAN
WELLINGTON
 LOT 26

PLAT NO. 8947
 4th ELECTION DISTRICT
 HOWARD COUNTY, MARYLAND

SCALE: 1" = 50'

DATE: MARCH 29, 1996

T.S.A. GROUP INC.
 8480 BALTIMORE NATIONAL PIKE, SUITE 41B
 ELLICOTT CITY, MARYLAND 21043
 (410) 465-6105