

SEPTIC TANK LEVEL OK 1500 gal CLEANOUTS OK

DISTRIBUTION BOX LEVEL OK baffle is in

DRAIN FIELD/TITLE DEPTH 7 FT. TRENCH WIDTH 2' FT. INLET DEPTH 3 FT.

EFFECTIVE GRAVEL DEPTH 4' FT. TOTAL LENGTH (1) 76' (2) 75' (3) 75' = 226 FT.

NUMBER OF TRENCHES 3 ONE SIDEWALL/BOTTOM AREA 904 SQ. FT. $\frac{226 \times 4}{1}$

DRYWALL INSIDE DIAMETER FT. EFFECTIVE DEPTH BELOW INLET FT.

ABSORBENT AREA SQ. FT.

REMARKS: 9-12-94 OK to cover house to tank and finish trench 1 and 2. ACS

9-13-94 OK to cover all work final sum

9-13-94 WPI OK Ann

DATE SYSTEM APPROVED 9-13-94 INSPECTOR Army M. Miller

APPLICATION

SEWAGE DISPOSAL TESTING

STATE OF MARYLAND - DEPARTMENT OF HEALTH AND MENTAL HYGIENE

A 41722

P _____

HOWARD COUNTY HEALTH DEPARTMENT
ENVIRONMENTAL HEALTH SERVICES
P. O. BOX 473 ELLICOTT CITY, MARYLAND 21043
TELEPHONE: 992-2330

DISTRICT 3RD.

DATE FEB. 16, 1988

TO: THE COUNTY HEALTH OFFICER
ELLICOTT CITY, MARYLAND

I, HEREBY, APPLY FOR THE NECESSARY TEST IN ORDER TO CONSTRUCT (OR RECONSTRUCT) A SEWAGE DISPOSAL SYSTEM.

PROPERTY OWNER ALBEE FARUS Christian and Helene ~~SEBASTIAN~~ HAKHAM

ADDRESS 12150 ROUTE 99 MARRIOTTVILLE MD. 21104 PHONE MD 964-3518

PROPERTY LOCATION: N/3 MD. ROUTE 99 WEST OF HEURYTON ROAD

SUBDIVISION ALBEE FARM LOT NO. 20

ROAD AND DESCRIPTION ROAD 'A' (12244 Woodford Drive)

SIZE OF LOT 3.5 Acs TYPE BLDG. SFD
(NUMBER OF BEDROOMS)

THE SYSTEM INSTALLED UNDER THIS APPLICATION IS ACCEPTABLE ONLY UNTIL PUBLIC FACILITIES BECOME AVAILABLE. I FULLY UNDERSTAND THE FEE CONNECTED WITH THE FILING OF THIS PERC TEST APPLICATION IS NON-REFUNDABLE UNDER ANY CIRCUMSTANCES. I ALSO AGREE TO COMPLY WITH ALL M.O.S.H.A. REQUIREMENTS IN TESTING THIS LOT.

Frank D. Baker

(SIGNATURE OF APPLICANT)

APPROVED BY _____ FOR _____ DATE _____

REJECTED BY _____ FOR _____ DATE _____

HOLD PENDING FURTHER TESTS _____ DATE _____

REASONS FOR REJECTION OR HOLDING 7-15-88 Per Satisfactory - Hold for Subal. Plat. S. Clark

BLDG. PERMIT SIGNED

AND RETURNED 7/25/94

Serial # 53503

SFD - 5 Bms


THIS IS NOT A PERMIT

SOIL PROFILE

10' AP
 Yellow Br
 Silty Clay
 LOAM
 <10%
 FRAGS

2.5-3 TAN/light
 BROWN
 Silty
 LOAM
 Highly
 Micaceous
 20-25%
 FRAGS

14'

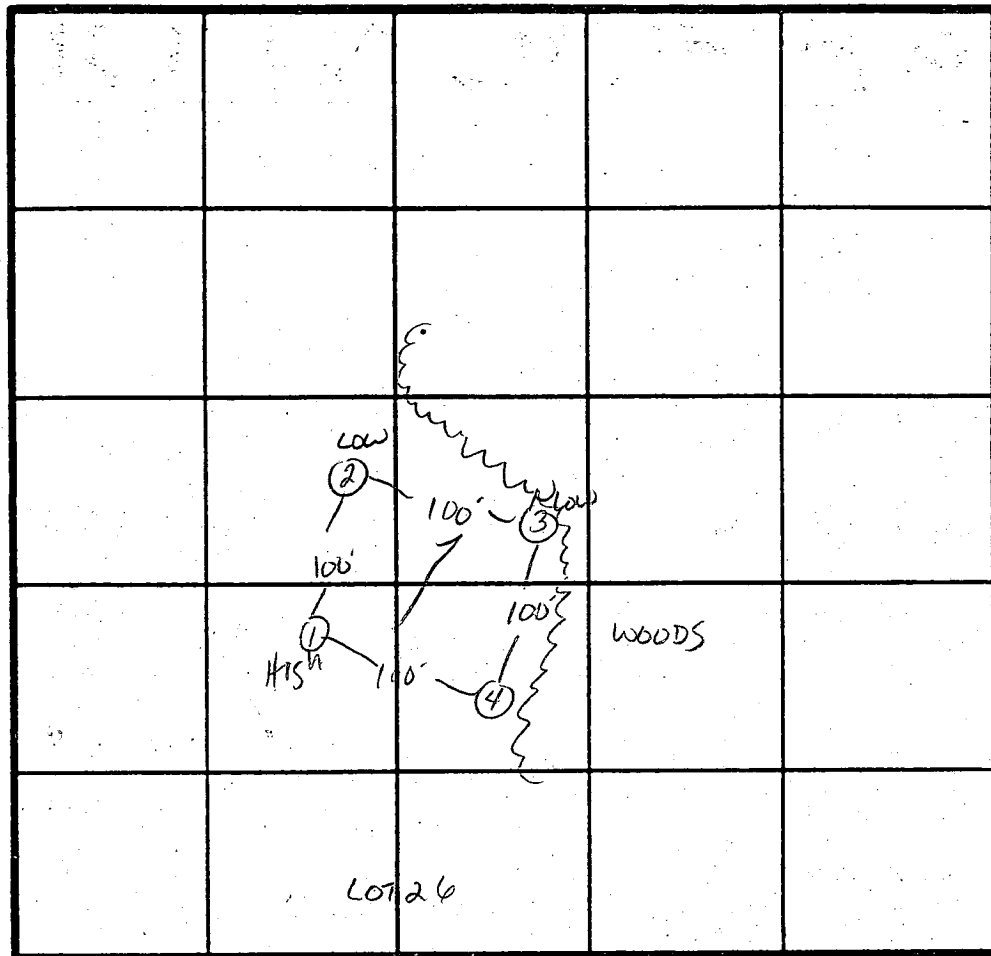

\bar{x} Perc 2 min
 160 #/BR
 Inlet 3'
 Bottom 8'

INDICATE NORTH - NAME ADJOINING ROADWAY AS BASE LINE.

R+99


DATE	TEST NO.	DEPTH	PRE-WET		TEST - 1" DROP		TIME
			START	STOP	START	STOP	
7/15/88	1S M	3'	9:20	9:21	9:21	9:23	2min
		7.5'	9:20	9:21	9:21	9:23	2min
	1V	14'	UNIFORM	Soil below 2.5-30'			
	2S V	30'	9:24	9:25	9:25	9:27	2min
	13'	UNIFORM	Soil below 3.0'				
	3S V	3.5'	9:26	9:27	9:27	9:29	2min
	12'	UNIFORM	Soil below 30'				
	4V	12'	UNIFORM	Soil below 2.5'			

REMARKS Holes APPROX. PCAT

TYPE OF SOIL Glendg

TESTED BY S. Abel ALSO PRESENT SKIP, JOHN MRS BAKPL

EH-12-1079

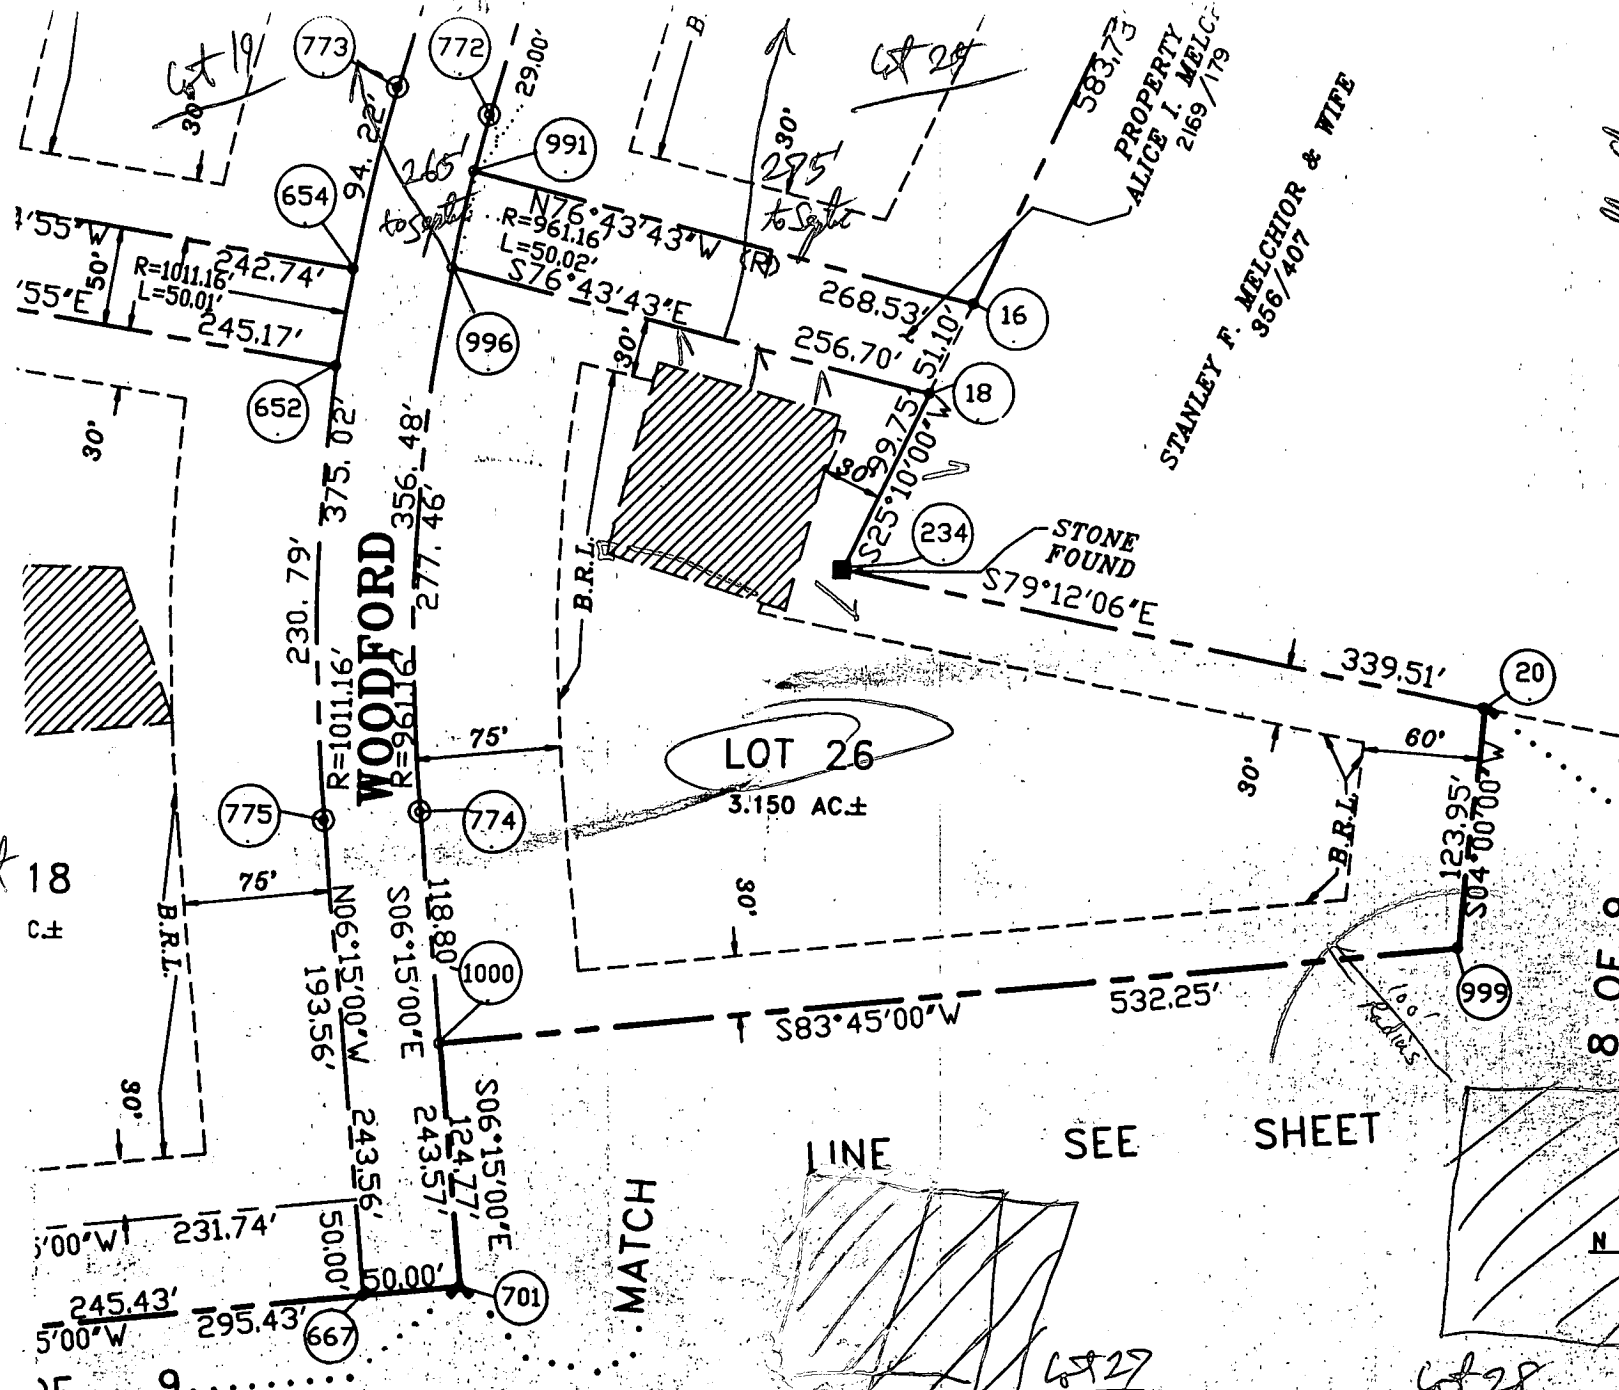

PROPERTY
ALICE I. MELCHOR
2169/179

STANLEY F. MELCHOR & WIFE
956/407

Spring Valley Chase
Segment Fend

LOT 26
3.150 AC±

WOODFORD

MATCH


LINE SEE SHEET

8 OF 9

N 544.250 E 819.500

AND DEVELOPER
ON SUSAN D. BAKER
RKWAY 12150 MARYLAND ROUTE 99
MARRIOTTVILLE, MARYLAND 21104

FISHER, COLLINS & CARTER,
CIVIL ENGINEERING CONSULTANTS
LAND SURVEYORS
8388 COURT AVE. - ELLICOTT CITY, MD 21043

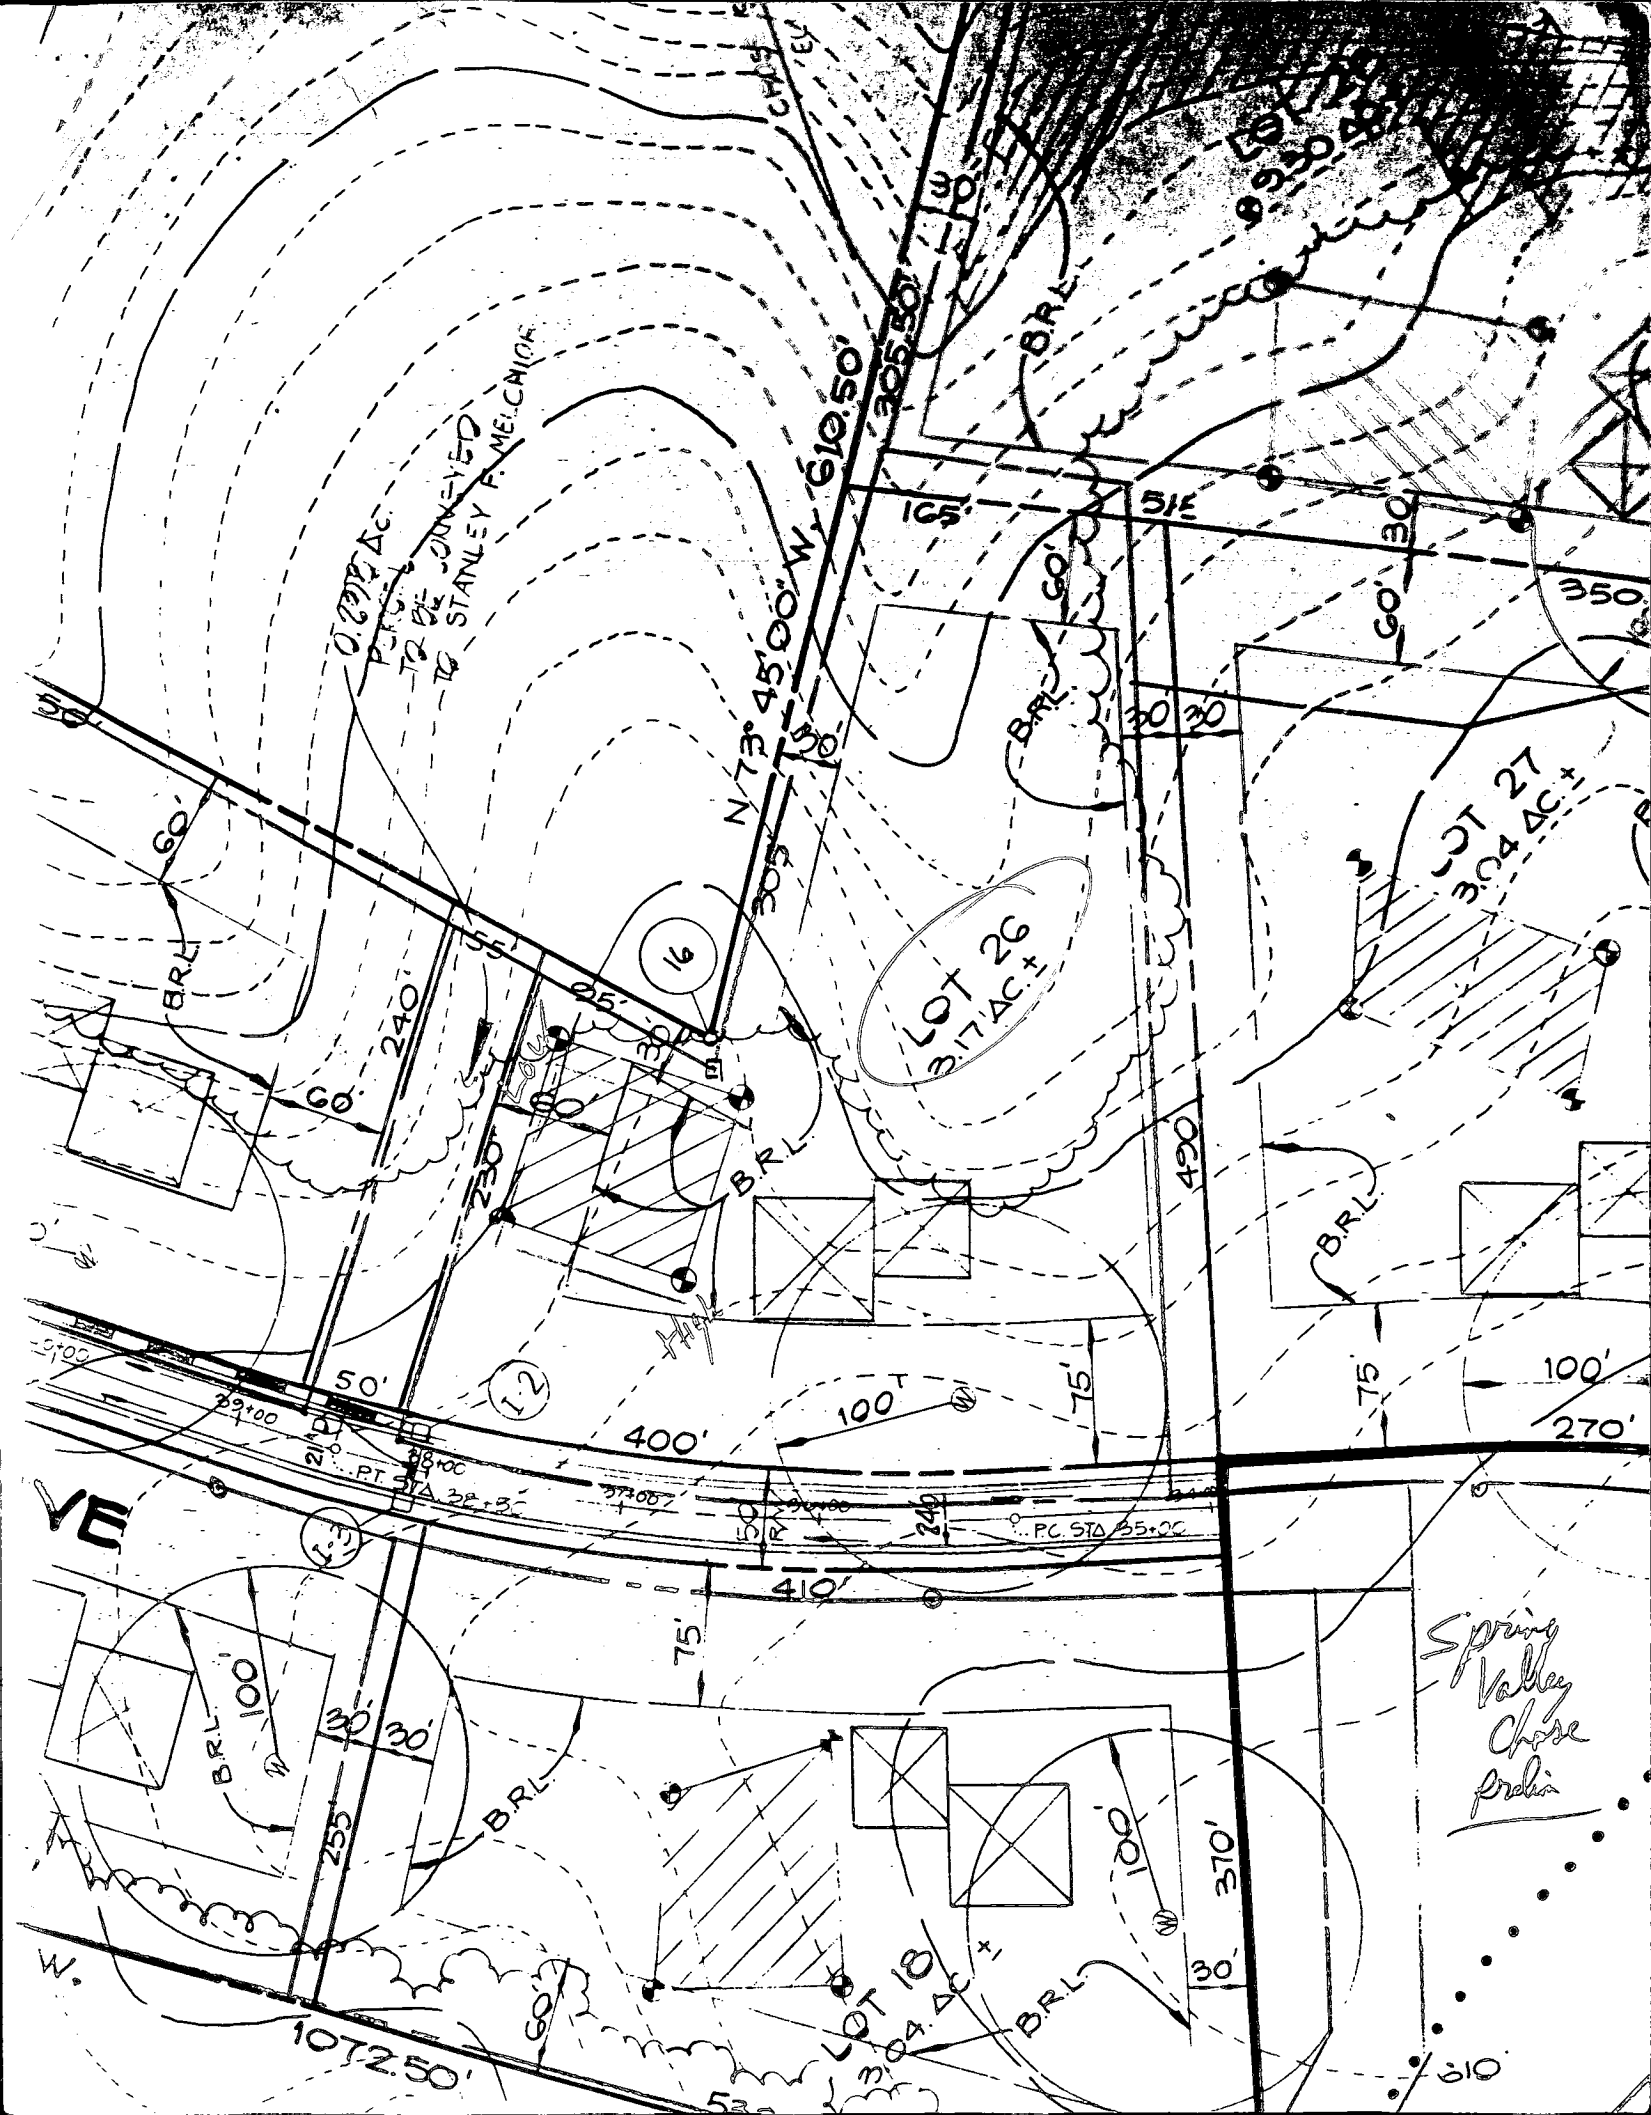

0.2972 AC.
PART OF
TO BE CONVEYED
TO STANLEY F. MELCHIOR

LOT 26
3.17 AC ±

Spring
Valley
Chase
Prelim

W.

NE

1072.50'

LOT 18
3.04 AC ±

310'

100'
270'

75'

430'

30' 30'

51'

305.50'

610.50'

N 73° 45' 00\"/>

305'

305'

277.46'

256.70'

SEPTIC AREA

ACCESS

PROP 4' WOOD FENCE

91'

55'

184'

82'

82'

722m

2003-71

POOL

SCALE: 1"=60'

FOR #59493

OK FOR SIGNATURE
PER C.O. 9/13/94
OK

33951

OK AS SHOWN

5/10/95

53225'

12375'

C1 **5160** SEQUENCE NO. (DENV USE ONLY)
 1 2 3 4 5 6
 (THIS NUMBER IS TO BE PUNCHED IN COLS. 3-6 ON ALL CARDS)

STATE OF MARYLAND
WELL COMPLETION REPORT
 FILL IN THIS FORM COMPLETELY
 PLEASE PRINT OR TYPE

THIS REPORT MUST BE SUBMITTED WITHIN
 45 DAYS AFTER WELL IS COMPLETED.
 COUNTY NUMBER **A 41723**

ST/CO USE ONLY DATE Received [] [] [] [] [] [] DATE WELL COMPLETED **05 23 74** Depth of Well **400** (TO NEAREST FOOT) PERMIT NO. **HC-94-CC82**

OWNER **Dennis** last name **Richard** first name
 STREET OR RFD **W. 11th St.** TOWN **West Friendship**
 SUBDIVISION **Swain Valley Church** SECTION **1** LOT **26**

WELL LOG
 Not required for driven wells
 STATE THE KIND OF FORMATIONS PENETRATED, THEIR COLOR, DEPTH, THICKNESS AND IF WATER BEARING

DESCRIPTION (Use additional sheets if needed)	FEET		Check if water bearing
	FROM	TO	
SAND	0	39	
GRAY Mica Rock	39	400	

GROUTING RECORD
 WELL HAS BEEN GROUTED (Circle Appropriate Box) **Y** **N**
 TYPE OF GROUTING MATERIAL
 CEMENT **CM** BENTONITE CLAY **BC**
 NO. OF BAGS **12** NO. OF POUNDS **1128**
 GALLONS OF WATER **22**
 DEPTH OF GROUT SEAL (to nearest foot)
 from **0** ft. to **36** ft.
 (enter 0 if from surface)

CASING RECORD
 casing types insert appropriate code below
ST **CO**
 STEEL CONCRETE
PL **OT**
 PLASTIC OTHER
 MAIN CASING TYPE **ST** Nominal diameter top (main) casing (nearest inch) **6** Total depth of main casing (nearest foot) **40**

OTHER CASING (if used)
 diameter inch depth (feet) from to

SCREEN RECORD
 screen type or open hole insert appropriate code below
ST **BR** **HO**
 STEEL BRASS OPEN HOLE
PL **OT**
 PLASTIC OTHER

C2
 DEPTH (nearest ft.)
 1 **110** **41** **400**
 2
 3
 SLOT SIZE 1 2 3
 DIAMETER OF SCREEN (NEAREST INCH) from to

CIRCLE APPROPRIATE LETTER
A A WELL WAS ABANDONED AND SEALED WHEN THIS WELL WAS COMPLETED
E ELECTRIC LOG OBTAINED
P TEST WELL CONVERTED TO PRODUCTION WELL

I HEREBY CERTIFY THAT THIS WELL HAS BEEN CONSTRUCTED IN ACCORDANCE WITH COMAR 26.04.04 "WELL CONSTRUCTION" AND IN CONFORMANCE WITH ALL CONDITIONS STATED IN THE ABOVE CAPTIONED PERMIT, AND THAT THE INFORMATION PRESENTED HEREIN IS ACCURATE AND COMPLETE TO THE BEST OF MY KNOWLEDGE.

DRILLERS IDENT. NO. **24**

DRILLERS SIGNATURE (MUST MATCH SIGNATURE ON APPLICATION)

SITE SUPERVISOR (sign. of driller or journeyman responsible for sitework if different from permittee)

GRAVEL PACK IF WELL DRILLED WAS FLOWING WELL INSERT F IN BOX 68

OEP USE ONLY (NOT TO BE FILLED IN BY DRILLER)

T (E.R.O.S.) W Q
 70 72 74 75 76


TELESCOPE CASING LOG INDICATOR OTHER DATA

C3
PUMPING TEST
 HOURS PUMPED (nearest hour) **9**
 PUMPING RATE (gal. per min. to nearest gal.) **4**
 METHOD USED TO MEASURE PUMPING RATE **Bucket**
 WATER LEVEL (distance from land surface)
 BEFORE PUMPING **26**
 WHEN PUMPING **35**
 TYPE OF PUMP USED (for test)
A air **P** piston **T** turbine
C centrifugal **R** rotary **O** other (describe below)
J jet **S** submersible

PUMP INSTALLED
 DRILLER WILL INSTALL PUMP YES NO
 IF DRILLER INSTALLS PUMP, THIS SECTION MUST BE COMPLETED FOR ALL WELLS EXCEPT HOME USE
 TYPE OF PUMP INSTALLED PLACE (A,C,J,P,R,S,T,O) IN BOX - SEE ABOVE:
 CAPACITY: GALLONS PER MINUTE (to nearest gallon)
 PUMP HORSE POWER
 PUMP COLUMN LENGTH (nearest ft.)
 CASING HEIGHT (circle appropriate box and enter casing height)
 above } LAND SURFACE (nearest foot)
 below }


LOCATION OF WELL ON LOT
 SHOW PERMANENT STRUCTURE SUCH AS BUILDING, SEPTIC TANKS, AND/OR LANDMARKS AND INDICATE NOT LESS THAN TWO DISTANCES (MEASUREMENTS TO WELL)

See attached location

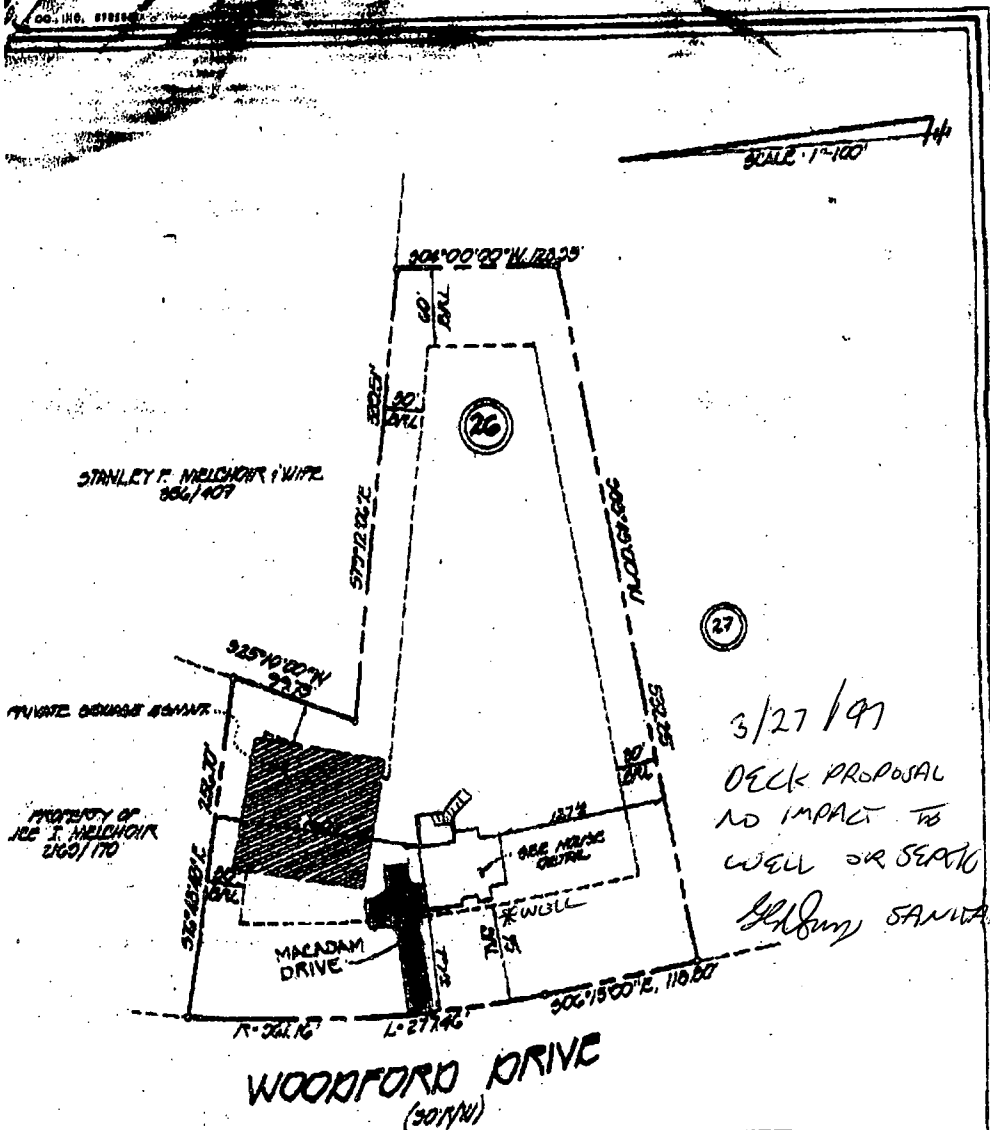

ORL BUILDING RESTRICTION LINE
TOP OF FINISH FLOOR ELEVATION - 672.1

NOTE: THIS PROPERTY IS NOT LOCATED
WITHIN A 100 YEAR FLOOD PLAIN.

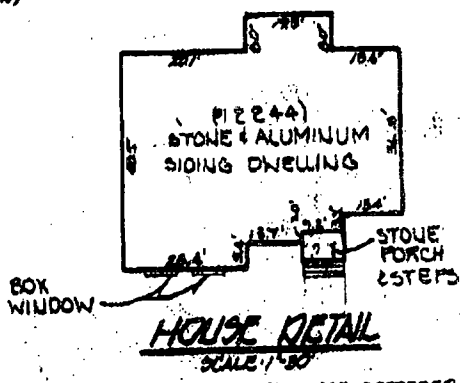

This is to certify that I have surveyed the property known as LOT 26 OF SPRING VALLEY CURVE, RECORDED AS
PLAT # 2400 AMONG THE LAND RECORDS OF HOWARD COUNTY, MARYLAND
for the purpose of locating the improvements thereon and the improvements are located as shown.
Signed this 17th day of FEBRUARY, 1997

THOMAS COLLINS & CARTER, INC.
CIVIL ENGINEERING CONSULTANTS & LAND SURVEYORS
507 BALTIMORE NATIONAL PARK DRIVE SW
CALVERT CITY, MARYLAND 20618
410-326-1234



This plat is not intended for use in
the establishment of property lines.