

9/3/96
Amey me

Tax ID - 04-351398

PERMIT

SEWAGE DISPOSAL SYSTEM

DEPARTMENT OF HEALTH AND MENTAL HYGIENE

INDEXED

P 570868

A 42807

DISTRICT 4th

DATE 8/21/96

DATE SYSTEM APPROVED 9/3/96

INSPECTOR [Signature]

HOWARD COUNTY HEALTH DEPARTMENT

BUREAU OF ENVIRONMENTAL HEALTH

461-9933 313-2640

Fogle's Septic Clean

IS PERMITTED TO INSTALL ☒ ALTER ☐

ADDRESS 558-R Obrecht Road Sykesville, MD 21784 PHONE 795-5674

SUBDIVISION Camden Downs LOT 6 ROAD 15631 Thistle Downs Court

PROPERTY OWNER Montgomery A. and Michelle D'Ambrosio

ADDRESS _____

SEPTIC TANK CAPACITY 1250 GALLONS

NUMBER OF BEDROOMS 4

240 SQUARE FEET PER BEDROOM

LINEAR FEET OF TRENCH REQUIRED 320

TRENCHES - Trench to be 3 feet wide. Inlet 4.5 feet below original grade. Bottom maximum depth 6.5 feet below original grade. Effective area begins at 4.5 feet below original grade. 2 feet of stone below distribution pipe.

LOCATION - Starting from the intersection of the 291.20' and the 469.92' lot lines, start the first trench 90' down the 291.20' lot line and 100' off this same lot line. Run trenches on contour toward the right rear (469.92') lot line. Maintain a minimum of 100' from the well.

NOTES - Best trench layout is 3 trenches 107' each, and high trench slightly higher than highest edge of sewage easement. No trench to exceed 100 feet in length. Provide 6" - 8" diameter cleanout and cap to grade or above on septic tank.

7/18/96 OK ALM

PLANS APPROVED BY Glen Savage DATE 7/3/96

VR

COVER NO WORK UNTIL INSPECTED AND APPROVED

NEITHER THE HOWARD COUNTY COUNCIL NOR THE HEALTH DEPARTMENT IS RESPONSIBLE FOR THE SUCCESSFUL OPERATION OF ANY SYSTEM

NOTE: CLEANOUT REQUIRED EVERY 70 FEET OF SEWER LINE AND/OR AT 90° SWEEPS IN LINES FROM HOUSE TO DRAIN FIELDS, 90° ELBOWS NOT ACCEPTABLE.

NOTE: ALL PARTS OF SEPTIC SYSTEMS (I.E. TANK, DISTRIBUTION BOX TRENCHES) TO BE 100 FEET FROM WELL (UNLESS OTHERWISE SPECIFICALLY AUTHORIZED)

NOTE: IF DEEP TRENCH(ES) ARE USED CALL FOR INSPECTION BEFORE AND AFTER PLACING GRAVEL IN TRENCH(ES)

NOTE: NO DRY WELL SHALL EXCEED 15 FOOT IN DIAMETER NO ABSORPTION TRENCH TO EXCEED 100 FEET IN LENGTH

NOTE: ALL PIPE FROM HOUSE TO SEPTIC TANK MUST BE CAST IRON OR SCHEDULE 35/40 PVC OR ABS

PERMIT VOID AFTER TWO YEARS

NOTE: INSTALL STAND PIPE ON SEPTIC TANK AND DRY WELL STAND PIPES MUST BE 6 INCHES IN DIAMETER CAST IRON. CONCRETE OR TERRA COTTA OR PVA OR ABS ACCEPTED. IF TOP OF SEPTIC TANK IS DEEPER THAN 3 FEET. MANHOLE TO GRADE REQUIRED.

NOTE: DISTRIBUTION BOXES MUST HAVE BAFFLES


*INSTALLER IS RESPONSIBLE FOR OBTAINING FINAL APPROVAL ON THIS PERMIT

HD-260(6-90)

*CALL 461-9933 FOR INSPECTION OF SEPTIC SYSTEM.

A 42807

WELL LINE OK BUT WELL CASING BROKEN AT CORNER, PATCHED WITH FERNCO COUPLING
 APPL. PENDING "TECHNO MAGIC"
 OK TO COVER WELL LINE BUT HAVE CASING REPAIRS
 CONTACT HEALTH DEPT WHEN CASING REPAIRS
 9/12/96 (CW)

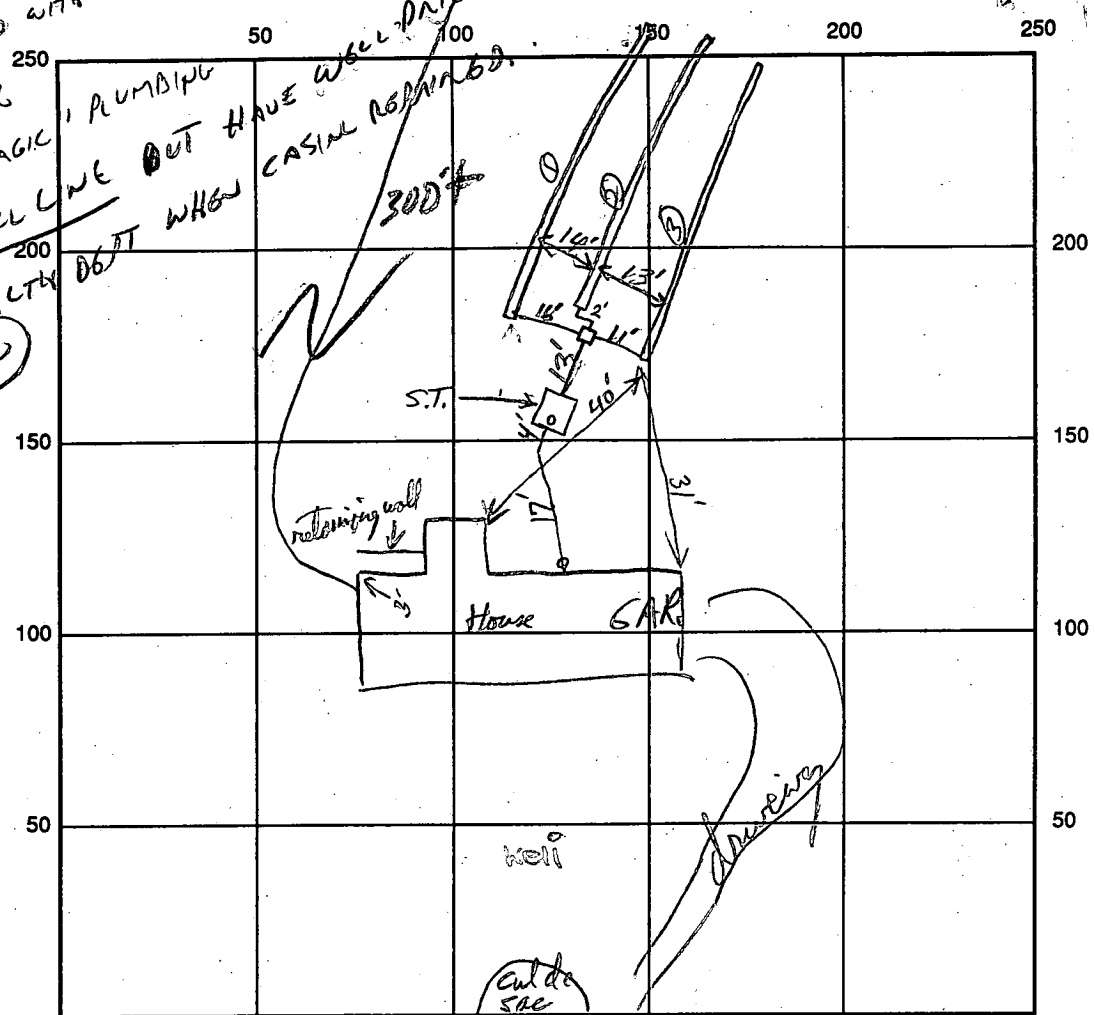

INDICATE NORTH - NAME ADJOINING ROADWAY AS BASE LINE

SEPTIC TANK LEVEL 1250 gal CLEANOUTS Hse & S.T. OK
 DISTRIBUTION BOX LEVEL OK 9/3/96 (water level)
 DRAIN FIELD/TITLE DEPTH 6 1/2 - 7 (Trench #1) FT. TRENCH WIDTH 3 FT. INLET DEPTH 4 1/2 (-5 ft at ends) FT.
 EFFECTIVE GRAVEL DEPTH 2 FT. TOTAL LENGTH 106 1/2 FT.
 NUMBER OF TRENCHES 3 ~~ONE SIDEWALL~~ BOTTOM AREA 960 SQ. FT.
 DRYWALL INSIDE DIAMETER _____ FT. EFFECTIVE DEPTH BELOW INLET _____ FT.
 ABSORBENT AREA _____ SQ. FT.

REMARKS: Trenches & Septic Tank & House Connection OK. OK to cover system 9/13/96

DATE SYSTEM APPROVED 9/13/96 INSPECTOR [Signature]

APPLICATION

PERCOLATION TESTING

A 42807

P _____

HOWARD COUNTY HEALTH DEPARTMENT
BUREAU OF ENVIRONMENTAL HEALTH
P.O. BOX 476 ELLICOTT CITY, MARYLAND 21043
TELEPHONE: 461-9933

DISTRICT 4

DATE 8/16/88

TO: THE COUNTY HEALTH OFFICER
ELLICOTT CITY, MARYLAND

I, HEREBY, APPLY FOR THE NECESSARY TEST IN ORDER TO CONSTRUCT (OR RECONSTRUCT) A SEWAGE DISPOSAL SYSTEM.

PROPERTY OWNER Garrie Lee Hutchins Montgomery A. Michelle D'Ambrasio

ADDRESS 830 Morgan Station Road, Woodbine, MD 21797 PHONE _____

PROSPECTIVE BUYER Potomac Development Company

ADDRESS 1015 Copperstone Ct., Rockville, MD 20852 PHONE 424-6006

PROPERTY LOCATION:

SUBDIVISION Camden Downs LOT NO. Prelim 6

ROAD AND DESCRIPTION Old Frederick Road and Morgan Station Road
15631 Thistle Down Ct.

**BLDG. PERMIT SIGNED
AND RETURNED 7-3-96**

B00100900

50

(SINGLE FAMILY DWELLING OR COMMERCIAL)

TAX MAP 8 PARCEL # 1

SIZE OF LOT 3.14 Acres TYPE BLDG. _____

THE SYSTEM INSTALLED UNDER THIS APPLICATION IS ACCEPTABLE ONLY UNTIL PUBLIC FACILITIES BECOME AVAILABLE. I FULLY UNDERSTAND THE FEE CONNECTED WITH THE FILING OF THIS PERC TEST APPLICATION IS NON-REFUNDABLE UNDER ANY CIRCUMSTANCES. I ALSO AGREE TO COMPLY WITH ALL M.O.S.H.A. REQUIREMENTS IN TESTING THIS LOT.

Gregory B. Powell
(SIGNATURE OF APPLICANT)

APPROVED BY _____ FOR _____ DATE _____

REJECTED BY _____ FOR _____ DATE _____

HOLD PENDING FURTHER TESTS _____ DATE _____

REASONS FOR REJECTION OR HOLDING 1-19-89 Pending perc hole locations and subdivision plat approval. SHALLOW SYSTEM ONLY JEN/dec

THIS IS NOT A PERMIT

Lot-7

A42807

SOIL PROFILE

0-4.5 Br sil
1m

4.5-13.5 Br cl sa
silt 1m
≤ 20%
decomp
rock
13.5 Bottom

(A)(B)(E)

0-4.0 Br sil
1m


4-14.0 Br cl sa
silt 1m,
little
broken
rx frags
≤ 15%
rx frags
14.0 Bottom

(F)

0-4.5 Br sil
1m

4.5-13.5 Br sa si
1m, trc
of broken
rock
≤ 10%
13.5 Bottom

EH-12-1079

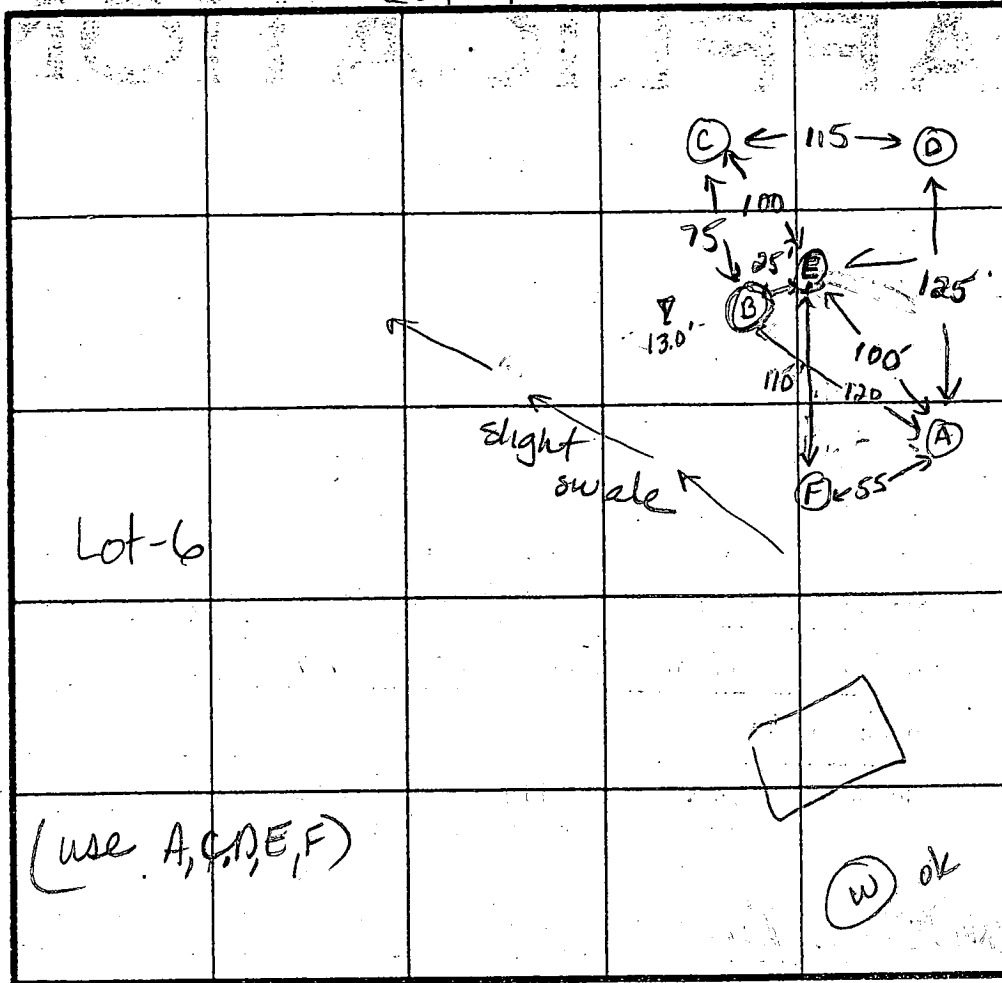

Highest A
D
F
E
C
Lowest B

SHALLOW
SYSTEM ONLY

$\bar{X} = 15 \text{ min}$
Inlet = 4.5 ft
Bottom = 6.0 ft
240 sqft/bdrm

(use A, C, D, E, F)

INDICATE NORTH - NAME ADJOINING ROADWAY AS BASE LINE.

Lot-5

DATE	TEST NO.	DEPTH	PRE-WET		TEST - 1" DROP		TIME
			START	STOP	START	STOP	
1-19-89	D	5.0 S	11:03	11:05	11:05	11:13	8min
		8.0 M	11:03	11:13	11:13	11:24	11min
		13.5 D	Bottom (see profile)				ok
	C	6.5 S	11:06	11:12	11:12	11:26	14min
		13.5 D	Bottom (see profile)				ok
	(B)	5.5 S	11:10	11:25	1/4 inch		Failed
		13.5 D	Bottom (Water at 13.0' after 18hrs)				
	A	14.0 V	Bottom (see profile)				ok
		3.0 S	11:41	11:57	no movement		Failed
	E	6.0 M	11:41	11:45	11:45	12:00	15min
		4.5 S	12:00	12:06	12:06	12:32	26min
		13.5 D	Bottom - dry				ok

REMARKS

All holes as shown on plat except E & F. Water in B at 13.0 ft.

TYPE OF SOIL

0-4.5 Br sil 1m, 4.5-14 Br cl sa si 1m, ≤ 20% rx


TESTED BY

Jane E. Nadeau

ALSO PRESENT

Cecilia, Kenny, Phil

GRID NORTH

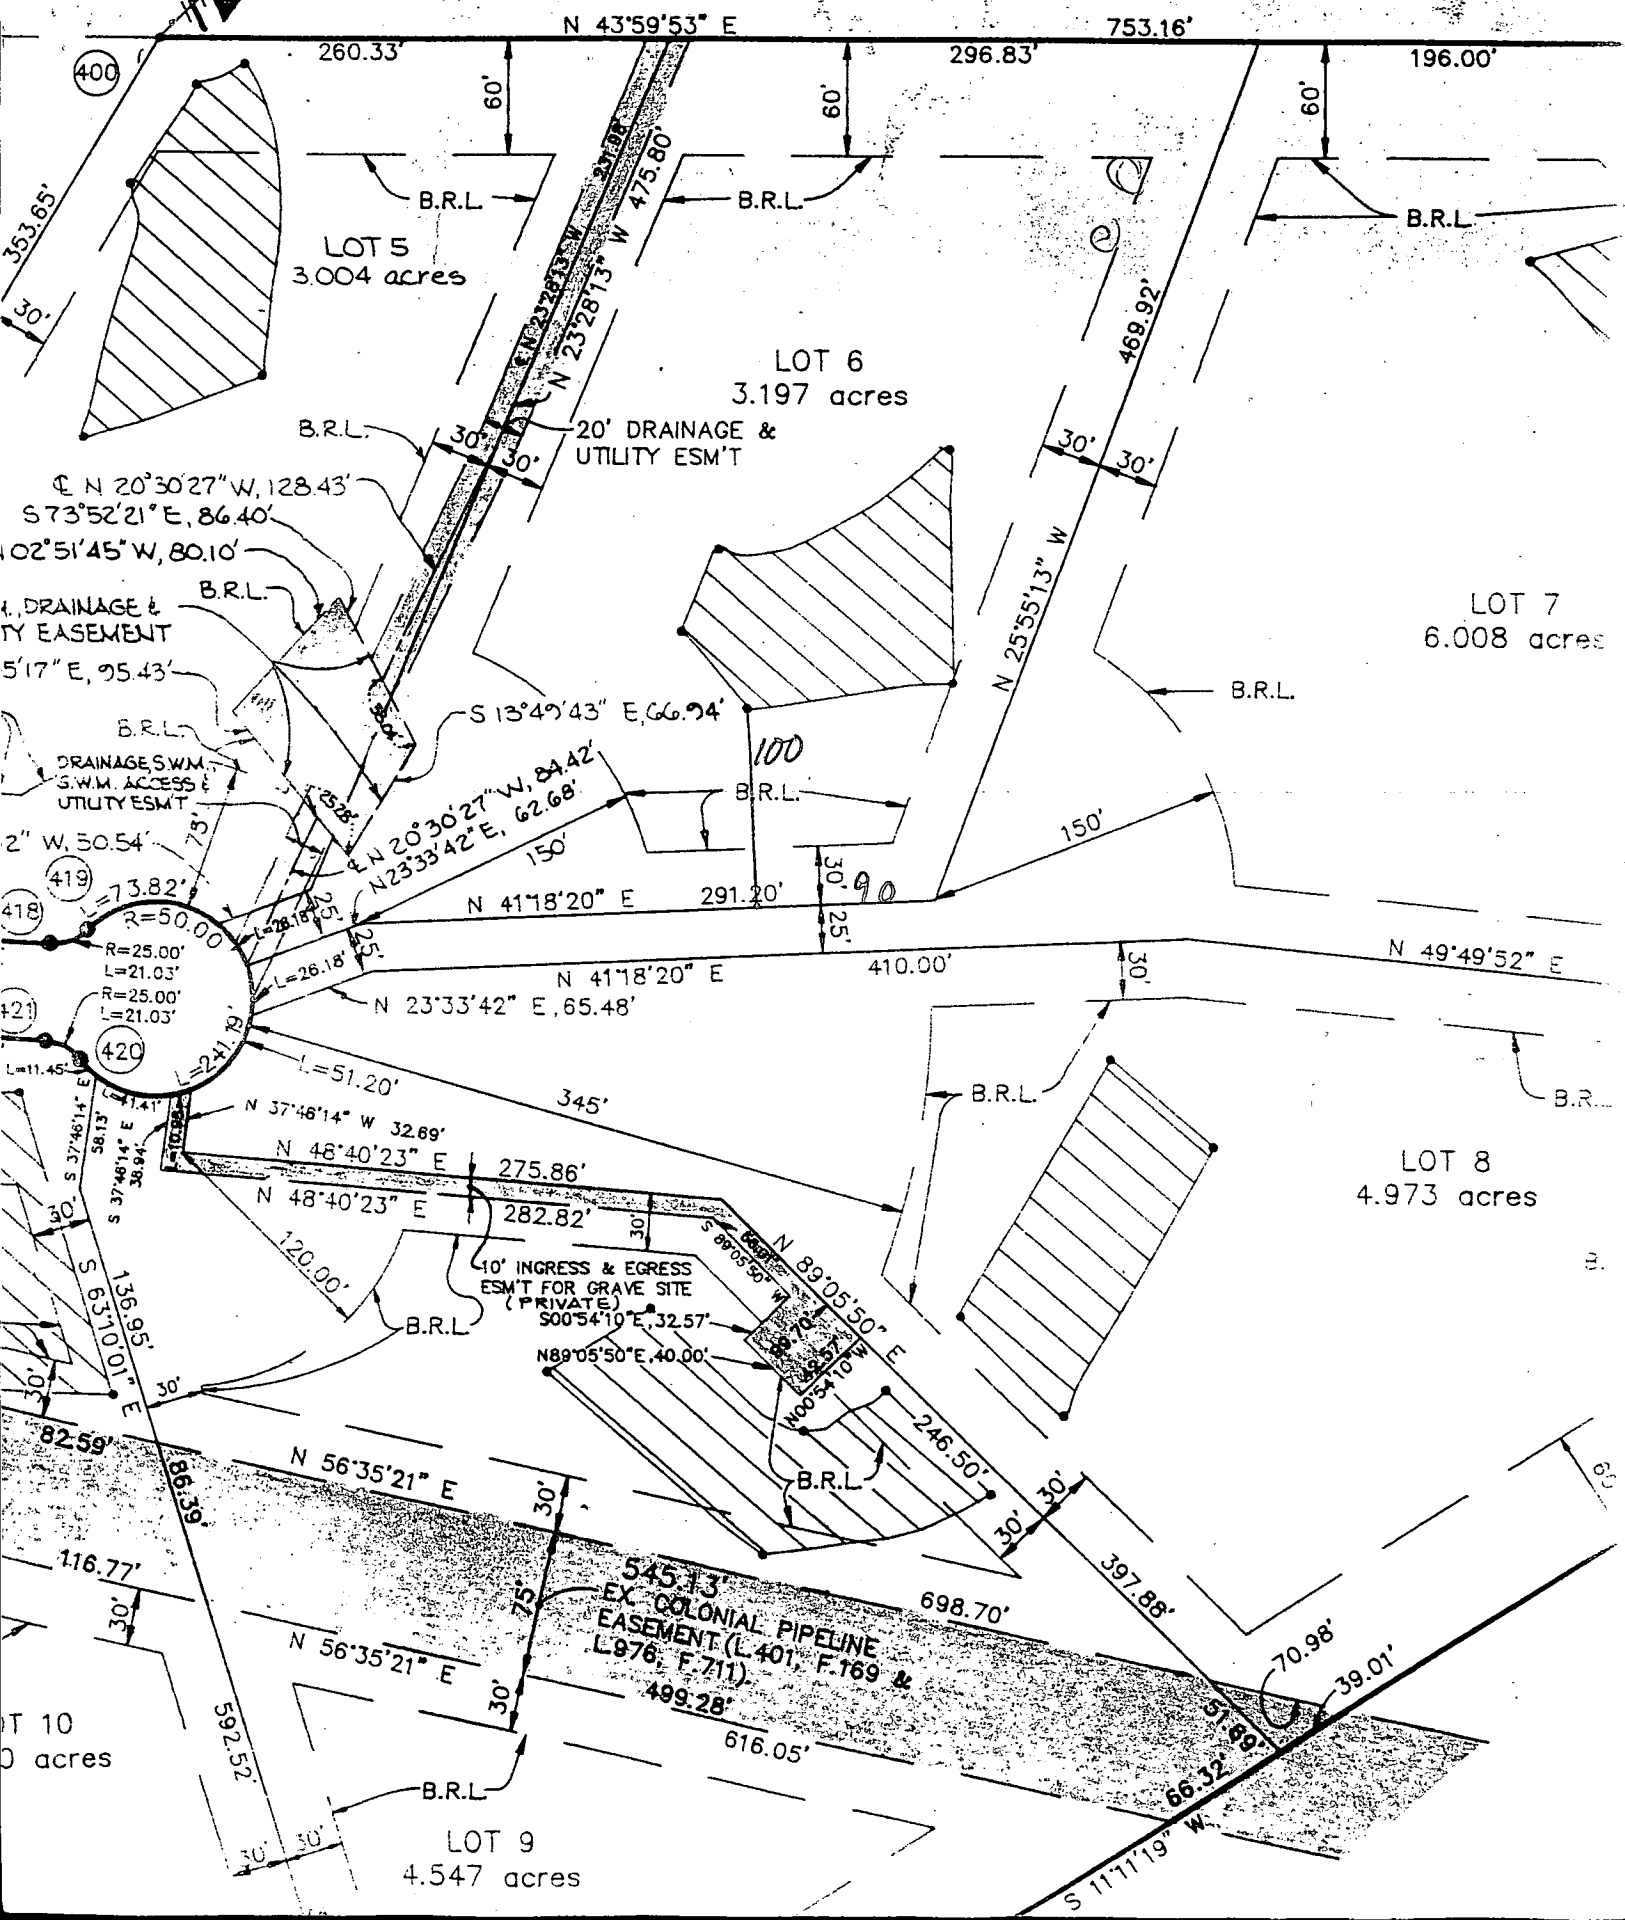

Ⓐ = PROPOSED 4 BEDROOM HOUSE
 F.F. ELEV. = 567.0'
 BSMT. ELEV. = 560.5'
 INV. ELEV. = 559.3'

Ⓑ = PROP. SEPTIC TANK
 EX. ELEV. = 562.9'
 INV. IN = 559.1'
 INV. OUT = 558.8'


Ⓒ = PROP. DIST. BOX
 EX. ELEV. = 562.8'
 INV. ELEV. = 558.6'

Ⓓ = PROP. TRENCHES
 INV. ELEV. = 558.3'
 2" STONE, 6" BOTTOM
 MAX. LENGTH TO BE
 DETERMINED AT TIME
 OF SEPTIC PERMIT
 ISSUANCE.

Approved Septic System Plan Howard County Health Department

000100900

Mark E. Riffkin 4/2/96
 Signature Date

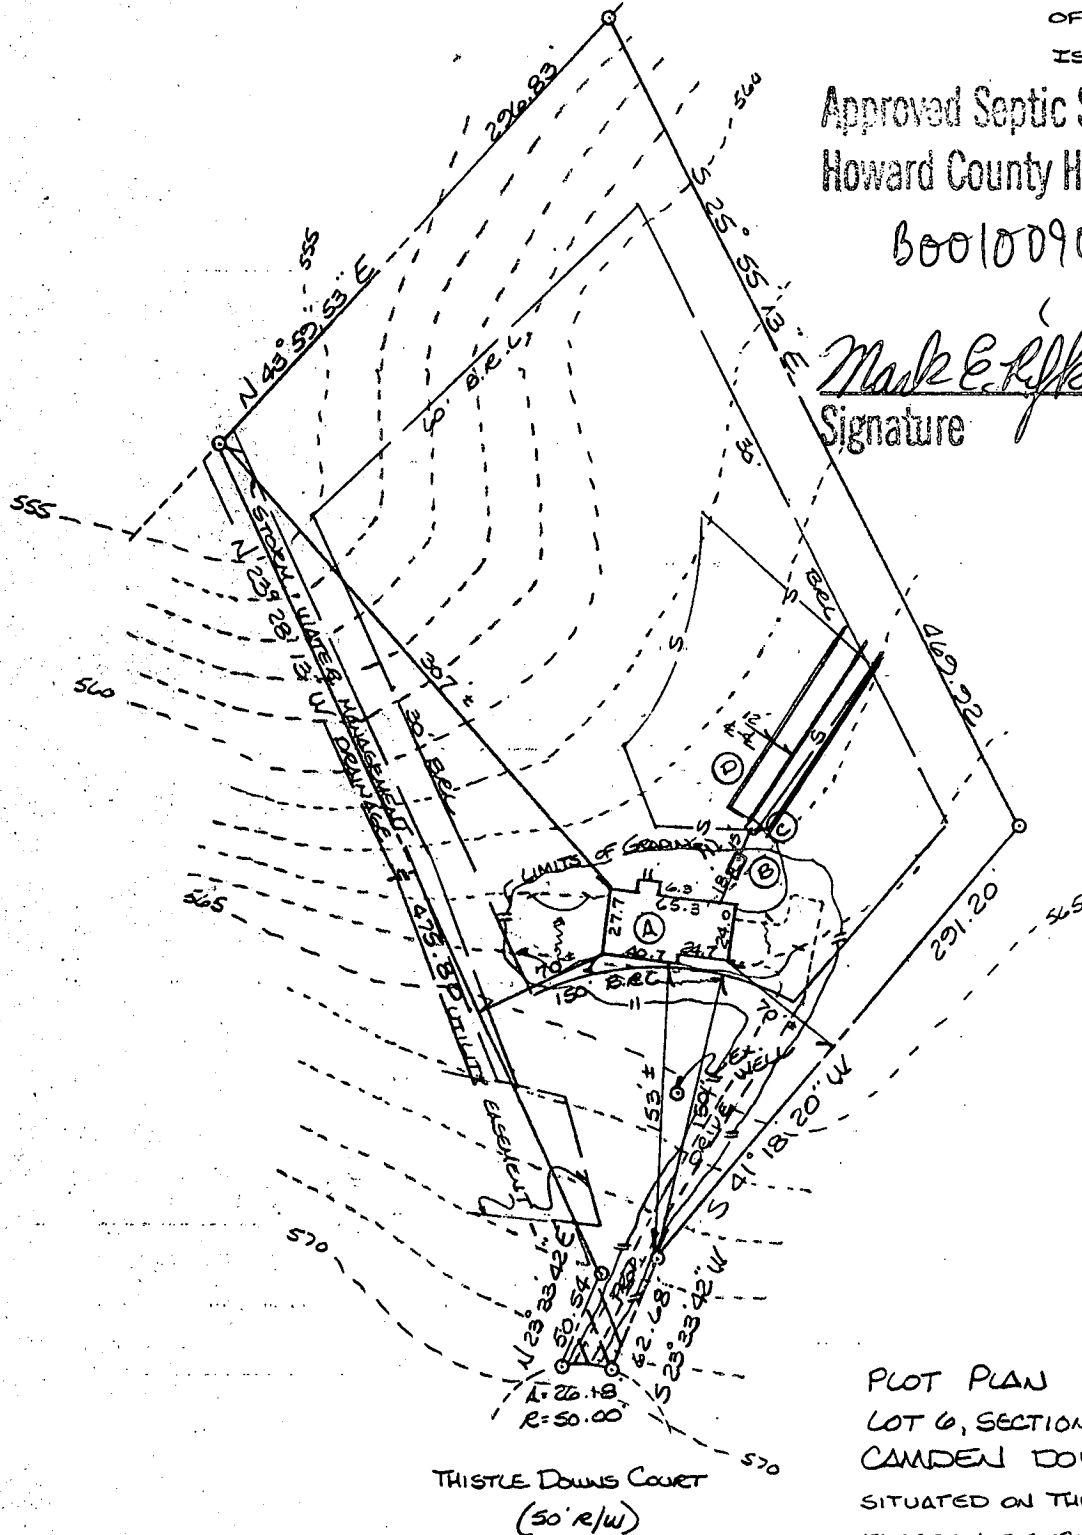

PLOT PLAN
 LOT 6, SECTION ONE
 CAMDEN TOWNS
 SITUATED ON THISTLE DOWNS COURT
 ELECTION DISTRICT N: 4
 HOWARD COUNTY, MARYLAND
 SCALE: 1" = 100' JUNE 1996



I CERTIFY THIS PLAT TO BE CORRECT; IT IS THE RESULT
 OF AN ACTUAL FIELD SURVEY, BASED ON DATA FOUND AMONG
 THE LAND RECORDS OF HOWARD COUNTY,
 MARYLAND, AS REFERENCED HEREON.

REFERENCE	JOB NO.
PLAT # 9673	9651 0102

NASSAUX-HEMSLEY, INC.
 204 S. Main Street
 Mount Airy, Maryland
 301-829-2296 21771

**HOWARD COUNTY HEALTH DEPARTMENT
BUREAU OF ENVIRONMENTAL HEALTH
WATER AND SEWERAGE PROGRAM
TEL: (410)313-2640 FAX: (410)313-2648**

Information Form for the Installation of the Well Pump, Pitless Adapter, and Supply Piping

NOTE: The installer is responsible for requesting an inspection prior to 9 am on the day of the desired inspection. No work is to be covered until approved by the Health Department. All installations must comply with the National Standard Plumbing Code (NSPC, as amended locally) and COMAR 26.04.04 (200 Well Construction Regulations). Submission of a complete form is required prior to Use and Occupancy approval.

Company Name: R&G WATER SYSTEMS INC Telephone #: 410-239-0700
Address: 4322 CPALIS CHURCH DR
MARLBOROUGH, MA 01922

(Must circle one) Licensed Plumber Licensed Well Driller Licensed Well Pump Installer
License # and name of individual responsible for the field installation:
Name (Print): RICKEY L. ROOS, SR. Licensed PI 141

*A licensed individual must perform the actual installation. Apprentices must be under the direct supervision of a licensed journeyman or master plumber, pump installer or well driller. Licenses may be subjected to field verification.

Name of Property Owner: MAUD MCKEY D'AMBROSIO Telephone #: 410-442-9723
Subdivision: CAMPBELL DOWNS Lot #: 141 Well Tag #: HO 94-3825 ✓
Site Address: 15631 THISSLEDOWNS CT MAP-3-H-8
WOODBINE MD 21797

Submersible Pump Data	Pitless Adapter	Well Cap and Electric Conduit
Make: <u>Goulds</u>	Make: <u>CAMPBELL</u>	Two piece watertight cap: <u>YES</u>
Model #: <u>7LS07422</u>	Model #: <u>PA-800</u>	Screwed, vented well cap: <u>YES</u>
Pump Capacity: <u>7</u> GPM	Depth: <u>42'</u> (36" min)	Cap secured to casing: <u>YES</u>
Well Yield: <u>1</u> GPM	NSF approved: <u>YES</u>	Conduit min 18" R.G.: <u>YES</u>
Depth of well encountered at time of pump installation: _____ (feet)		Conduit secured to well cap: <u>YES</u>

If pump capacity exceeds well yield, a low water cut off switch is required by NSPC 1990 Section 17.8.4
Torque arrestors or Cable glands are required. - Must circle one
Safety rope, if used, attached to inside of well casing with eye bolt YES

Pipings to house
Type: 1" POLYETHYLENE
PSI: 160 (160 psi min)
Depth of supply line: 42' (36" min)

House Connection
PVC sleeved to undisturbed soil at wall penetration: YES
Approximate length of sleeve: 10'
Sleeve caulked and sealed properly: YES - FERRO


The water supply line is required to be at least ten feet from the septic tank, pump chamber, sewage piping, distribution box, drainfields, and sewage reserve area. If this cannot be accomplished, contact this office for approval prior to installation.

Signature of company representative responsible for installation: Rickey L. Roos, Sr.

date: 12/28/03

For Health Department Use Only - Not to be completed by Installer

Date Insp. Requested: 12/29/03 IF POSS. Date Insp. Approved: 12/29/03 (50)
Inspection Data: Pitless adapter and water supply line at least 36" below grade _____
Two piece cap installed and attached to casing securely _____
Elec. conduit extends at least 18" below grade/attached to cap properly _____
Safety rope installed inside of well casing _____
Correct well tag attached properly and casing 3" above finished grade _____
Water supply line sleeved adequately at house connection _____
Adequate grout observed below pitless adapter _____

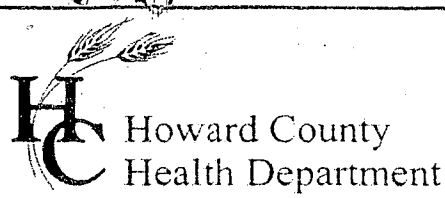

3525 H Ellicott Mills Drive, Ellicott City, MD 21043
(410) 313-2640 Fax (410) 313-2648
TDD (410) 313-2323 Toll Free 1-866-313-6300
website: www.hchealth.org

Penny E. Borenstein, M.D., M.P.H., Health Officer

November 14, 2003

Mr. D'Ambrosio
15631 Thistle Downs Court
Woodbine, MD 21797

RE: **Replacement Well Connection**
15631 Thistle Downs Court
Well Permit #: HO-94-3825

Dear Mr. D'Ambrosio:

This office is requesting that you forward the enclosed form to the appropriate licensed contractor (Well Driller, Registered Plumber or Pump Installer) who is responsible for the installation of the well pump, well water line connection and related plumbing in the referenced replacement well. The contractor should complete this form neatly and submitted it to this office via fax or mail once the pump is placed in the well.

Submission of this completed form by the contractor is required for final approval of the field inspection, which should be conducted by an inspector from this office when the work is ready for inspection. The contractor is responsible for scheduling an inspection request with this office.

Also, after the well completion inspections is approved and the well disinfected, please call (410)-313-1773 to schedule a water sample at no cost to you.

If you have any questions, or would like to discuss these matters further please call me at (410) 313-1771. Thank you for your attention to these important matters.

Respectfully,

Kacie Noonan
Environmental Sanitarian

Enclosure

cc: Ron Kyker
File

R & G Water Systems, Inc

4322 Opals Choice Drive
Manchester, MD 21102

Phone No.: 410-239-0700 or 800-352-9836

Date: 12/28/03

Fax

1 of 2 PAGES

TO: HOWARD COUNTY ENVIRONMENTAL HEALTH DEPT.

PHONE: 410-313-2640

FAX: 410-313-2648

FROM: RICK ROOS / R & G WATER SYSTEMS, INC.

PHONE: 410-239-0700

FAX: 410-239-0700

NOTES:

IF THIS UNDERRUN COULD BE INSPECTED
MAD-12/24/03 I WOULD GREATLY APPRECIATE IT.
WE DID THE TRENCHING THIS WEEKEND AND LEFT DITCH
OPEN @ PITLESS ADPT. AND @ THE HOUSE.
I DID FORGET TO GET THE "HO" II OFF OF THE WELL
I HOPE THIS DOES NOT CAUSE A PROBLEM.

THANKS!

RICK

12/29/03 3⁰⁰pm or earlier if possible

(FA)

SITE INSPECTION SHEET

OWNER: Monty D'Ambrosio

PHONE #: 410-442-9723

ADDRESS: 15631 Thistle Downs Ct

CONTRACTOR: Westminster


WELL TAG #: _____

SUBDIVISION: Camden Downs LOT: 6

COUNTY #: _____

PROPOSAL: Contaminated Well Driller reports well is contaminated w/ salt. Nearby Property has sediment pond on site.

LOCATION DIAGRAM

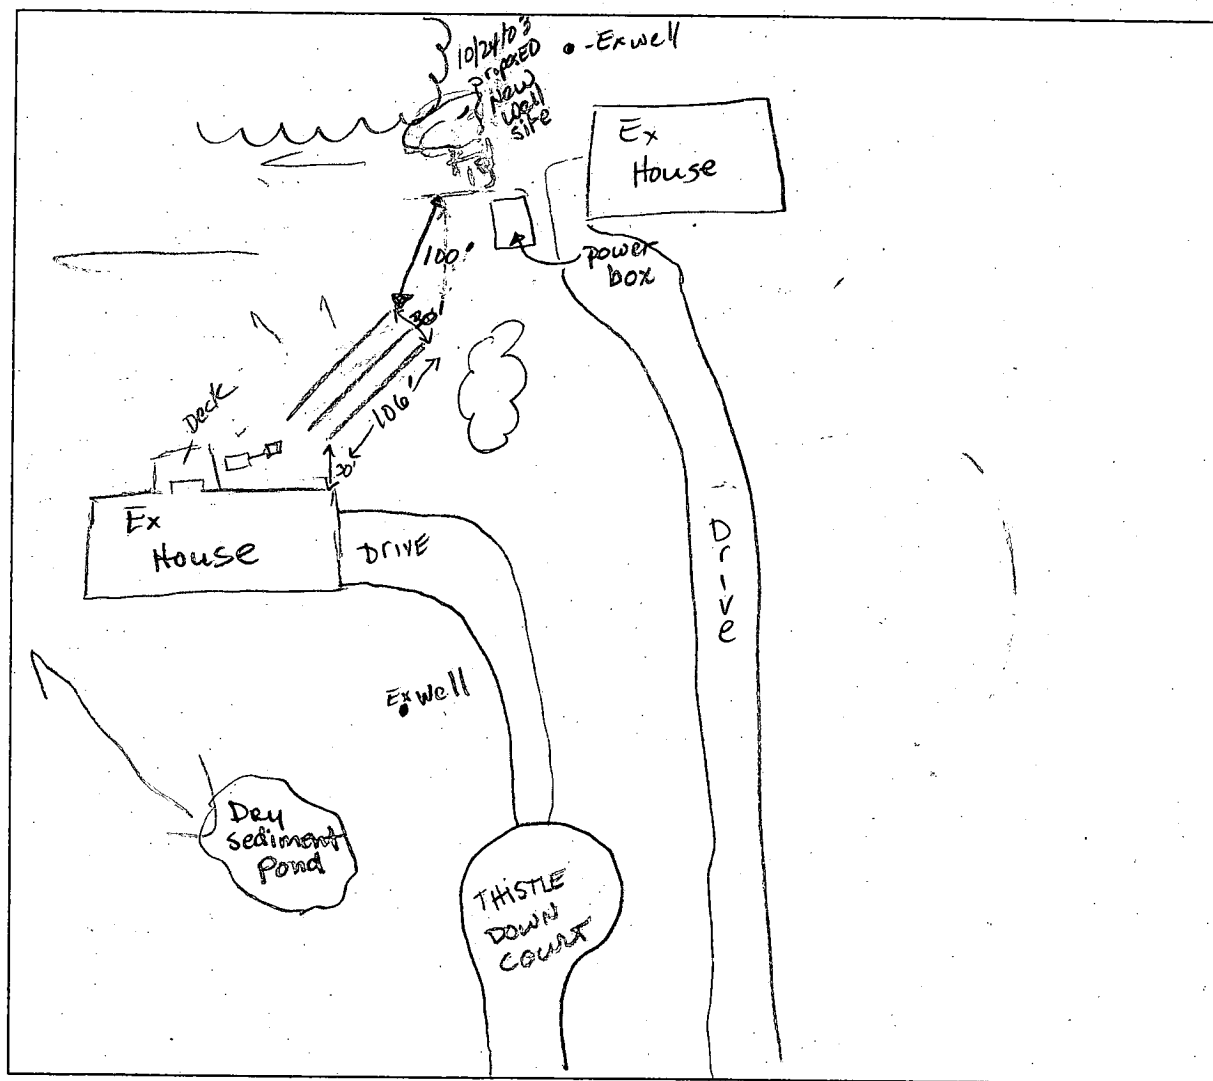

COMMENTS: 10/24/03 Prop. 3 acres in size. Will keep existing well for gov't testing and data collection. New well location approved.

DATE: 10/24/03

INSPECTOR: Rae Norman

C1 1597 SEQUENCE NO. (DENY USE ONLY)

(THIS NUMBER IS TO BE PUNCHED IN COLS. 3-6 ON ALL CARDS)

STATE OF MARYLAND
WELL COMPLETION REPORT
FILL IN THIS FORM COMPLETELY
PLEASE PRINT OR TYPETHIS REPORT MUST BE SUBMITTED WITHIN
45 DAYS AFTER WELL IS COMPLETED.

COUNTY NUMBER A-42807

CO USE ONLY
DATE Received

DATE WELL COMPLETED

Depth of Well

PERMIT NO.
FROM "PERMIT TO DRILL WELL"

8 13

061190

22 145 26
(TO NEAREST FOOT)28 29 30 31 32 33 34 35 36 37
40-88-1491OWNER Camden Downs Partner
STREET OR RD last name first name TOWN Lisbon
SUBDIVISION Camden Downs SECTION 2 LOT 6

WELL LOG

Not required for driven wells

STATE THE KIND OF FORMATIONS
PENETRATED, THEIR COLOR, DEPTH,
THICKNESS AND IF WATER BEARING

DESCRIPTION (Use additional sheets if needed) FEET Check if water bearing

DESCRIPTION (Use additional sheets if needed)	FEET	Check if water bearing
FROM	TO	
Top Soil	0 2	
Shale	2 15	
Brown Slate	15 23	
Blue Slate	23 35	
Brown Slate	35 50	
Blue Slate	50 10	
Brown Slate	10 95	
Blue Slate	15 110	
Brown Slate	110 115	
Blue Slate	115 165	

GROUTING RECORD

WELL HAS BEEN GROUTED

(Circle Appropriate Box)

TYPE OF GROUTING MATERIAL

CEMENT CM BENTONITE CLAY BC

NO. OF BAGS 7 NO. OF POUNDS 700

GALLONS OF WATER 45

DEPTH OF GROUT SEAL (to nearest foot)

from 48 ft. to 54 ft.
(enter 0 if from surface)

CASING RECORD

casing types insert appropriate code below

ST CO
STEEL CONCRETE
PL OT
PLASTIC OTHER

MAIN CASING TYPE Nominal diameter top (main) casing (nearest inch) Total depth of main casing (nearest foot)

PL L 60 61 63 64 66 70

OTHER CASING (if used)

diameter inch depth (feet) from to

EACH CASING

screen type or open hole insert appropriate code below

ST BR HO
STEEL BRASS OPEN HOLE
PL OT
PLASTIC OTHER

C2

DEPTH (nearest ft.)

EACH SCREEN

SLOT SIZE 1 2 3
DIAMETER OF SCREEN (NEAREST INCH)

GRAVEL PACK IF WELL DRILLED WAS FLOWING WELL INSERT F IN BOX 68

OEP USE ONLY (NOT TO BE FILLED IN BY DRILLER)

T (E.R.O.S.) W Q
70 72 74 75 76
TELESCOPE CASING LOG INDICATOR OTHER DATA

C3

PUMPING TEST

HOURS PUMPED (nearest hour) 3

PUMPING RATE (gal. per min. to nearest gal.) 10

METHOD USED TO MEASURE PUMPING RATE Bucket

WATER LEVEL (distance from land surface)

BEFORE PUMPING 18

WHEN PUMPING 25

TYPE OF PUMP USED (for test)

A air P piston T turbine
C centrifugal R rotary O other (describe below)
J jet S submersible

PUMP INSTALLED

DRILLER WILL INSTALL PUMP YES NO

IF DRILLER INSTALLS PUMP, THIS SECTION MUST BE COMPLETED FOR ALL WELLS EXCEPT HOME USE TYPE OF PUMP INSTALLED PLACE (A,C,J,P,R,S,T,O) IN BOX - SEE ABOVE

CAPACITY: GALLONS PER MINUTE (to nearest gallon)

PUMP HORSE POWER

PUMP COLUMN LENGTH (nearest ft.)

CASING HEIGHT (circle appropriate box and enter casing height)

+ above LAND SURFACE (nearest foot)
- below

LOCATION OF WELL ON LOT

SHOW PERMANENT STRUCTURE SUCH AS BUILDING, SEPTIC TANKS, AND/OR LANDMARKS AND INDICATE NOT LESS THAN TWO DISTANCES (MEASUREMENTS TO WELL)

CIRCLE APPROPRIATE LETTER
A A WELL WAS ABANDONED AND SEALED WHEN THIS WELL WAS COMPLETED

E ELECTRIC LOG OBTAINED

P TEST WELL CONVERTED TO PRODUCTION WELL



I HEREBY CERTIFY THAT THIS WELL HAS BEEN CONSTRUCTED IN ACCORDANCE WITH COMAR 26.04.04 "WELL CONSTRUCTION" AND IN CONFORMANCE WITH ALL CONDITIONS STATED IN THE ABOVE CAPTIONED PERMIT, AND THAT THE INFORMATION PRESENTED HEREIN IS ACCURATE AND COMPLETE TO THE BEST OF MY KNOWLEDGE.

DRILLERS IDENT. NO. 453

DRILLERS SIGNATURE (MUST MATCH SIGNATURE ON APPLICATION)

SITE SUPERVISOR (sign of driller or journeyman responsible for sitework if different from permittee)

COUNTY

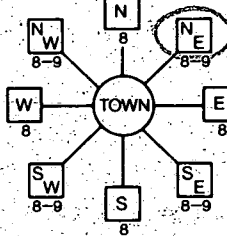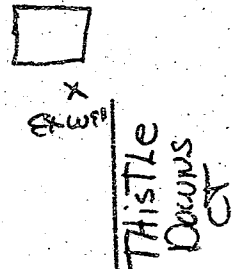B 1 5733 2 3 6	SEQUENCE NO. (MDE USE ONLY)	STATE OF MARYLAND APPLICATION FOR PERMIT TO DRILL WELL W519641 please type	STATE PERMIT NUMBER HD-94-3825 70 fill in this form completely 79
Date Received (APA) 10/24/03 8 MM DD YY 13 D'AMBROSIO MONTY 15 Last Name Owner First Name 34 15631 THISTLE DOWNS COURT 36 Street or RFD 55 WOODBINE MARYLAND 21797 57 Town 70 State 72 Zip 76		B 3 HOWARD LOCATION OF WELL 8 COUNTY 21 CAMDEM DOWNS 23 SUBDIVISION 42 SECTION 44 46 LOT 6 48 50 LISBON 52 NEAREST TOWN MILES FROM TOWN (enter 0 if in town) 2 M 73 76 77 78	
DRILLER INFORMATION RONALD KYKER M W D296 Driller's Name 76 License No. 81 WESTMINSTER WELL DRILL INC Firm Name P.O. BOX 861 WESTMINSTER MD. 21157 Address Ronald Kyker OCT 22 03 Signature Date		B 4 THISTLE DOWNS CT. 11 NEAR WHAT ROAD 30 ON WHICH SIDE OF ROAD (CIRCLE APPROPRIATE BOX) NORTH ☒ WEST ☐ EAST ☐ SOUTH ☐ 34 400 37 DISTANCE FROM ROAD FT. ENTER FT OR MI. 38 39 TAX MAP: 8 BLK: _____ PARCEL: 1	
B 2 WELL INFORMATION 1 2 APPROX. PUMPING RATE 5 (GAL. PER MIN.) 8 12 AVERAGE DAILY QUANTITY NEEDED 500 (GAL. PER DAY) 14 20		DIRECTION OF WELL FROM TOWN (CIRCLE BOX) 	
USE FOR WATER (CIRCLE APPROPRIATE BOX) ☒ DOMESTIC POTABLE SUPPLY & RESIDENTIAL IRRIGATION ☐ FARMING (LIVESTOCK WATERING & AGRICULTURAL IRRIGATION) ☐ INDUSTRIAL, COMMERCIAL, DEWATERING ☐ PUBLIC WATER SUPPLY WELL ☐ TEST, OBSERVATION, MONITORING ☐ GEO-THERMAL		NOT TO BE FILLED IN BY DRILLER HEALTH DEPARTMENT APPROVAL HOWARD P57086 B COUNTY NAME COUNTY NO. STATE SIGNATURE _____ INSERT S → 41 DATE ISSUED 10/27/03 Kacie Norman 10/23/04 43 MM DD YY 48 CO SIGNATURE EXP. DATE NORTH GRID 550 0 0 0 EAST GRID 780 0 0 0 50 55 57 63	
APPROXIMATE DEPTH OF WELL 300 FEET 24 28 APPROXIMATE DIAMETER OF WELL 6 INCH NEAREST INCH		SHOW MAJOR FEATURES OF BOX & LOCATE WELL WITH AN X SOURCES OF DRILLING WATER 1. CITY 2. 3. WRITE THE BOX NUMBER FROM THE MAP HERE E 780 550 N 000 000	
METHOD OF DRILLING (circle one) BORED (or Augered) JETTED Jetted & DRIVEN 30 AIR-ROTary AIR-PERCussion ROTARY (Hydraulic Rotary) 37 CABLE REVerse-ROTary Drive-POINT other _____		DRAW A SKETCH BELOW SHOWING LOCATION OF WELL IN RELATION TO NEARBY TOWNS AND ROADS AND GIVE DISTANCE FROM WELL TO NEAREST ROAD JUNCTION x Septic X N Well 	
REPLACEMENT OR DEEPEMED WELLS (CIRCLE APPROPRIATE BOX) ☐ THIS WELL WILL NOT REPLACE AN EXISTING WELL ☐ THIS WELL WILL REPLACE A WELL THAT WILL BE ABANDONED AND SEALED 39 ☒ THIS WELL WILL REPLACE A WELL THAT WILL BE USED AS A STANDBY-CONTACT LOCAL APPROVING AUTHORITY FOR POLICY ON STANDBY WELLS ☐ THIS WELL WILL DEEPEMED AN EXISTING WELL PERMIT NUMBER OF WELL TO BE REPLACED OR DEEPEMED (IF AVAILABLE) 41 HD-88-1401 52		Not to be filled in by driller (MDE OR COUNTY USE ONLY) APPROX. PERMIT NUMBER G PERMIT No. HD-94-3825 70 71 72 73 74 75 76 77 78 79	
SPECIAL CONDITIONS NOTE - APPROVING AUTHORITIES SHOULD USE SEPARATE SHEET IF NEEDED			

DRILLER: REMOVE COPY AND RETAIN FOR YOUR RECORDS. RETURN COUNTY COPY TO COUNTY ENVIRONMENTAL AGENCY. SUBMIT COPY TO OWNER. RETURN ALL OTHER PARTS TO DEPARTMENT OF ENVIRONMENT, 2500 BROENING HIGHWAY, BALTIMORE, MARYLAND 21224.

C1 3860 (THIS NUMBER IS TO BE PUNCHED IN COLS. 3-6 ON ALL CARDS)		SEQUENCE NO. (MDE USE ONLY)		STATE OF MARYLAND WELL COMPLETION REPORT FILL IN THIS FORM COMPLETELY. PLEASE TYPE		THIS REPORT MUST BE SUBMITTED WITHIN 45 DAYS AFTER WELL IS COMPLETED.																																																																											
ST/CO USE ONLY DATE Received MM <u>11</u> DD <u>12</u> YR <u>03</u>		DATE WELL COMPLETED MM <u>11</u> DD <u>03</u> YR <u>2003</u>		Depth of Well 22 <u>355</u> 26 (TO NEAREST FOOT)		COUNTY NUMBER <u>13</u> <u>A42807</u> PERMIT NO. FROM "PERMIT TO DRILL WELL" <u>H0-94-3825</u>																																																																											
OWNER <u>Ambrosio</u> STREET OR RFD <u>15631 Thistle Down Ct</u> TOWN <u>Woodburn</u> SUBDIVISION <u>Camden Downs</u> SECTION <u>6</u> LOT <u>6</u>																																																																																	
WELL LOG Not required for driven wells STATE THE KIND OF FORMATIONS PENETRATED, THEIR COLOR, DEPTH, THICKNESS AND IF WATER BEARING				GROUTING RECORD WELL HAS BEEN GROUTED (Circle appropriate box) TYPE OF GROUTING MATERIAL (Circle one) CEMENT <u>CM</u> BENTONITE CLAY <u>BC</u> NO. OF BAGS <u>47</u> NO. OF POUNDS <u>4418</u> GALLONS OF WATER <u>282</u> DEPTH OF GROUT SEAL (to nearest foot) from <u>0</u> ft. to <u>80</u> ft. (enter 0 if from surface)																																																																													
<table border="1" style="width:100%; border-collapse: collapse;"><thead><tr><th rowspan="2">DESCRIPTION (Use additional sheets if needed)</th><th colspan="2">FEET</th><th rowspan="2">check if water bearing</th></tr><tr><th>FROM</th><th>TO</th></tr></thead><tbody><tr><td>Dirt</td><td>0</td><td>1</td><td></td></tr><tr><td>Soft Br. Shale</td><td>1</td><td>14</td><td></td></tr><tr><td>Opening</td><td>14</td><td>15</td><td>X</td></tr><tr><td>Soft Br. Shale</td><td>15</td><td>48</td><td></td></tr><tr><td>Gravel/Br. Shale</td><td>48</td><td>51</td><td>X</td></tr><tr><td>Soft Br. Shale</td><td>51</td><td>59</td><td></td></tr><tr><td>Hard Br. Shale</td><td>59</td><td>61</td><td></td></tr><tr><td>Hard Blue Schist</td><td>61</td><td>83</td><td></td></tr><tr><td>Br. Schist</td><td>83</td><td>84</td><td>X</td></tr><tr><td>Hard Blue/Blk Schist</td><td>84</td><td>247</td><td></td></tr><tr><td>Blue Schist</td><td>247</td><td>248</td><td>X</td></tr><tr><td>Hard Blue/Blk Schist</td><td>248</td><td>316</td><td></td></tr><tr><td>Green Schist</td><td>316</td><td>317</td><td></td></tr><tr><td>Hard Blue Schist</td><td>317</td><td>338</td><td></td></tr><tr><td>Green Schist</td><td>338</td><td>339</td><td></td></tr><tr><td>Hard Blue Schist</td><td>339</td><td>355</td><td></td></tr></tbody></table>				DESCRIPTION (Use additional sheets if needed)	FEET		check if water bearing	FROM	TO	Dirt	0	1		Soft Br. Shale	1	14		Opening	14	15	X	Soft Br. Shale	15	48		Gravel/Br. Shale	48	51	X	Soft Br. Shale	51	59		Hard Br. Shale	59	61		Hard Blue Schist	61	83		Br. Schist	83	84	X	Hard Blue/Blk Schist	84	247		Blue Schist	247	248	X	Hard Blue/Blk Schist	248	316		Green Schist	316	317		Hard Blue Schist	317	338		Green Schist	338	339		Hard Blue Schist	339	355		CASING RECORD casing types insert appropriate code below <table border="1" style="width:100%; border-collapse: collapse;"><tr><td><u>ST</u> STEEL</td><td><u>CO</u> CONCRETE</td></tr><tr><td><u>PL</u> PLASTIC</td><td><u>OT</u> OTHER</td></tr></table> MAIN CASING TYPE <u>ST</u> Nominal diameter top (main) casing (nearest inch) <u>6</u> Total depth of main casing (nearest foot) <u>82</u> EACH CASING diameter inch depth (feet) from to				<u>ST</u> STEEL	<u>CO</u> CONCRETE	<u>PL</u> PLASTIC	<u>OT</u> OTHER
					DESCRIPTION (Use additional sheets if needed)	FEET		check if water bearing																																																																									
FROM	TO																																																																																
Dirt	0	1																																																																															
Soft Br. Shale	1	14																																																																															
Opening	14	15	X																																																																														
Soft Br. Shale	15	48																																																																															
Gravel/Br. Shale	48	51	X																																																																														
Soft Br. Shale	51	59																																																																															
Hard Br. Shale	59	61																																																																															
Hard Blue Schist	61	83																																																																															
Br. Schist	83	84	X																																																																														
Hard Blue/Blk Schist	84	247																																																																															
Blue Schist	247	248	X																																																																														
Hard Blue/Blk Schist	248	316																																																																															
Green Schist	316	317																																																																															
Hard Blue Schist	317	338																																																																															
Green Schist	338	339																																																																															
Hard Blue Schist	339	355																																																																															
<u>ST</u> STEEL	<u>CO</u> CONCRETE																																																																																
<u>PL</u> PLASTIC	<u>OT</u> OTHER																																																																																
<table border="1" style="width:100%; border-collapse: collapse;"><thead><tr><th>screen type or open hole</th><th colspan="2">SCREEN RECORD</th></tr></thead><tbody><tr><td>insert appropriate code below</td><td><u>ST</u> STEEL</td><td><u>BR</u> BRASS</td></tr><tr><td></td><td><u>PL</u> PLASTIC</td><td><u>OT</u> OTHER</td></tr></tbody></table>				screen type or open hole	SCREEN RECORD		insert appropriate code below	<u>ST</u> STEEL	<u>BR</u> BRASS		<u>PL</u> PLASTIC	<u>OT</u> OTHER	C3 PUMPING TEST HOURS PUMPED (nearest hour) <u>3</u> PUMPING RATE (gal. per min.) <u>8.5</u> METHOD USED TO MEASURE PUMPING RATE <u>submersible</u> WATER LEVEL (distance from land surface) BEFORE PUMPING <u>14</u> ft. WHEN PUMPING <u>227</u> ft. TYPE OF PUMP USED (for test) <u>A</u> air <u>P</u> piston <u>T</u> turbine <u>C</u> centrifugal <u>R</u> rotary <u>O</u> other (describe below) <u>J</u> jet <u>S</u> submersible																																																																				
				screen type or open hole	SCREEN RECORD																																																																												
insert appropriate code below	<u>ST</u> STEEL	<u>BR</u> BRASS																																																																															
	<u>PL</u> PLASTIC	<u>OT</u> OTHER																																																																															
NUMBER OF UNSUCCESSFUL WELLS: <u>0</u>				C2 DEPTH (nearest ft.) H <u>82</u> <u>355</u> E A C H 8 9 11 15 17 21 S 23 24 26 30 32 36 C 3 38 39 41 45 47 51 R E E N SLOT SIZE 1 2 3 DIAMETER OF SCREEN (NEAREST INCH) <u>56</u> <u>60</u> from to																																																																													
WELL HYDROFRACTURED <u>Y</u> <u>N</u> CIRCLE APPROPRIATE LETTER A A WELL WAS ABANDONED AND SEALED WHEN THIS WELL WAS COMPLETED E ELECTRIC LOG OBTAINED P TEST WELL CONVERTED TO PRODUCTION WELL I HEREBY CERTIFY THAT THIS WELL HAS BEEN CONSTRUCTED IN ACCORDANCE WITH COMAR 26.04.04 "WELL CONSTRUCTION" AND IN CONFORMANCE WITH ALL CONDITIONS STATED IN THE ABOVE CAPTIONED PERMIT, AND THAT THE INFORMATION PRESENTED HEREIN IS ACCURATE AND COMPLETE TO THE BEST OF MY KNOWLEDGE. DRILLERS LIC. NO. <u>MWD 2961</u> DRILLERS SIGNATURE <u>Ronald Kyker</u> (MUST MATCH SIGNATURE ON APPLICATION) LIC. NO. <u>MWD 3341</u> SITE SUPERVISOR (sign. of driller or journeyman responsible for sitework if different from permittee) <u>[Signature]</u>				GRAVEL PACK IF WELL DRILLED WAS FLOWING WELL INSERT F IN BOX 68 MDE USE ONLY (NOT TO BE FILLED IN BY DRILLER) (E.R.O.S.) T <u>70</u> W Q <u>72</u> TELESCOPE CASING LOG INDICATOR OTHER DATA																																																																													

LOCATION OF WELL ON LOT
SHOW PERMANENT STRUCTURE SUCH AS BUILDING, SEPTIC TANKS, AND/OR LANDMARKS AND INDICATE NOT LESS THAN TWO DISTANCES (MEASUREMENTS TO WELL)

Existing well
Need measurements to new well