

Tax ID - 04-351452

NEEDS CAP ON CLEANOUT
HOUSE

PERMIT

SEWAGE DISPOSAL SYSTEM

DEPARTMENT OF HEALTH AND MENTAL HYGIENE

INDEXED

HOWARD COUNTY HEALTH DEPARTMENT

BUREAU OF ENVIRONMENTAL HEALTH

461-9933

P 47140

A 42813

DISTRICT 4th

DATE 5/23/91

DATE SYSTEM APPROVED 7/24/91

INSPECTOR C.F.O.

Barnes Excavation IS PERMITTED TO INSTALL ☒ ALTER

ADDRESS PHONE

SUBDIVISION Camden Downs LOT 11 ROAD 15616 Thistle Downs Court

PROPERTY OWNER Thomas E. & Phyllis T. Page

ADDRESS

SEPTIC TANK CAPACITY 1500 GALLONS

NUMBER OF BEDROOMS 5

210 SQUARE FEET PER BEDROOM

LINEAR FEET OF TRENCH REQUIRED 210

TRENCHES - 210 sq. ft. per bedroom. Trench to be 2.0 feet wide. Inlet 3.0 feet below original grade. Bottom maximum depth 8.0 feet below original grade. Effective area begins at 3.0 feet below original grade. 5.0 feet of stone below distribution pipe.

LOCATION - Place the distribution box 135 feet off the front (221.44') lot line and 100 ft. off the left (178.69') lot line, as seen when facing the lot from Thistle Downs Court. Run trenches on contour toward the right (537.80') and left (178.69') lot lines. Maintain a minimum of 100 feet from all nearby wells.

NOTE - No trench to exceed 100 feet in length. Provide 6" - 8" diameter cleanout and cap to grade or above on septic tank. OK 3/15/91 RH

PLANS APPROVED BY Jane E. Nadeau cm DATE 01/08/90

COVER NO WORK UNTIL INSPECTED AND APPROVED

NEITHER THE HOWARD COUNTY COUNCIL NOR THE HEALTH DEPARTMENT IS RESPONSIBLE FOR THE SUCCESSFUL OPERATION OF ANY SYSTEM

NOTE: CLEANOUT REQUIRED EVERY 70 FEET OF SEWER LINE AND/OR AT 90° SWEEPS IN LINES FROM HOUSE TO DRAIN FIELDS, 90° ELBOWS NOT ACCEPTABLE.

NOTE: ALL PARTS OF SEPTIC SYSTEMS (I.E. TANK, DISTRIBUTION BOX TRENCHES) TO BE 100 FEET FROM WELL (UNLESS OTHERWISE SPECIFICALLY AUTHORIZED)

NOTE: IF DEEP TRENCH(ES) ARE USED CALL FOR INSPECTION BEFORE AND AFTER PLACING GRAVEL IN TRENCH(ES)

NOTE: NO DRY WELL SHALL EXCEED 15 FOOT IN DIAMETER NO ABSORPTION TRENCH TO EXCEED 100 FEET IN LENGTH

NOTE: ALL PIPE FROM HOUSE TO SEPTIC TANK MUST BE CAST IRON OR SCHEDULE 35/40 PVC OR ABS

PERMIT VOID AFTER TWO YEARS


NOTE: INSTALL STAND PIPE ON SEPTIC TANK AND DRY WELL STAND PIPES MUST BE 6 INCHES IN DIAMETER CAST IRON. CONCRETE OR TERRA COTTA OR PVA OR ABS ACCEPTED. IF TOP OF SEPTIC TANK IS DEEPER THAN 3 FEET. MANHOLE TO GRADE REQUIRED.

NOTE: DISTRIBUTION BOXES MUST HAVE BAFFLES

*INSTALLER IS RESPONSIBLE FOR OBTAINING FINAL APPROVAL ON THIS PERMIT

BLDG. PERMIT REVIEW
AND RETURNED 7/5/91
300131351 - deck w/step
down & w stair case
4/21/03 300141354 - ADDITION ABOVE
GARAGE

42813

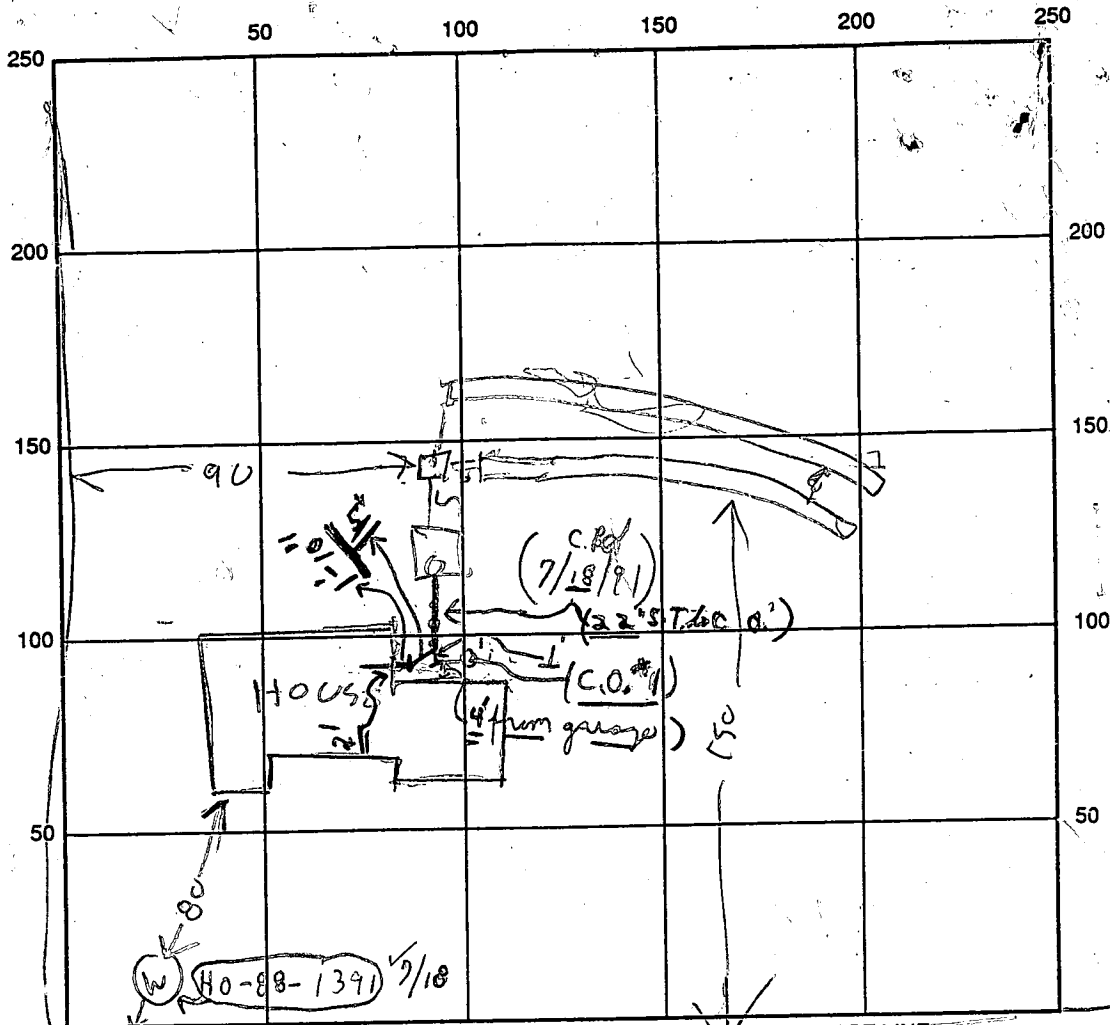

SEPTIC TANK LEVEL 150V CLEANOUTS (C.O. #1) 7/18/91
 DISTRIBUTION BOX LEVEL all covered 7/18/91
 DRAIN FIELD/TITLE DEPTH 2.5/0.5 FT. TRENCH WIDTH 2 FT. INLET DEPTH 3 1/2 FT.
 EFFECTIVE GRAVEL DEPTH 4 FT. TOTAL LENGTH 107/107 FT.
 NUMBER OF TRENCHES 2 ONE SIDEWALL/BOTTOM AREA 1070 SQ. FT.
 DRYWALL INSIDE DIAMETER FT. EFFECTIVE DEPTH BELOW INLET FT.
 ABSORBENT AREA SQ. FT.

REMARKS: 6/21/91 LOCATION OK OK TO HAVE 2 TRENCHES
RUNNING TOWARD RIGHT LOT LINE ADD STONE
TO TRENCHES HOOK UP TANK & CALL RH

6/21/91 - TRENCHES OK CALL FOR INSPECTION OF
HOUSE HOOK UP WHEN READY RIL 6/22/91 PM - NOTHING DONE RH

7/18/91 HOUSE CONNECTION OK Needs cap @ C.O. near home - Patrick

DATE SYSTEM APPROVED 7/24/91 INSPECTOR Charles, Ryan Street

NOTE: 7/18/91 (P.M.) W.P.I. Line + Pathless Adapter - ok No permit
in folder C.B.D. ① LEFT CARD AT WATER WELL; ② LEFT CARD AT GARAGE DOOR

APPLICATION

PERCOLATION TESTING

A 42813

P _____

HOWARD COUNTY HEALTH DEPARTMENT
BUREAU OF ENVIRONMENTAL HEALTH
P.O. BOX 476 ELLICOTT CITY, MARYLAND 21043
TELEPHONE: 461-9933

DISTRICT 44h

DATE 8/16/88

TO: THE COUNTY HEALTH OFFICER
ELLICOTT CITY, MARYLAND

I, HEREBY, APPLY FOR THE NECESSARY TEST IN ORDER TO CONSTRUCT (OR RECONSTRUCT) A SEWAGE DISPOSAL SYSTEM.

PROPERTY OWNER Carrie Lee Hutchins Thomas E. & Phyllis T. Page

ADDRESS 830 Morgan Station Road, Woodbine MD 21797 PHONE 301-277-9411

PROSPECTIVE BUYER Potomac Development Company

ADDRESS 1015 Copperstone Ct., Rockville, MD 20852 PHONE 424-6006

PROPERTY LOCATION:

SUBDIVISION Camden Downs LOT NO. 11

ROAD AND DESCRIPTION Old Frederick Road and Morgan Station Road
(15616 Thistle Downs Court)

TAX MAP 8 PARCEL # 1

SIZE OF LOT 3.00 Acres TYPE BLDG. SFD
(SINGLE FAMILY DWELLING OR COMMERCIAL)

THE SYSTEM INSTALLED UNDER THIS APPLICATION IS ACCEPTABLE ONLY UNTIL PUBLIC FACILITIES BECOME AVAILABLE. I FULLY UNDERSTAND THE

FEE CONNECTED WITH THE FILING OF THIS PERC TEST APPLICATION IS NON-REFUNDABLE UNDER ANY CIRCUMSTANCES. I ALSO AGREE TO COMPLY

WITH ALL M.O.S.H.A. REQUIREMENTS IN TESTING THIS LOT.

Gregory B. Powell
(SIGNATURE OF APPLICANT)

APPROVED BY _____ FOR _____ DATE _____

REJECTED BY _____ FOR _____ DATE _____

HOLD PENDING FURTHER TESTS _____ DATE _____

REASONS FOR REJECTION OR HOLDING 1-24-89 Per SATISFACTORY hold for PERC'S SELL

BLDG. PERMIT SIGNED
AND RETURNED 3/8/91


Serial # 36734 - SFD
4 Bedrooms

THIS IS NOT A PERMIT

A.42813

SOIL PROFILE

8"	AP
	RED BROWN CLAY LOAM 10-15% FRAP
3.5 4.0	YELLOW RED TO YELLOW BROWN SILTY LOAM 15-25% FRAP
13"	

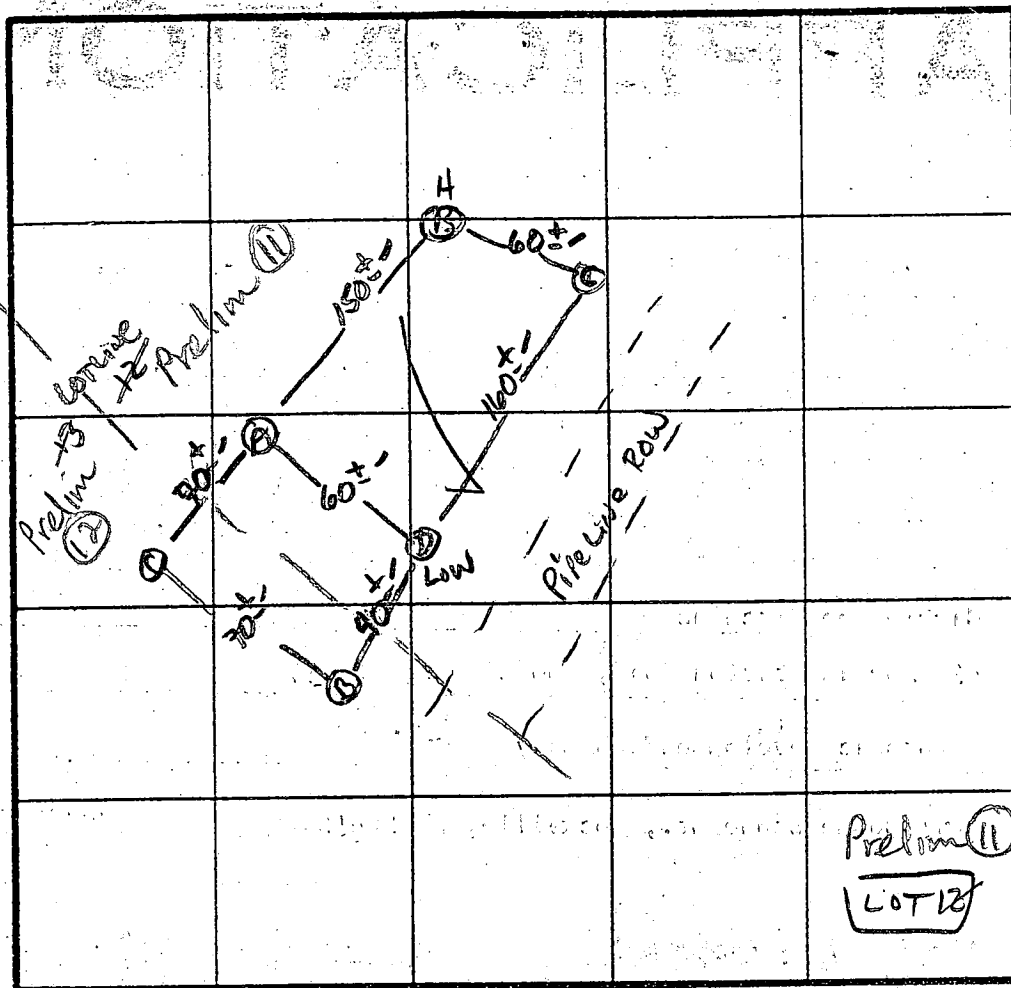

X Perc 10 MIN

210 #/BL

Inlet 3.5

Bottom 8.5

Requires 3.5-7.5'

Prelim 11
LOT 12

INDICATE NORTH - NAME ADJOINING ROADWAY AS BASE LINE

OLD FRED Rd.

DATE	TEST NO.	DEPTH -'	PRE-WET		TEST - 1" DROP		TIME
			START	STOP	START	STOP	
1/24/89	S CV	4.5 - 13 -	10:23 As profiled	10:29	10:29	10:40	11 min
	B BM	4 - 7.5 -	10:25 10:28	10:28 10:29	10:28 10:29	10:35 10:33	7 min 4 min
	B V	13 -	Similar to Profile				
	A V	12.5 -	10:35 Same as #D	10:39	10:39	10:50	11 min
	D V	4 - 12.5 -	10:37 Similar to Profile	10:44	10:44	10:59	15 min



REMARKS Holes Approx to Plat as Staked

TYPE OF SOIL Chester Loam

TESTED BY S. Abel

ALSO PRESENT

Phil

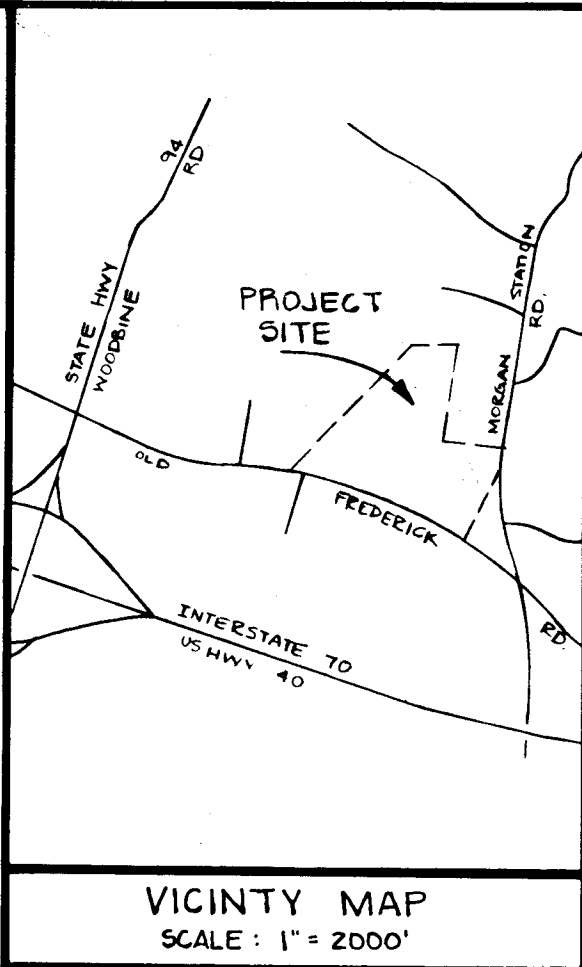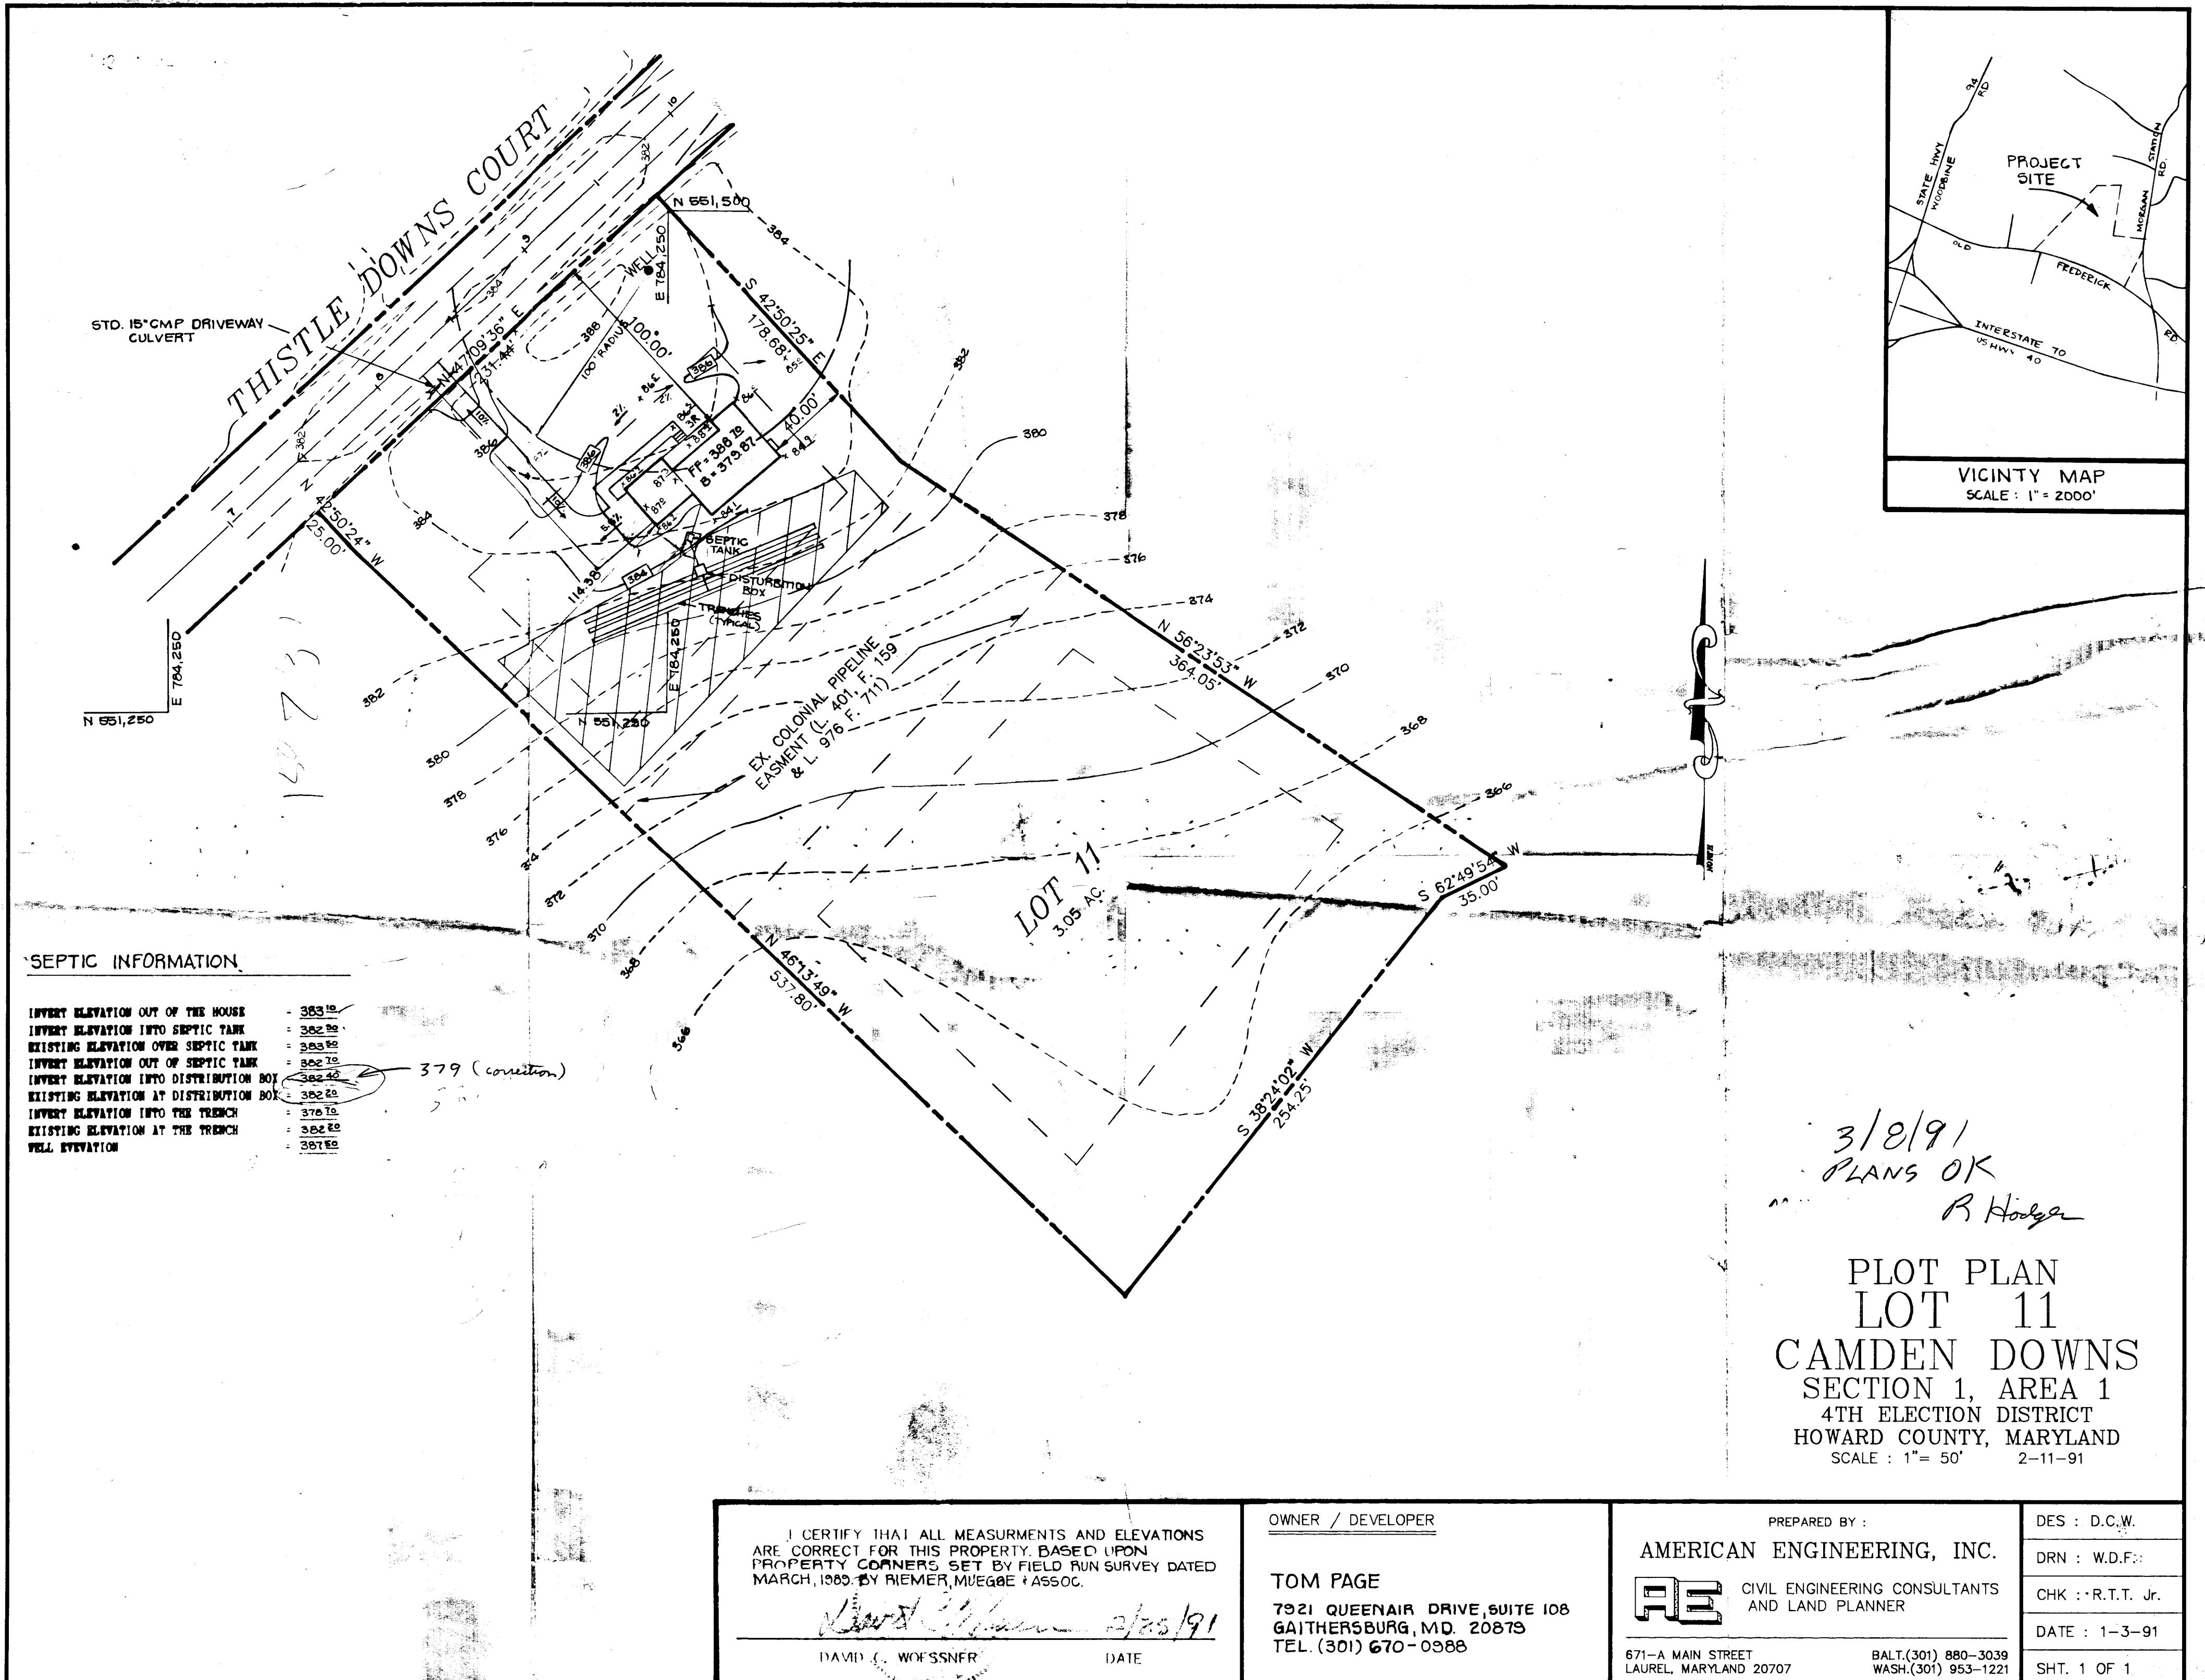

SEPTIC INFORMATION

INVERT ELEVATION OUT OF THE HOUSE	= 363.10
INVERT ELEVATION INTO SEPTIC TANK	= 362.80
EXISTING ELEVATION OVER SEPTIC TANK	= 363.50
INVERT ELEVATION OUT OF SEPTIC TANK	= 362.70
INVERT ELEVATION INTO DISTRIBUTION BOX	= 362.40
EXISTING ELEVATION AT DISTRIBUTION BOX	= 362.20
INVERT ELEVATION INTO THE TRENCH	= 370.10
EXISTING ELEVATION AT THE TRENCH	= 362.20
WELL ELEVATION	= 367.00

3/8/91
PLANS OK
R. Hodges

PLOT PLAN
LOT 11
CAMDEN DOWNS
SECTION 1, AREA 1
4TH ELECTION DISTRICT
HOWARD COUNTY, MARYLAND
SCALE : 1"= 50' 2-11-91

I CERTIFY THAT ALL MEASUREMENTS AND ELEVATIONS ARE CORRECT FOR THIS PROPERTY, BASED UPON PROPERTY CORNERS SET BY FIELD RUN SURVEY DATED MARCH, 1989, BY RIEMER, MUEGGE & ASSOC.

DAVID C. WOESSNER

DATE

OWNER / DEVELOPER

TOM PAGE

7921 QUEENAIR DRIVE, SUITE 108
GAITHERSBURG, MD. 20879
TEL. (301) 670-0988

PREPARED BY :

AMERICAN ENGINEERING, INC.



CIVIL ENGINEERING CONSULTANTS
AND LAND PLANNER

671-A MAIN STREET
LAUREL, MARYLAND 20707

BALT.(301) 880-3039
WASH.(301) 953-1221

DES : D.C.W.

DRN : W.D.F.

CHK : R.T.T. Jr.

DATE : 1-3-91

SHT. 1 OF 1

LOT 2
3.004 acres

LOT 3
3.015 acres

LOT 4
3.014 acres

THISTLE

DOWN

COURT

323.96'

N 47°09'36" E

235.91'

235.00'

402

403

404

405

LOT 10

FOR CON
SEE SHE

LOT 13
4.132 acres

LOT 12
3.144 acres

LOT 11
3.051 acres

LOT 16

LOT 15

LOT 14

FOR CONTINUATION SEE SHEET 4 OF 4

□ DENOTES 4" X 4" X 36" CONCRETE MONUMENT

● DENOTES 1/2" Ø PIPE OR IRON PIN SET

RIEMER M

3105

ELLICOTT

THISTLE DOWNS COURT

6/6/01 MR

W/OWNERS
AUGER HOLES DUG,
NOT SUFF FOR
DECISION

301-948
2793
Tom Page fax
6/28/01 EX. S.S.
INSTALLED AS SHOWN
w/HANDSKETCH. OK TO
REMOVE SHADED AREA
FROM EX. SEWAGE
EASEMENT; ~10,400' REMAINS MR

DECK OK AS
SHOWN MR
7/5/01

LOT 11
3.05 AC.

~~MR~~

307-948

2793

Tom Page fax

6/28/07 EX. S.S.
INSTALLED AS SHOWN
w/ HANDSKETCH. OK TO
REMOVE SHADED AREA
FROM EX. SEWAGE
EASEMENT; ~10,400 SF
REMAINS (MD)

MR

DECK OK AS
SHOWN (MR)

MR

7/5/01

LOT 11

3.05 AC.

DEPARTMENT OF INSPECTIONS, LICENSES AND PERMITS 3430 COURT HOUSE DRIVE ELLICOTT CITY, MD 21043 PERMITS (410) 313-2455 INSPECTIONS (410) 313-1810 AUTOMATED INFORMATION (410) 313-3800	HOWARD COUNTY PERMIT APPLICATION	PERMIT NUMBER B00131351
---	-------------------------------------	-----------------------------------

Building Address <u>15616 Thistle Downs Ct.</u> <u>Woodbine Md 21797</u>	Property Owner's Name <u>Thomas Page</u> Address <u>15616 Thistle Downs Ct.</u> City <u>Woodbine</u> State <u>Md</u> Zip Code <u>21797</u> Home Phone <u>301 854-6178</u> Work Phone <u>301 948-5611</u> Applicant's Name & Mailing Address, (if other than stated hereon):
Suite/Apt. #: _____ SDP/WP/Petition #: _____ Census Tract <u>6040</u> Subdivision <u>Camden Downs</u> Section _____ Area _____ Lot <u>11</u> Tax Map <u>8</u> Parcel <u>237</u> Grid <u>1</u> Zoning <u>RC</u> Map Coordinates <u>3H8</u> Lot size _____	Phone _____ Fax _____
Existing Use <u>SFD</u> Proposed Use <u>New Deck</u> Estimated Construction Cost \$ <u>13500</u> Description of Work <u>New Deck 10' x 20' w/</u> <u>with step down + 18' x 14' w/</u> <u>10' stone case</u>	Contractor Company <u>Owner</u> Contact Person _____ Address _____ City _____ State _____ Zip Code _____ License No. _____ Phone _____ Fax _____
Occupant or Tenant _____ Contact Name _____ Address _____ City _____ State _____ Zip Code _____ Phone _____ Fax _____	Engineer or Architect Company <u>N/A</u> Contact Person _____ Address _____ City _____ State _____ Zip Code _____ Phone _____ Fax _____

BUILDING DESCRIPTION - <u>COMMERCIAL</u>		BUILDING DESCRIPTION - <u>RESIDENTIAL</u>	
Building Characteristics Height: _____ No. of stories: _____ Gross area, sq. ft. per floor: _____ Use group: _____ Construction type: ☐ Reinforced Concrete ☐ Structural Steel ☐ Masonry ☐ Wood Frame ☐ State Certified Modular	Utilities Water Supply: ☐ Public ☐ Private Sewage Disposal: ☐ Public ☐ Private Electric Yes ☐ No ☐ Gas Yes ☐ No ☐ Heating System: Electric ☐ Oil ☐ Natural Gas ☐ Propane Gas ☐ Sprinkler system: <u>N/A</u> ☐ ☐ Full ☐ Partial ☐ Other Suppression # of Heads _____	Building Characteristics SF Dwelling ☒ SF Townhouse ☐ Depth _____ Width _____ 1st floor: _____ 2nd floor: _____ Basement: _____ Finished Basement ☒ Unfinished Basement ☐ Crawl space ☐ Slab on Grade ☐ No. of Bedrooms <u>3</u> Multi-family dwellings: No. of efficiency units: _____ No. of 1 BR units: _____ No. of 2 BR units: _____ No. of 3 BR units: _____ Other Structure: _____ Dimensions: _____ Footings: _____ Roof: _____ ☒ State Certified Modular ☐ Manufactured Home	Utilities Water Supply: ☒ Public ☐ Private Sewage Disposal: ☐ Public ☒ Private Electric Yes ☒ No ☐ Gas Yes ☐ No ☐ Heating System: Electric ☐ Oil ☒ Natural Gas ☐ Propane Gas ☐ Sprinkler system: <u>N/A</u> ☐ ☐ NFPA #13D ☐ NFPA #13R ☐ Other:

I, THE UNDERSIGNED HEREBY CERTIFIES AND AGREES AS FOLLOWS: (1) THAT HE/SHE IS AUTHORIZED TO MAKE THIS APPLICATION; (2) THAT THE INFORMATION IS CORRECT; (3) THAT HE/SHE WILL COMPLY WITH ALL REGULATIONS OF HOWARD COUNTY WHICH ARE APPLICABLE THEREON; (4) THAT HE/SHE WILL PERFORM NO WORK ON THE ABOVE REFERENCED PROPERTY NOT SPECIFICALLY DESCRIBED IN THIS APPLICATION; (5) THAT HE/SHE GRANTS COUNTY OFFICIALS THE RIGHT TO ENTER INTO THIS PROPERTY FOR THE PURPOSE OF INSPECTING THE WORK PERMITTED AND POSTING NOTICES.


Applicant's Signature Thomas E. Page Date 7/5/01
Title/Company _____

Checks payable to: **DIRECTOR OF FINANCE OF HOWARD COUNTY**
** PLEASE WRITE NEATLY AND LEGIBLY. **

FOR OFFICE USE ONLY			PROPERTY ID# <u>47267</u>	
AGENCY ☒ Land Development, DPZ ☐ State Highways ☒ Building Official ☒ Dev. Engineering, DPZ ☒ Health ☐ Fire Protection	DATE <u>7/5/01</u>	SIGNATURE APPROVAL <u>[Signature]</u>	DPZ SETBACK INFORMATION Front: _____ Rear: _____ Side: <u>75'</u> Side St.: <u>30'</u> All minimum setbacks met? YES ☐ NO ☒ Is Entrance Permit required? YES ☒ NO ☐ Historic District? YES ☐ NO ☒ Lot Coverage for NewTown Zone _____ SDP/Red-line approval date _____	PROPERTY ID# Filing fee \$ _____ Permit fee \$ _____ Excise tax \$ _____ Add'l per. fee \$ _____ TOTAL FEES \$ _____ Sub-total paid \$ _____ Balance due \$ _____ Check # <u>4188</u> Validation # <u>43474</u>
Is Sediment Control approval required prior to issuance? YES ☐ NO ☐ CONTINGENCY CONSTRUCTION START: ☐ ONE STOP SHOP: ☐			Accepted by <u>[Signature]</u>	
Distribution of Copies: White: Building Official Green: LDD, DPZ Yellow: DED, DPZ Pink: Health Gold: SHA			Rev. 5/17/00	

THISTLE DOWNS COURT

J.O. 91107

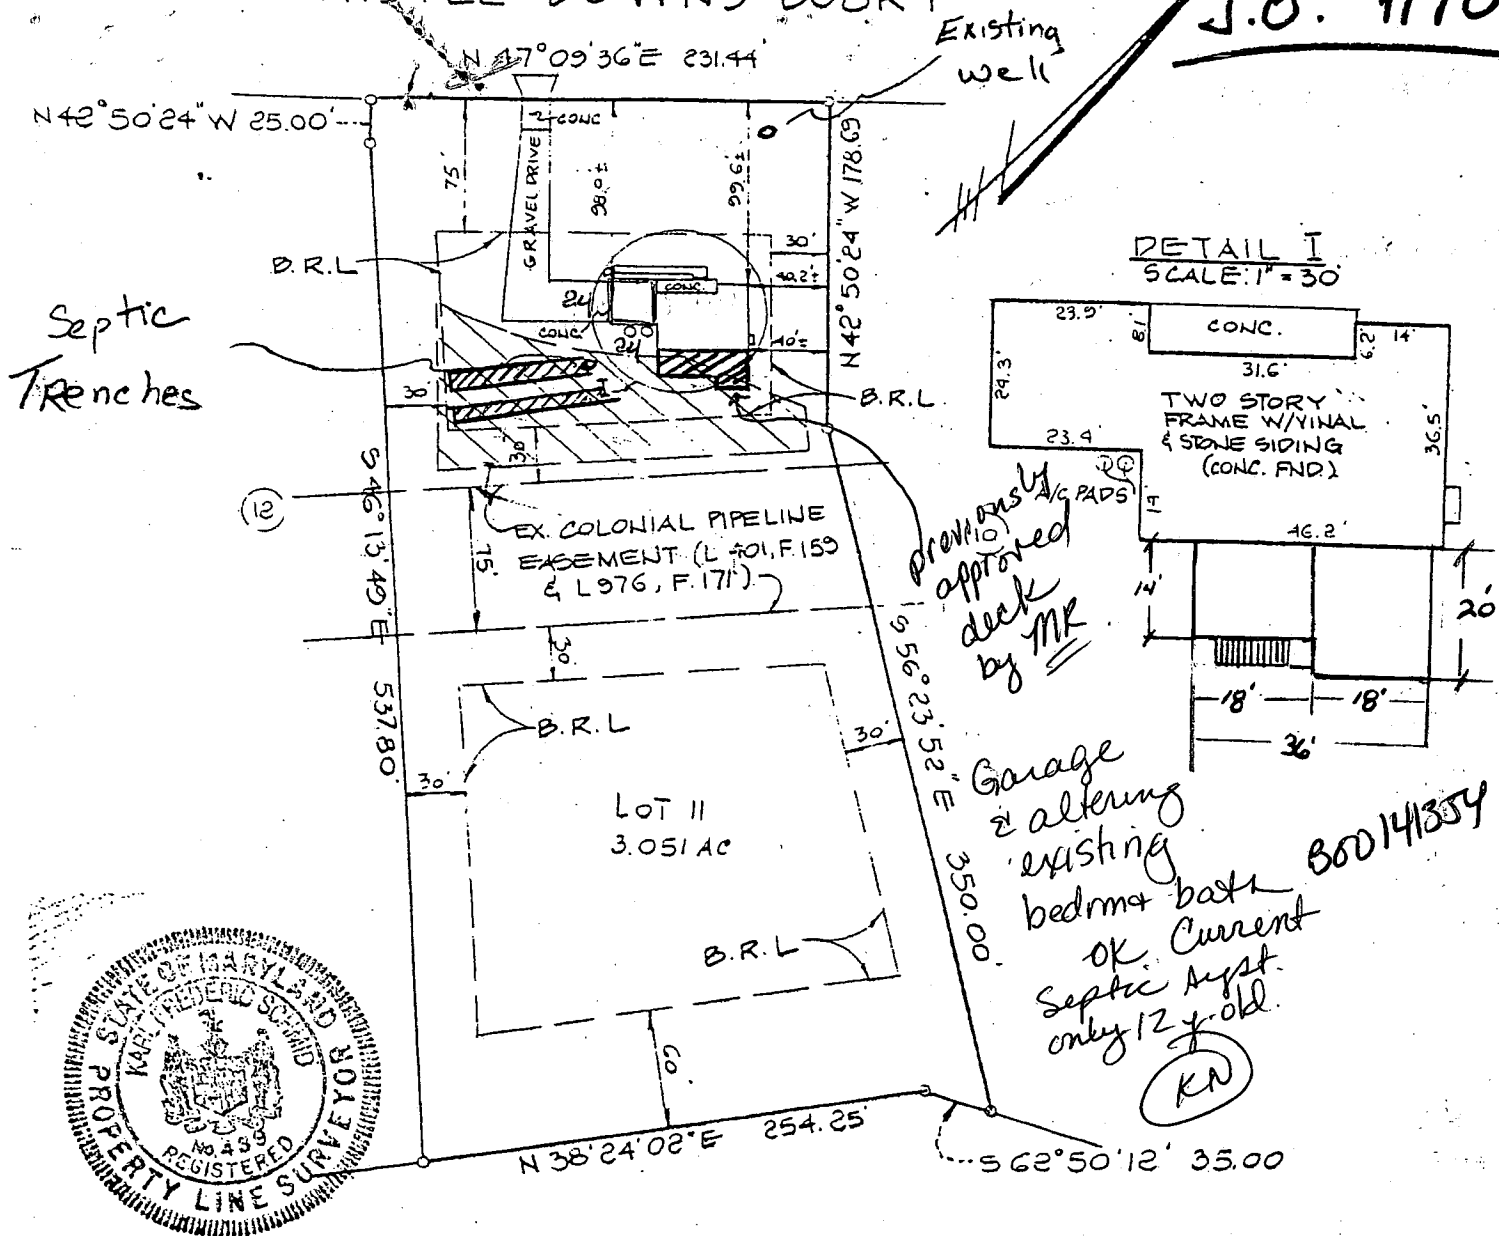

THIS IS TO CERTIFY that I have located the improvements on the lot shown hereon, and that said improvements exist, and that said improvements lie entirely within the boundaries.

Karl F. Schmidt 9-11-91

THIS PLAT NOT INTENDED FOR USE IN THE ESTABLISHMENT OF PROPERTY LINES

SUBJECT TO ALL MATTERS OF RECORD THAT A FULL AND COMPLETE TITLE SEARCH MIGHT REVEAL. SUBJECT ALSO TO ALL EASEMENTS AND SET BACK LINES AS DEPICTED EITHER GRAPHICALLY OR BY NOTE ON THE PLAT RECORDED IN PLAT # 3572 OF THE LAND RECORDS OF HOWARD COUNTY, MARYLAND.

LOT II SHOWN HEREON DOES NOT LIE WITHIN A FLOOD HAZARD AREA IN ACCORDANCE WITH THE DOCUMENT ENTITLED "DEPARTMENT OF HOUSING AND URBAN DEVELOPMENT - FEDERAL INSURANCE ADMINISTRATION - SPECIAL FLOOD HAZARD AREA MAPS".

CERTIFICATION SURVEY OF

LOT II
CAMDEN DOWNS

SECTION ONE

LOTS 1 THRU 21

HOWARD COUNTY, MARYLAND

PLAT # 3572





Harris, Smariga, Matz, Inc.

Planners/Engineers/Surveyors
104 Church Lane, Suite 100/Baltimore, MD 21208
(301) 486-1511

SCALE: 1" = 30'

SEPTEMBER 9, 1991

#40559

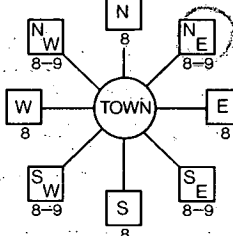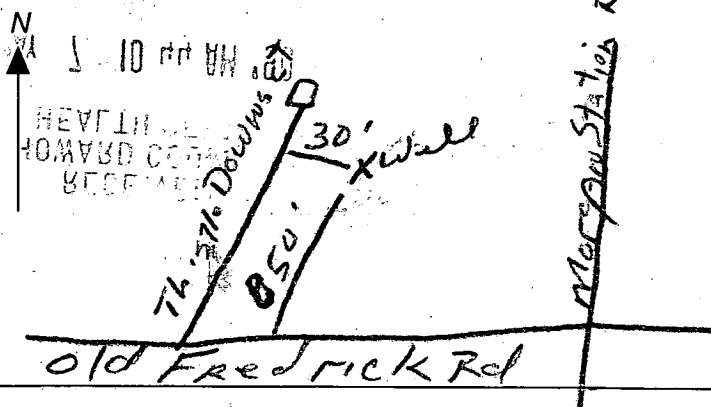B 1 9470 (THIS NUMBER IS TO BE PUNCHED IN COLS. 3-6-ON ALL CARDS)	SEQUENCE NO. (DP USE ONLY)	STATE OF MARYLAND APPLICATION FOR PERMIT TO DRILL WELL please print or type	STATE PERMIT NUMBER HD-88-1391 fill in this form completely
Date Received (APA) 050790 OWNER INFORMATION CAMDEN I DOWNS PARTNR 10805 HICKORY RIDGE RD COLUMBIA MD 21044		B 3 LOCATION OF WELL HOWARD 8 COUNTY CAMDEN DOWNS 23 SUBDIVISION SECTION 1 LOT 11 LISBON 52 NEAREST TOWN MILES FROM TOWN (enter 0 if in town) 2 MI	
DRILLER INFORMATION FRANK DELPH FRANK DELPH WELL DRILLERS INC 18234 PENN SHOP RD MH HAVEN MD FRANK Delph 5-2-90		B 4 DIRECTION OF WELL FROM TOWN (CIRCLE BOX)  Thistle Downs Ct NEAR WHAT ROAD ON WHICH SIDE OF ROAD (CIRCLE APPROPRIATE BOX) NORTH WEST EAST SOUTH 34 30 37 DISTANCE FROM ROAD ENTER FT OR MI FT	
B 2 WELL INFORMATION APPROX. PUMPING RATE (GAL. PER MIN.) 5 AVERAGE DAILY QUANTITY NEEDED (GAL. PER DAY) 500		NOT TO BE FILLED IN BY DRILLER HEALTH DEPARTMENT APPROVAL Howard COUNTY NAME COUNTY NO. STATE SIGNATURE DATE ISSUED 060690 Mark E. Rikkin 12/6/90 NORTH GRID 551000 EAST GRID 0784000 50 55 57 63	
USE FOR WATER (CIRCLE APPROPRIATE BOX) ☒ HOME (SINGLE OR DOUBLE HOUSEHOLD UNIT ONLY) ☐ FARMING (LIVESTOCK WATERING & AGRICULTURAL IRRIGATION) ☐ INDUSTRIAL, COMMERCIAL, STATE AND FEDERAL GOV. OTHER (REQUIRES APPROPRIATION PERMIT) ☐ PUBLIC OR PRIVATE WATER COMPANY (REQUIRES APPROPRIATION PERMIT AND STATE HEALTH DEPARTMENT APPROVAL) ☐ TEST, OBSERVATION, MONITORING (MAY REQUIRE APPROPRIATION PERMIT)		SHOW MAJOR FEATURES OF BOX & LOCATE WELL WITH AN X SOURCES OF DRILLING WATER 1. well 2. 3. WRITE THE BOX NUMBER FROM THE MAP HERE E 7864 N 5571	
APPROXIMATE DEPTH OF WELL 200 FEET APPROXIMATE DIAMETER OF WELL 6 INCH		6/8/90 PM MR 6/8/90 23' CASING 19' OPEN 5 BAGS 1' CASING A.C. GROUT NOT OBS'D 000 TAG	
METHOD OF DRILLING (circle one) BORED (or Augered) JETTED Jetted & DRIVEN AIR-ROTary AIR-PERCussion ROTARY (Hydraulic Rotary) CABLE REVERSE-ROTary Drive-POINT other		DRAW A SKETCH BELOW SHOWING LOCATION OF WELL IN RELATION TO NEARBY TOWNS AND ROADS AND GIVE DISTANCE FROM WELL TO NEAREST ROAD JUNCTION 	
REPLACEMENT OR DEEPEMED WELLS (CIRCLE APPROPRIATE BOX) ☒ THIS WELL WILL NOT REPLACE AN EXISTING WELL ☐ THIS WELL WILL REPLACE A WELL THAT WILL BE ABANDONED AND SEALED ☐ THIS WELL WILL REPLACE A WELL THAT WILL BE USED AS A STANDBY ☐ THIS WELL WILL DEEPEMED AN EXISTING WELL PERMIT NUMBER OF WELL TO BE REPLACED OR DEEPEMED (IF AVAILABLE)		Not to be filled in by driller (OEP USE ONLY) APPROP. PERMIT NUMBER GAP FORCE MR PERMIT No. HD-88-1391 SPECIAL CONDITIONS	

C1	1602	SEQUENCE NO. (DENV USE ONLY)	STATE OF MARYLAND WELL COMPLETION REPORT FILL IN THIS FORM COMPLETELY PLEASE PRINT OR TYPE		THIS REPORT MUST BE SUBMITTED WITHIN 45 DAYS AFTER WELL IS COMPLETED.	
					COUNTY NUMBER	A-42813
ST/CO USE ONLY DATE Received		DATE WELL COMPLETED		Depth of Well		
05-7-90		060890		22 165 26 (TO NEAREST FOOT)		

OWNER	Camden Downs Partnership		PERMIT NO.	FROM "PERMIT TO DRILL WELL"	
STREET OR RFD	last name	first name	TOWN	Lisbon	
SUBDIVISION	Camden Downs	SECTION	2	LOT	11

WELL LOG Not required for driven wells		
STATE THE KIND OF FORMATIONS PENETRATED, THEIR COLOR, DEPTH, THICKNESS AND IF WATER BEARING		
DESCRIPTION (Use additional sheets if needed)	FEET FROM TO	Check if water bearing
Top Soil	0 2	
Brown Shale	2 10	
Blue Shale	10 45	
Brown Shale	45 50	✓
Blue Shale	50 75	
Brown Shale	75 8	✓
Blue Shale	8 110	
Brown Shale	110 120	✓
Blue Shale	120 165	

GROUTING RECORD	
WELL HAS BEEN GROUTED (Circle Appropriate Box)	
TYPE OF GROUTING MATERIAL	
CEMENT ☒ CM	BENTONITE CLAY ☒ BC
NO. OF BAGS 5 NO. OF POUNDS 500	
GALLONS OF WATER 70	
DEPTH OF GROUT SEAL (to nearest foot)	
from 48 52 ft. to 54 58 ft. (enter 0 if from surface)	
CASING RECORD	
casing types insert appropriate code below	
STEEL ☒ ST CONCRETE ☒ CO	
PLASTIC ☒ PL OTHER ☒ OT	
MAIN CASING TYPE	
Nominal diameter top (main) casing (nearest inch)	
Total depth of main casing (nearest foot)	
60 61 63 64 66 67 70	
OTHER CASING (if used)	
diameter inch depth (feet) from to	
EACH CASING	
screen type or open hole	
insert appropriate code below	
STEEL ☒ ST BRASS ☒ BR OPEN HOLE ☒ HO	
BRONZE ☒ PL PLASTIC ☒ OT OTHER ☒ OT	

C2	
DEPTH (nearest ft.)	
1 110 11 142 17 21	
2 23 24 26 30 32 36	
3 38 39 41 45 47 51	
EACH SCREEN	
SLOT SIZE 1 2 3	
DIAMETER OF SCREEN (NEAREST INCH)	
from to	
GRAVEL PACK	
IF WELL DRILLED WAS FLOWING WELL INSERT FIN BOX 68	
OEP USE ONLY (NOT TO BE FILLED IN BY DRILLER)	
T (E.R.O.S.) WQ	
70 72 74 75 76	
TELESCOPE CASING LOG INDICATOR OTHER DATA	

C3	
PUMPING TEST	
HOURS PUMPED (nearest hour)	
PUMPING RATE (gal. per min. to nearest gal.)	
METHOD USED TO MEASURE PUMPING RATE	
WATER LEVEL (distance from land surface)	
BEFORE PUMPING	
WHEN PUMPING	
TYPE OF PUMP USED (for test)	
A air P piston T turbine	
C centrifugal R rotary O other (describe below)	
J jet S submersible	

PUMP INSTALLED	
DRILLER WILL INSTALL PUMP YES NO	
IF DRILLER INSTALLS PUMP, THIS SECTION MUST BE COMPLETED FOR ALL WELLS EXCEPT HOME USE	
TYPE OF PUMP INSTALLED	
PLACE (A,C,J,P,R,S,T,O) IN BOX - SEE ABOVE	
CAPACITY: GALLONS PER MINUTE (to nearest gallon)	
PUMP HORSE POWER	
PUMP COLUMN LENGTH (nearest ft.)	
CASING HEIGHT (circle appropriate box and enter casing height)	
LAND SURFACE (nearest foot)	

CIRCLE APPROPRIATE LETTER	
A A WELL WAS ABANDONED AND SEALED WHEN THIS WELL WAS COMPLETED	
E ELECTRIC LOG OBTAINED	
P TEST WELL CONVERTED TO PRODUCTION WELL	

I HEREBY CERTIFY THAT THIS WELL HAS BEEN CONSTRUCTED IN ACCORDANCE WITH COMAR 26.04.04 "WELL CONSTRUCTION" AND IN CONFORMANCE WITH ALL CONDITIONS STATED IN THE ABOVE CAPTIONED PERMIT, AND THAT THE INFORMATION PRESENTED HEREIN IS ACCURATE AND COMPLETE TO THE BEST OF MY KNOWLEDGE.	
DRILLERS IDENT. NO. 4153	
DRILLERS SIGNATURE (MUST MATCH SIGNATURE ON APPLICATION)	
SITE SUPERVISOR (sign of driller or journeyman responsible for sitework if different from permittee)	

COUNTY	
--------	--

LOCATION OF WELL ON LOT	
SHOW PERMANENT STRUCTURE SUCH AS BUILDING, SEPTIC TANKS, AND/OR LANDMARKS AND INDICATE NOT LESS THAN TWO DISTANCES (MEASUREMENTS TO WELL)	
Rt 301	
30' x well	
116'	
old road	