

PERMIT

SEWAGE DISPOSAL SYSTEM

MARYLAND STATE DEPARTMENT OF HEALTH

HOWARD COUNTY

BUREAU OF ENVIRONMENTAL HEALTH

461-9933

P 42603

A Repair

DISTRICT

DATE

DATE SYSTEM APPROVED

INSPECTOR

INDEXED

Jenkins Brothers

IS PERMITTED TO INSTALL ☒ ALTER ☐

ADDRESS

PHONE

SUBDIVISION

ROAD

LOT

PROPERTY OWNER

Burgoyne Frank

ADDRESS

11764 Triadelphia Rd.

IF GARBAGE GRINDER IS USED INCREASE SEPTIC TANK CAPACITY BY 50% AND ABSORPTION AREA BY 22%.

GARBAGE GRINDER?

YES

NO

SEPTIC TANK CAPACITY

1000

GALLONS

NUMBER OF BEDROOMS

Replace collapsed metal septic tank.

PLANS APPROVED BY

C. Williams

DATE 9/23/88

COVER NO WORK UNTIL INSPECTED AND APPROVED.

NEITHER THE HOWARD COUNTY COUNCIL NOR THE HEALTH DEPARTMENT IS RESPONSIBLE FOR THE SUCCESSFUL OPERATION OF ANY SYSTEM.

NOTE: CLEANOUT REQUIRED EVERY 70 FEET OF SEWER LINE AND/OR AT 90° SWEEPS IN LINES FROM HOUSE TO DRAIN FIELDS.

NOTE: ALL PARTS OF SEPTIC SYSTEMS (I.E., TANK, DISTRIBUTION BOX, TRENCHES) TO BE 100 FEET FROM WELL. (UNLESS OTHERWISE SPECIFICALLY AUTHORIZED)

NOTE: IF DEEP TRENCH(ES) ARE USED CALL FOR INSPECTION BEFORE AND AFTER PLACING GRAVEL IN TRENCH(ES).

NOTE: NO DRY WELL SHALL EXCEED 15 FOOT IN DIAMETER. NO ABSORPTION TRENCH TO EXCEED 100 FEET IN LENGTH.

NOTE: ALL PIPE FROM HOUSE TO SEPTIC TANK MUST BE CAST IRON OR SCHEDULE 40 PVC OR ABS.

PERMIT VOID AFTER TWO YEARS.


NOTE: INSTALL STAND PIPE ON SEPTIC TANK AND DRY WELL. STAND PIPES MUST BE 6 INCHES IN DIAMETER. CAST IRON, CONCRETE OR TERRA COTTA OR PVC OR ABS ACCEPTED. IF TOP OF SEPTIC TANK IS DEEPER THAN 3 FEET, MANHOLE TO GRADE REQUIRED.

NOTE: DISTRIBUTION BOXES MUST HAVE BAFFLES.

*INSTALLER IS RESPONSIBLE FOR OBTAINING FINAL APPROVAL ON THIS PERMIT

*CALL 461-9933 FOR INSPECTION OF SEPTIC SYSTEMS.

EH - 2-1186

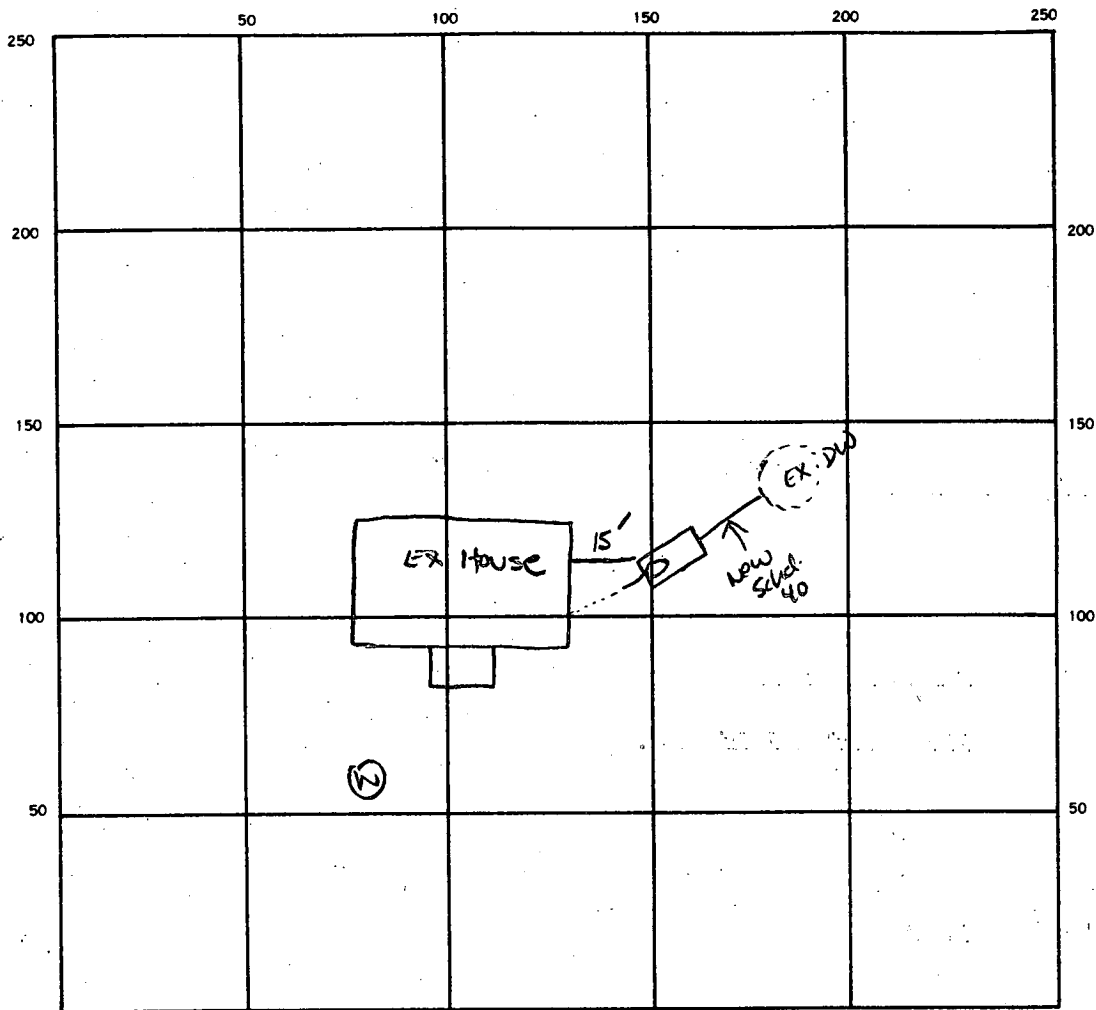

INDICATE NORTH. — NAME ADJOINING ROADWAY AS BASE LINE.

SEPTIC TANK LEVEL ✓ 1000 GA CLEANOUTS ✓

DISTRIBUTION BOX LEVEL _____

DRAIN FIELD/TILE FIELD DEPTH _____ FT. TRENCH WIDTH _____ FT. INLET DEPTH _____ FT.

EFFECTIVE GRAVEL DEPTH _____ FT. TOTAL LENGTH _____ FT.

NUMBER OF TRENCHES _____ ONE SIDEWALL/BOTTOM AREA _____ SQ. FT.

DRYWELL INSIDE DIAMETER _____ FT. EFFECTIVE DEPTH BELOW INLET _____ FT.

ABSORBENT AREA _____ SQ. FT.

REMARKS 9-29-88 - NEW TANK INSTALLED AND NEW PIPE (SCHED. 40) TANK TO DRYWELL

DATE SYSTEM APPROVED 9-29-88 INSPECTOR S. Noel

11/24/81
9:30

HO-73-4066

FILE Emergency Well Site Check DATE REPORTED 11/23/81
PROPERTY OWNER Edward Frank Sr.
P.O. ADDRESS 11764 Triadelphia Road TELEPHONE 286-2814
DIRECTIONS TO PROPERTY across from Franks Garage

INFORMANT Miss Mabel Frank (owners daughter) reports that water source is
a spring and has very low yield, they've spoken to Costley
Dill's re. drilling a new well
HO-73-4066 in permit # if site check in K-F.S.

CONDITION FOUND old spring has gone dry

ACTION TAKEN Locate well 40' from house + 20' from
driveway (over)

12/1/81 well grouted.

FINAL DISPOSITION

gas Pump
TANK

pu

DRAIN
FIELD


slightly
down grade
1' or 2'



to 16

120 → prepared well

190

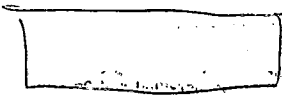

well

dry well



B 1	4920	SEQUENCE NO. (OEP USE ONLY)	STATE OF MARYLAND PERMIT TO DRILL WELL	OEP PERMIT NUMBER H0-73-4066
(THIS NUMBER IS TO BE PUNCHED IN COLS. 3-6 ON ALL CARDS)			please print or type	fill in this form completely

Date Received **12/18/81** (OEP Use Only)

OWNER INFORMATION

Last Name **Frank** Owner **Edward** 34 Name

11764 **Triadelphia Rd** 55

81110 **City** 76 Zip **21043**

LOCATION OF WELL

COUNTY **Howard**

SUBDIVISION

SECTION **23** LOT **48**

NEAREST TOWN **Marfield**

MILES FROM TOWN (enter 0 if in town) **1**

B 1 Continued DRILLER INFORMATION

George Easterday 77 License No. **80**

Firm Name **Franklin Easterday Inc**

Address **9265 Pimlico Church Rd Mt Airy Md**

Signature **George Easterday** Date **11-24-81**

B 4

DIRECTION OF WELL FROM TOWN (CIRCLE BOX)

ON WHICH SIDE OF ROAD (CIRCLE APPROPRIATE BOX)

DISTANCE FROM ROAD **1177**

SHOW MAJOR FEATURES OF BOX & LOCATE WELL WITH AN X

SOURCES OF DRILLING WATER

1. **PEC 81**

2. **WELL OK**

3. **SEE OTHER SIDE**

WRITE THE BOX NUMBER FROM THE MAP HERE

820 **530**

B 2 WELL INFORMATION

APPROX. PUMPING RATE (GAL. PER MIN.) **5**

AVERAGE DAILY QUANTITY NEEDED (GAL. PER DAY) **500**

USE FOR WATER (CIRCLE APPROPRIATE BOX)

☒ HOME (SINGLE OR DOUBLE HOUSEHOLD UNIT ONLY)

☐ FARMING (LIVESTOCK WATERING & AGRICULTURAL IRRIGATION)

☐ INDUSTRIAL, COMMERCIAL, STATE AND FEDERAL GOV. OTHER (REQUIRES APPROPRIATION PERMIT)

☐ PUBLIC OR PRIVATE WATER COMPANY (REQUIRES APPROPRIATION PERMIT AND STATE HEALTH DEPARTMENT APPROVAL)

☐ TEST, OBSERVATION, MONITORING (MAY REQUIRE APPROPRIATION PERMIT)

APPROXIMATE DEPTH OF WELL **150** FEET

APPROXIMATE DIAMETER OF WELL **6"** NEAREST INCH

METHOD OF DRILLING (circle one)

BORED (OR AUGERED) JETTED JETTED & DRIVEN

☒ AIR ROTARY ☐ AIR PERCUSSION ☐ ROTARY (HYDRAULIC ROTARY)

☐ CABLE ☐ REVERSE ROTARY ☐ DRIVE POINT

other

REPLACEMENT OR DEEPEINED WELLS (CIRCLE APPROPRIATE BOX)

☐ THIS WELL WILL NOT REPLACE AN EXISTING WELL

☐ THIS WELL WILL REPLACE A WELL THAT WILL BE ABANDONED AND SEALED

☒ THIS WELL WILL REPLACE A WELL THAT WILL BE USED AS A STANDBY

☐ THIS WELL WILL DEEPEIN AN EXISTING WELL

PERMIT NUMBER OF WELL TO BE REPLACED OR DEEPEINED (IF AVAILABLE) 41

Not to be filled in by driller (OEP USE ONLY)

APPROX. PERMIT NUMBER **GAP**

FORCE **ES** WRITE INITIALS IN BOX

PERMIT No. **H0-73-4066**

B 4 NOT TO BE FILLED IN BY DRILLER HEALTH DEPARTMENT APPROVAL


COUNTY NAME **HOWARD** COUNTY NO. **2**

OEP SIGNATURE **Frank Shuman** DATE ISSUED **11/20/81**

CO SIGNATURE **0822** EXPIRES **053082**

NORTH GRID **531** EAST GRID **0822**

B 5 SPECIAL CONDITIONS 8-63

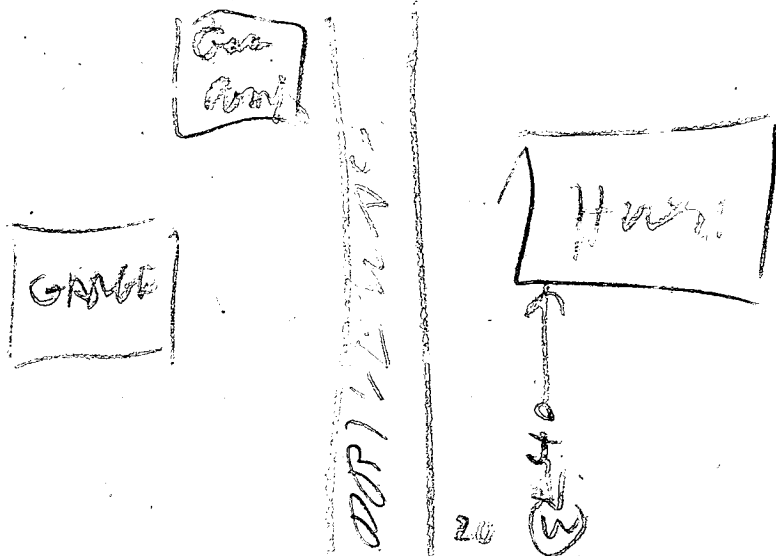

Frederick R.

1 DEC 81

- ① LOCATION OK
- ② 30 FT CASING 2 FT OUT OF GROUND
- ③ 28 FT OPEN HOLE
- ④ 9 BAGS
- ⑤ WELL OK

B. HODGES

C11351

SEQUENCE NO.
(OEP USE ONLY)

STATE OF MARYLAND
WELL COMPLETION REPORT
FILL IN THIS FORM COMPLETELY
PLEASE PRINT OR TYPE

THIS REPORT MUST BE SUBMITTED WITHIN
45 DAYS AFTER WELL IS COMPLETED.

COUNTY
NUMBER

PERMIT NO.

DATE RECEIVED
(OEP USE ONLY)

DATE WELL COMPLETED

Depth of Well

FROM "PERMIT TO DRILL WELL"

OWNER

STREET OR RFD

TOWN

SUBDIVISION

SECTION

LOT

WELL LOG		
Not required for driven wells		
STATE THE KIND OF FORMATIONS PENETRATED, THEIR COLOR, DEPTH, THICKNESS AND IF WATER BEARING		
DESCRIPTION (Use additional sheets if needed)	FEET	Check if water bearing
	FROM	TO
Topsoil	0	2
Clay	2	6
Shale	6	15
Brown slate	15	23
Mica schist	23	67
Brown slate	67	70
Mica schist	70	270
Flint	270	272
Mica schist	272	300

GRouting RECORD

WELL HAS BEEN GROUTED

TYPE OF GROUTING MATERIAL

CEMENT

BENTONITE CLAY

NO. OF BAGS

NO. OF POUNDS

GALLONS OF WATER

DEPTH OF GROUT SEAL (to nearest foot)

CASING RECORD

MAIN CASING TYPE

Nominal diameter

Total depth

OTHER CASING (if used)

SCREEN RECORD

screen type or openhole

DEPTH (nearest ft.)

SLOT SIZE

DIAMETER OF SCREEN

GRAVEL PACK

IF WELL DRILLED WAS FLOWING WELL CIRCLE BOX

OEP USE ONLY

TELESCOPE CASING

LOG INDICATOR

OTHER DATA

PUMPING TEST

HOURS PUMPED

PUMPING RATE

METHOD USED TO MEASURE PUMPING RATE

WATER LEVEL

BEFORE PUMPING

WHEN PUMPING

TYPE OF PUMP USED (for test)

PUMP INSTALLED

DRILLER WILL INSTALL PUMP

IF DRILLER INSTALLS PUMP, THIS SECTION MUST BE COMPLETED FOR ALL WELLS EXCEPT HOME USE

TYPE OF PUMP (WRITE APPROPRIATE LETTER IN BOX - SEE ABOVE)

CAPACITY: GALLONS PER MINUTE

PUMP HORSE POWER

PUMP COLUMN LENGTH

CASING HEIGHT

LAND SURFACE

LOCATION OF WELL ON LOT

SHOW PERMANENT STRUCTURE SUCH AS BUILDING, SEPTIC TANKS, AND/OR LANDMARKS AND INDICATE NOT LESS THAN TWO DISTANCES (MEASUREMENTS TO WELL)

CIRCLE APPROPRIATE BOX

A WELL WAS ABANDONED AND SEALED WHEN THIS WELL WAS COMPLETED

ELECTRIC LOG OBTAINED

TEST WELL CONVERTED TO PRODUCTION WELL

I HEREBY CERTIFY THAT THIS WELL HAS BEEN CONSTRUCTED IN ACCORDANCE WITH COMAR 10.17.13 "WELL CONSTRUCTION" AND IN CONFORMANCE WITH ALL CONDITIONS STATED IN THE ABOVE CAPTIONED PERMIT, AND THAT THE INFORMATION PRESENTED HEREIN IS ACCURATE AND COMPLETE TO THE BEST OF MY KNOWLEDGE.

DRILLERS IDENT. NO.

DRILLERS SIGNATURE

SITE SUPERVISOR

HEALTH

HOUSE

40'

35'

well