

5/12/91 11:00

PERMIT

SEWAGE DISPOSAL SYSTEM

DEPARTMENT OF HEALTH AND MENTAL HYGIENE

HOWARD COUNTY HEALTH DEPARTMENT
BUREAU OF ENVIRONMENTAL HEALTH
461-9933

INDEXED

05-410665

P 47560

A 43749

DISTRICT 5th

DATE 10/17/91

DATE SYSTEM APPROVED 8/22/91

INSPECTOR M. Rifkin

Jack Fyock, Jr. Septic Service

IS PERMITTED TO INSTALL ☒ ALTER

ADDRESS 13775 Triadelphia Road, Glenelg, Maryland 21737 PHONE 988-9270

SUBDIVISION Twelve Hills LOT 29 ROAD 13064 Twelve Hills Road

PROPERTY OWNER Seth Blom

ADDRESS

SEPTIC TANK CAPACITY 1250 GALLONS

NUMBER OF BEDROOMS 4

210 SQUARE FEET PER BEDROOM

LINEAR FEET OF TRENCH REQUIRED 210

TRENCHES - 210 sq. ft. bedrooms. Trench to be 2.0 feet wide. Inlet 3.0 feet below original grade. Bottom maximum depth 7.0 feet below original grade. Effective area begins at 3.0 feet below original grade. 4.0 feet of stone below distribution pipe.

LOCATION - Beginning at the right-of-way as seen when facing the lot from Twelve Hills Rd. place the distribution box 130 feet down the front lot line (515.02') and 120 ft. off the same line. Run trenches on contour toward the left front lot corner. Maintain 100 feet minimum from the well.

NOTE - No trench to exceed 100 feet in length. Provide 6" - 8" diameter cleanout and cap to grade or above on septic tank. OK 6/3/91 RH

PLANS APPROVED BY Jane E. Nadeau cm DATE 04/25/89

COVER NO WORK UNTIL INSPECTED AND APPROVED

NEITHER THE HOWARD COUNTY COUNCIL NOR THE HEALTH DEPARTMENT IS RESPONSIBLE FOR THE SUCCESSFUL OPERATION OF ANY SYSTEM

NOTE: CLEANOUT REQUIRED EVERY 70 FEET OF SEWER LINE AND/OR AT 90° SWEEPS IN LINES FROM HOUSE TO DRAIN FIELDS, 90° ELBOWS NOT ACCEPTABLE.

NOTE: ALL PARTS OF SEPTIC SYSTEMS (I.E. TANK, DISTRIBUTION BOX TRENCHES) TO BE 100 FEET FROM WELL (UNLESS OTHERWISE SPECIFICALLY AUTHORIZED)

NOTE: IF DEEP TRENCH(ES) ARE USED CALL FOR INSPECTION BEFORE AND AFTER PLACING GRAVEL IN TRENCH(ES)

NOTE: NO DRY WELL SHALL EXCEED 15 FOOT IN DIAMETER NO ABSORPTION TRENCH TO EXCEED 100 FEET IN LENGTH

NOTE: ALL PIPE FROM HOUSE TO SEPTIC TANK MUST BE CAST IRON OR SCHEDULE 35/40 PVC OR ABS


PERMIT VOID AFTER TWO YEARS

NOTE: INSTALL STAND PIPE ON SEPTIC TANK AND DRY WELL STAND PIPES MUST BE 6 INCHES IN DIAMETER CAST IRON. CONCRETE OR TERRA COTTA OR PVA OR ABS ACCEPTED. IF TOP OF SEPTIC TANK IS DEEPER THAN 3 FEET. MANHOLE TO GRADE REQUIRED.

NOTE: DISTRIBUTION BOXES MUST HAVE BAFFLES

*INSTALLER IS RESPONSIBLE FOR OBTAINING FINAL APPROVAL ON THIS PERMIT

A 43749

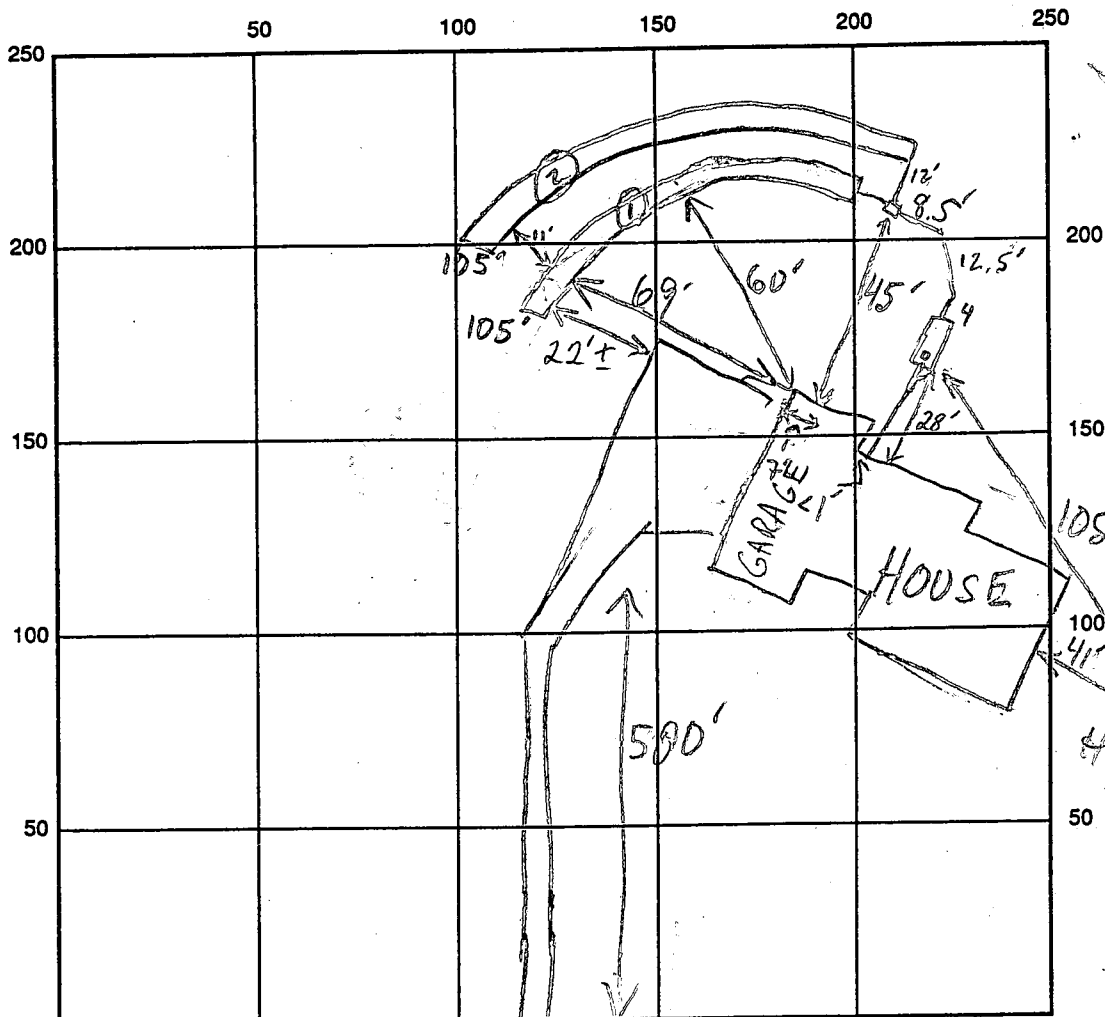

TWELVE HILLS RD

INDICATE NORTH - NAME ADJOINING ROADWAY AS BASE LINE

SEPTIC TANK LEVEL 1250 GAL-OK

CLEANOUTS OK

DISTRIBUTION BOX LEVEL OK-BAFFLE IN

DRAIN FIELD/TITLE DEPTH 1 1/2 FT.

TRENCH WIDTH 2 FT.

INLET DEPTH 1 1/2 FT.

EFFECTIVE GRAVEL DEPTH 4 1/4 FT.

TOTAL LENGTH 105 FT.

NUMBER OF TRENCHES 2

ONE SIDEWALL/BOTTOM AREA 0420 SQ. FT.

DRYWALL INSIDE DIAMETER — FT.

EFFECTIVE DEPTH BELOW INLET — FT.

ABSORBENT AREA 840 SQ. FT.

REMARKS: 8/22/91 #1 SDA HAD FILL COVER BY BUILDER, BUT WAS REMOVED (PER FYOCK); OK TO FINISH & COVER TRENCH ①, DIG TRENCH ② MR

8/22/91 #2 OK FINISH STONE & COVER MR

DATE SYSTEM APPROVED

8/22/91

INSPECTOR

M. R. R. R.

APPLICATION

PERCOLATION TESTING

HOWARD COUNTY HEALTH DEPARTMENT
BUREAU OF ENVIRONMENTAL HEALTH
P.O. BOX 476 ELLICOTT CITY, MARYLAND 21043
TELEPHONE: 461-9933

A 43749

P _____

DISTRICT 5TH

DATE 3-8-89

TO: THE COUNTY HEALTH OFFICER
ELLICOTT CITY, MARYLAND

I, HEREBY, APPLY FOR THE NECESSARY TEST IN ORDER TO CONSTRUCT (OR RECONSTRUCT) A SEWAGE DISPOSAL SYSTEM.

PROPERTY OWNER ~~ALTOGETHER LIMITED PARTNERSHIP~~ Seth Bloom

ADDRESS _____ PHONE _____

PROSPECTIVE BUYER _____

ADDRESS _____ PHONE _____

PROPERTY LOCATION:

SUBDIVISION 12 HILLS SECTION III LOT NO. 4 Preliminary RE-PERC

ROAD AND DESCRIPTION [13064 Twelve Hills Road] Lot-29 Final

TAX MAP _____ PARCEL # _____

SIZE OF LOT 3 AC TYPE BLDG. SFD
(SINGLE FAMILY DWELLING OR COMMERCIAL)

THE SYSTEM INSTALLED UNDER THIS APPLICATION IS ACCEPTABLE ONLY UNTIL PUBLIC FACILITIES BECOME AVAILABLE. I FULLY UNDERSTAND THE

FEE CONNECTED WITH THE FILING OF THIS PERC TEST APPLICATION IS NON-REFUNDABLE UNDER ANY CIRCUMSTANCES. I ALSO AGREE TO COMPLY

WITH ALL M.O.S.H.A. REQUIREMENTS IN TESTING THIS LOT. John C. Rea

(SIGNATURE OF APPLICANT)

APPROVED BY _____ FOR _____ DATE _____

REJECTED BY _____ FOR _____ DATE _____

HOLD PENDING FURTHER TESTS _____ DATE _____

REASONS FOR REJECTION OR HOLDING 3-9-89 Pending perc hole locations and

subdivision plat approval, etc.

BLDG. PERMIT SIGNED
AND RETURNED 5/30/91

37893/S.F. S 4/B...

THIS IS NOT A PERMIT

A 43749


(G)

SOIL PROFILE

0-2.0 Rd-br si cl sa lm
 2.0-6.0 Rd-br mica sa si lm
 6.0-11.5 White to brown mottled mica sa si lm
 Water at 10.5 ft
 11.5 Bottom

(H)

0-3.0 Rd-br si cl lm
 3.0-7.5 Tan mica sa si lm
 7.5-13.5 White mica sa si lm
 13.5 Bottom

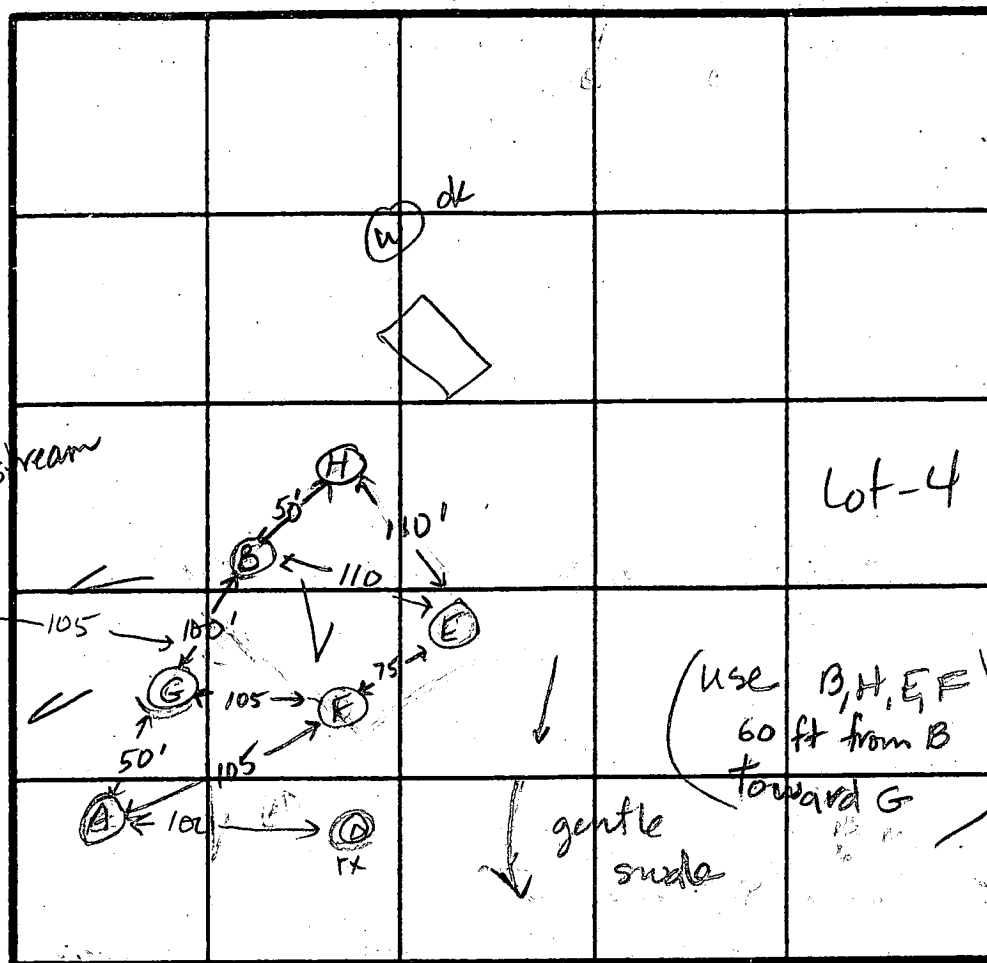

INDICATE NORTH - NAME ADJOINING ROADWAY AS BASE LINE.

DATE	TEST NO.	DEPTH	PRE-WET		TEST - 1" DROP		TIME
			START	STOP	START	STOP	
3-9-89	G	2.5 S	1:57	2:05	2:05	2:14	9 min
✓		11.5 D	Bottom	(Water at 10.5')	mottles at 6.0)	No	
✓	H	13.5 V	Bottom	(Dry)			ok

REMARKS Use holes B, E, F, H and stay 40 ft above #G.

TYPE OF SOIL 0-2.5 Rd-br si cl lm, 2.5-7 Tan mica sa si lm, 7-13.5 White mica sa si lm

TESTED BY Jane E. Nadeau ALSO PRESENT Dave, John Renner

APPLICATION

PERCOLATION TESTING

A 39922
P _____

HOWARD COUNTY HEALTH DEPARTMENT
BUREAU OF ENVIRONMENTAL HEALTH
P.O. BOX 476 ELLICOTT CITY, MARYLAND 21043
TELEPHONE: 461-9933

9-4-87 Perc
ok pending
plat approval JEN

DISTRICT 504
DATE 8-19-87

TO: THE COUNTY HEALTH OFFICER
ELLICOTT CITY, MARYLAND

I, HEREBY, APPLY FOR THE NECESSARY TEST IN ORDER TO CONSTRUCT (OR RECONSTRUCT) A SEWAGE DISPOSAL SYSTEM.

PROPERTY OWNER Alfred Bassler

ADDRESS 4994 Shepherd Lane PHONE 531-2193

PROSPECTIVE BUYER N/A

ADDRESS _____ PHONE _____

PROPERTY LOCATION:

SUBDIVISION Twelve Hills Sec III LOT NO. 29 Final 30 33 LOT 4 Preliminary

ROAD AND DESCRIPTION Linden Church Rd

TAX MAP 28 PARCEL # 49

SIZE OF LOT 3 acres TYPE BLDG. SFD
(SINGLE FAMILY DWELLING OR COMMERCIAL)

THE SYSTEM INSTALLED UNDER THIS APPLICATION IS ACCEPTABLE ONLY UNTIL PUBLIC FACILITIES BECOME AVAILABLE. I FULLY UNDERSTAND THE

FEE CONNECTED WITH THE FILING OF THIS PERC TEST APPLICATION IS NON-REFUNDABLE UNDER ANY CIRCUMSTANCES. I ALSO AGREE TO COMPLY

WITH ALL M.O.S.H.A. REQUIREMENTS IN TESTING THIS LOT. Mal D. Rein
(SIGNATURE OF APPLICANT)

APPROVED BY _____ FOR _____ DATE _____

REJECTED BY _____ FOR _____ DATE _____

HOLD PENDING FURTHER TESTS _____ DATE _____

REASONS FOR REJECTION OR HOLDING 9-4-87 for perc hole location and subdivision
plat approval. Limited house & well site JEN

THIS IS NOT A PERMIT

Highest

B
A
E
D

Low

(A)

SOIL PROFILE

0'

0-2.5 Tan micaceous sa si lm
 2.5-11.5 Brown micaceous sandy silty loam, trace of decomposed rock, <10%
 11.5 Bottom


(D)

0-5.5 Tan mica sa si lm
 5.5-8.0 Brown gvl sa lm, broken rock <50%
 8.0 Refusal

(B)

0-5 Orange brown sa cl si loam
 5-13.5 Tan mica sa si lm, trace of saprolite <10%
 13.5 Bottom

EH

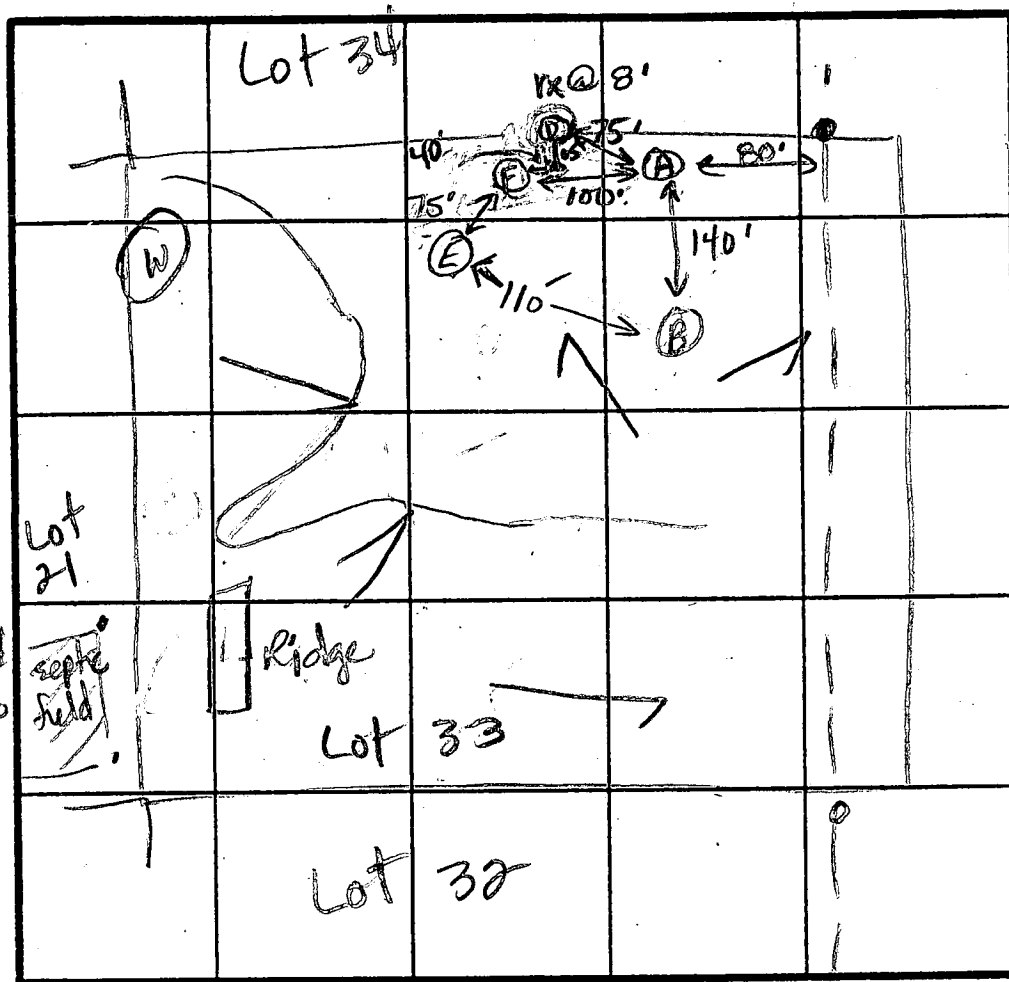

INDICATE NORTH - NAME ADJOINING ROADWAY AS BASE LINE.

0-3.5 Tan sa si cl loam, trace gvl <10%
 3.5-12.0 Brown to white sa si loam, trace decomp rock <40%
 12.0 Bottom

(E)

0-3.5 Red-tan mica sa si loam
 3.5-11.0 Tan mica sa si lm, trace of decomp. rock <20%
 11.0 Bottom

X PERC
 10 MIN
 190 #/BR
 INLET 30'
 BOTTOM 70'

DATE	TEST NO.	DEPTH	PRE-WET		TEST - 1" DROP		TIME
			START	STOP	START	STOP	
9-4-87	A	3.0 S	2:10	2:12	2:12	2:14	2
		11.5 D	Bottom (see profile)				
	(D)	8.0 V	(see profile) failed				
	B	3.5 S	2:23	2:25	2:25	2:30	5
		13.5 D	Bottom (see profile)				
	E	3.0 S	2:41	2:44	2:44	2:49	5
		6.0 M	2:41	2:47	2:47	1:10 ⁺	27 ⁺
		12.0 D	Bottom (see profile)				
	F	11.0 V	(see profile)				OK

REMARKS

All holes moved uphill from gas line. Limited house & well site.

TYPE OF SOIL

0-4' Tan mica sa si lm, 4'-13' Tan mica sa si lm trace saprolite/decomp rock <20%

TESTED BY

JE Nadeau

ALSO PRESENT

Dank, Mark R.

FIRST FLOOR ELEV. 441.0
 BSMT. FLOOR ELEV. 433.0
 INV. OUT OF HSE. ELEV. 431.71

SEPTIC TANK
 EXIST. ELEV. 432.90
 INV. IN. 431.25
 INV. OUT. 431.00

DISTRIBUTION BOX
 EXIST. ELEV. 433.4
 INV. IN. 430.4

NOTE: CONTRACTOR TO PROVIDE POSITIVE DRAINAGE
 AWAY FROM FOUNDATION AT ALL TIMES.

S-S = SILT FENCE

SCE = STABILIZED CONSTRUCTION ENTRANCE

I HEREBY CERTIFY THAT THE ABOVE
 MEASUREMENTS AND ELEVATIONS ARE
 ACTUAL AND CORRECT FOR THIS PROPERTY.

Mark L. Robel
 MARK L. ROBEL

DATE



NOTE: LENGTH OF TRENCHES TO BE
 DETERMINED AT SEPTIC PERMIT
 APPLICATION.

BASSLER, INC.
 516 / 769

TRANSCONTINENTAL
 PIPELINE COMPANY
 EXISTING UTILITY R/W
 E. 15 / 33.2 / 601 / 246.

REVISED
 ELEVATIONS OR
 AS REVISED
 6/7/91 CWL
 BP 3783


LOT # 29 ~ SECT. # 3
 TWELVE HILLS (A*)
 ELECTION DISTRICT NO. 5
 HOWARD COUNTY, MARYLAND


SCALE: 1" = 50' ~ DATE: 5-8-91
 REVISED: 6-3-91

(PERC FIELD ADJUSTMENT)

VITTI, ROBEL & ASSOCIATES, INC.
 SUITE 2-B ~ 1717 YORK RD.
 LUTHERVILLE, MARYLAND 21093
 PHONE (301) 252-4552

TWELVE HILLS ROAD
 (50' R/W)

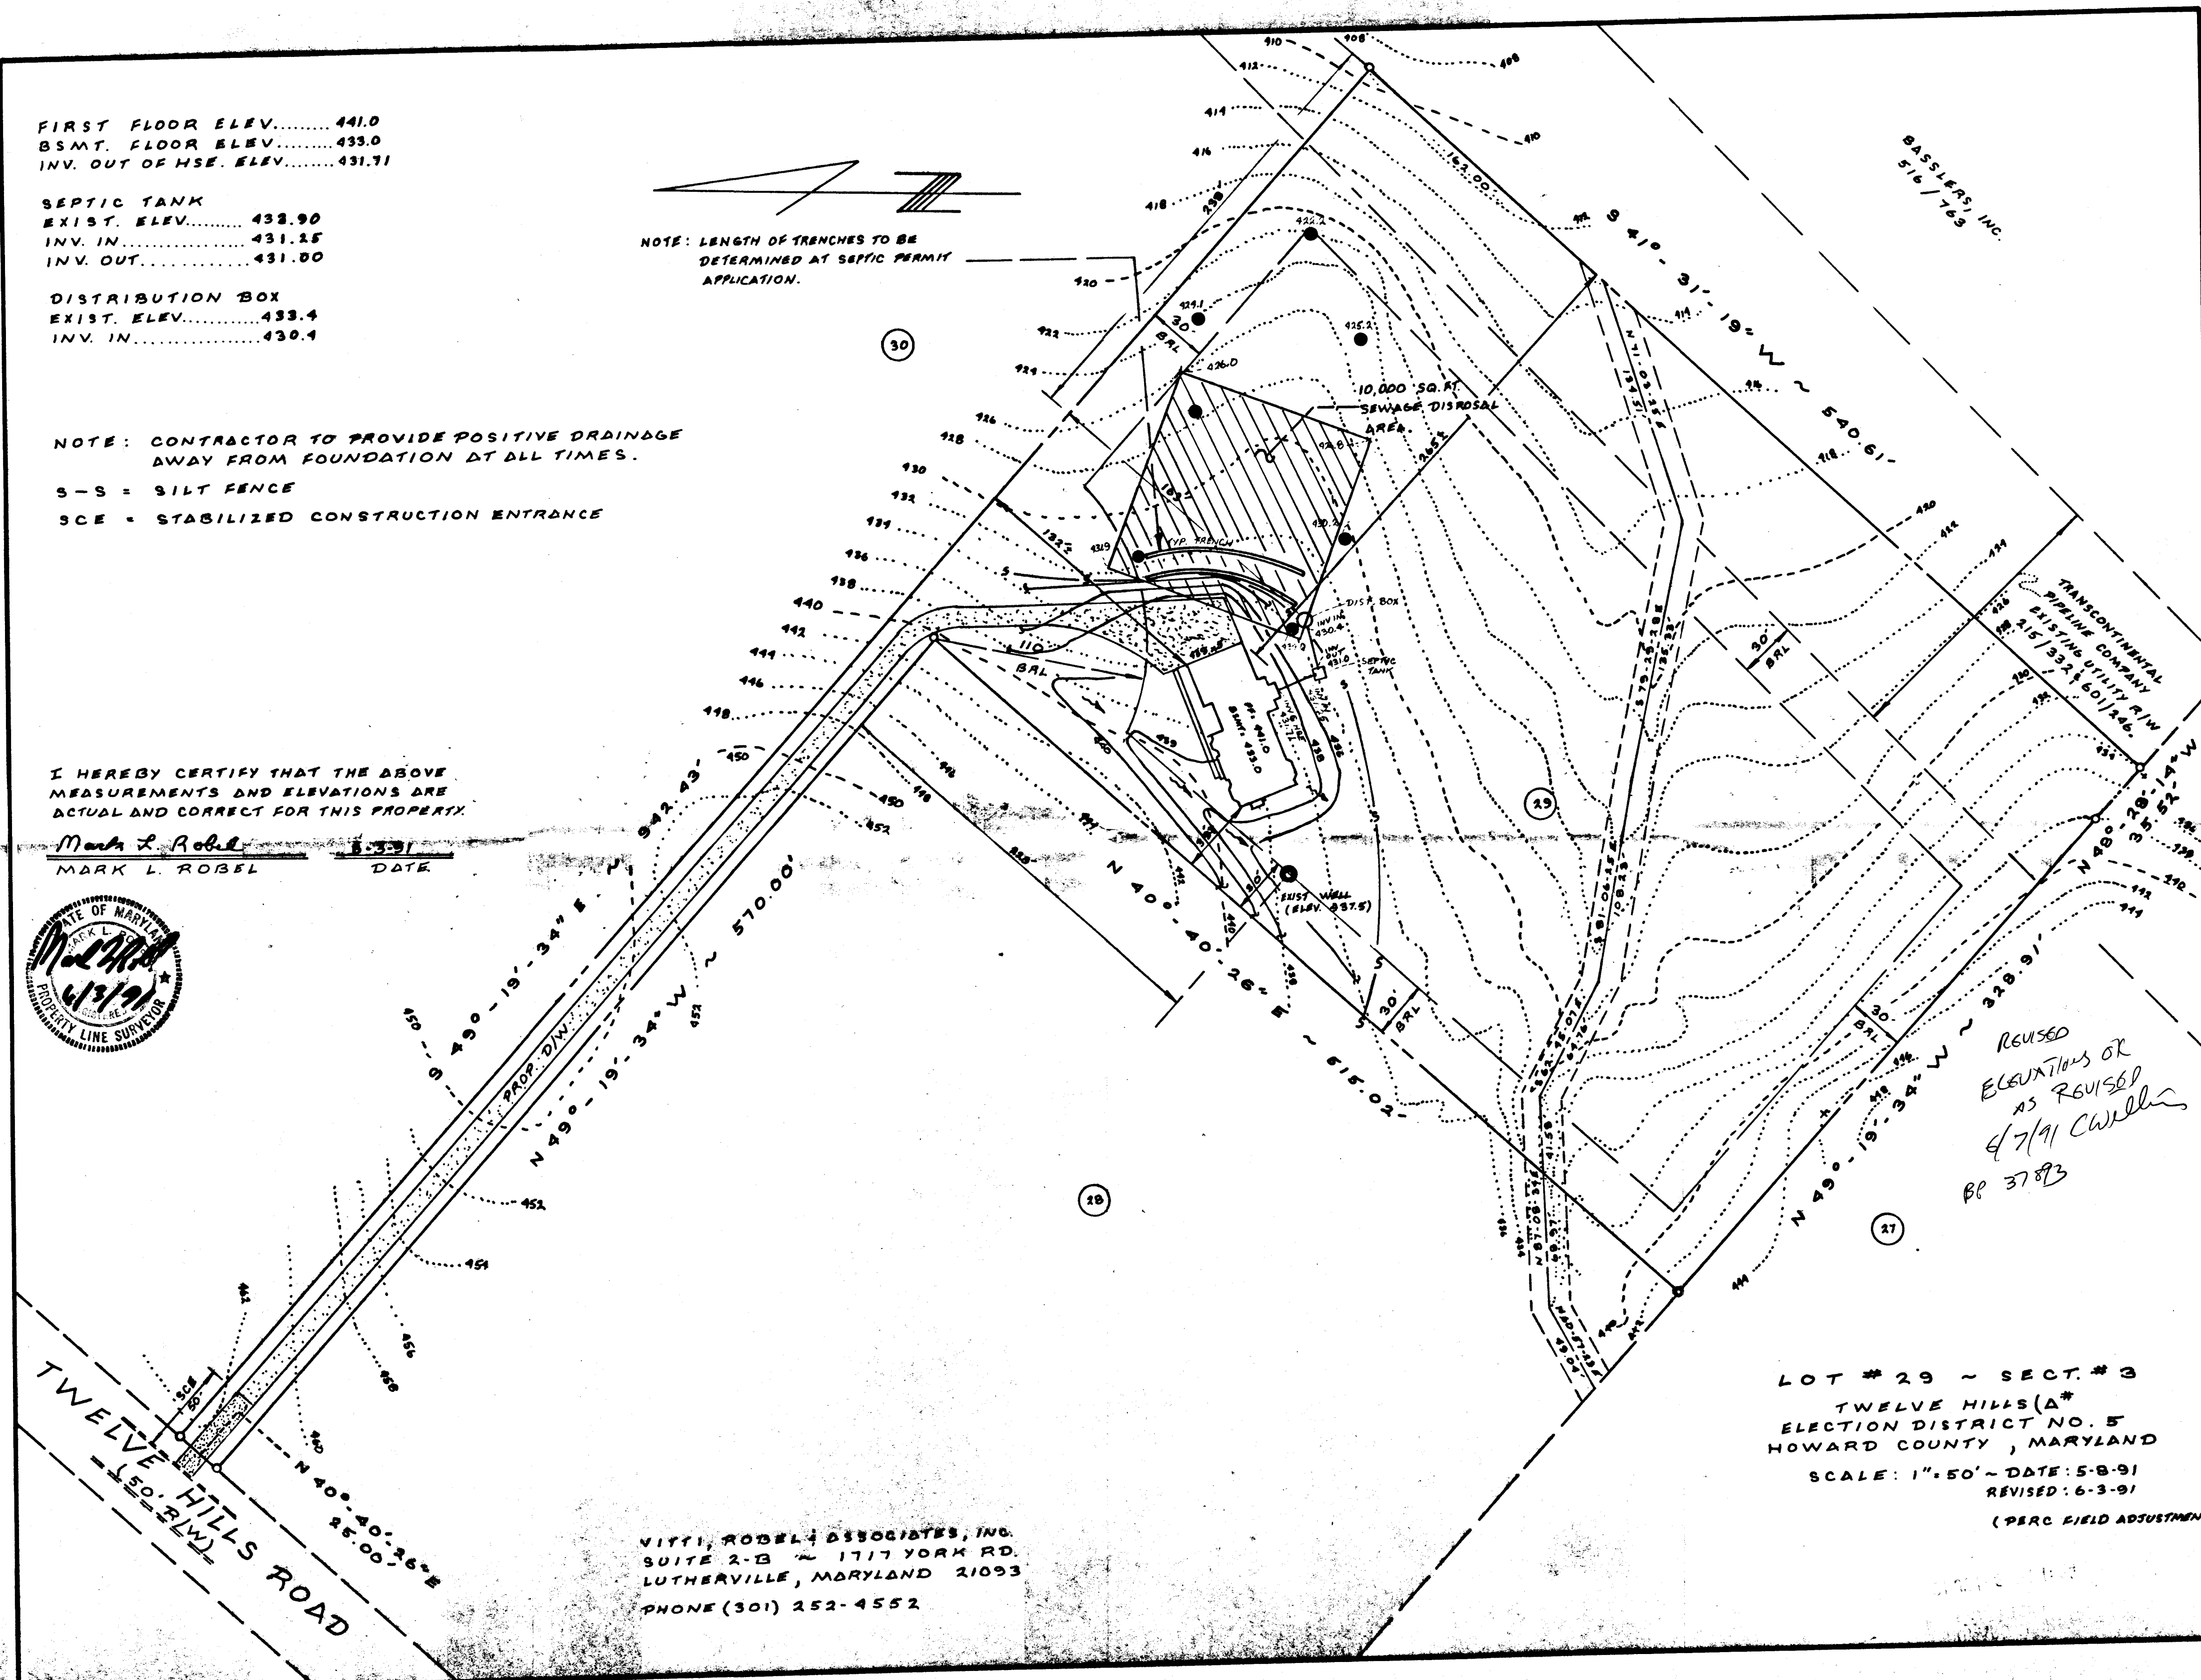

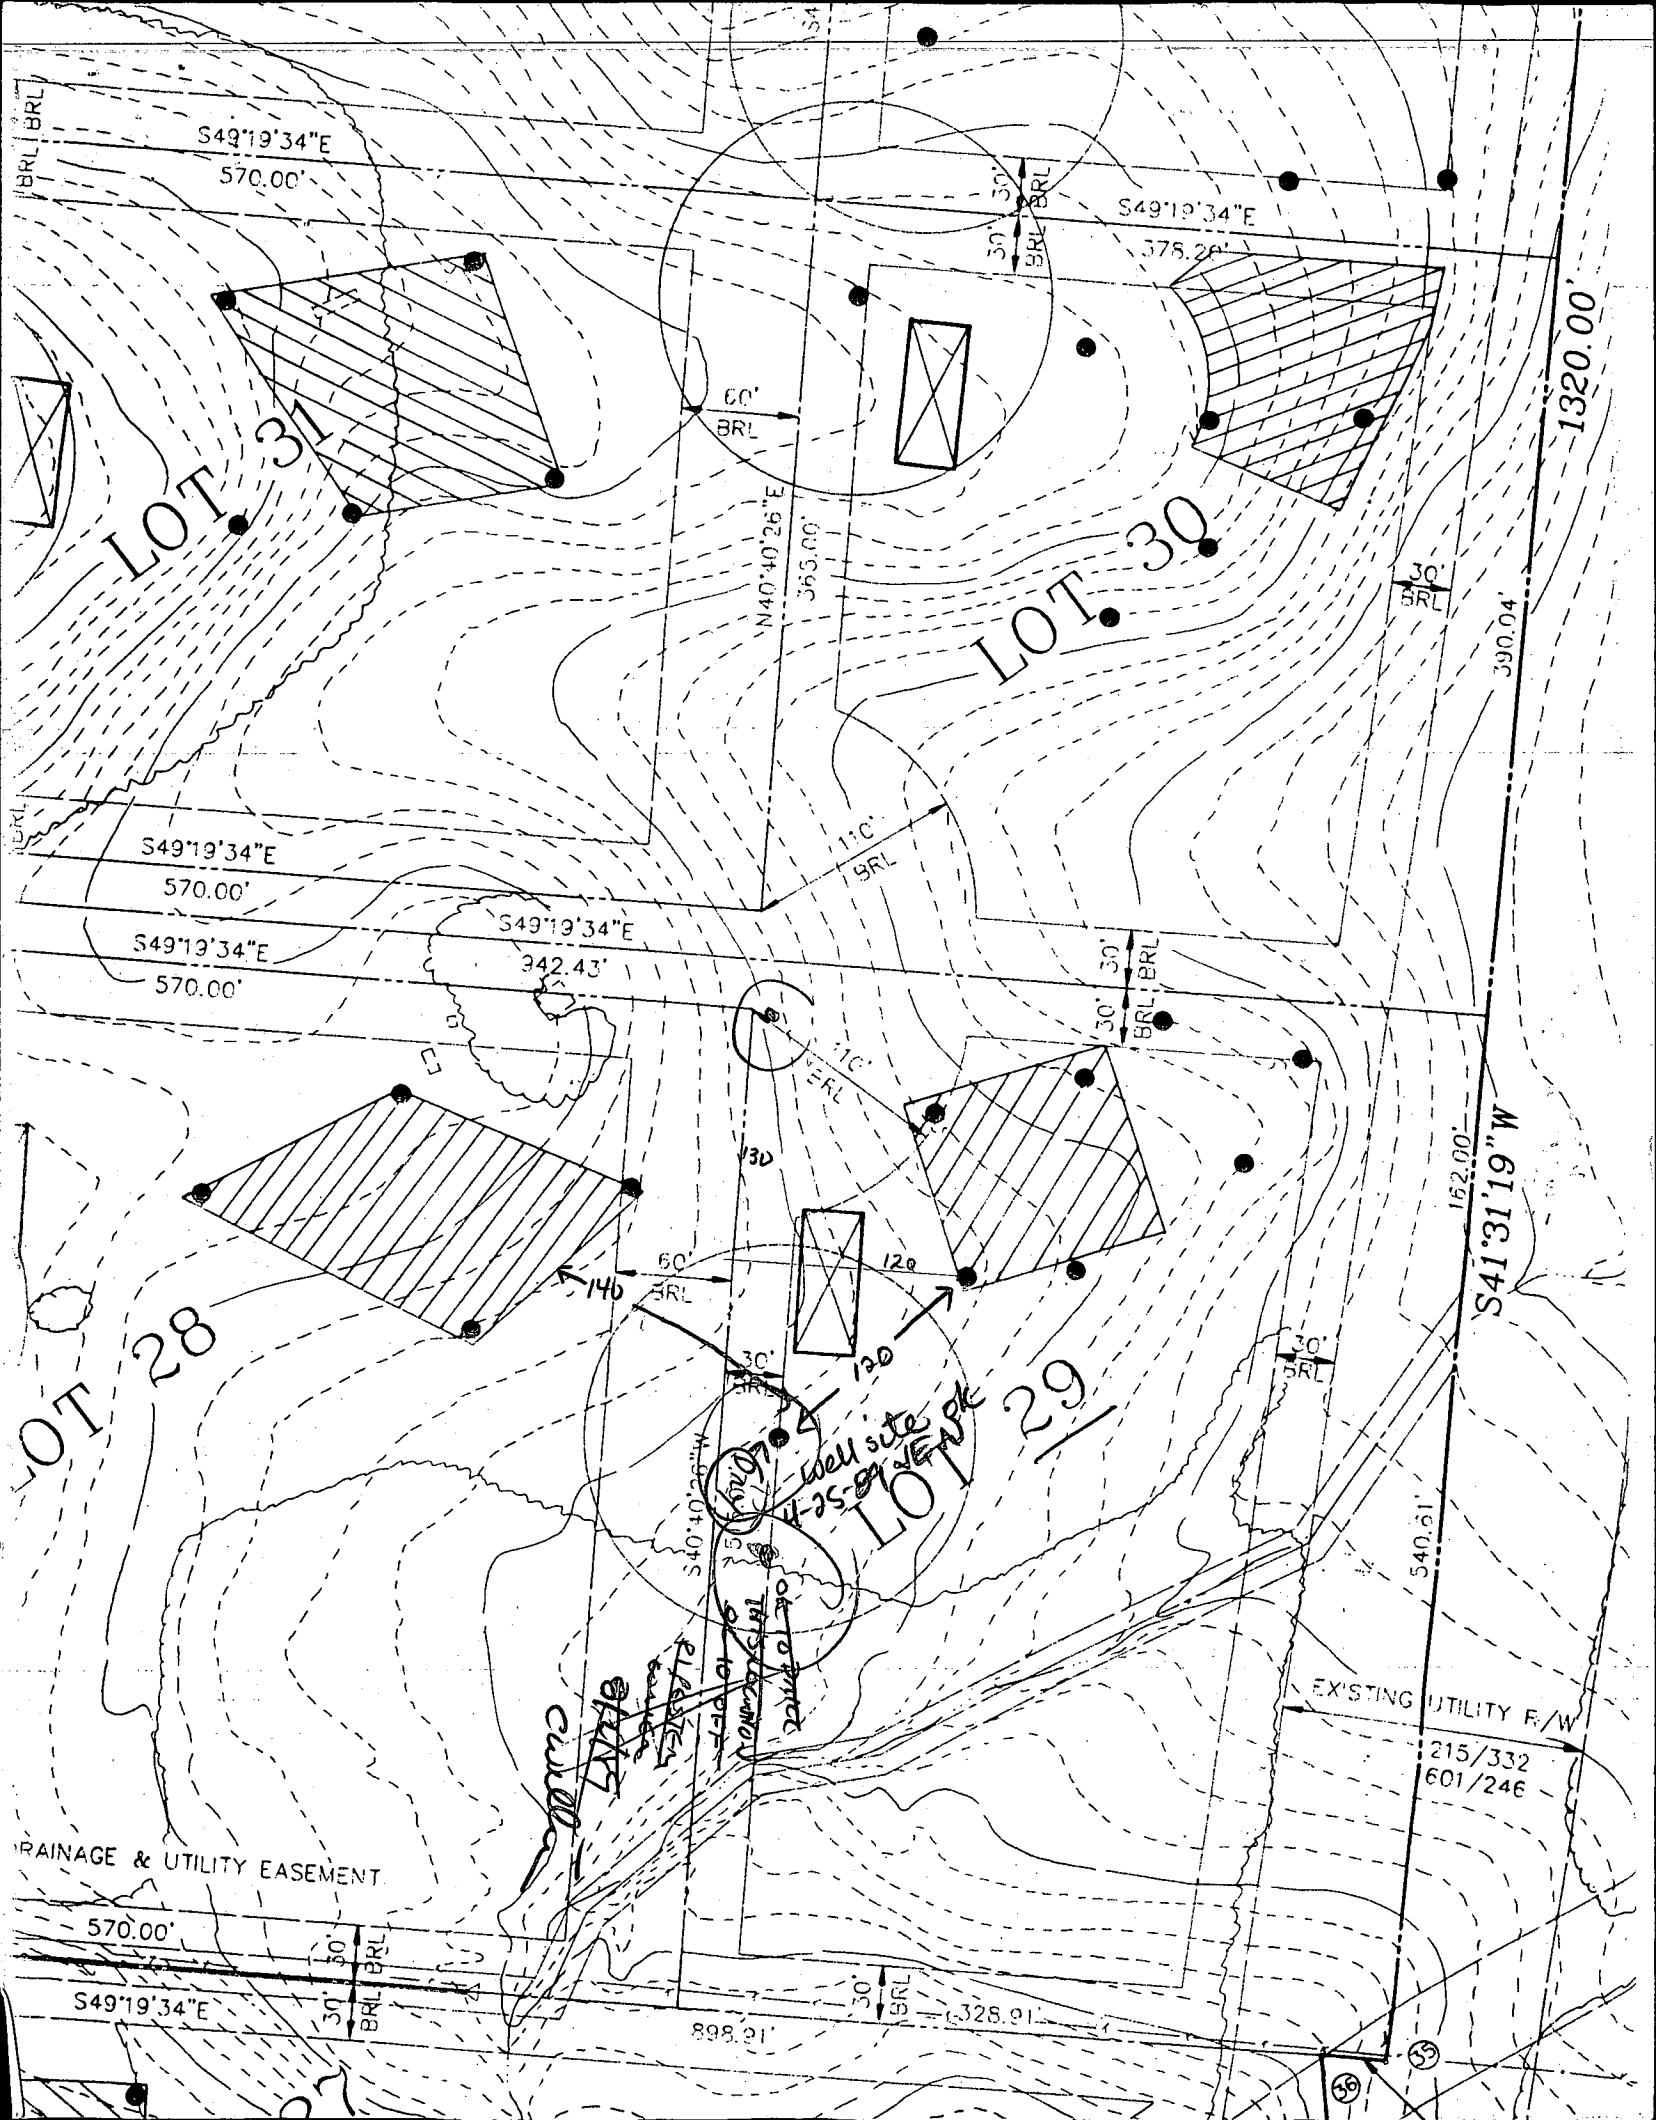

S49°19'34"E
570.00'

S49°19'34"E
375.20'

LOT 31

LOT 30

S49°19'34"E
570.00'

S49°19'34"E
342.43'

S49°19'34"E
570.00'

LOT 28

LOT 29

Well site
4-25-01

S41°31'19"W
162.00'

540.61'

EXISTING UTILITY F/W
215/332
601/246

RAINAGE & UTILITY EASEMENT

570.00'

S49°19'34"E

898.91'

328.91'

1320.00'

390.04'

B 1 6830 (THIS NUMBER IS TO BE PUNCHED IN COLS. 3-6 ON ALL CARDS)	SEQUENCE NO. (DP USE ONLY)	STATE OF MARYLAND PERMIT TO DRILL WELL please print or type	STATE PERMIT NUMBER H0-88-0570 fill in this form completely
Date Received (APA) 1211688		B 3 LOCATION OF WELL 8 COUNTY HOWARD 23 SUBDIVISION TWELVE HILLS SECTION 3 LOT 29 52 NEAREST TOWN DAYTON MILES FROM TOWN (enter 0 if in town) 1 MI	
OWNER INFORMATION 15 Last Name ALTOGETHER Owner LTD First Name PART 36 Street or RFD 10176-BALT NAT PIKE 57 Town ELLICOTT CITY MD 21043		DRILLER INFORMATION Driller's Name Frank Delph License No. 453 Firm Name Frank Delph Well Drillers Inc. Address 18234 Penn Shop Rd. N.H. Park Md. Signature <i>Frank Delph</i> Date 12/14/88	
B 2 WELL INFORMATION APPROX. PUMPING RATE (GAL. PER MIN.) 5 AVERAGE DAILY QUANTITY NEEDED (GAL. PER DAY) 500		B 4 DIRECTION OF WELL FROM TOWN (CIRCLE BOX) NEAR WHAT ROAD Twelve Hills Rd ON WHICH SIDE OF ROAD (CIRCLE APPROPRIATE BOX) NORTH ☒ WEST ☐ EAST ☐ SOUTH ☐ DISTANCE FROM ROAD 600 FT or MI 600	
USE FOR WATER (CIRCLE APPROPRIATE BOX) ☒ HOME (SINGLE OR DOUBLE HOUSEHOLD UNIT ONLY) ☐ FARMING (LIVESTOCK WATERING & AGRICULTURAL IRRIGATION) ☐ INDUSTRIAL, COMMERCIAL, STATE AND FEDERAL GOV. OTHER (REQUIRES APPROPRIATION PERMIT) ☐ PUBLIC OR PRIVATE WATER COMPANY (REQUIRES APPROPRIATION PERMIT AND STATE HEALTH DEPARTMENT APPROVAL) ☐ TEST, OBSERVATION, MONITORING (MAY REQUIRE APPROPRIATION PERMIT)		NOT TO BE FILLED IN BY DRILLER HEALTH DEPARTMENT APPROVAL 43749 COUNTY NAME HOWARD COUNTY NO. A# 39932 STATE SIGNATURE _____ DATE ISSUED 10/29/89 CO SIGNATURE _____ EXP. DATE _____ NORTH GRID 810000 EAST GRID 0810000	
APPROXIMATE DEPTH OF WELL 200 FEET APPROXIMATE DIAMETER OF WELL 6 INCH		SHOW MAJOR FEATURES OF BOX & LOCATE WELL WITH AN X SOURCES OF DRILLING WATER 1. WELL GROWN 2. SEE OTHER SIDE 3. SEE OTHER SIDE WRITE THE BOX NUMBER FROM THE MAP HERE 811 E 5790 514 N 5780	
METHOD OF DRILLING (circle one) BORED (or Augered) ☐ JETTED ☐ Jetted & DRIVEN ☐ 30- AIR-ROTary ☐ AIR-PERCussion ☐ ROTARY (Hydraulic Rotary) ☒ 37 CABLE ☐ REVERSE-ROTary ☐ DRIVE-POINT ☐ other _____		DRAW A SKETCH BELOW SHOWING LOCATION OF WELL IN RELATION TO NEARBY TOWNS AND ROADS AND GIVE DISTANCE FROM WELL TO NEAREST ROAD JUNCTION 	
REPLACEMENT OR DEEPEMED WELLS (CIRCLE APPROPRIATE BOX) ☒ THIS WELL WILL NOT REPLACE AN EXISTING WELL ☐ THIS WELL WILL REPLACE A WELL THAT WILL BE ABANDONED AND SEALED 39 ☐ THIS WELL WILL REPLACE A WELL THAT WILL BE USED AS A STANDBY ☐ THIS WELL WILL DEEPEMED AN EXISTING WELL PERMIT NUMBER OF WELL TO BE REPLACED OR DEEPEMED (IF AVAILABLE) _____		Not to be filled in by driller (OEP USE ONLY) APPROP. PERMIT NUMBER _____ FORCE SA WRITE INITIALS IN BOX PERMIT NO. H0-88-0570 SPECIAL CONDITIONS	

2 AUG 9

- ① Well Already Counted Got info from F &
- ② 50 Ft pipe
- ③ 35 Ft open Hole
- ④ 14 Bags
- ⑤ Location OK

B. Budge

C1 6705	SEQUENCE NO. (DENV USE ONLY)	STATE OF MARYLAND WELL COMPLETION REPORT FILL IN THIS FORM COMPLETELY PLEASE PRINT OR TYPE	THIS REPORT MUST BE SUBMITTED WITHIN 45 DAYS AFTER WELL IS COMPLETED.
(THIS NUMBER IS TO BE PUNCHED IN COLS. 3-6 ON ALL CARDS)		COUNTY NUMBER 43749	PERMIT NO. FROM "PERMIT TO DRILL WELL" 10-88-0570
DATE Received	DATE WELL COMPLETED	Depth of Well	
	070789	365 (TO NEAREST FOOT)	

OWNER ALTOGETHER LTD. PART.	last name TWELVE HILLS RD	first name	TOWN DRYTON
STREET OR RFD	SUBDIVISION TWELVE HILLS	SECTION 3	LOT #29

WELL LOG Not required for driven wells		
STATE THE KIND OF FORMATIONS PENETRATED, THEIR COLOR, DEPTH, THICKNESS AND IF WATER BEARING		
DESCRIPTION (Use additional sheets if needed)	FEET FROM TO	Check if water bearing
Top Soil	0 2	
Shale	2 35	
Mika	35 55	
Sandstone	55 60	
Mika	60 160	
Sandstone	160 165	
Mika	165 365	

GROUTING RECORD	
WELL HAS BEEN GROUTED (Circle Appropriate Box)	
yes Y	no N
TYPE OF GROUTING MATERIAL	
CEMENT CM	BENTONITE CLAY BC
NO. OF BAGS 14	NO. OF POUNDS 1400
GALLONS OF WATER 80	
DEPTH OF GROUT SEAL (to nearest foot)	
from 0 ft.	to 36 ft.
(enter 0 if from surface)	

CASING RECORD		
casing types insert appropriate code below	ST CO	
	STEEL CONCRETE	
	PL OT	
PLASTIC OTHER		
MAIN CASING TYPE	Nominal diameter top (main) casing (nearest inch)	Total depth of main casing (nearest foot)
PL	60	50

OTHER CASING (if used)	
diameter inch	depth (feet) from to

SCREEN RECORD	
screen type or open hole	ST BR HO
insert appropriate code below	STEEL BRASS BRONZE OPEN HOLE
	PL OT
	PLASTIC OTHER

C2	
DEPTH (nearest ft.)	
1 H0	2 50
3 315	

CIRCLE APPROPRIATE LETTER	
A	A WELL WAS ABANDONED AND SEALED WHEN THIS WELL WAS COMPLETED
E	ELECTRIC LOG OBTAINED
P	TEST WELL CONVERTED TO PRODUCTION WELL

I HEREBY CERTIFY THAT THIS WELL HAS BEEN CONSTRUCTED IN
ACCORDANCE WITH COMAR 10.17.13 "WELL CONSTRUCTION"
AND IN CONFORMANCE WITH ALL CONDITIONS STATED IN THE
ABOVE CAPTIONED PERMIT, AND THAT THE INFORMATION
PRESENTED HEREIN IS ACCURATE AND COMPLETE TO THE BEST
OF MY KNOWLEDGE.

DRILLERS IDENT. NO. 453	DRILLERS SIGNATURE (MUST MATCH SIGNATURE ON APPLICATION)
SITE SUPERVISOR (sign. of driller or journeyman responsible for sitework if different from permittee)	

SLOT SIZE 1 2 3	
DIAMETER OF SCREEN	(NEAREST INCH)
GRAVEL PACK	
IF WELL DRILLED WAS FLOWING WELL INSERT F IN BOX 68	

OEP USE ONLY (NOT TO BE FILLED IN BY DRILLER)		
T	(E.R.O.S.)	WQ
70	72	74 75 76
TELESCOPE CASING	LOG INDICATOR	OTHER DATA

C3		
PUMPING TEST		
HOURS PUMPED (nearest hour)	6	
PUMPING RATE (gal. per min. to nearest gal.)	1	
METHOD USED TO MEASURE PUMPING RATE	Bucket	
WATER LEVEL (distance from land surface) BEFORE PUMPING	13	
WHEN PUMPING	225	
TYPE OF PUMP USED (for test)		
A air	P piston	T turbine
C centrifugal	R rotary	O other (describe below)
J jet	S submersible	

PUMP INSTALLED	
DRILLER WILL INSTALL PUMP YES NO	
IF DRILLER INSTALLS PUMP, THIS SECTION MUST BE COMPLETED FOR ALL WELLS EXCEPT HOME USE	
TYPE OF PUMP INSTALLED PLACE (A,C,J,P,R,S,T,O) IN BOX - SEE ABOVE:	
CAPACITY: GALLONS PER MINUTE (to nearest gallon)	
PUMP HORSE POWER	
PUMP COLUMN LENGTH (nearest ft.)	
CASING HEIGHT (circle appropriate box and enter casing height)	
+ above	LAND SURFACE
- below	2 (nearest foot)

LOCATION OF WELL ON LOT	
SHOW PERMANENT STRUCTURE SUCH AS BUILDING, SEPTIC TANKS, AND/OR LANDMARKS AND INDICATE NOT LESS THAN TWO DISTANCES (MEASUREMENTS TO WELL)	

COUNTY

3/20/92
NOD

HOWARD COUNTY HEALTH DEPARTMENT
Bureau of Environmental Health
3525-H Ellicott Mills Drive
Ellicott City, MD 21043
461-9933

APPLICATION FOR PITLESS ADAPTER, WELL PUMP AND PRESSURE TANK INSTALLATION

New Installation X
Replacement _____

Receipt # 47930
Date 3-19-92

Name of Installer T&R Plumbing & Heating

Telephone 725-2392

License Number 7079

Certified Well Pump Installer _____

Well Driller _____

Registered Plumber ✓

Name of Property Owner Capitano Custom Homes

Telephone 988-9178

Subdivision Twelve Hills

Lot # 29

Well Tag # HO-88-0570

Site Address 13064 Twelve Hills Rd
Clarksville, MD 21029

Pump

1. Type

- a. Deep well jet _____
b. Shallow well jet _____
c. Submersible _____

2. Make Jacuzzi

3. Model # _____

4. Capacity _____ GPM

5. Pump exceeds well capacity Yes ✓ No _____

6. If Yes, is low pressure cutoff switch installed? Yes ✓ No _____

7. What methods are used to protect the pump and electrical wiring from vibrations? Torque arrestors ✓ Cable guards _____ Other _____

Motor

1. Horsepower _____

2. RPM _____

3. Voltage _____

a. 110 _____

b. 220 X

Pitless Adapter

1. Make Howard

2. Model # _____

3. Depth _____

Tank

1. Capacity _____

2. Pressure relief valve? yes

Piping

1. Type Creston

2. Size 1"

3. NSF and/or BOCA Code approved yes

4. Depth of supply line _____

Well data

1. Depth _____ ft.

2. Yield _____ GPM

3. Static water level _____ ft.

4. Will water supply be disinfected by installer? no

P.A. OK @ 4' B.G.
MR 3/20/92

I understand that it is my responsibility to notify the Howard County Health Department when the installation is ready for inspection (otherwise this permit is null and void).

All information given above is true to the best of my knowledge.

Signature of Applicant: _____

Date: 3-19-92

Note: A sticker indicating approval/status of the installation will be placed on the well casing at the time of the inspection.