

4/23/71  
Landy

# PERMIT

P 15878

A 13196

SEWAGE DISPOSAL SYSTEM

MARYLAND STATE DEPARTMENT OF HEALTH

HOWARD COUNTY

ELLICOTT CITY

DISTRICT 2

**INDEXED**

DATE 4/19/71

Emerson Feaga IS PERMITTED TO INSTALL  ALTER

ADDRESS Old Frederick Road, Woodstock, Maryland PHONE \_\_\_\_\_

A SEWAGE DISPOSAL SYSTEM LOCATED AT \_\_\_\_\_

SUBDIVISION Mt. Hebron ROAD Calvin Drive LOT 102, Sec. 11

PROPERTY OWNER Mt. Hebron, Inc.

ADDRESS \_\_\_\_\_

SPECIFICATIONS - 3 bedrooms

DRAIN FIELD \_\_\_\_\_ DEPTH \_\_\_\_\_ FEET, BOTTOM AREA \_\_\_\_\_ SQ. FT.

SEEPAGE PITS \_\_\_\_\_ ABSORBENT SIDE-WALL AREA \_\_\_\_\_ SQ. FT.

SEPTIC TANK CAPACITY 1,000 GALLONS

FOR GARBAGE GRINDER, INCREASE DISPOSAL AREA 22% & TANK CAPACITY 50%.

OTHER 400 sq. ft. of dry well. Locate system 90 ft. from Calvin

Circle and 54 ft. from right lot line.

NOTE: ALL PIPE FROM HOUSE TO SEPTIC TANK MUST BE CAST IRON.


PERMIT VOID AFTER THREE YEARS.

PLANS APPROVED BY Palmer F. Wine DATE 9/24/70

FILL SEPTIC TANK AND DISTRIBUTION BOX WITH WATER BEFORE CALLING FOR AN INSPECTION. COVER NO WORK UNTIL INSPECTED AND APPROVED.

NEITHER THE HOWARD COUNTY COMMISSIONERS NOR THE HEALTH DEPARTMENT IS RESPONSIBLE FOR THE SUCCESSFUL OPERATION OF ANY SYSTEM.

A  
13196

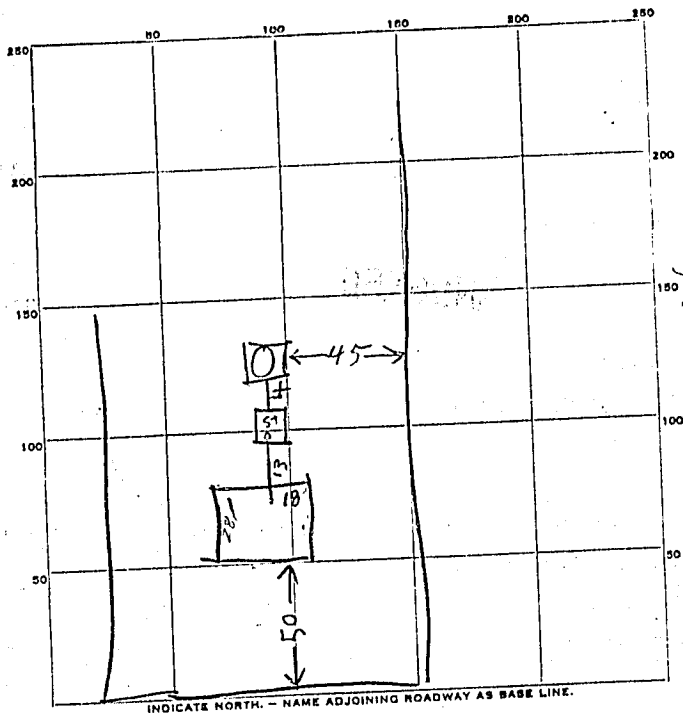

14  
 14  
 14  
 14  
 55  
  
 4  
 10  
 15  
 28  
 56  
 105  
  
 37  
 2  
 3

INDICATE NORTH. - NAME ADJOINING ROADWAY AS BASE LINE.

PERMIT CARD \_\_\_\_\_

SEPTIC TANK, LEVEL OK 1000 concrete CLEANOUTS OK  
TOP in 14" below original grade & about 4-5 FT. below total grade  
 DISTRIBUTION BOX, LEVEL \_\_\_\_\_

TILE FIELD, DEPTH \_\_\_\_\_ FT. TRENCH WIDTH \_\_\_\_\_ FT.

GRAVEL DEPTH \_\_\_\_\_ IN. TOTAL LENGTH \_\_\_\_\_ FT.

NUMBER OF TRENCHES \_\_\_\_\_ TOTAL BOTTOM AREA \_\_\_\_\_

SEEPAGE PITS, INSIDE DIAMETER 12 FT. DEPTH BELOW INLET 9 FT.

ABSORBENT AREA 333 SQ. FT. not counting stone  
616 SQ. FT. counting stone

REMARKS 4/23/71 Dry Well In Oct in 25' below grade

56  
33  
6

DATE SYSTEM APPROVED 4/23/71 INSPECTOR Raymond Dodge