

5/19/89
J. M. M.

PERMIT

SEWAGE DISPOSAL SYSTEM

MARYLAND STATE DEPARTMENT OF HEALTH DISTRICT

HOWARD COUNTY
BUREAU OF ENVIRONMENTAL HEALTH
461-9933

P 44605

A REPAIR

DATE 4/28/89

DATE SYSTEM APPROVED

INSPECTOR

INDEXED
INDEXED

Jack Fyock

IS PERMITTED TO INSTALL ALTER X

ADDRESS PHONE 988-9270

SUBDIVISION ROAD 13140 Route 108 LOT

PROPERTY OWNER Cameron

ADDRESS 13140 Route 108
Clarksville, Maryland 21029

IF GARBAGE GRINDER IS USED INCREASE SEPTIC TANK CAPACITY BY 50% AND ABSORPTION AREA BY 22%.

GARBAGE GRINDER? YES NO X

SEPTIC TANK CAPACITY 1000 GALLONS NUMBER OF BEDROOMS 3

REPAIR - CALL FOR INSPECTION WHEN GROUND IS OPENED UP SO SANITARIAN CAN RECOMMEND
REPAIR.

PLANS APPROVED BY C. Williams DATE 5/18/89

COVER NO WORK UNTIL INSPECTED AND APPROVED

NEITHER THE HOWARD COUNTY COUNCIL NOR THE HEALTH DEPARTMENT IS RESPONSIBLE FOR THE SUCCESSFUL OPERATION OF ANY SYSTEM.

NOTE: CLEANOUT REQUIRED EVERY 70 FEET OF SEWER LINE AND/OR AT 90° SWEEPS IN LINES FROM HOUSE TO DRAIN FIELDS

NOTE: ALL PARTS OF SEPTIC SYSTEMS (I.E. TANK, DISTRIBUTION BOX, TRENCHES) TO BE 100 FEET FROM WELL (UNLESS OTHERWISE SPECIFICALLY AUTHORIZED)

NOTE: IF DEEP TRENCHES ARE USED CALL FOR INSPECTION BEFORE AND AFTER PLACING GRAVEL IN TRENCH(ES)

NOTE: NO DRY WELL SHALL EXCEED 15 FOOT IN DIAMETER NO ABSORPTION TRENCH TO EXCEED 100 FEET IN LENGTH.

NOTE: ALL PIPE FROM HOUSE TO SEPTIC TANK MUST BE CAST IRON OR SCHEDULE 40 PVC OR ABS

PERMIT VOID AFTER TWO YEARS

NOTE: INSTALL STAND PIPE ON SEPTIC TANK AND DRY WELL. STAND PIPES MUST BE 6 INCHES IN DIAMETER. CAST IRON, CONCRETE OR TERRA COTTA OR PVC OR ABS ACCEPTED. IF TOP OF SEPTIC TANK IS DEEPER THAN 3 FEET, MANHOLE TO GRADE REQUIRED


NOTE: DISTRIBUTION BOXES MUST HAVE BAFFLES

BUDG. PERMIT SIGNED
AND RETURNED 8/20/90
Serial #34406

*INSTALLER IS RESPONSIBLE FOR OBTAINING FINAL APPROVAL ON THIS PERMIT

*CALL 461-9933 FOR INSPECTION OF SEPTIC SYSTEMS Satellite dish

P 44605

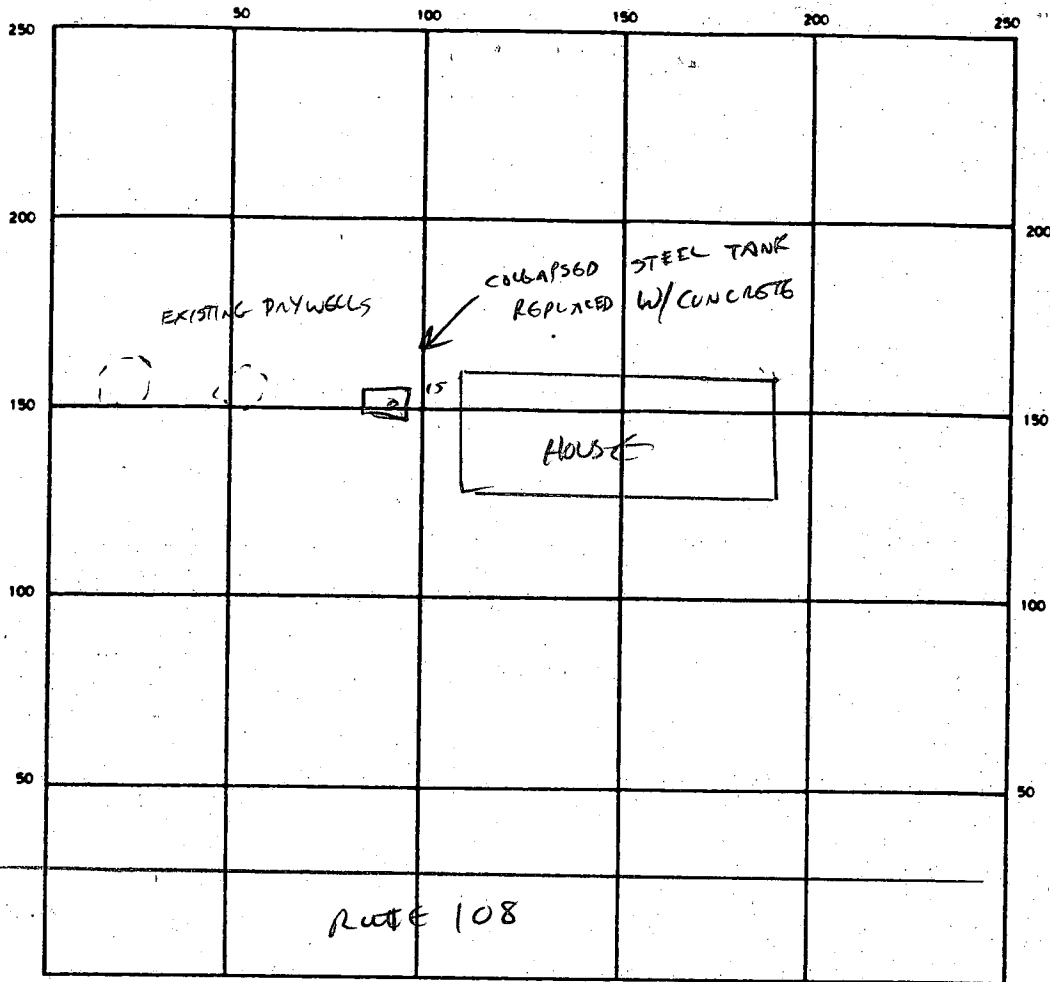

SEPTIC TANK LEVEL 1000 GAL CLEANOUTS ✓ ST

DISTRIBUTION BOX LEVEL N/A

DRAIN FIELD/TILE FIELD DEPTH 1 FT. TRENCH WIDTH 1 FT. INLET DEPTH 1 FT.

EFFECTIVE GRAVEL DEPTH 1 FT. TOTAL LENGTH 1 FT.

NUMBER OF TRENCHES 2 ONE SIDEWALL/BOTTOM AREA 1 SQ FT.

DRYWELL INSIDE DIAMETER 2-EXISTING FT. EFFECTIVE DEPTH BELOW INLET 1 FT.

ABSORBENT AREA SEE P12942 SQ. FT.

REMARKS

DATE SYSTEM APPROVED 5/19/87 INSPECTOR ewilley

Permit on back hoe seat.

8/10/67

PERMIT

SEWAGE DISPOSAL SYSTEM

MARYLAND STATE DEPARTMENT OF HEALTH

HOWARD COUNTY

ELLICOTT CITY

DISTRICT 5

DATE 7/31/67

INDEXED

James Triplett

IS PERMITTED TO INSTALL ALTER X

ADDRESS Hardy Rd., Mt. Airy, Md.

PHONE HU 9-4535

A SEWAGE DISPOSAL-SYSTEM LOCATED AT _____

SUBDIVISION _____

SOUTH
ROAD Rt. 108 - approx. 2 LOT _____
miles out of Clarksville on the right hand side
house sits about 500 ft. back off road

PROPERTY OWNER Mr. Cameron

ADDRESS _____

SPECIFICATIONS

DRAIN FIELD _____ DEPTH _____ FEET, BOTTOM AREA _____ SQ. FT.

SEEPAGE PITS _____ ABSORBENT SIDE-WALL AREA _____ SQ. FT.

SEPTIC TANK CAPACITY _____ GALLONS

FOR GARBAGE GRINDER, INCREASE DISPOSAL AREA 22% & TANK CAPACITY 50%.

OTHER REPAIR - 300 sq. ft. dry well.


PLANS APPROVED BY _____ DATE 7/31/67

FILL SEPTIC TANK AND DISTRIBUTION BOX WITH WATER BEFORE CALLING FOR AN INSPECTION. COVER NO WORK UNTIL INSPECTED AND APPROVED.

NEITHER THE HOWARD COUNTY COMMISSIONERS NOR THE HEALTH DEPARTMENT IS RESPONSIBLE FOR THE SUCCESSFUL OPERATION OF ANY SYSTEM.

**NOTIFY THE HEALTH DEPARTMENT 48 HOURS
BEFORE EXCAVATIONS ARE TO BE BACK FILLED.**

P 12942

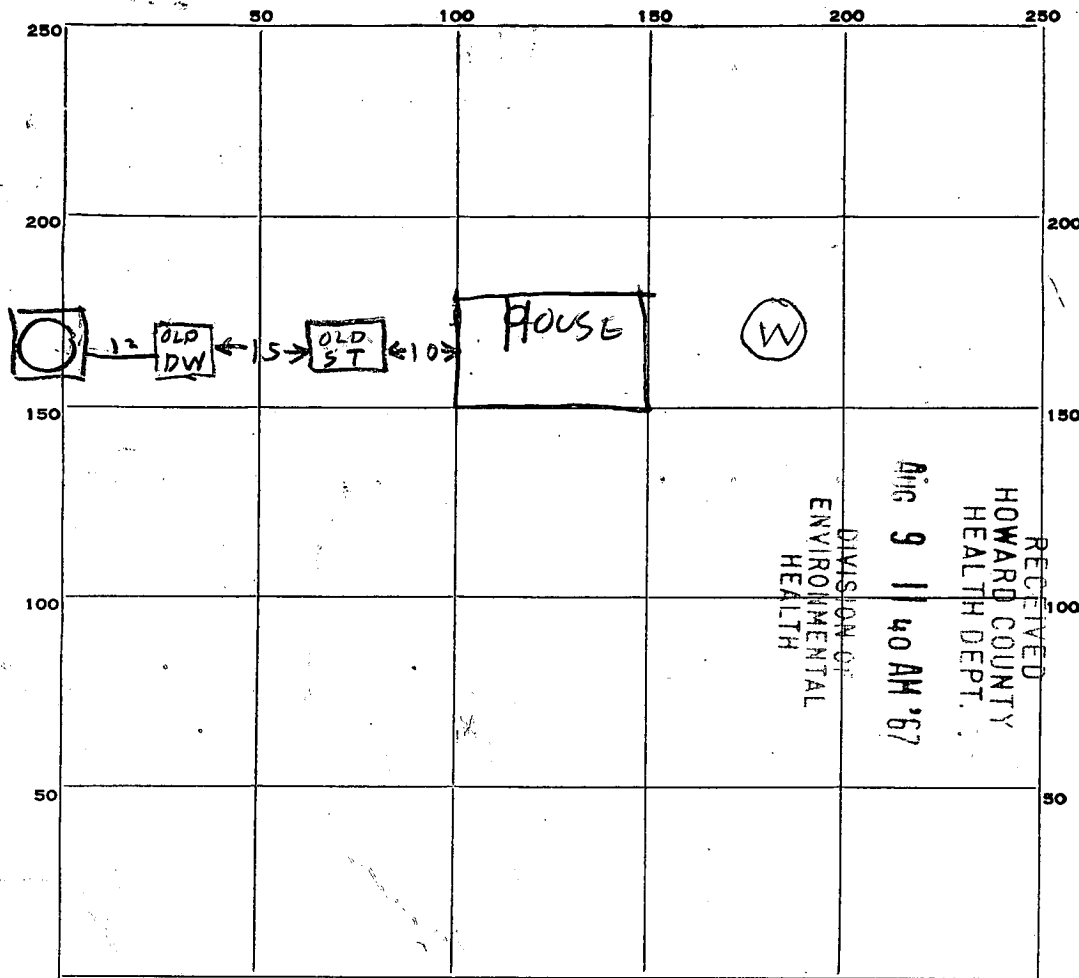

8
8
7
11
12
44

PERMIT CARD _____

SEPTIC TANK, LEVEL _____

CLEANOUTS _____

DISTRIBUTION BOX, LEVEL _____

TILE FIELD, DEPTH _____ FT. TRENCH WIDTH _____ FT.

GRAVEL DEPTH _____ IN. TOTAL LENGTH _____ FT.

NUMBER OF TRENCHES _____ TOTAL BOTTOM AREA _____

SEEPAGE PITS, INSIDE DIAMETER 10 FT. DEPTH BELOW INLET 7 1/2 FT.

ABSORBENT AREA 233 SQ. FT. counting stone not counting stone

REMARKS 10 AUG 67 - Dry well 1 in 2 ft below grade
Perimeter of dry well = 44 ft Therefore 330 sq ft
sidewall area below inlet counting stone


Old Dry well in use 12 years
Soil is sandy

DATE SYSTEM APPROVED 10 AUG 67 INSPECTOR Raymond Hodges

44
7.5
220
308
330
31
7.5
155
217
2325

Location of All Above-Ground Building Structures Adjacent to the Proposed Site

Health Syst

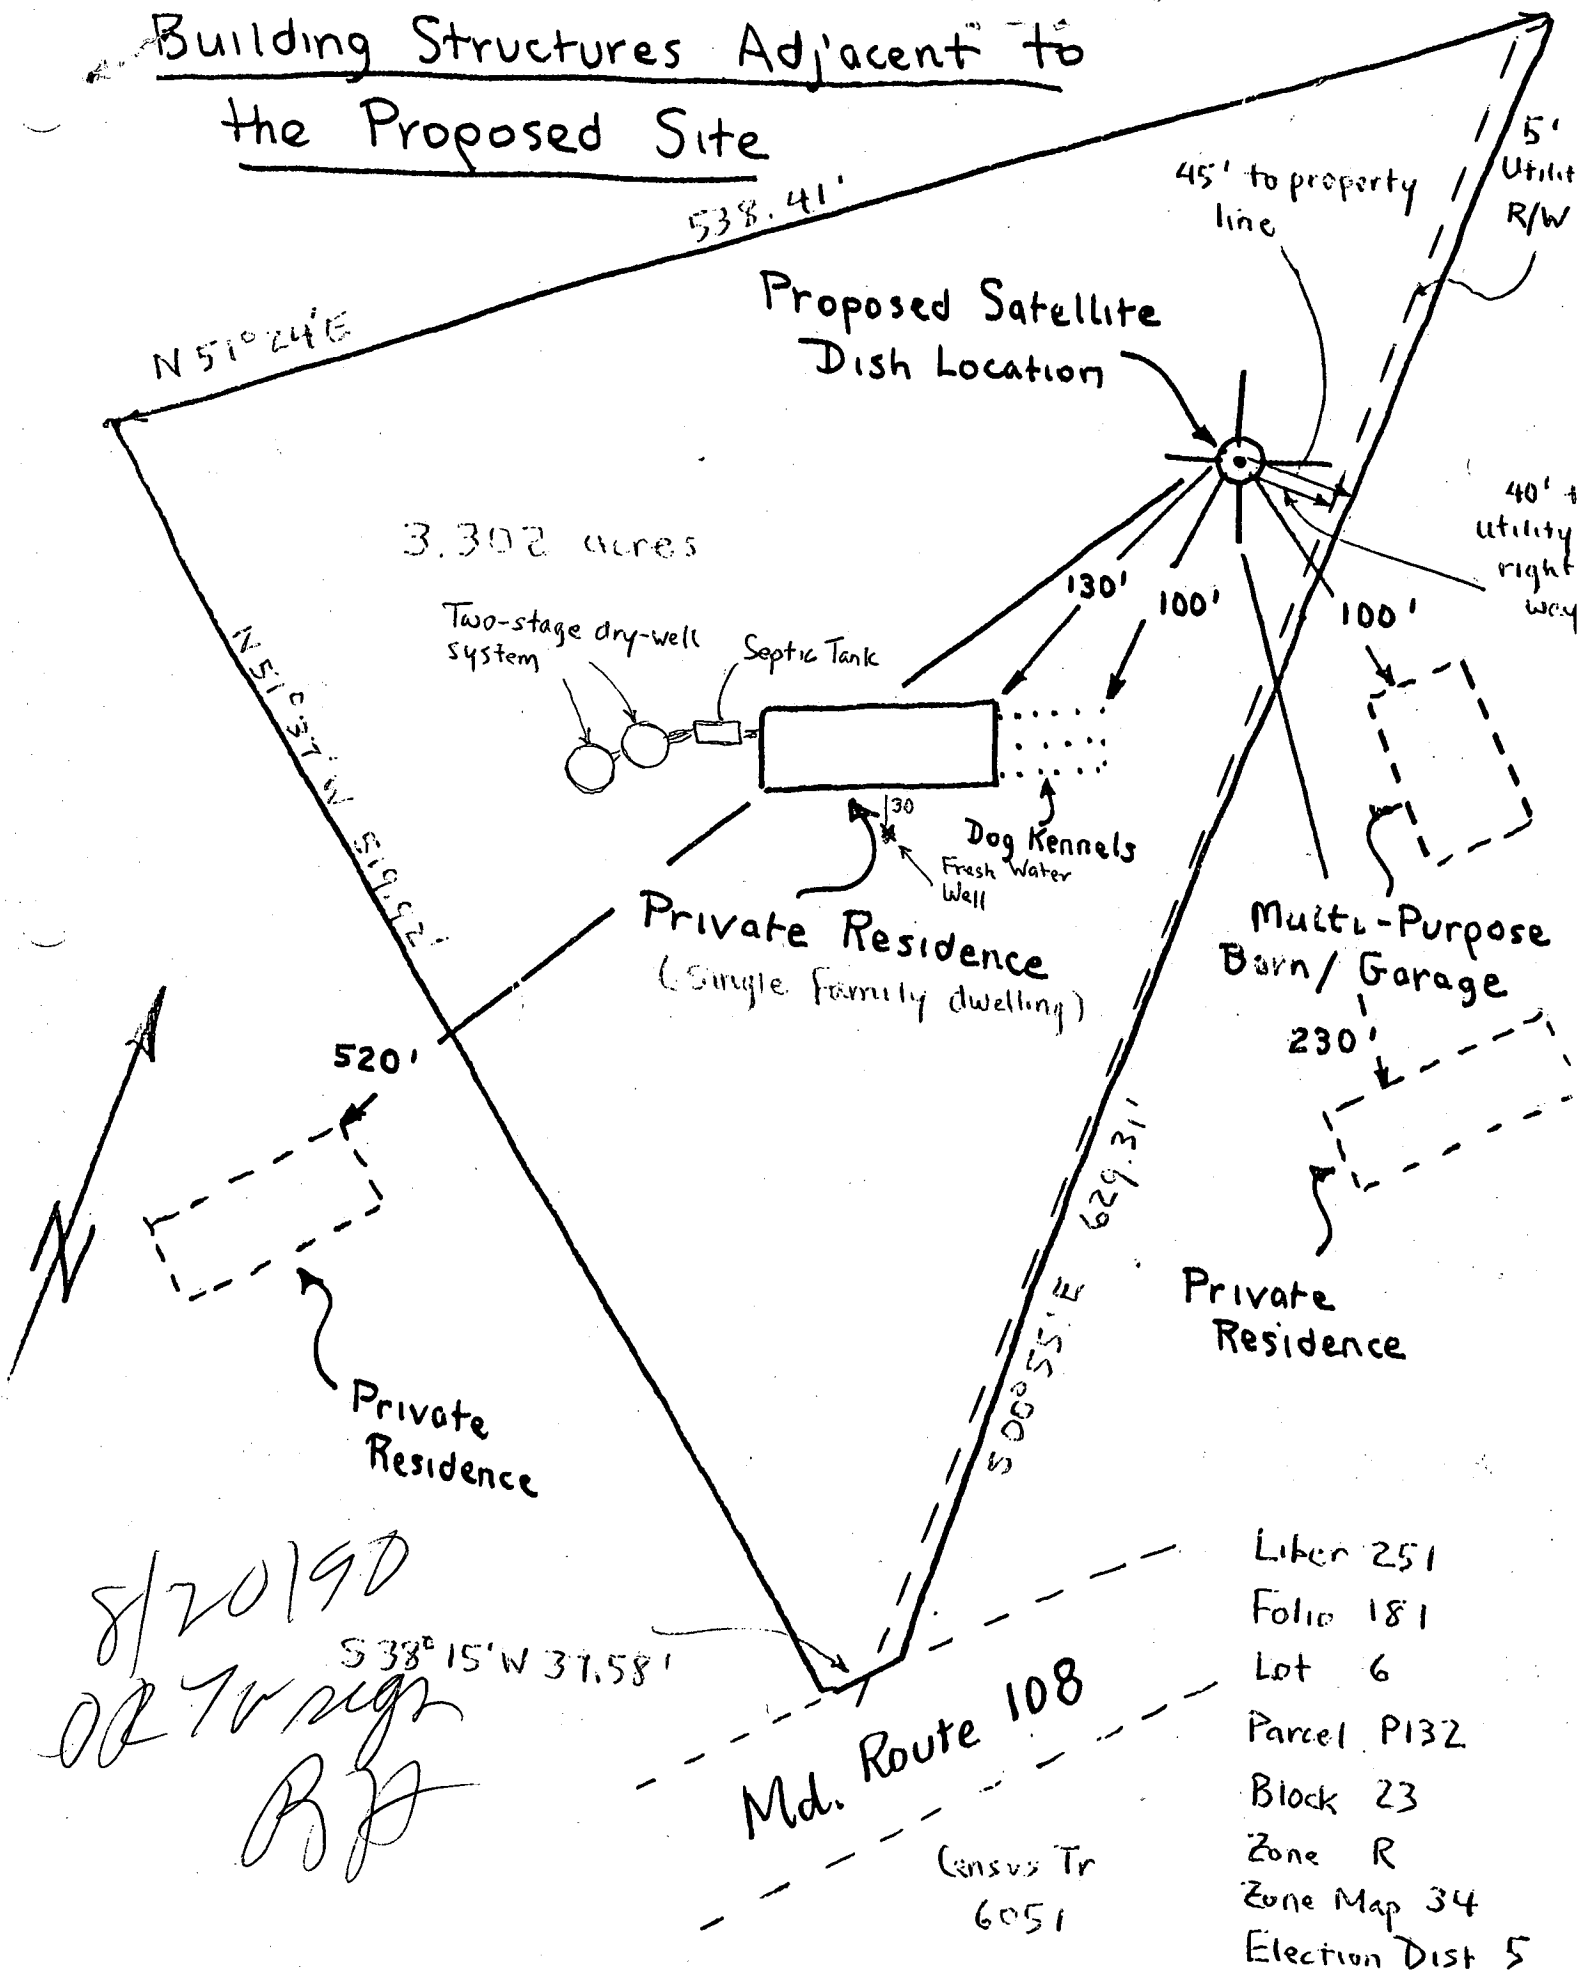

8/20/90
 OR Tr map
 BJD

Libert 251
 Folio 181
 Lot 6
 Parcel P132
 Block 23
 Zone R
 Zone Map 34
 Election Dist 5