

10/22/63

PERMIT

SEWAGE DISPOSAL SYSTEM

10/22/63
approved

P 06960
A06792

MARYLAND STATE DEPARTMENT OF HEALTH

HOWARD COUNTY

04318056

ELLICOTT CITY

DISTRICT 4

DATE 5-28-63

INDEXED

INDEXED

INDEXED

Robert J. Groove

IS PERMITTED TO INSTALL ALTER

ADDRESS _____ PHONE _____

A SEWAGE DISPOSAL SYSTEM LOCATED AT _____

Mrs. Honigsberg

SUBDIVISION Mill Lica 3460 Higley Mill Rd. LOT 4

PROPERTY OWNER Robert Groove

ADDRESS Rt 2 - Woodbine

SPECIFICATIONS

DRAIN FIELD _____ DEPTH _____ FEET, BOTTOM AREA _____ SQ. FT.

SEEPAGE PITS ABSORBENT SIDE WALL AREA 12' x 10' deep below inlet

SEPTIC TANK CAPACITY 750 GALLONS

FOR GARBAGE GRINDER, INCREASE DISPOSAL AREA 22% & TANK CAPACITY 50%

OTHER * Inlet to be 4 ft. below original grade.

Place dry well about 210 ft. from rear lot line and about 30 ft. from right side of area when facing lot from Higley Mill Rd.

PLANS APPROVED BY DW Monaghan DATE 5-16-63

FILL SEPTIC TANK AND DISTRIBUTION BOX WITH WATER BEFORE CALLING FOR AN INSPECTION. COVER NO WORK UNTIL INSPECTED AND APPROVED.

NEITHER THE HOWARD COUNTY COMMISSIONERS NOR THE HEALTH DEPARTMENT IS RESPONSIBLE FOR THE SUCCESSFUL OPERATION OF ANY SYSTEM.


PROPOSED SWIMMING POOL.

BLDG. PERMIT SIGNED AND RETURNED 4/29/64
George Bealder
Lic # 46319

A06792

A 457453

3.14
 5826
 9 1/2
 1413
 25534
 269.47
 376
 9 1/2
 188
 3584
 3572

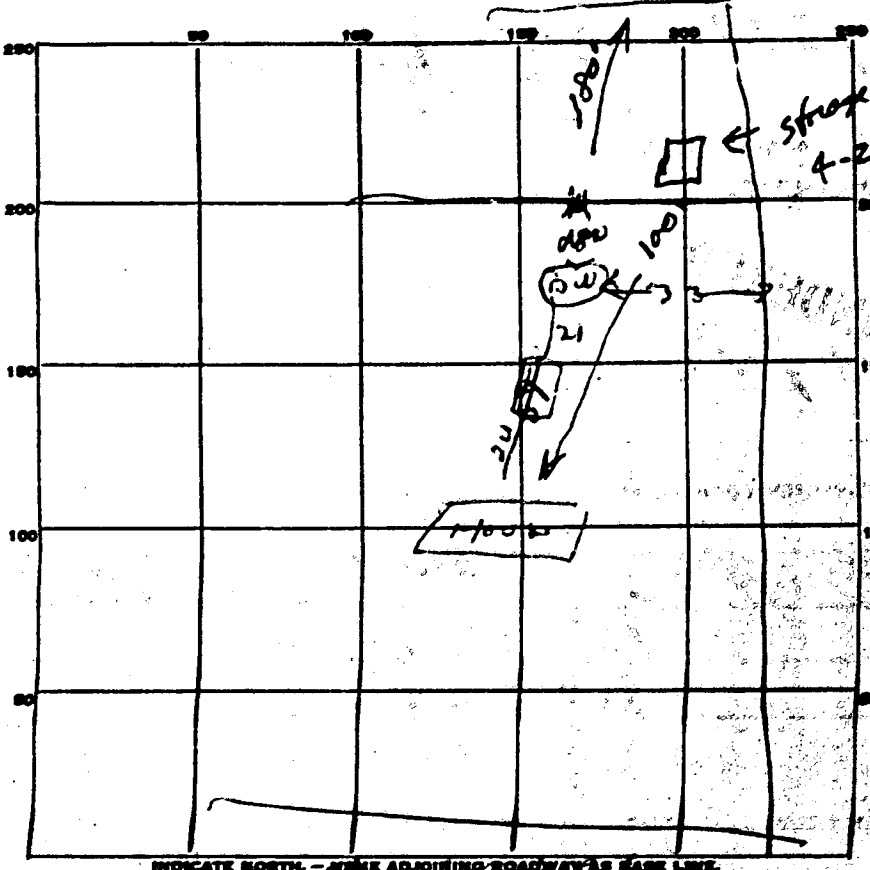


PERMIT CARD 10 K
 SEPTIC TANK, LEVEL OK CLEANOUTS OK
 DISTRIBUTION BOX, LEVEL _____
 TILE FIELD, DEPTH _____ FT. TRENCH WIDTH _____ FT.
 GRAVEL DEPTH _____ IN. TOTAL LENGTH _____ FT.
 NUMBER OF TRENCHES _____ TOTAL BOTTOM AREA _____
 SEEPAGE PITS, INSIDE DIAMETER 9 FT. DEPTH BELOW INLET 9 1/2 FT.
 ABSORBENT AREA 2694 SQ. FT.

REMARKS 10/2/63 - System has ^{over} 1 1/2 ft gravel around dry well - giving diameter of
over 4 ft - no problem - OK - 3572 y p

DATE SYSTEM APPROVED 10/2/63 INSPECTOR W. J. Morgan

A# 06792

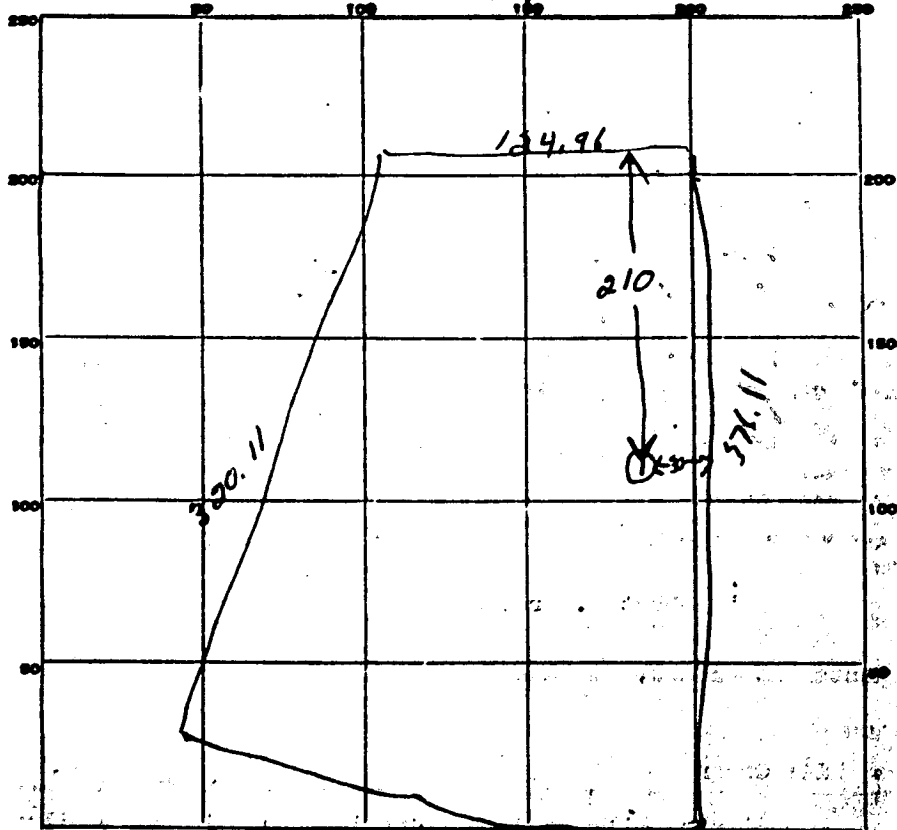

INDICATE NORTH - NAME ADJOINING ROADWAY AS BASE LINE.

Hipcity Mill Rd

DATE	TEST NO.	DEPTH	PRE-WET		TEST - 1" DROP		TIME
			START	STOP	START	STOP	
5/14/63	1	8 ft	107	114	114	1:30	16 min
	2	4 ft	109	114	114	1:21	7 min

SOIL AUGER FINDING *fine clay*

TESTED BY *Geo M S/14/63*


REMARKS _____

ALSO PRESENT *Khoda M Groves* LOT NO. *4*

LOCATION DRAWING

MAP OF
MILL GREEN
SECTION ONE
LOT 4
HOWARD COUNTY, MARYLAND

5/21/97
Shown pool
location will
have no impact to
the existing well or
Septic
AU

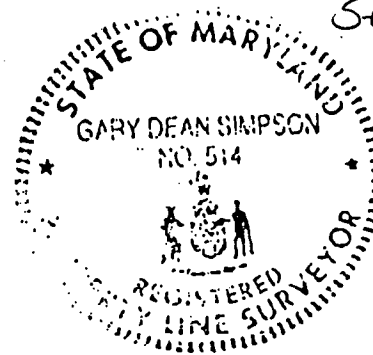


NORTH

LOT 6

LOT 4
1.974 acres

LOT 3

LOT 5

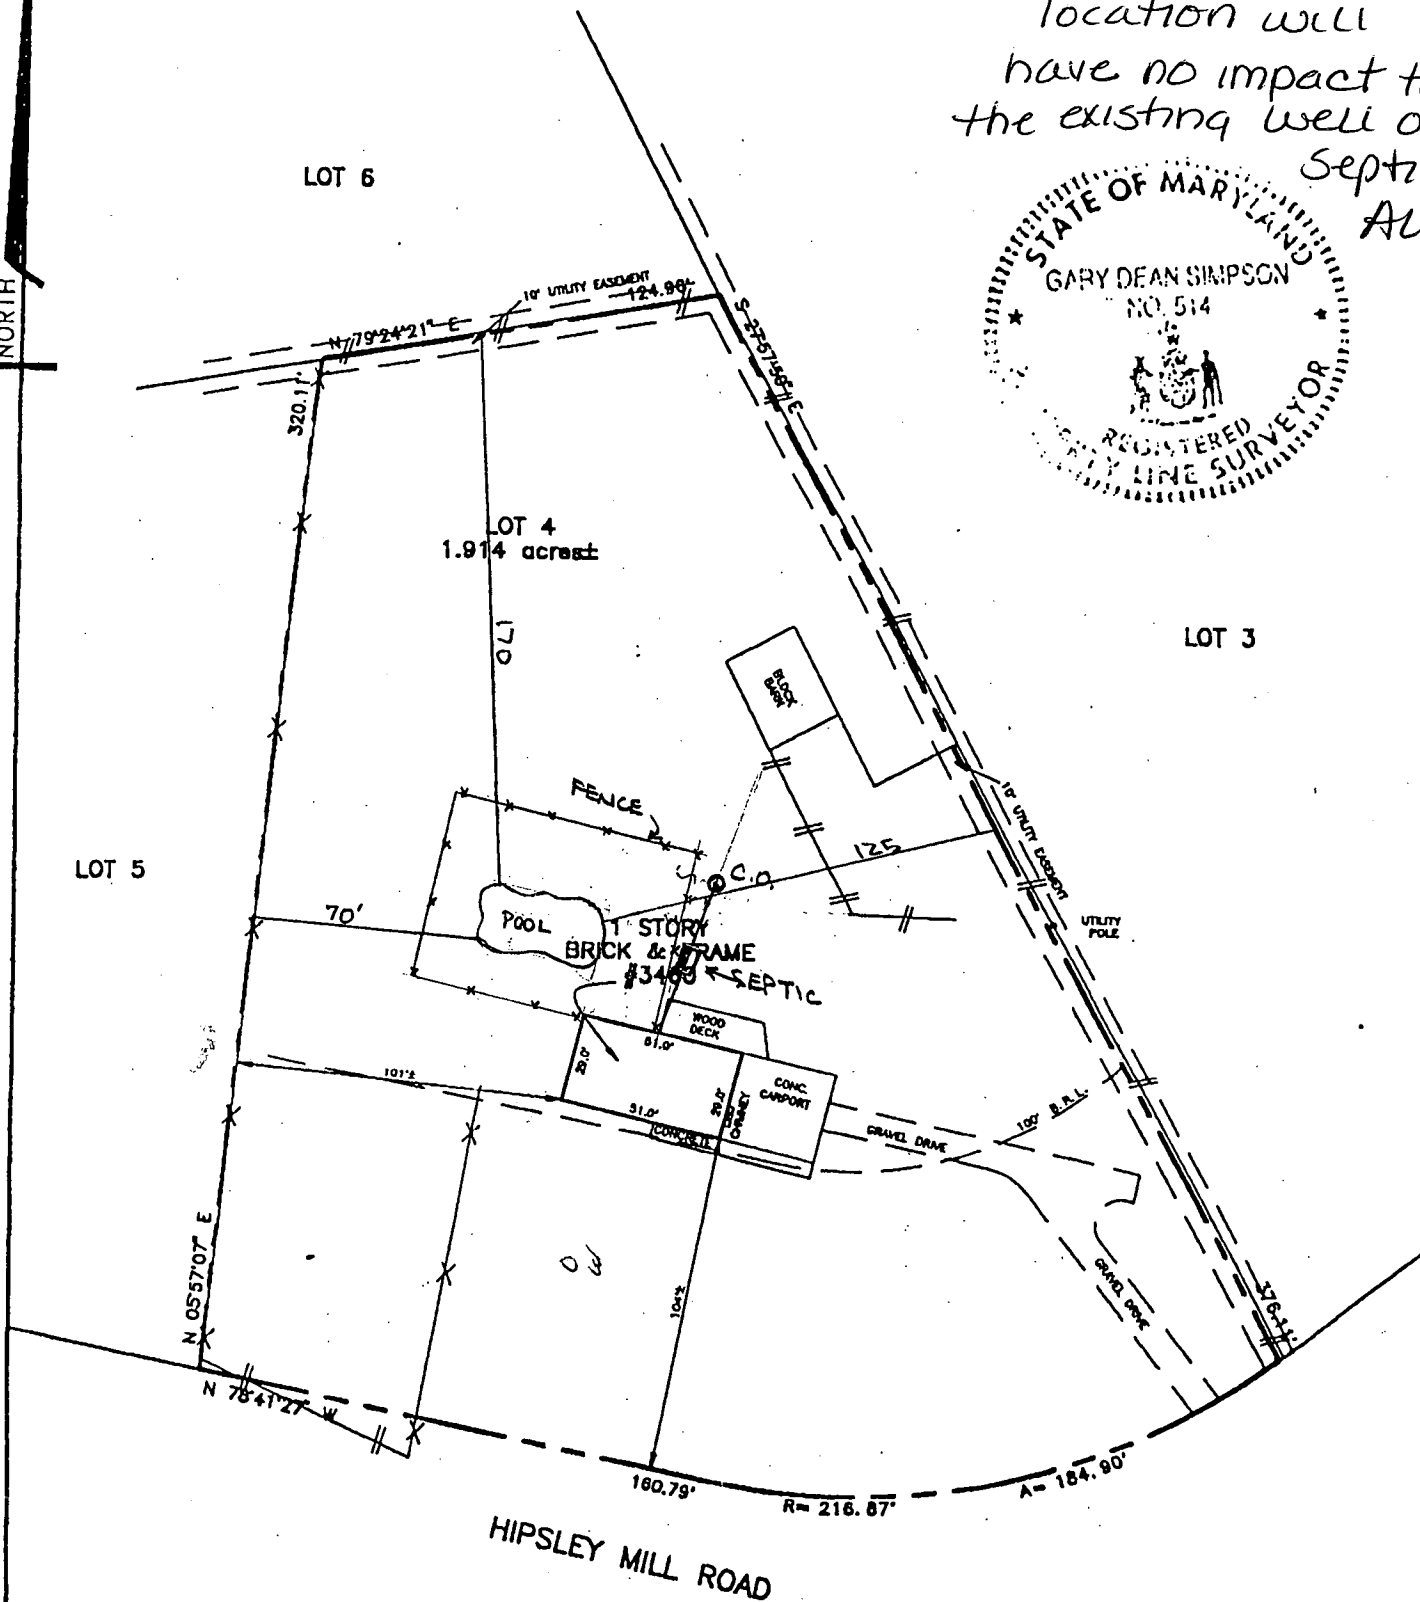

HIPSLEY MILL ROAD

PROPERTY ADDRESS: 3460 HIPSLEY MILL ROAD

THE PROPERTY SHOWN HEREON IS LOCATED IN ZONE C (AREA OF MINIMAL FLOODING) ACCORDING TO NATIONAL FLOOD INSURANCE PROGRAM F.I.R.M. MAP COMMUNITY PANEL NO. 240044 0013 B AS REVISED 12/04/1986.

APPLICATION

HOWARD COUNTY

SERIAL NUMBER

PERMIT APPLICATION

DEPARTMENT OF INSPECTIONS, LICENSES & PERMIT
3430 COURT HOUSE DRIVE, ELLICOTT CITY, MARYLAND 21043

BUILDING ADDRESS (HOUSE NO., STREET, TOWN OR AREA)

3460 HIPSLEY HILL Rd
WOODBINE/LISBON 21797

GRADING/SEDIMENT CONTROL YES NO

SDP #

DESCRIPTION OF WORK AUTHORIZED

Inground Swimming Pool
& Fence

LOT NO. 4	PARCEL NO.	SEC. 1	AREA	BLOCK NO. 7	LIBER	FOLIO
SUB DIVISION Mill Green		ZONE C	ZONE MAP	ELEC. DIST.	CENSUS TR.	

OWNER NAME AND ADDRESS
GILES C + BARBARA B. COOK
Same

OCCUPANT'S NAME AND ADDRESS
Same

ARCHITECT OR ENGINEER'S NAME AND ADDRESS

CONTRACTOR'S NAME AND ADDRESS
L.C. Hohna Inc
9000 Harford Rd
Baltimore MD 21234
PHONE NO. 668-1300

EXISTING USE
S.F.D
PROPOSED USE
S.F.D. + Pool

EST. CONSTRUCTION COST
25,000.00
LICENSE NUMBER
377
PERMIT FEE

SIZE OF BLDG.	FRONT	DEPTH	HEIGHT

TYPE OF BLDG.	AREA	VOLUME	ROOF
B. ROOMS			
ROOMS			
BATHS			
FIREPLACES			

FOOTINGS	FOUNDATION	S. WALLS

UTILITIES				
WATER/WELL	SEWER/SEPTIC	GAS	ELECTRICITY	TYPE OF HEAT
				AC

I have carefully examined and read this application and know the same is true and correct, and that is doing this work, all provisions of Howard County Ordinances and the State Laws of Maryland will be complied with, whether specified or not; and I will notify the Department of Inspections, and Permits twenty-four hours in advance when I am ready for the inspections called for elsewhere in the application; and that no work will be covered up until such inspections have been complied with.

SIGNATURE
TITLE
DATE

FOR OFFICE USE ONLY

DISTANCE IN FEET FROM R/W LINE TO FRONT BUILDING LINE

SIDE YARD
(DISTANCE IN FEET FROM SIDE BLDG. LINE TO SIDE PROPERTY LINE)

TO SIDE BUILDING LINE
DISTANCE IN FEET, REAR YD. REQUIRING SET

BACK
(CORNER LOT ONLY)

Check payable to: DIRECTOR OF FINANCE OF HOWARD COUNTY

CAUTION
To begin construction before a permit placard has been issued and displayed on the job is a violation of the law.
Use and occupancy permit must be applied for two weeks before it will be issued.

FUNCTION	DATE	SIGNATURE APPROVAL
ZONING/PLANNING		
SHA		
SEDIMENT/GRADING		
BUILDING OFFICIAL		
WATER & SEWER		
HEALTH DEPT.	5/21/97	A McMulle
FIRE PROTECTION		
STORM WATER MGM.		

IMPORTANT: PLEASE SHOW ZIP CODES AND AREA CODES WHEREVER REQUIRED. APPROVED DATE

A